




Existing - First Floor Image



As Built - First Floor Image

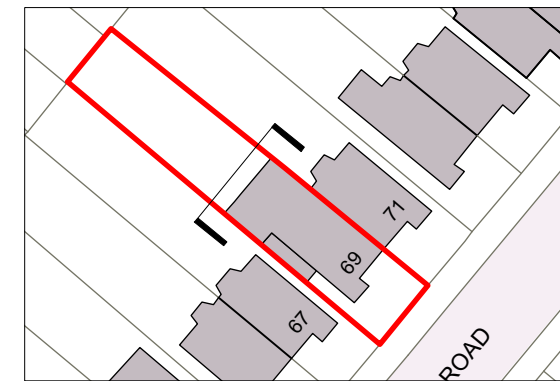

## Notes


Do not scale from drawings

Errors to be reported immediately to the Architect.


To be read in conjunction with all relevant Architects, Services and Structural Engineers drawings.

All existing site, tree and building information has been compiled from different sources.


All dimensions to be checked on site.

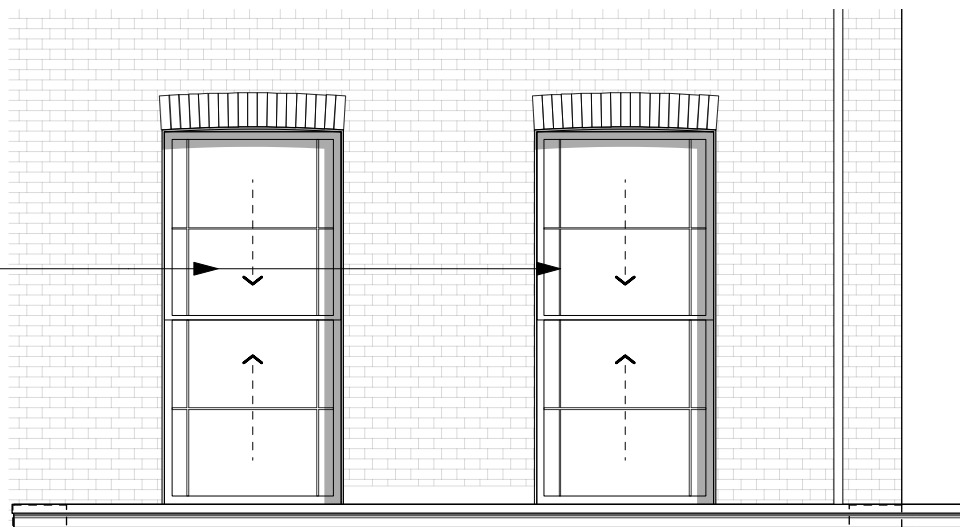


Existing - First Floor Elevation

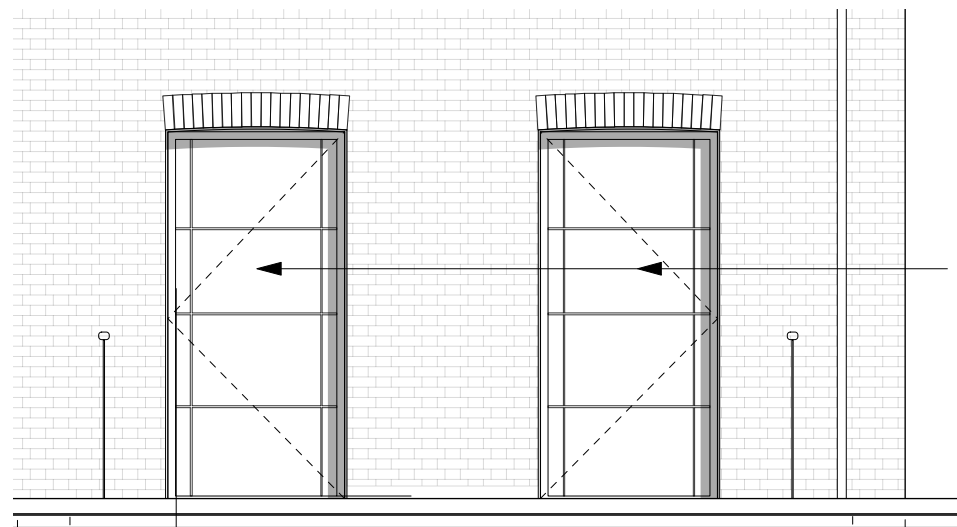


As Built - First Floor Elevation

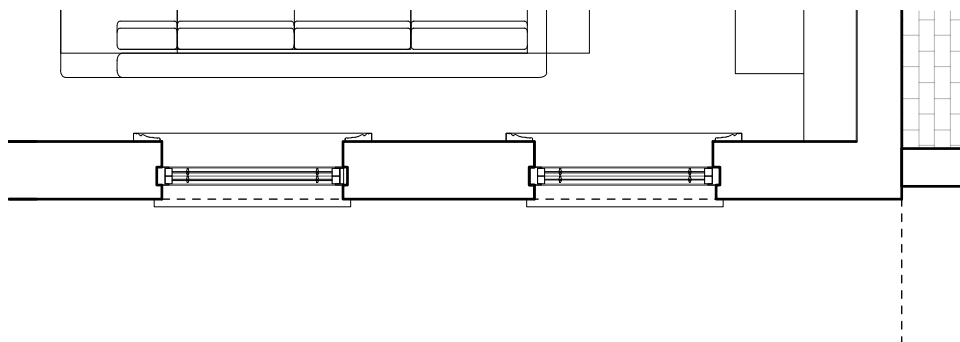

Existing - First Floor Plan

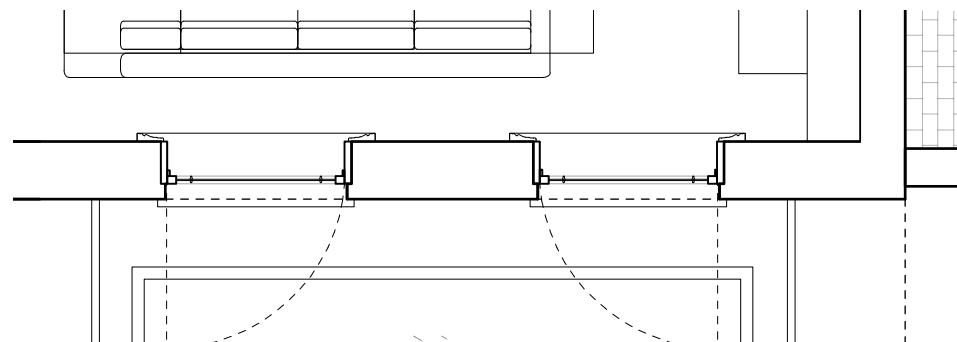

As Built - First Floor Plan

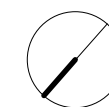

## PLANNING

Project Title	
<b>69 St. Augustine's Rd, NW1</b>	
Job No.	Sheet Title
1268	Existing & Proposed Terrace Windows
Stage	Scale
Planning	1:50 @ A3
Drawn By	Date
JT	31.08.21
Reviewed By	CAD File Name
NL	1268 - 69 St.Augustines Road-01-DW

**nicholas lee architects ltd**

34A Rosslyn Hill, London NW3 1NH  
Tel: 020 7435 9315 www.nleearchitects.com