



EXISTING CROSS SECTION 1-1
Scale 1/100


EXISTING CROSS SECTION

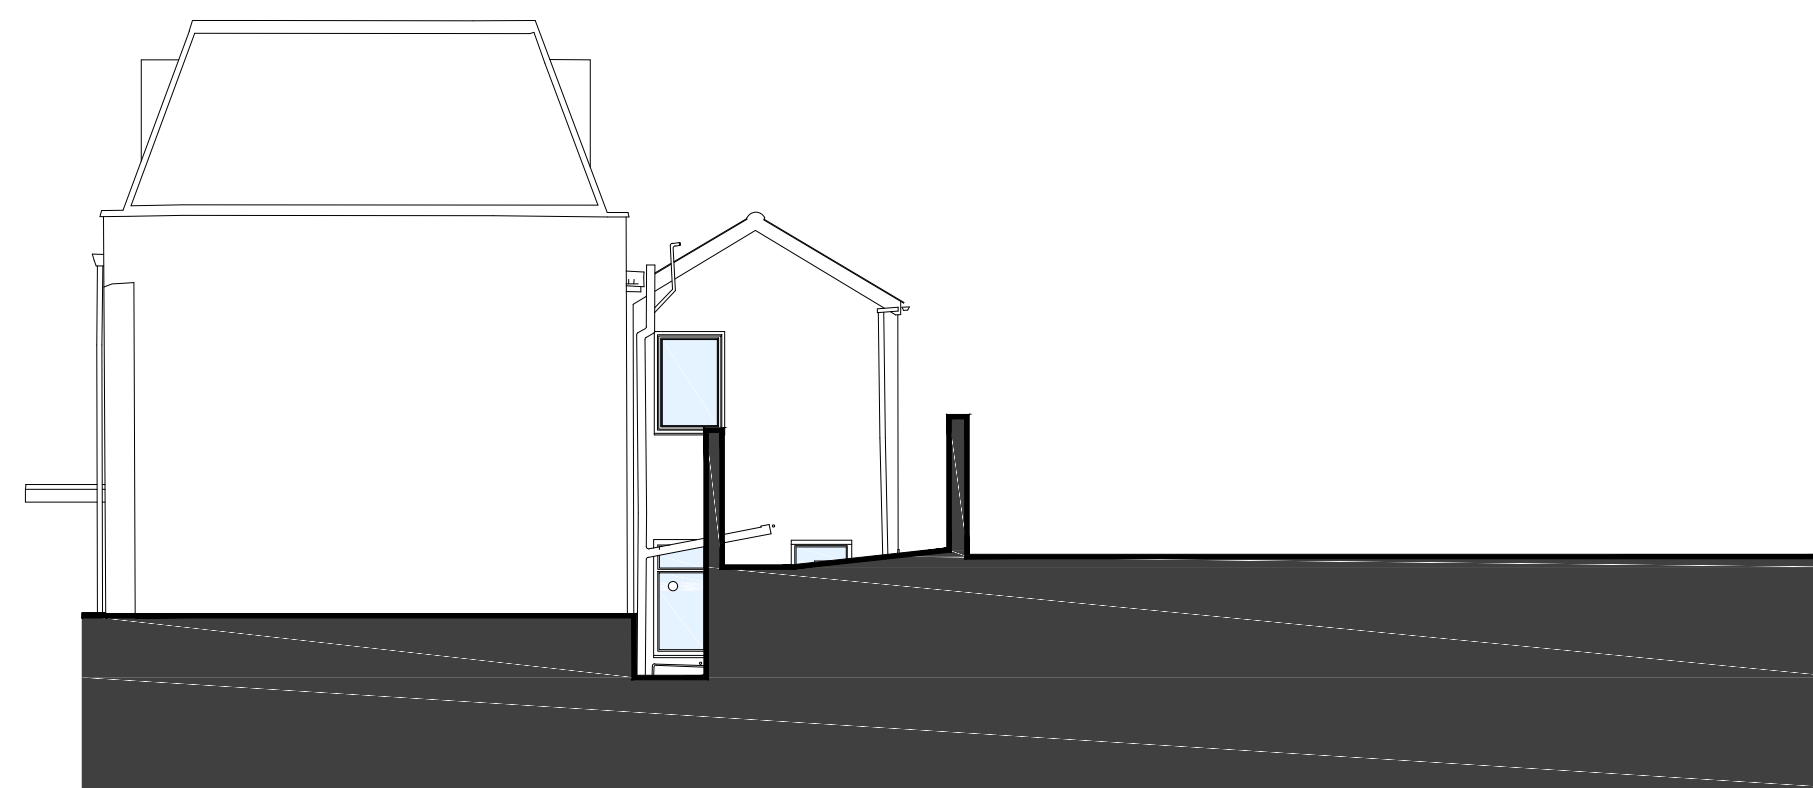


EXISTING CROSS SECTION

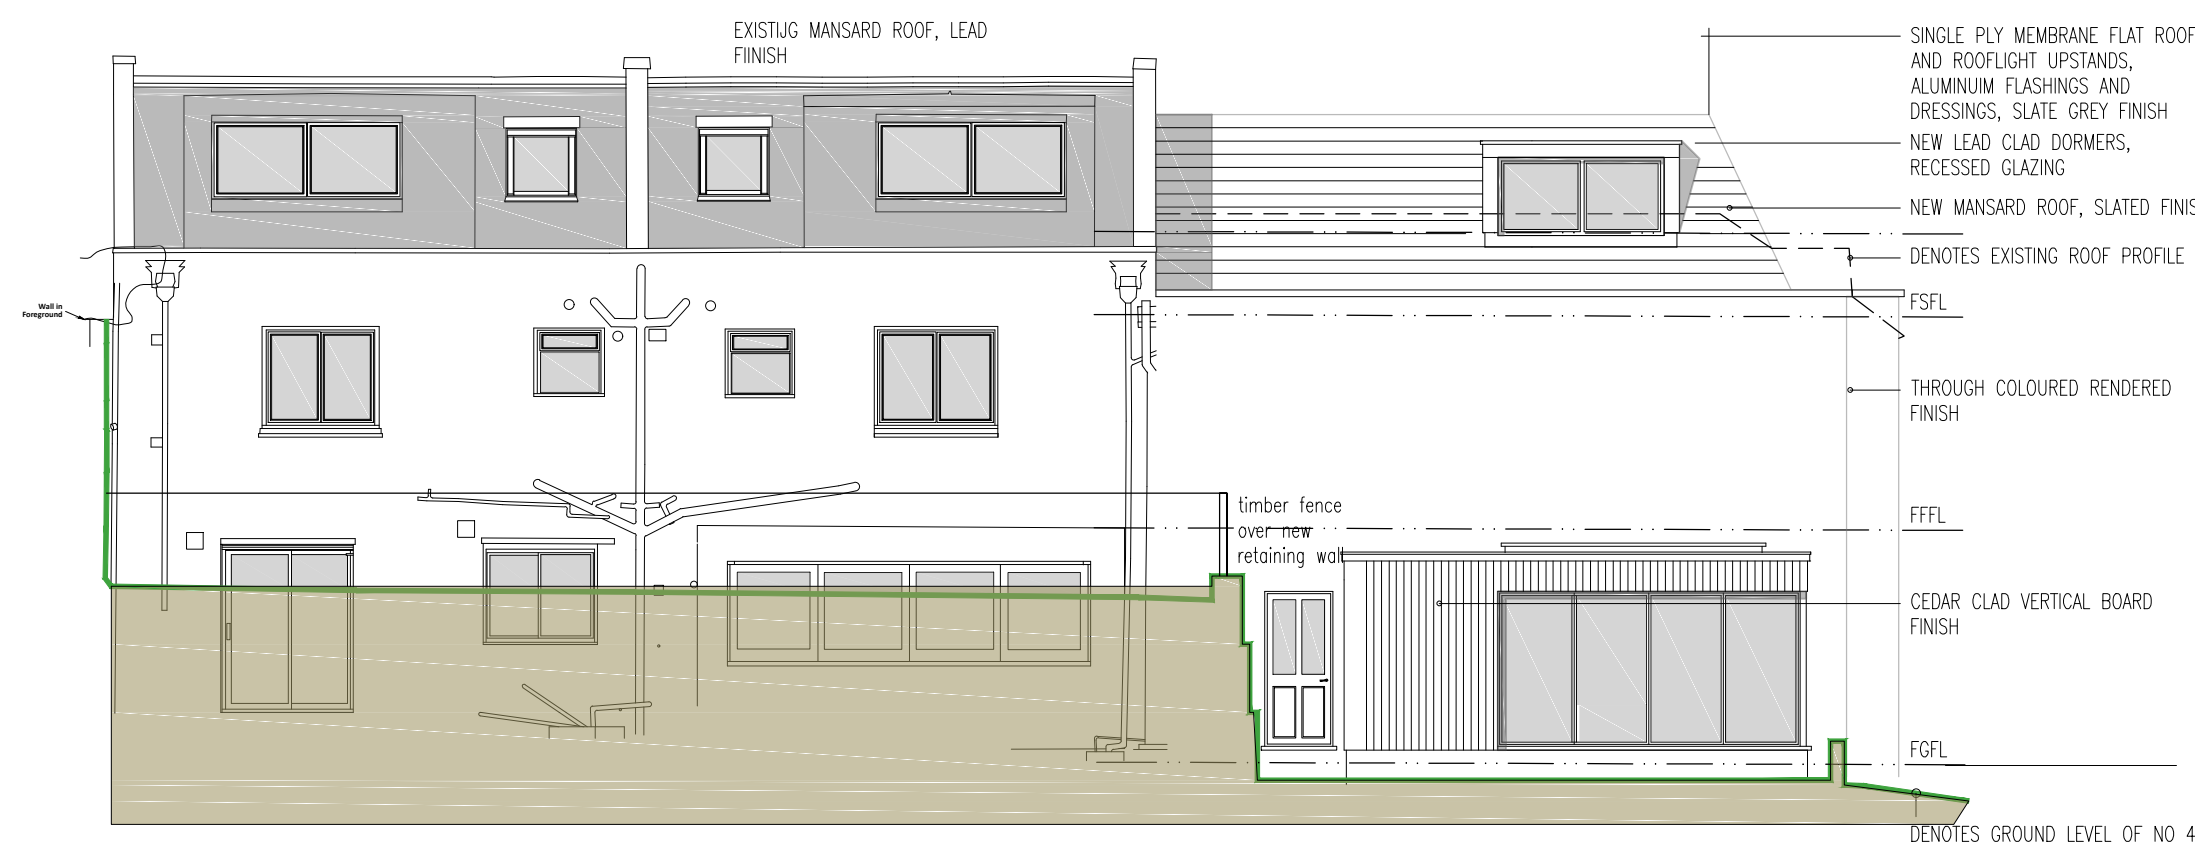

PROPOSED CROSS SECTION

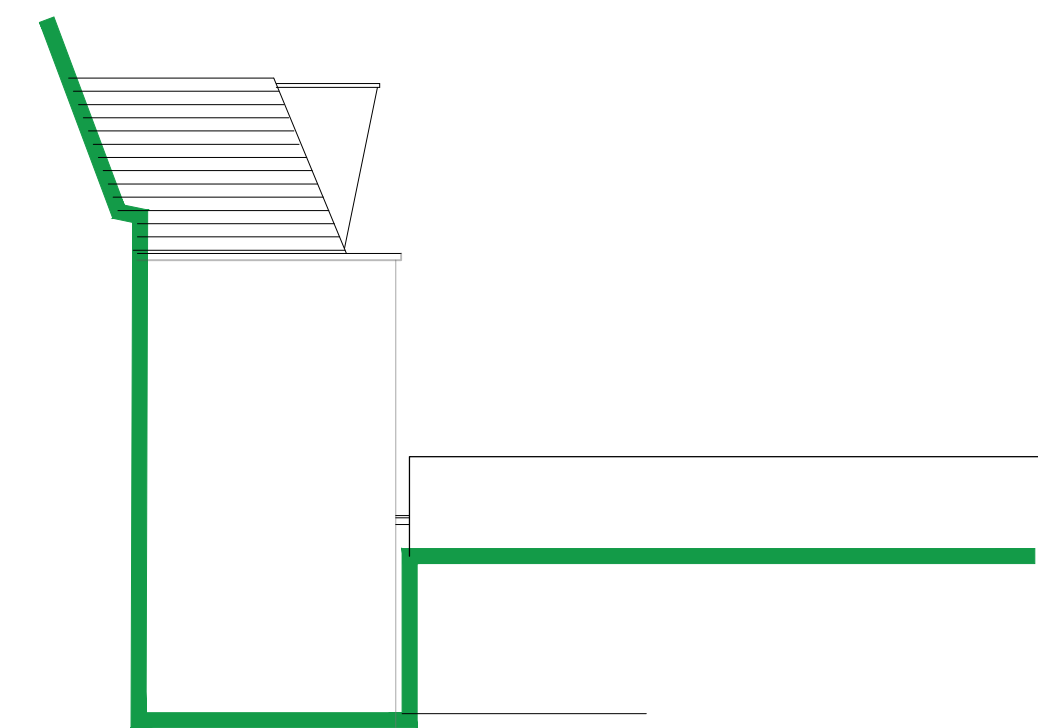

PROPOSED CROSS SECTION

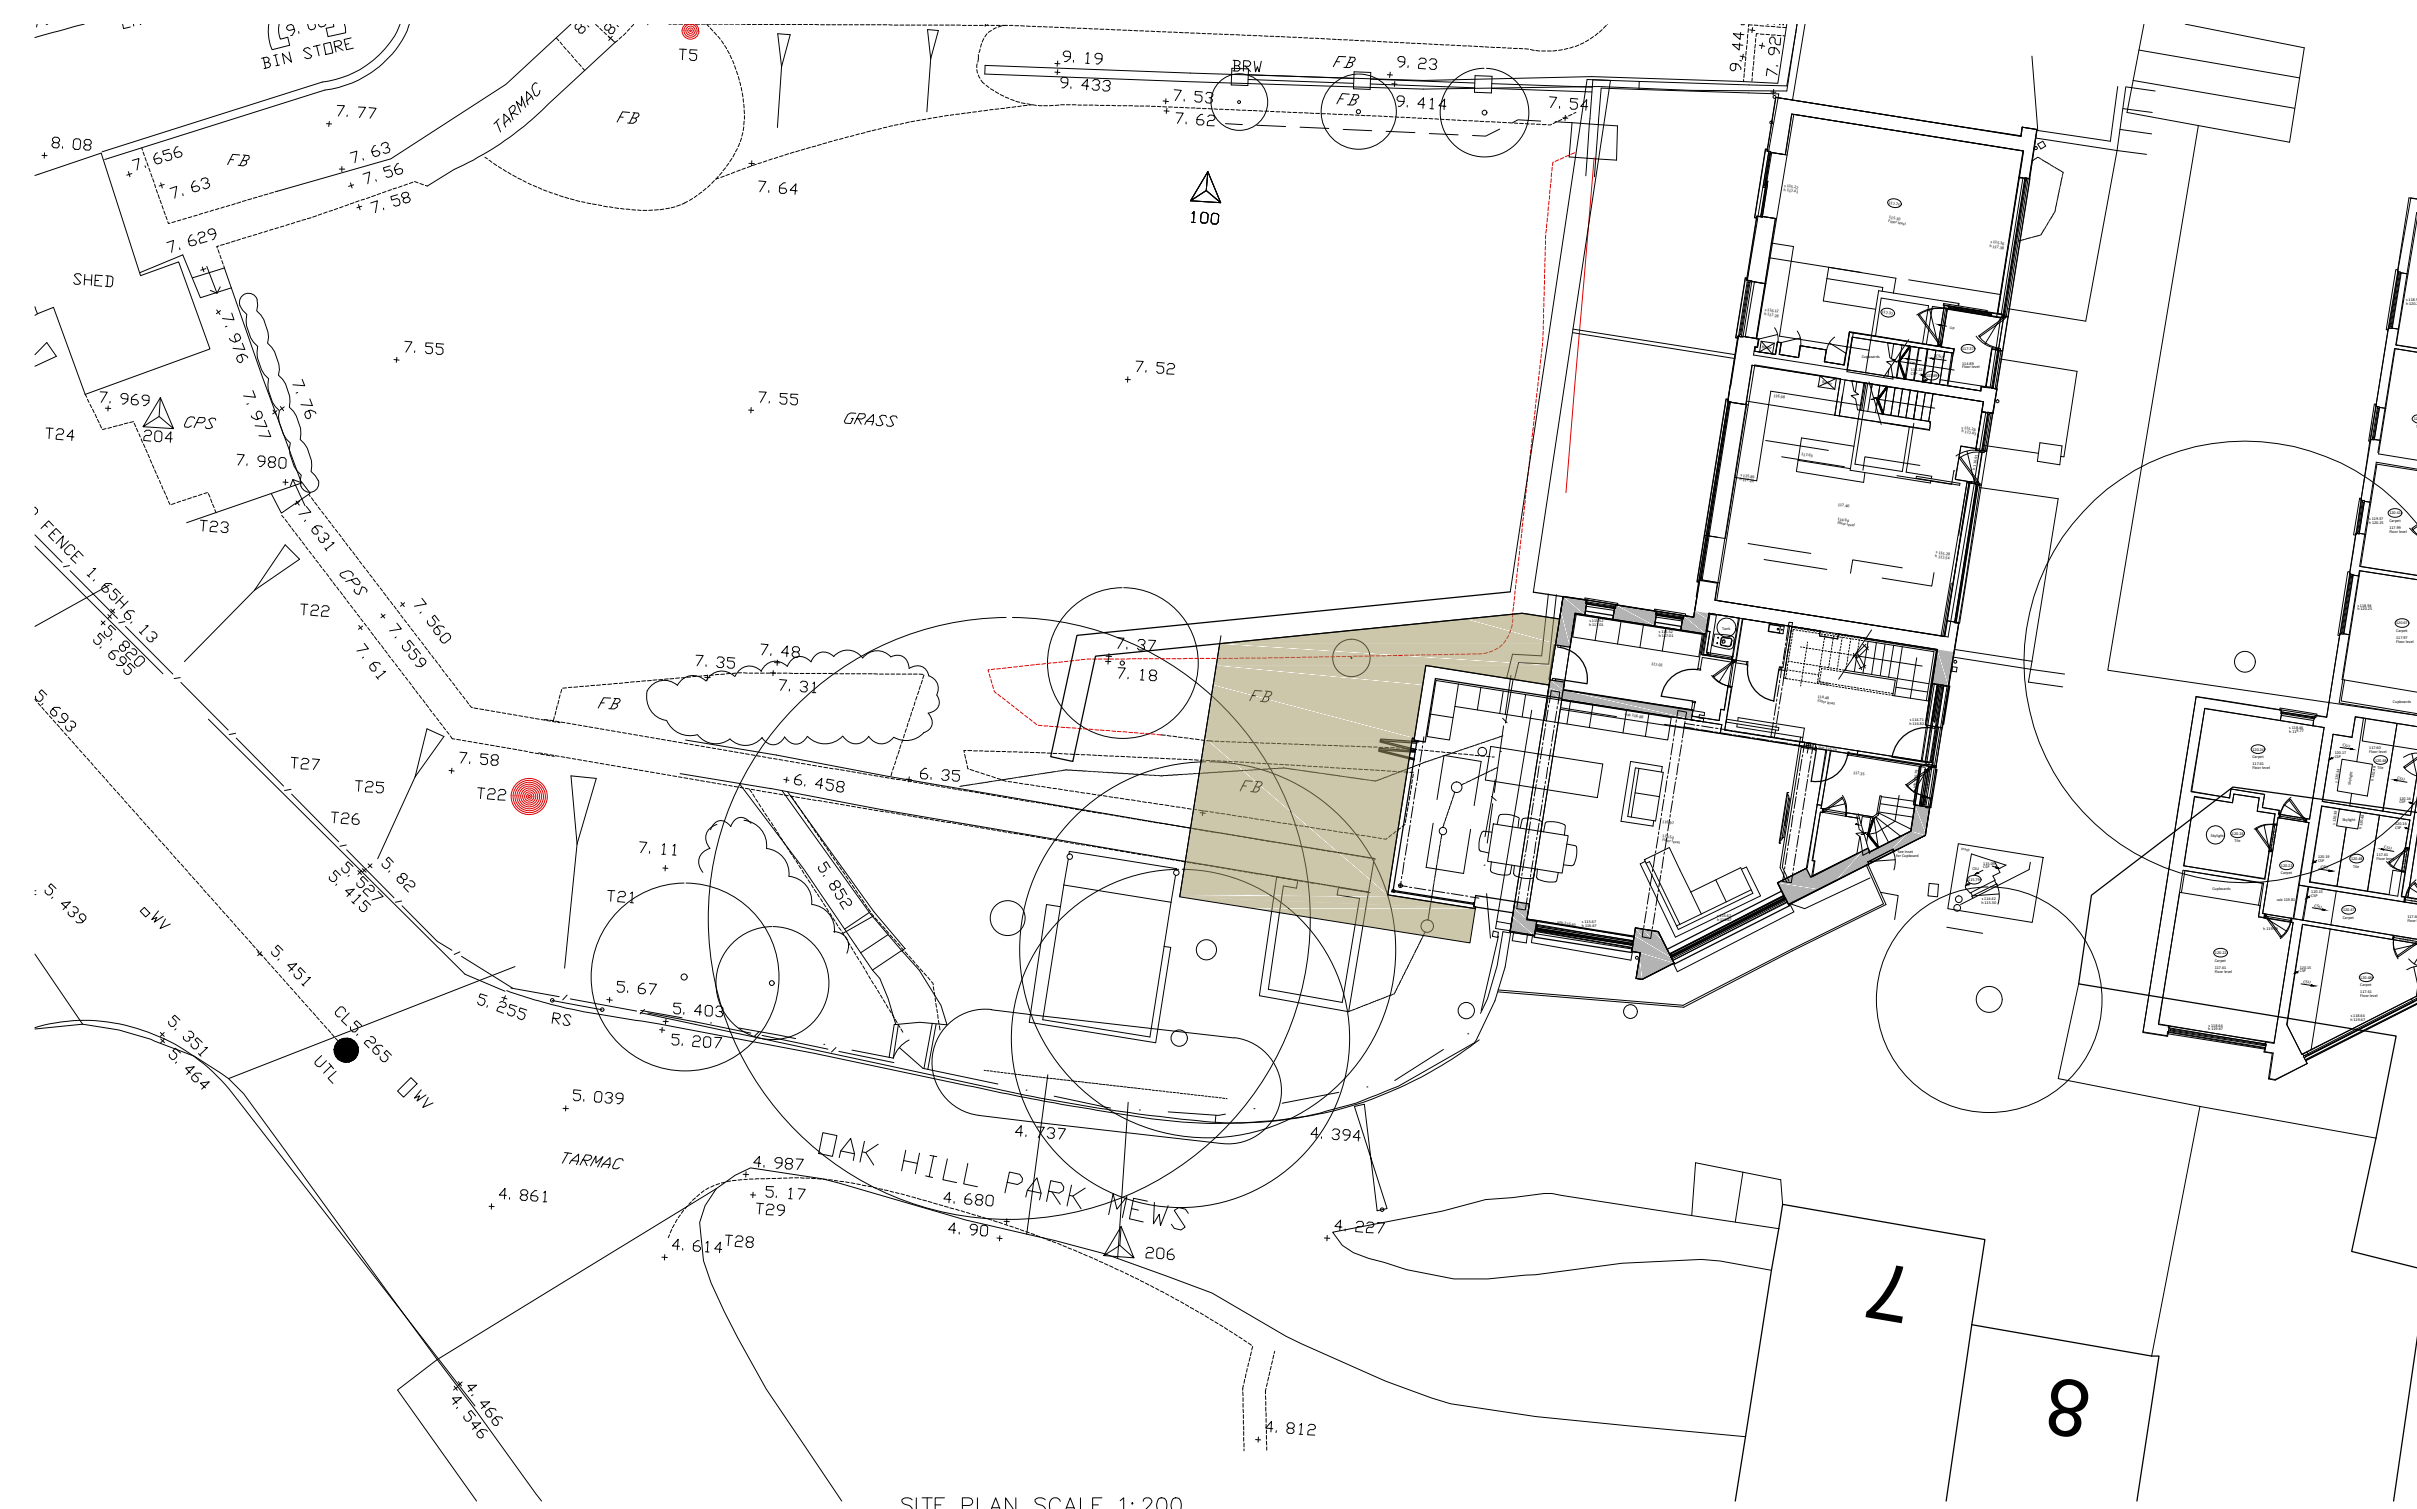

SITE PLAN SCALE 1:200

do not scale from this drawing
use dimensions only, all discrepancies to be reported to the architect

copyright reserved
This drawing may only be used for the client and location specified, it may not be copied or adapted to any third party without prior written permission from rickett architects ltd.



rickett architects
168 parade
leamington spa
cv32 4ae

dim	21.09.21	titleblock amended
b	11.08.21	location plan amended
a	09.08.21	issued for retrospective planning
dwa no	dim	2002 S3 003 c
client	Messrs Dimant	
project	No1 Oak Park Mews Hamstead	
title	pre existing and as built sections siteplan	
date	03.21	scale 1:100/1:200
drawn	dr	check
studio@rickett.co.uk	size	A1

