


NEALS YARD

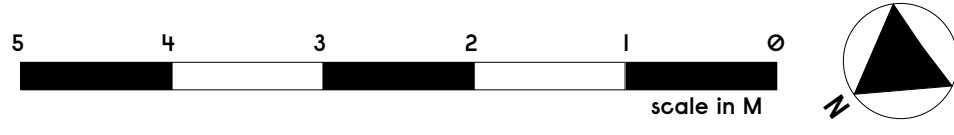

Notes

Revision	Date	Description
/	23.07.21	/

Gundry + Ducker
 Gundry & Ducker Architecture Ltd
 3 Garrick Street
 London WC2E 9BF
 t +44(0)203 417 4895
 info@gundryducker.com

Project	Barbary Next Door.		
Drawing title	As Existing Plan		
Scale	1:25@A3	Drwg. No.	Rev
Date	Jan 2021	430.PL.01	/
Status	as built		

Do not scale. All dimensions to be confirmed on site. Information contained in this drawing is the sole copyright of the designer and is not to be reproduced without permission.