


boundary

boundary

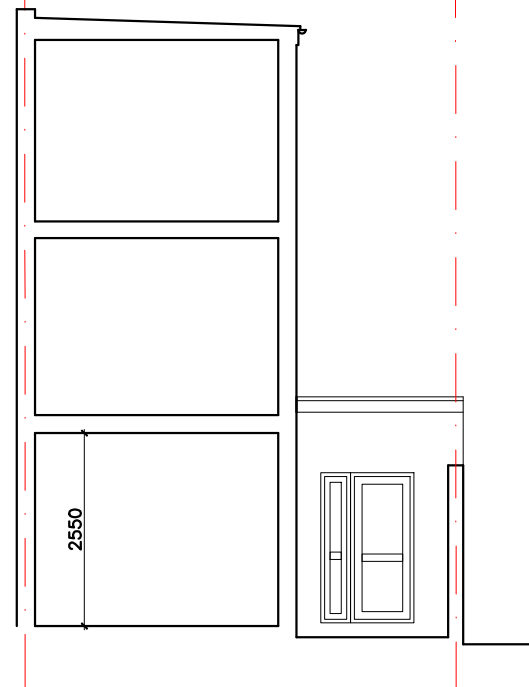


SOUTH ELEVATION

boundary

boundary






WEST ELEVATION

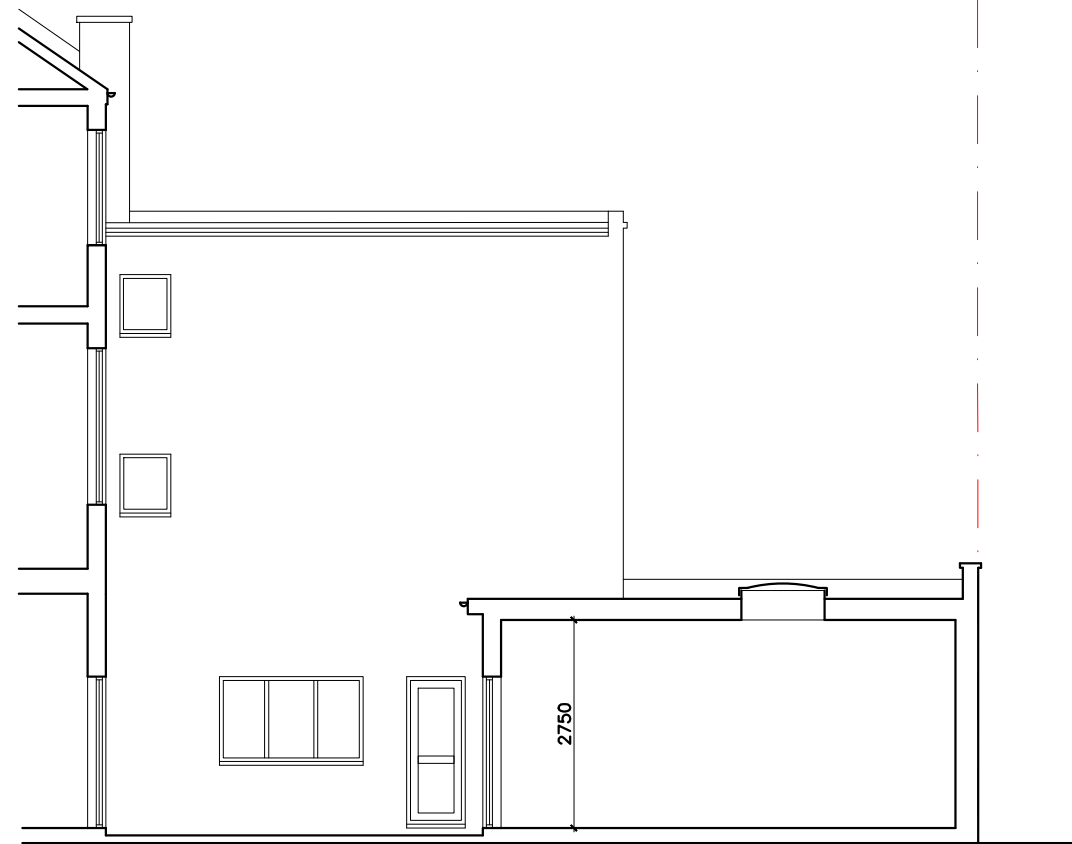

NORTH ELEVATION

Copyright notice:


This and all other documents authored by VMA and all information and concepts both depicted and implied therein are the sole property of VMA. Reproduction or transmission in any form is strictly forbidden unless prior permission is obtained in writing from VMA. Construction based on the depicted information at any time or location not related to this project is strictly forbidden unless prior permission is obtained in writing from VMA.

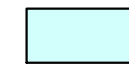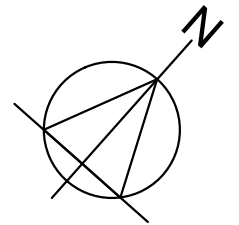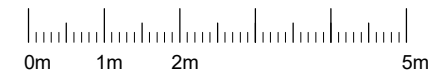


HMO UNIT 03
Gross internal area 55.0 m²



SHOP AREA
Gross internal area 42.0 m²

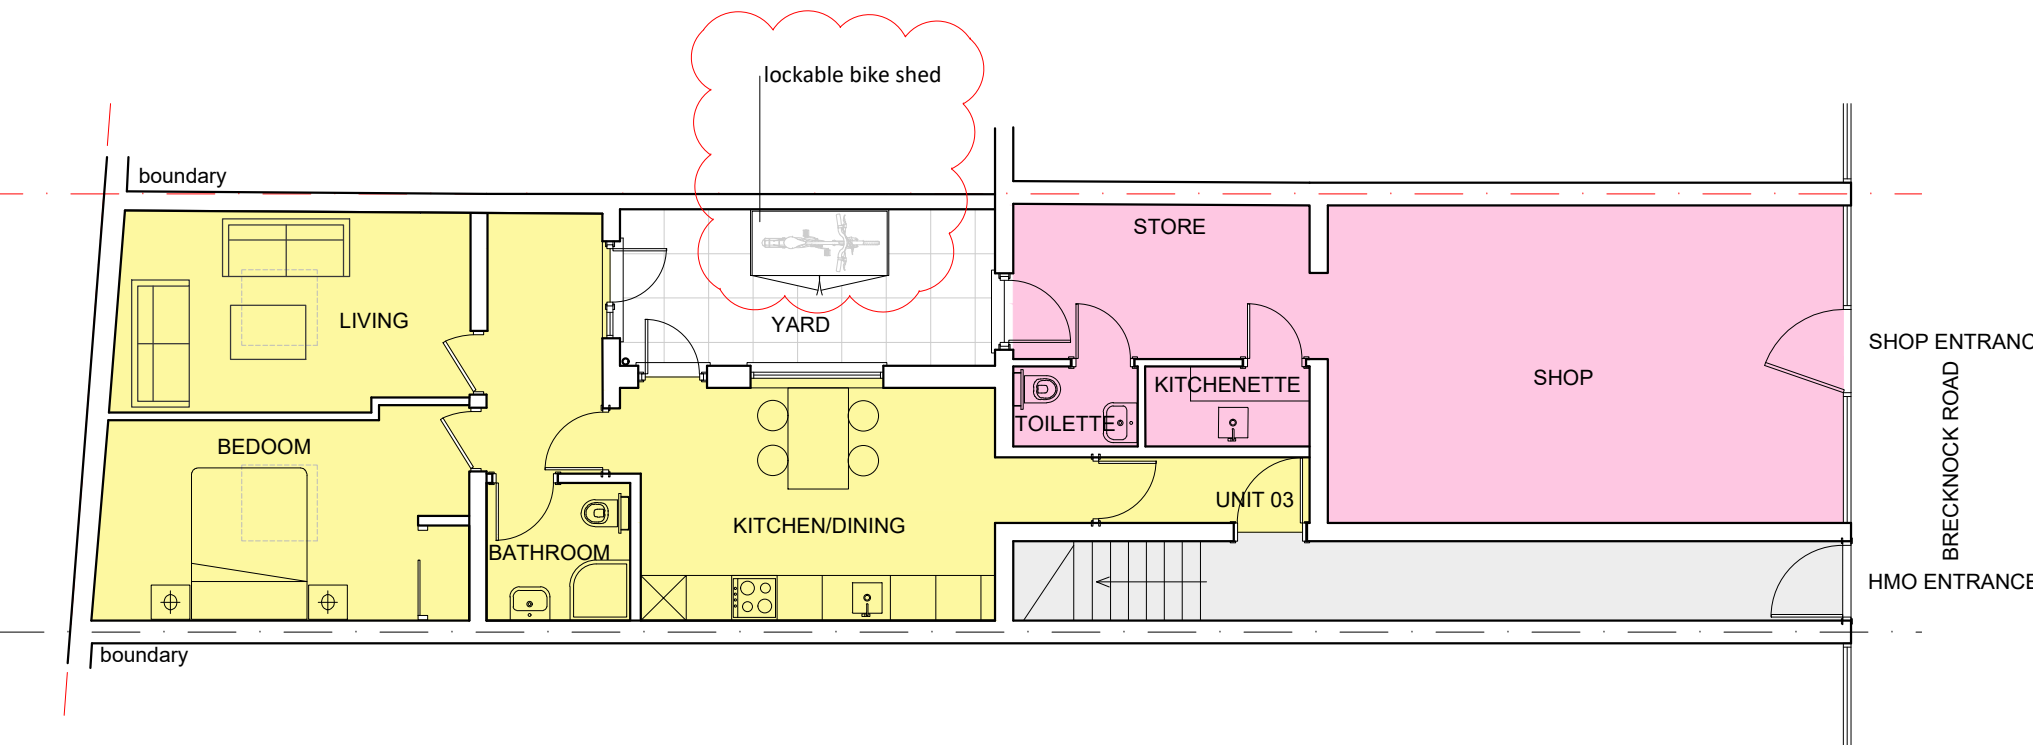

**GROUND FLOOR PLAN
AS BUILT**

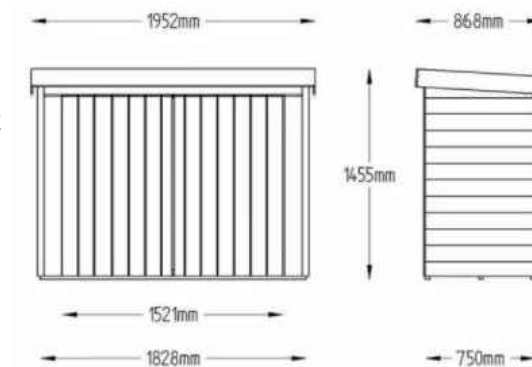

Wooden, double door
lockable bike shed by Sheds Direct

01	25.11.21	Bicycle shed added
00	10.05.21	PLANNING

VMA rchitects

21 Sunningfields Road DDI: 020 7936 4222
London NW4 4QR office@vm-arch.com

Job title
5 BRECKNOCK ROAD
LONDON - N7 0BL

Drawing title
PLAN, SECTIONS AND ELEVATIONS
AS BUILT

Scale	Date	Drawn	Checked
1:100@ A3	May 21	SB	VM

Drawing No.	Rev. No.
380 - 110	01