


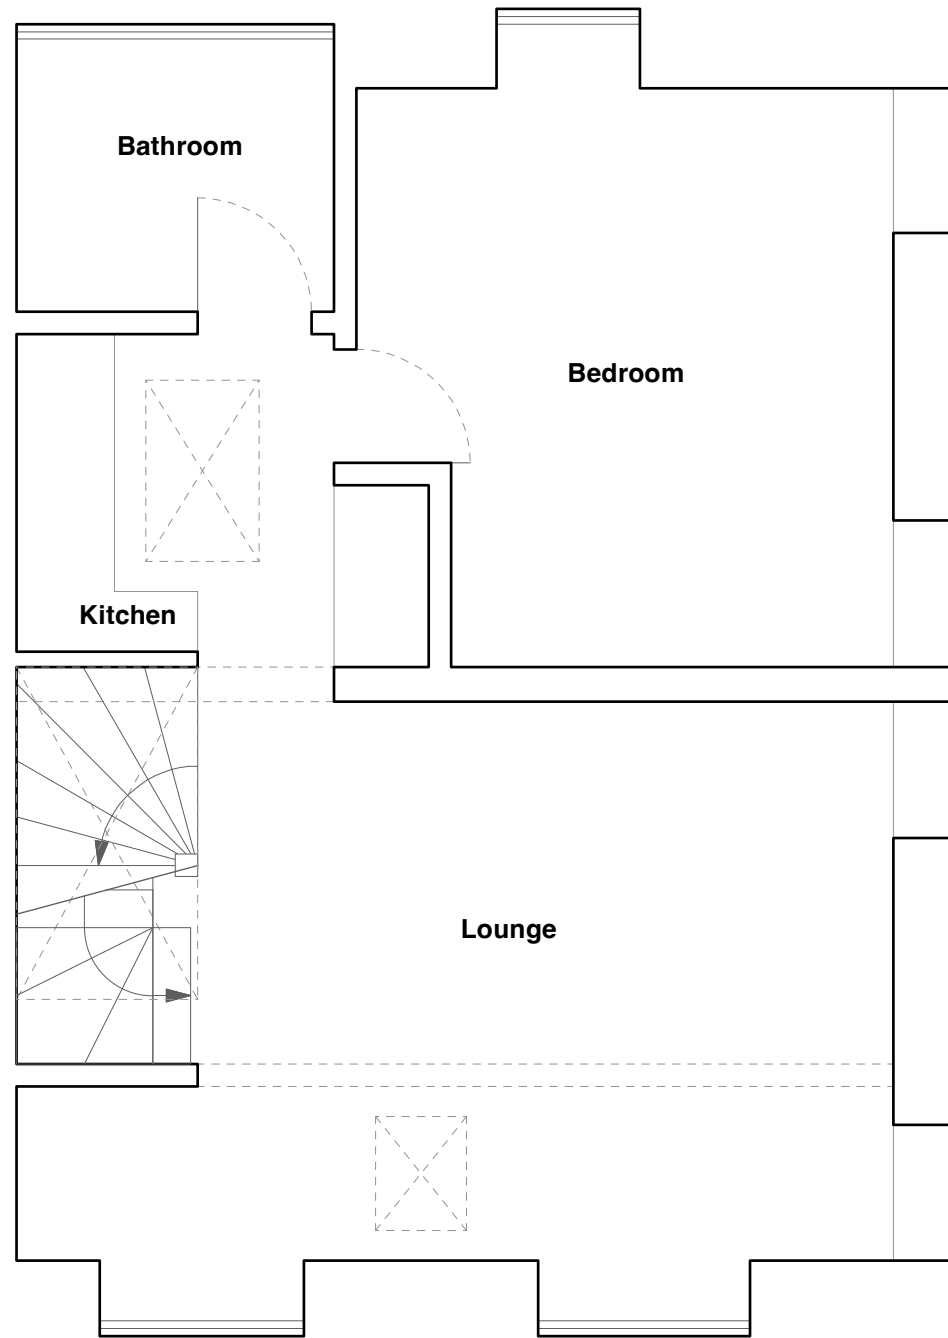


5 M
4
3
2
0

As-Built Floor Plan



As-Built Roof Plan

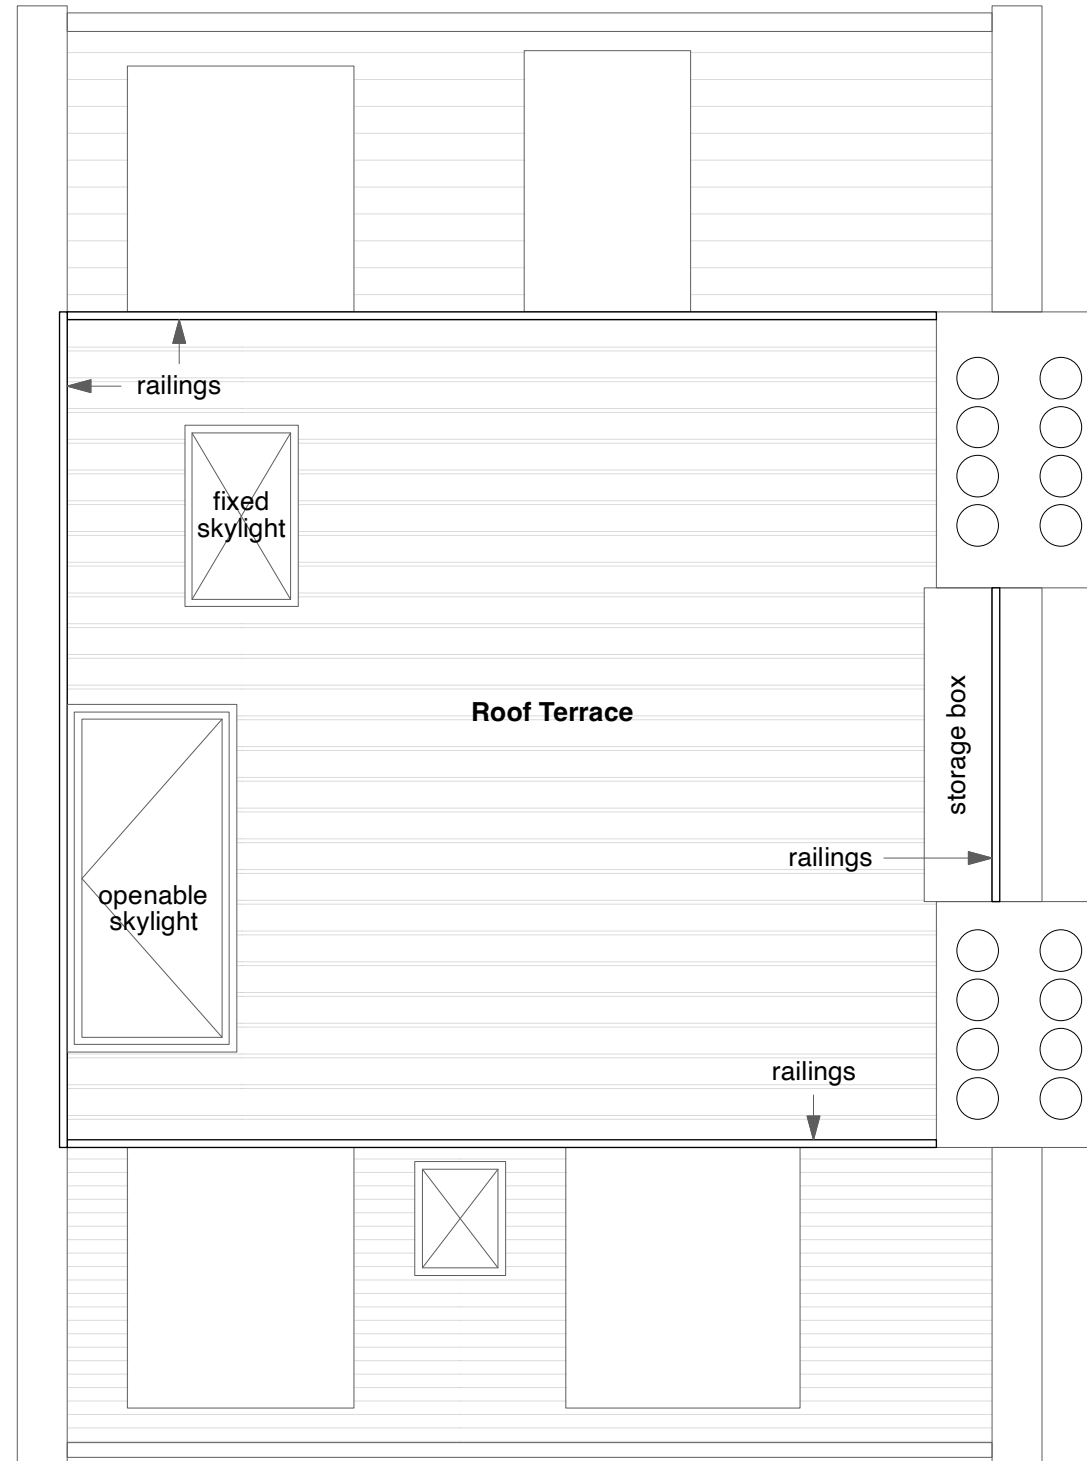

0197[PL]002

A

1:50 @ A3

Floor Plans

[As-Built]

3rd Floor Flat, 27 Pilgrim's Lane
London, NW7

PLANNING

square peg bureau

0208 432 2262 | squarepegbureau.com

[copyright reserved | do not scale this drawing]

"This drawings is prepared solely for design and planning submission purposes. It is not intended or suitable for either Building Regulations or Construction purposes and should not be used for such"