


Elevations


[As-Built]

3rd Floor Flat, 27 Pilgrim's Lane
London, NW7


PLANNING

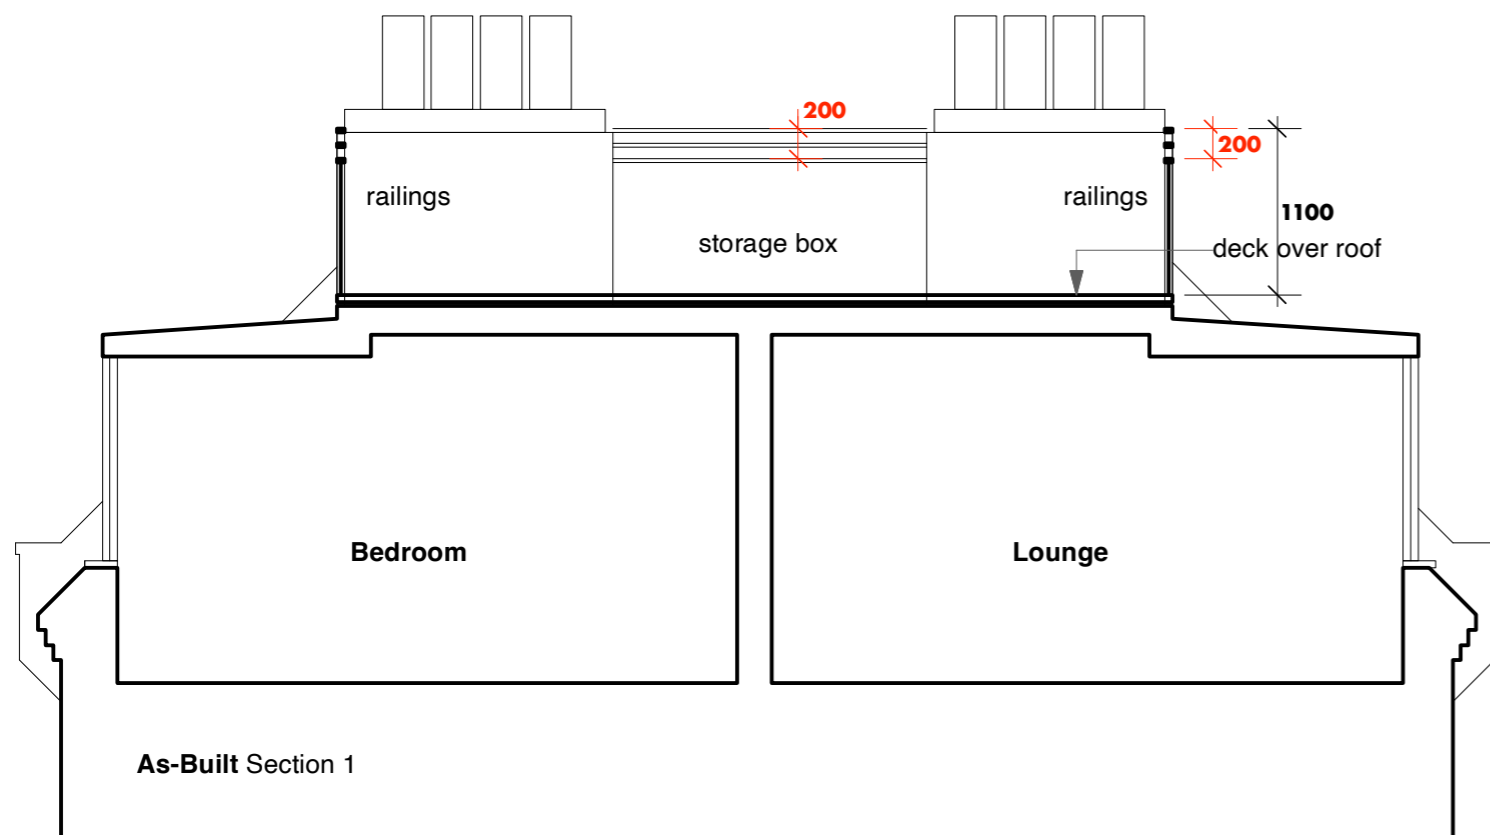

As-Built Section 1

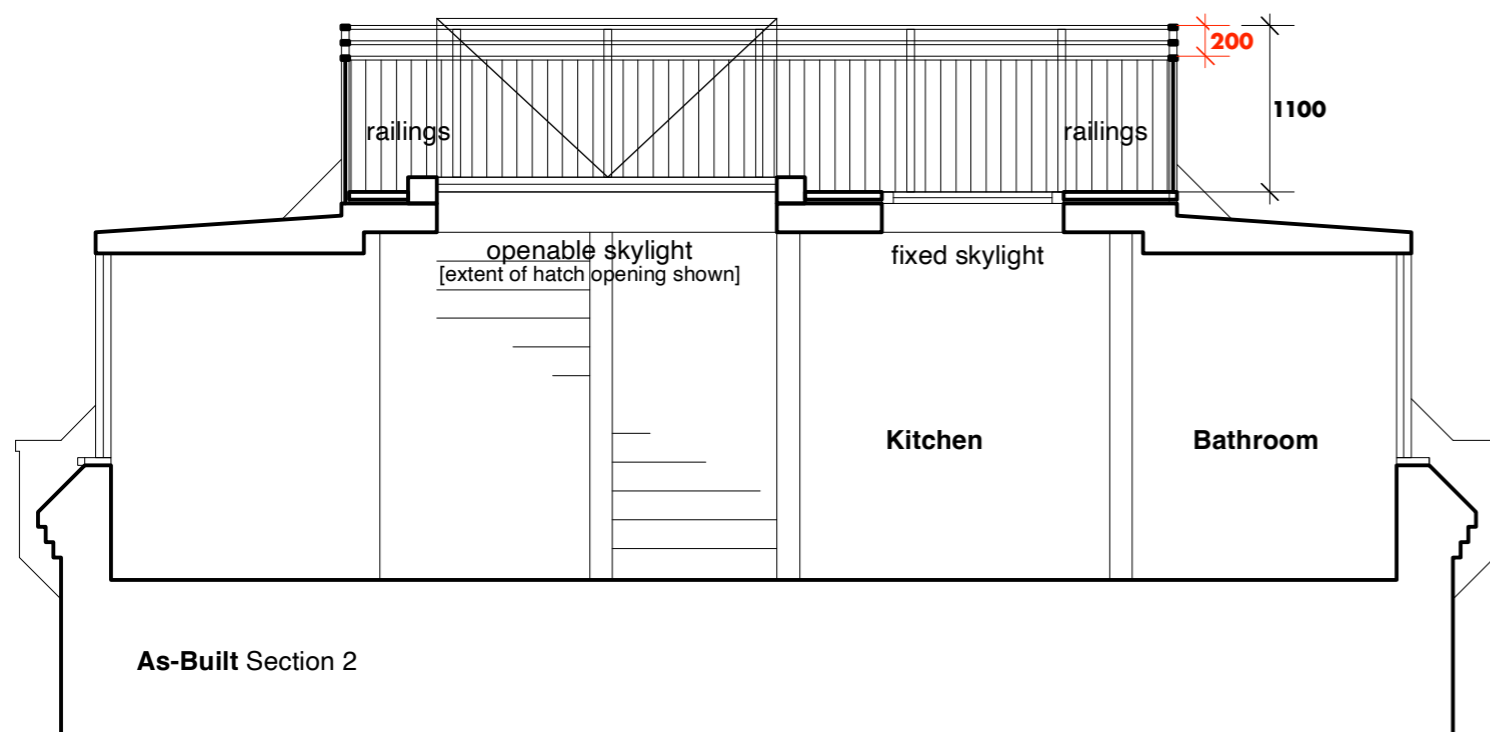

As-Built Section 2

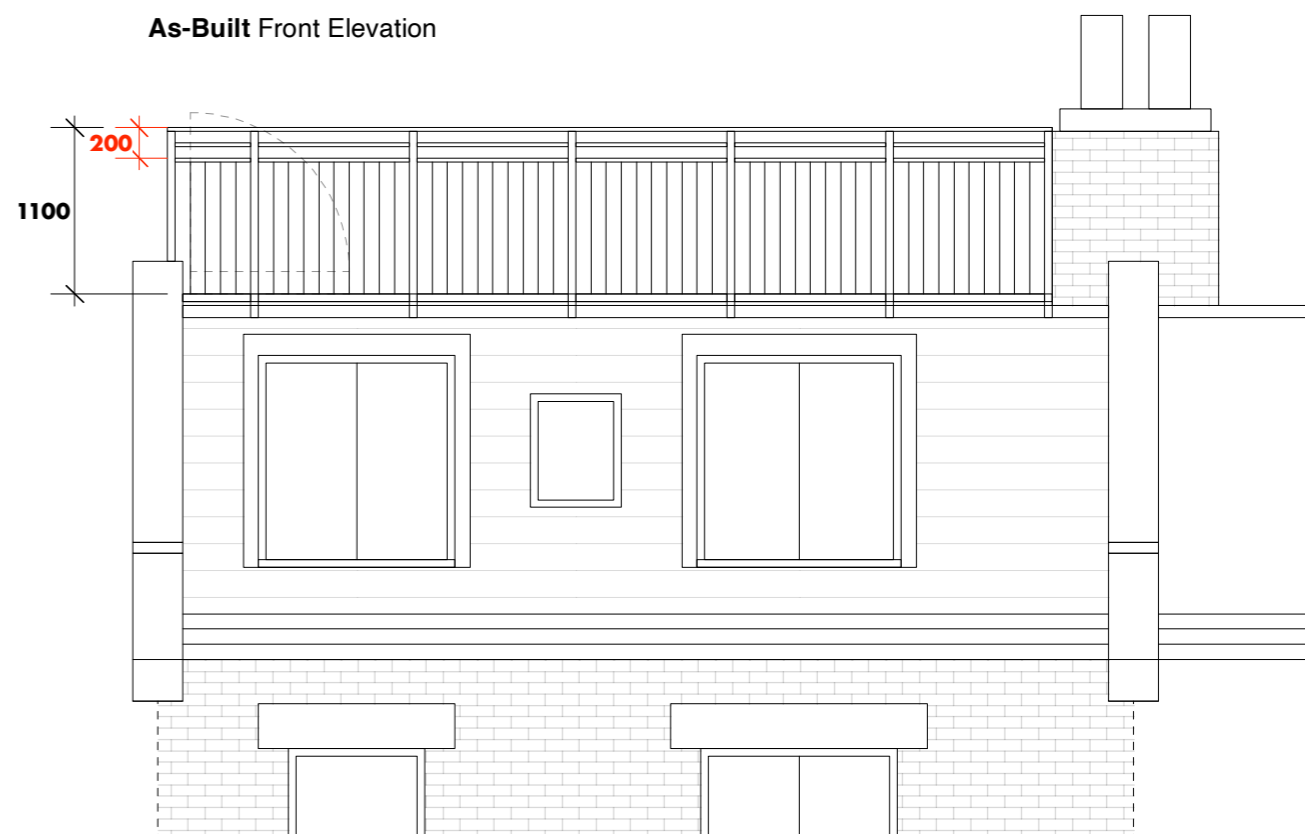

As-Built Front Elevation

square peg bureau