
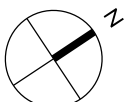


Comparative Ground Floor Plan

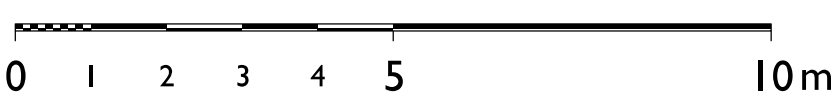

PREVIOUS PROPOSED LAYOUT FROM PLANNING APPLICATION 2020/1357/P INDICATED IN GREEN

XAB

ARCHITECTS
T +44 20 3282 7585 WWW.XAB.CO.UK

Project:
44 CHALCOT ROAD
LONDON, NW1 8LS

Drawing Title:
Proposed Ground Floor
COMPARATIVE PLAN

Project No:
21016

Status:
PRELIMINARY

Scale:
1:100 @ A3

Drawing No.

150-G PI

Revision:

This drawing must not be scaled for construction.