


Comparative Long Section A-A



**PREVIOUS PROPOSED LAYOUT FROM  
PLANNING APPLICATION 2020/1357/P  
INDICATED IN GREEN**

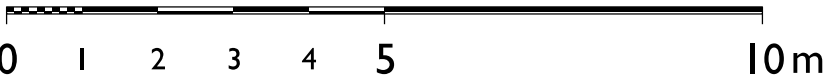

Project:  
**44 CHALCOT ROAD  
LONDON, NW1 8LS**

Drawing Title:  
**Comparative Long Section  
SECTION A-A**

Project No:  
**21016**

Status:  
**PRELIMINARY**

Scale:  
**1:100 @ A3**

Drawing No.

**351**

Revision:

**PI**

This drawing must not be scaled for construction.