




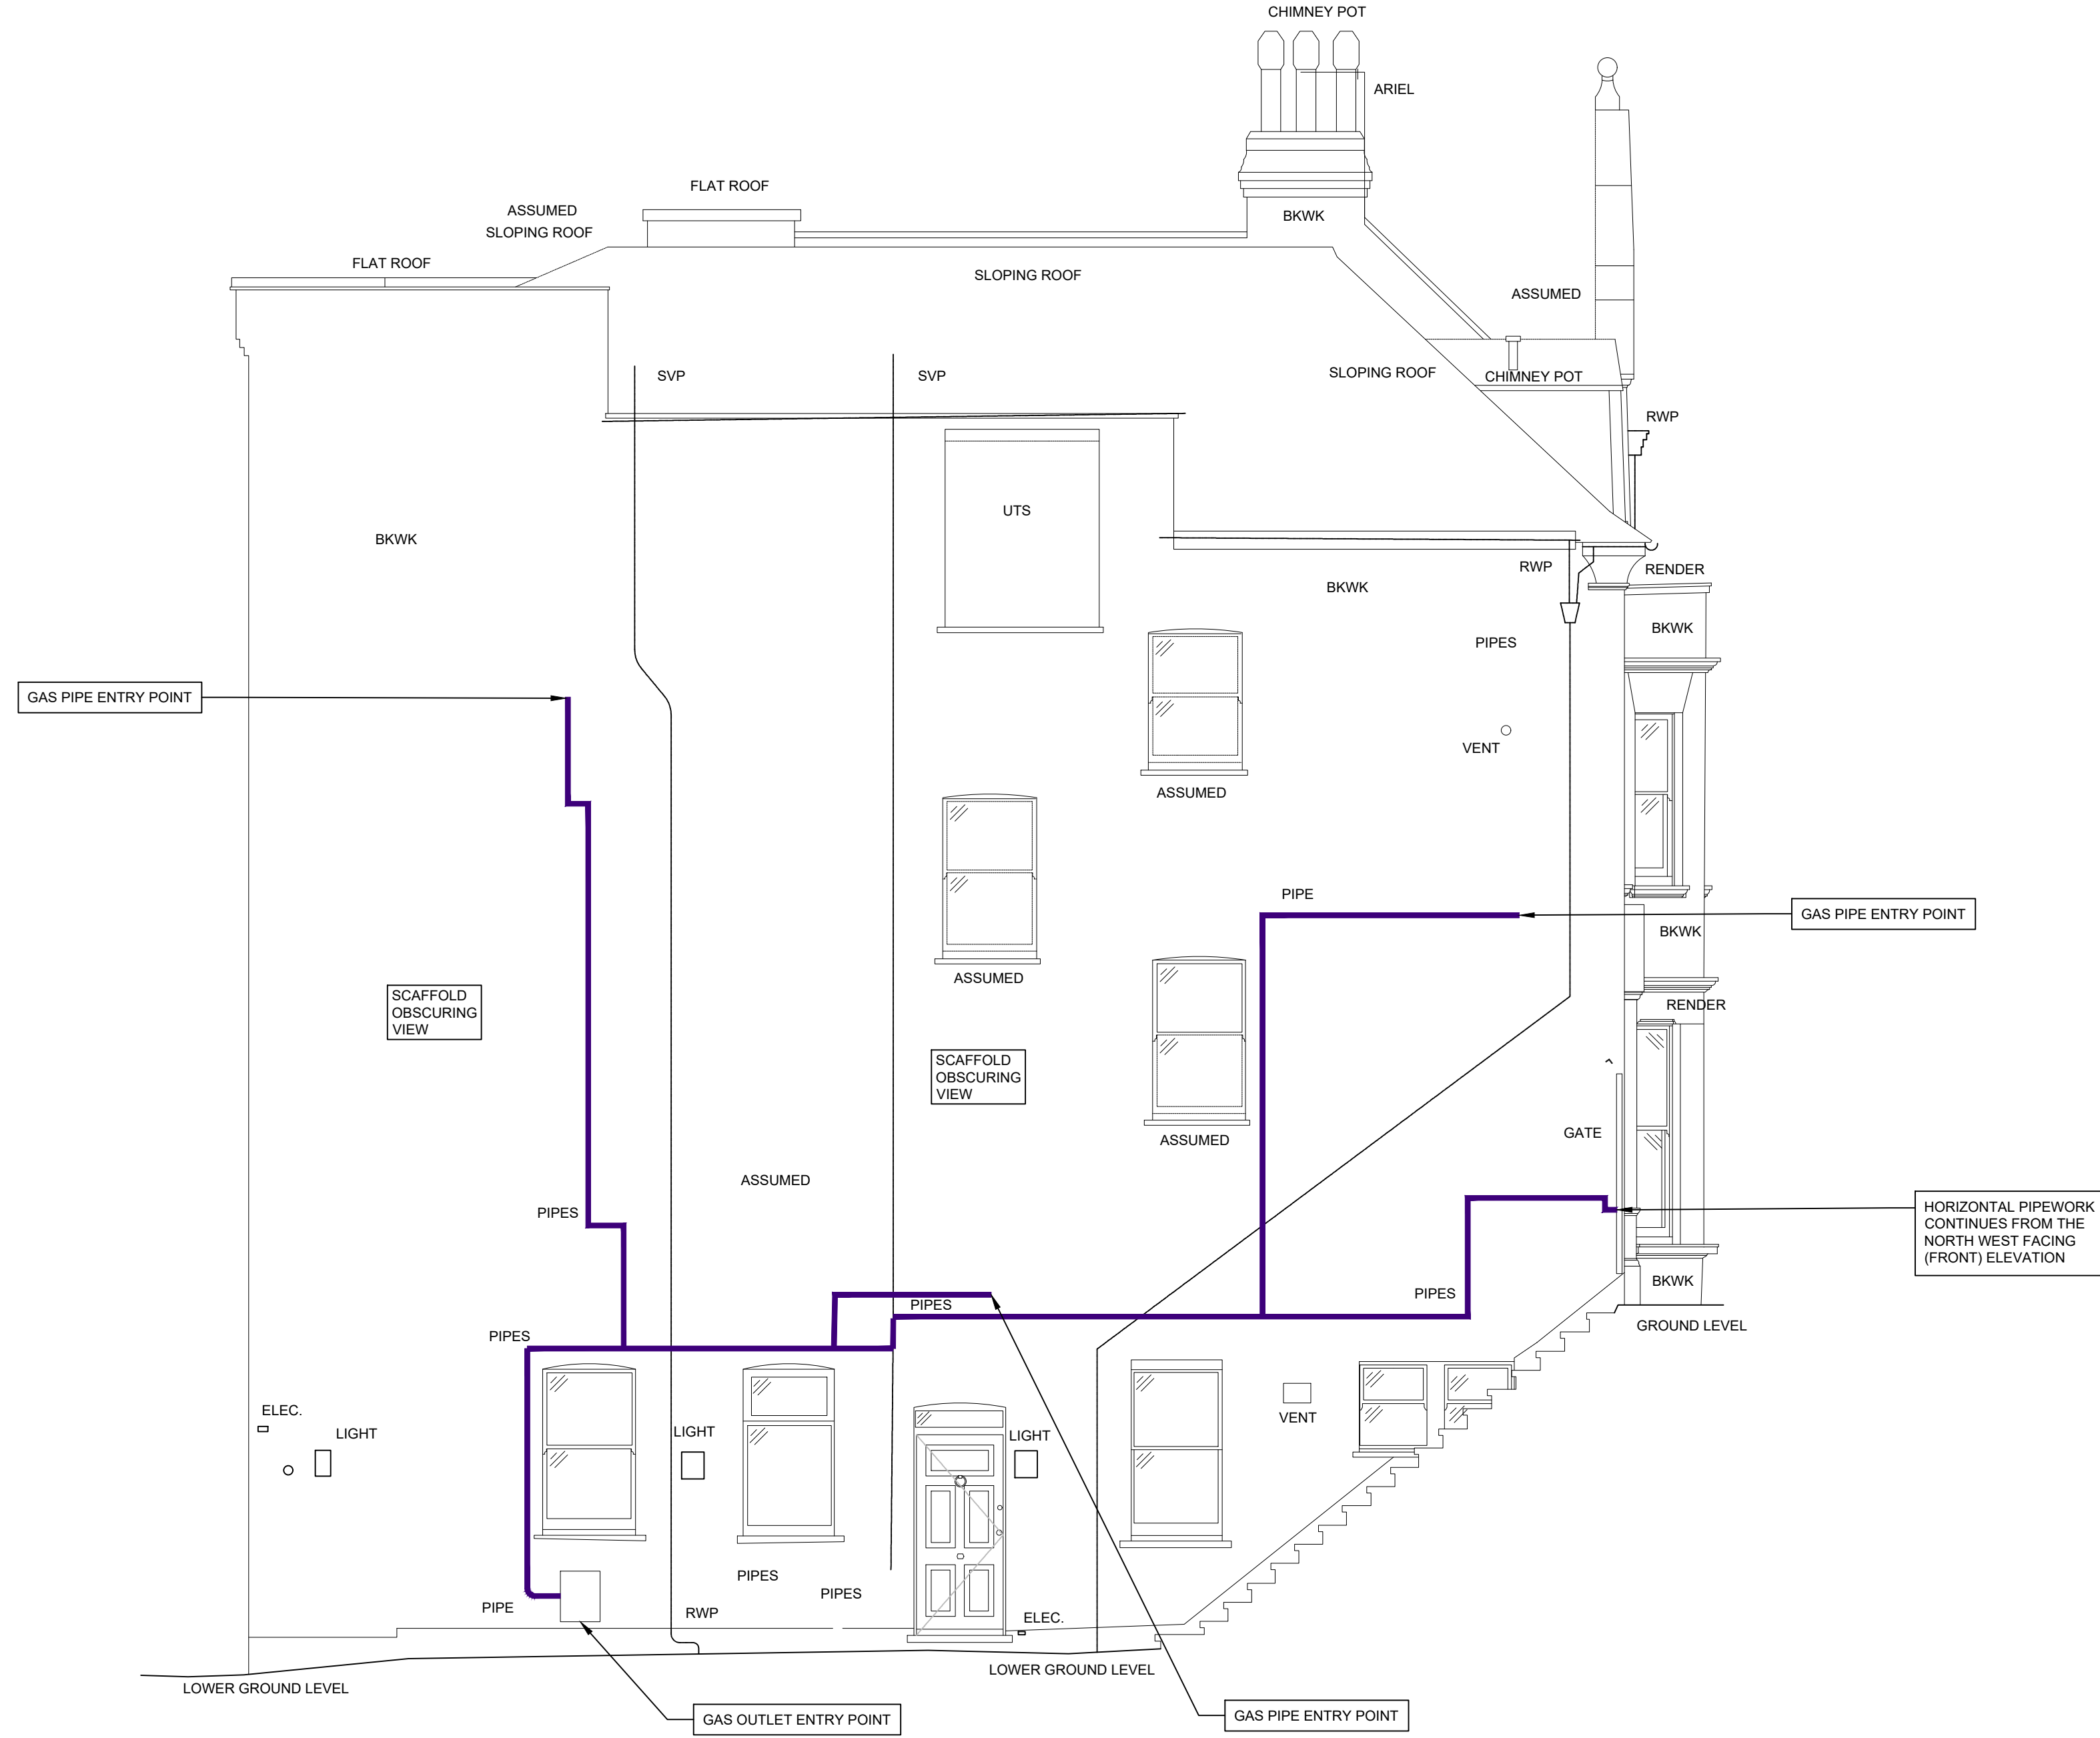

ELEVATION 1  
(NORTH WEST FACING (FRONT) ELEVATION)

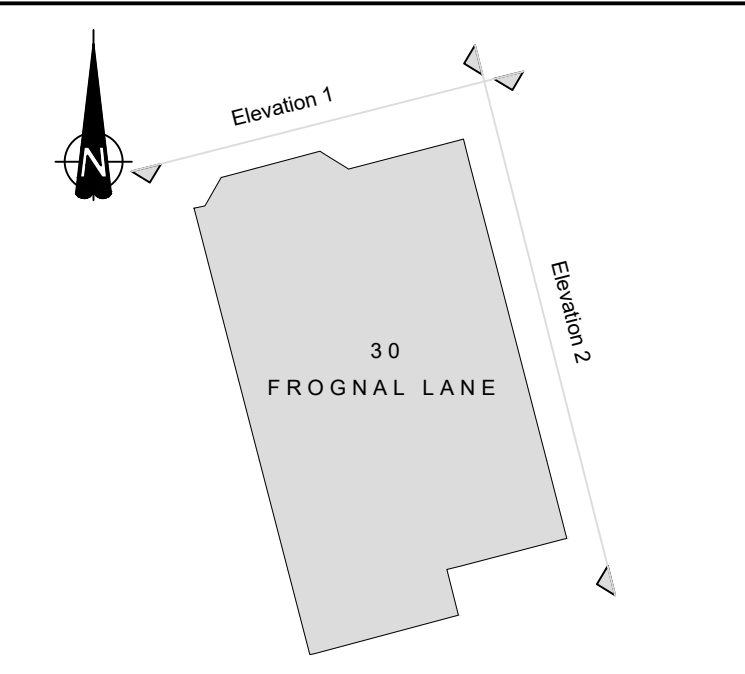

ELEVATION 2  
(NORTH EAST FACING (SIDE) ELEVATION)

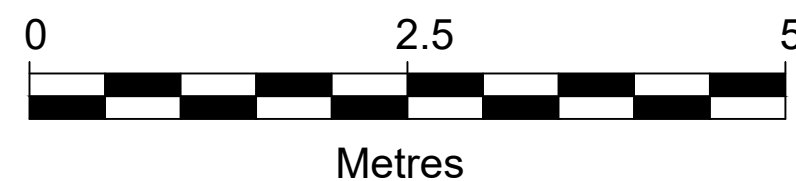

KEY PLAN  
SCALE 1:250

KEY

EXTENT OF NEW EXTERNAL GAS PIPEWORK

A	FIRST ISSUE		10/12/21	SJ	CB
REVISION	DETAILS		DATE	DESIGNED	CHECKED
CLIENT					
CADENT GAS LIMITED					
PROJECT					
30 FROGNAL LANE					
DRAWING TITLE					
AS INSTALLED ELEVATIONS PLAN					
DRG No.		CA12372-005		REV	
DRG SIZE		SCALE		DATE	
A1		1:50		24-11-21	
DRAWN BY		CHECKED BY		APPROVED BY	
DR		SJ		CB	
<div><div><div>■</div><div>STOKE ON TRENT   TEL 01742 276700</div><div>WWW.WARDELL-ARMSTRONGS.COM</div></div><div><div><div><div><div></div><div></div><div></div><div></div><div></div><div></div><div></div><div></div><div></div><div></div><div></div><div></div><div></div><div></div><div></div><div></div><div></div><div></div><div></div><div></div><div></div><div></div><div></div><div></div><div></div><div></div><div></div><div></div><div></div><div></div><div></div><div></div><div></div><div></div><div></div><div></div><div></div><div></div><div></div><div></div><div></div><div></div><div></div><div></div><div></div><div></div><div></div><div></div><div></div><div></div><div></div><div></div><div></div><div></div><div></div><div></div><div></div><div></div><div></div><div></div><div></div><div></div><div></div><div></div><div></div><div></div><div></div><div></div><div></div><div></div><div></div><div></div><div></div><div></div><div></div><div></div><div></div><div></div><div></div><div></div><div></div><div></div><div></div><div></div><div></div><div></div><div></div><div></div><div></div><div></div><div></div><div></div><div></div><div></div><div></div><div></div><div>