



PLEASE NOTE:

1. All dimensions to be checked on site before fabrication,
2. Contractor to refer to engineers drawings before proceeding with works.
3. All drawings and designs are covered by design right (intellectual property), and may not be distributed, copied or issued without written permission by the Architect.
4. All design concepts are the sole property of the Architect and no adaptations, reproductions or copies may be made without written permission of the Architect.
5. These drawings are subject to any variation required or recommendation by any statutory authority, or for the better carrying out of the works.
6. Samples to be provided by contractor for XUL Architecture's approval.
7. All finishes to XUL Architecture's satisfaction.
8. All drawings to be approved by XUL Architecture prior to construction.

ADDITIONAL NOTE:

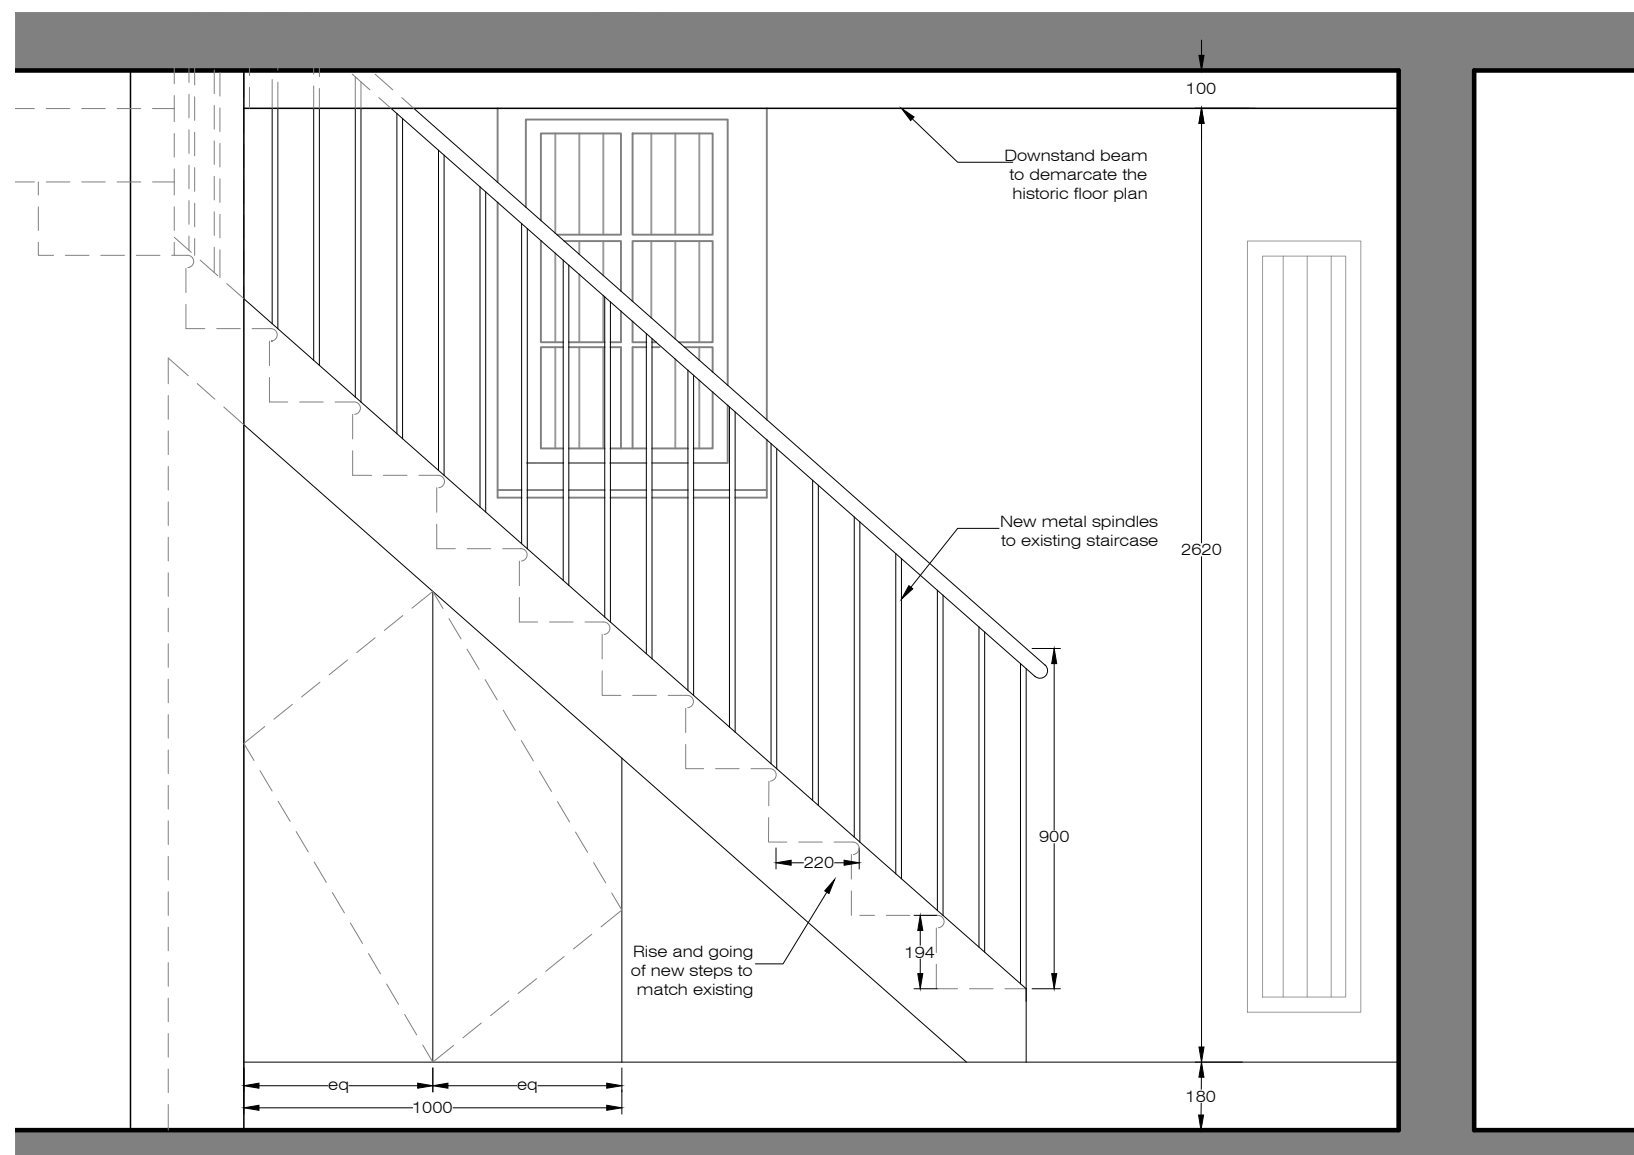

X PROPOSED
Staircase Detail - Section SS 1:20@A3

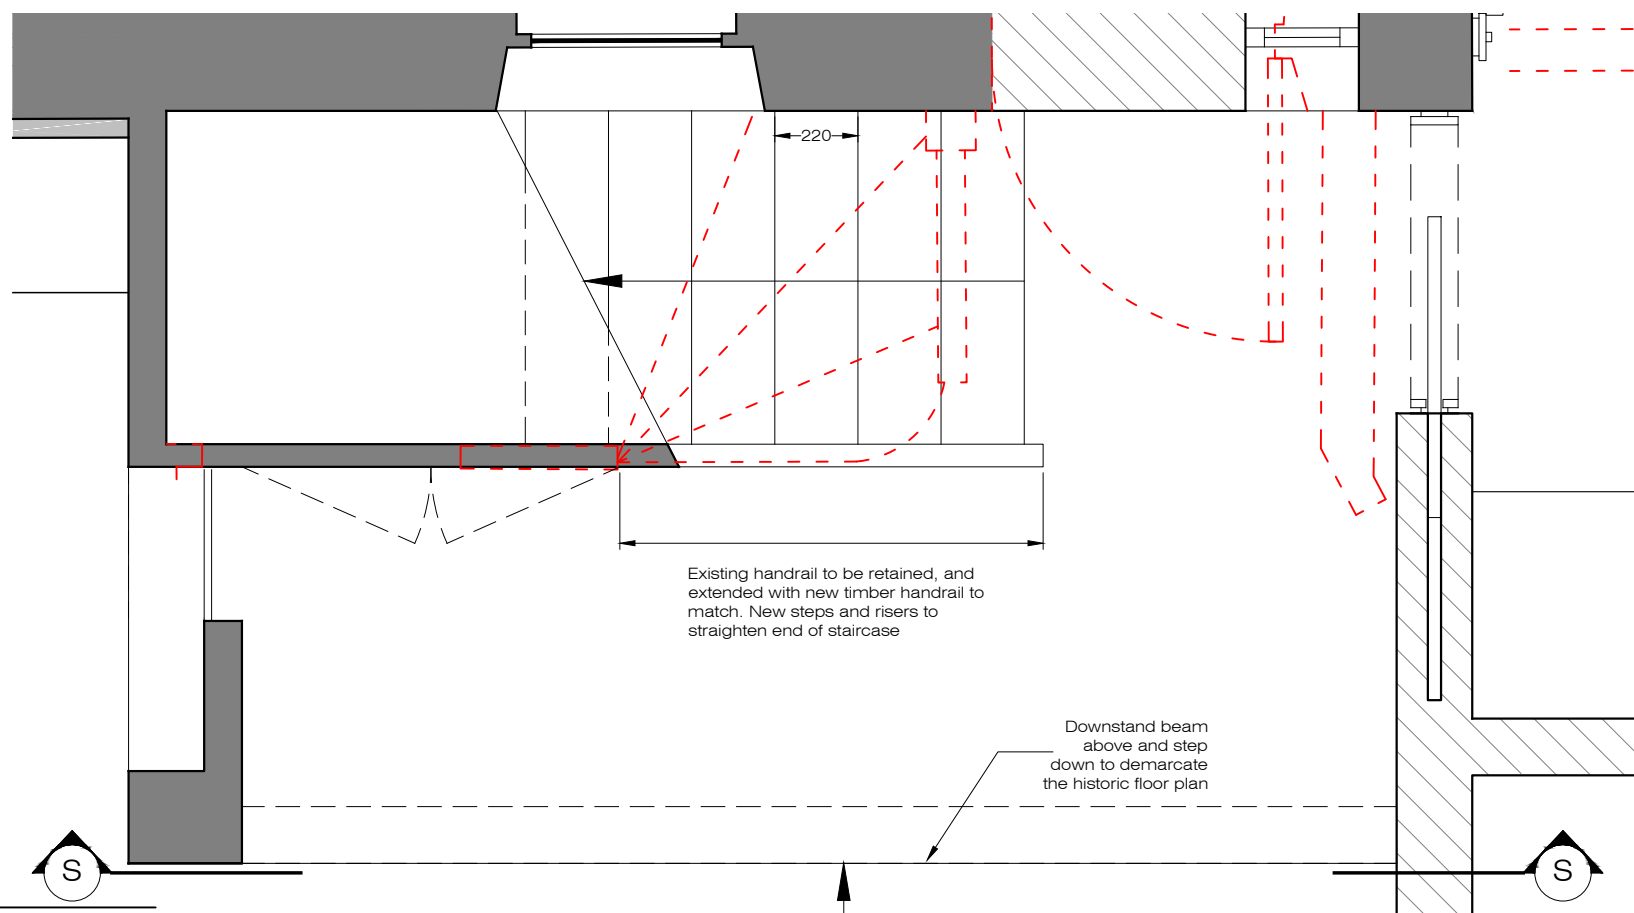

X PROPOSED
Staircase Detail - Plan 1:20@A3

Issue key:	Tender (T)
Information (I)	Construction (C)
Planning (P)	As Built (B)

Project Address
6 Provost Rd, NW3 4ST

PROPOSED
LGF - Staircase Detail

Scale 1:20@A3	Dwg. No. DD-01
------------------	-------------------

Rev. Date 16.12.21	Rev. P-01
-----------------------	--------------

Drawn AT	Project Number 21155
-------------	-------------------------

Checked SS	Issue For: PLANNING
---------------	------------------------