



1 LEVEL 9
PLAN - AS EXISTING 1:100 @ A1

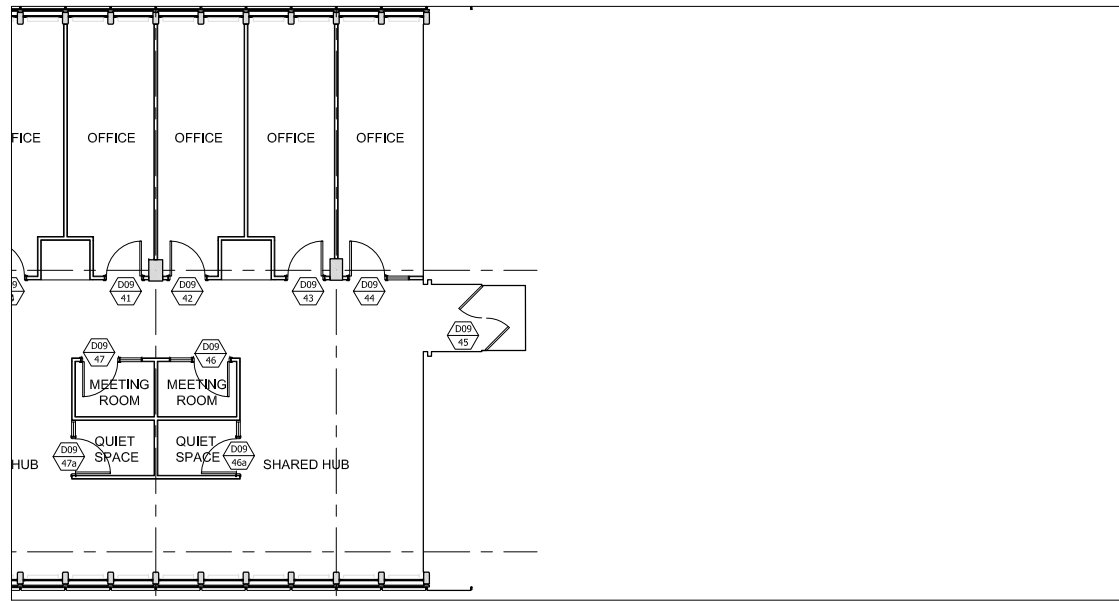

2 LEVEL 9
STAGE 4 PLAN - AS PROPOSED 1:100 @ A1

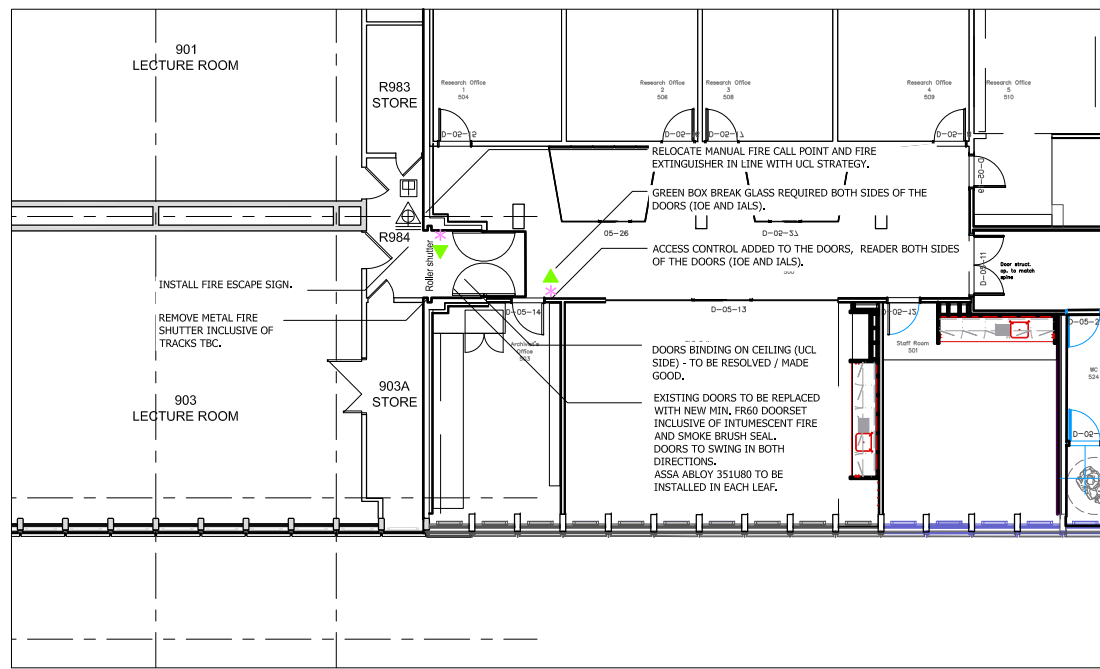


3 LEVEL 9
ENABLING WORKS - AS PROPOSED 1:100 @ A1

LEVEL 9 SCOPE OF WORKS

- SPECIALIST CONTRACTOR TO COMPLETE REMOVAL OF ASBESTOS PRIOR TO ANY WORKS.
- REMOVE METAL FIRE SHUTTER INCLUSIVE OF TRACKS. POSSIBLE USE AS CONDUIT FOR CARD ACCESS AND GREEN BOX BREAK GLASS - LISTED CONSENT - TBC?
- REMOVE ALL CEILINGS / BOXINGS IN RECESS AREA OF DOORS, DOORSET AND EXPOSED SOFFIT FOR DECORATION.
- REMOVE CARPET TILES AND SKIRTINGS (ENABLING/FINAL).
- REDO MOVEMENT JOINT - EXACT SCOPE / SPECIFICATION TO BE CONFIRMED ONCE ASBESTOS CLEARED AND DEPTH VISIBLE - WIDTH NOTED AS 40MM.
- REMOVE DOOR AND FRAME.
- RETAIN EXISTING FLOOR SPRINGS.
- EXISTING UCL DOORSET TO BE REPLACED WITH NEW MIN. FD60S DOORSET INCLUSIVE OF INTUMESCENT FIRE AND SMOKE BRUSH SEALS. DOORS TO SWING IN BOTH DIRECTIONS ON RETAINED FLOOR SPRINGS.
- DOORS TO BE A LAMINATE FINISH. IOE SIDE COLOUR GRAPHITE (F7837). IALS SIDE COLOUR BLUE (ABET LAMINATI - 850 BLEU RADA SET). SUBMIT SAMPLES / OPTIONS FOR APPROVAL.
- NEW FR60 IRONMONGERY TO SUIT DOUBLE SWING / FIRE ESCAPE / CARD ACCESS.
- INSTALL ASSA ABLOY - 351U80 IN EACH DOOR LEAF.
- ALLOW TO MAKE GOOD TO MATCH EXISTING IALS IF REQUIRED.
- ALLOW FOR NEW WALL FINISHES AS MAIN WORKS.
- ALLOW FOR NEW FLOOR FINISHES AND SKIRTINGS AS MAIN WORKS.
- ALLOW FOR CEILINGS AND LIGHTING AS MAIN WORKS INCLUSIVE OF ILLUMINATED FIRE ESCAPE SIGN.
- INSTALL ACCESS CONTROL AND GREEN BOX BREAK GLASS BOTH SIDES. AGREE LOCATION OF CARD ACCESS / BREAK GLASS ON IALS SIDE - ALL FLOORS.
- RELOCATE EXISTING MANUAL FIRE CALL POINT AND FIRE EXTINGUISHER IN LINE WITH UCL FIRE STRATEGY.

LEGEND

- AREA OUTSIDE SCOPE OF WORKS, EXCEPT FOR MAKING GOOD WHERE DISTURBED
- BREAK GLASS GREEN BOX
- ACCESS CONTROL
- DISABLED FIRE SHUTTER WELDED SHUT. WORKS TBC
- FIRE EXTINGUISHER (WATER)
- MANUAL FIRE ALARM CALL POINT
- S22 FIRE SAFETY SIGN - FIRE EXIT

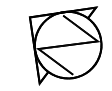

© Architon LLP 2014

This drawing is the property of Architon LLP and must not be divulged to anyone, copied or reproduced, or used for marketing, advertising or promotional purposes without the express written permission of Architon LLP.

All dimensions are to be checked on site and not scaled from this drawing. Contractors must verify all dimensions on site before setting out, commencing work or preparing shop drawings. Any discrepancies on this drawing with other contract documentation to be reported immediately for clarification.

Notes

RECORD / AS BUILT ISSUE

Rev	Description	Date




Job title
University College London
Institute of Education
Phase 2
20 Bedford Way, WC1H 0AL

Drawing title
Level 9
Plan - IALS Doors
Enabling Works

Scale	Date	Drawn
1:100 @A1	Jan 21	PH

ARCHITON LLP
 CHARTERED ARCHITECTS - DESIGN
 PLANNING CONSULTANTS - DEVELOPMENT
 BUILDING COST MANAGEMENT
 REGENCY HOUSE 17 WEST STREET EPSOM KT18 7RL
 TEL:01372 745600 FAX:01372 745016 Email:info@architon.com

Drawing No
3147 - 006
 ARCHITON LLP certified to:
 BS EN ISO 9001
 BS EN ISO 14001
 IIP Accreditation

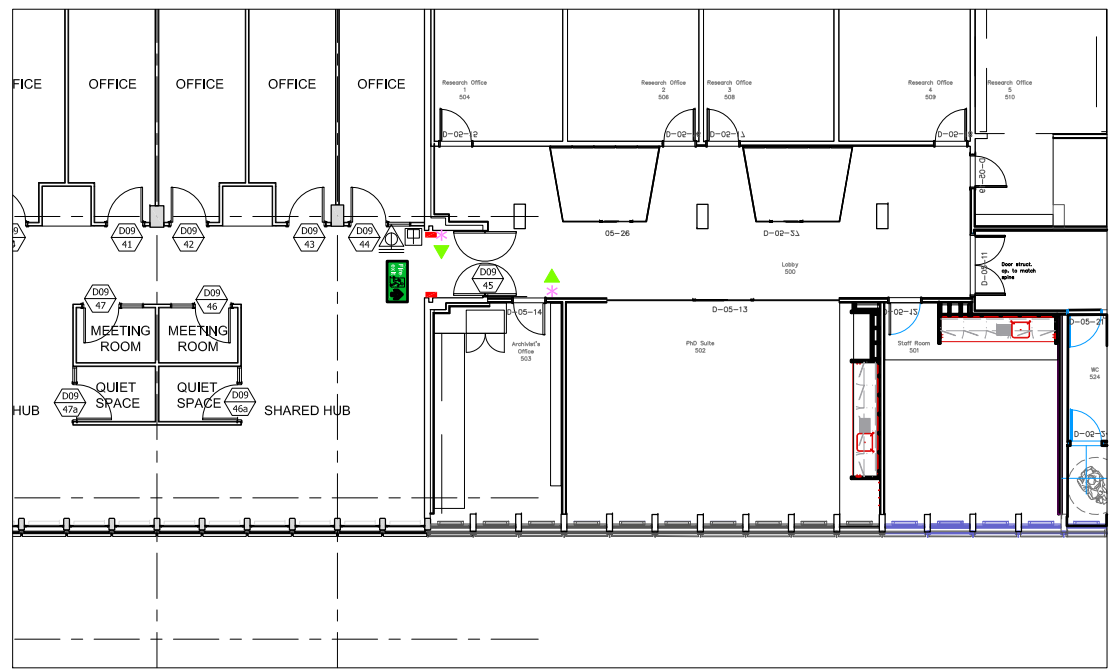

4 LEVEL 9
FINAL 1:100 @ A1

