
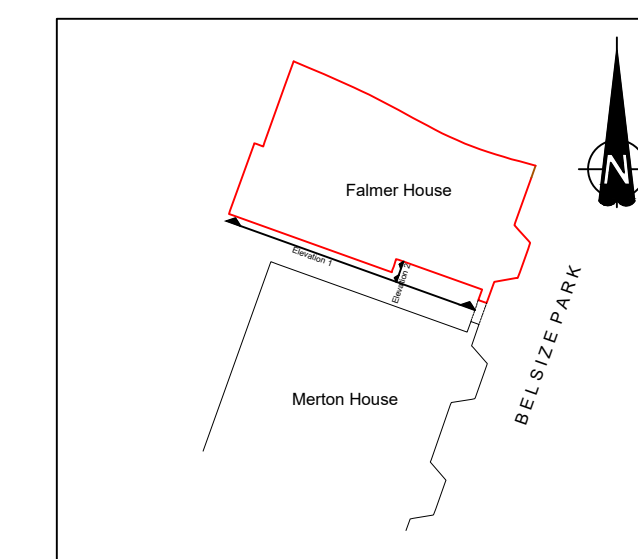


South East Facing Return Elevation  
Elevation 2

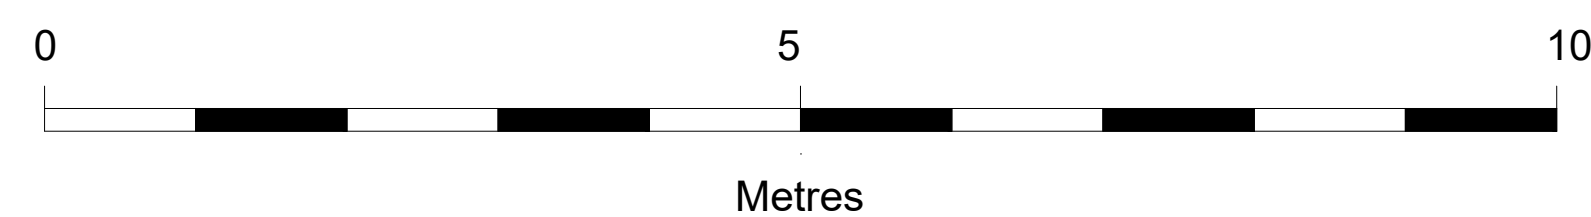

**KEY PLAN**  
SCALE 1:500

KEY

EXTENT OF NEW EXTERNAL GAS PIPEWORK

A	FIRST ISSUE			19-03-22	DR	SJ
HD0050A	DETAILS			DATE	DRAWN	CHECKED
CLIENT						
CADENT GAS LIMITED						
PROJECT						
1 TO 5 FALMER HOUSE						
DRAWING TITLE						
AS INSTALLED ELEVATIONS PLAN						
DRG No.				REV		
CA12446-005				A		
DRG SIZE		SCALE		DATE		
A1		1:50		09/02/22		
DRAWN BY		CHECKED BY		APPROVED BY		
S.J.R		S.I		P.R		

