



GRAYS INN



PRE- EXISTING GROUND FLOOR PLAN

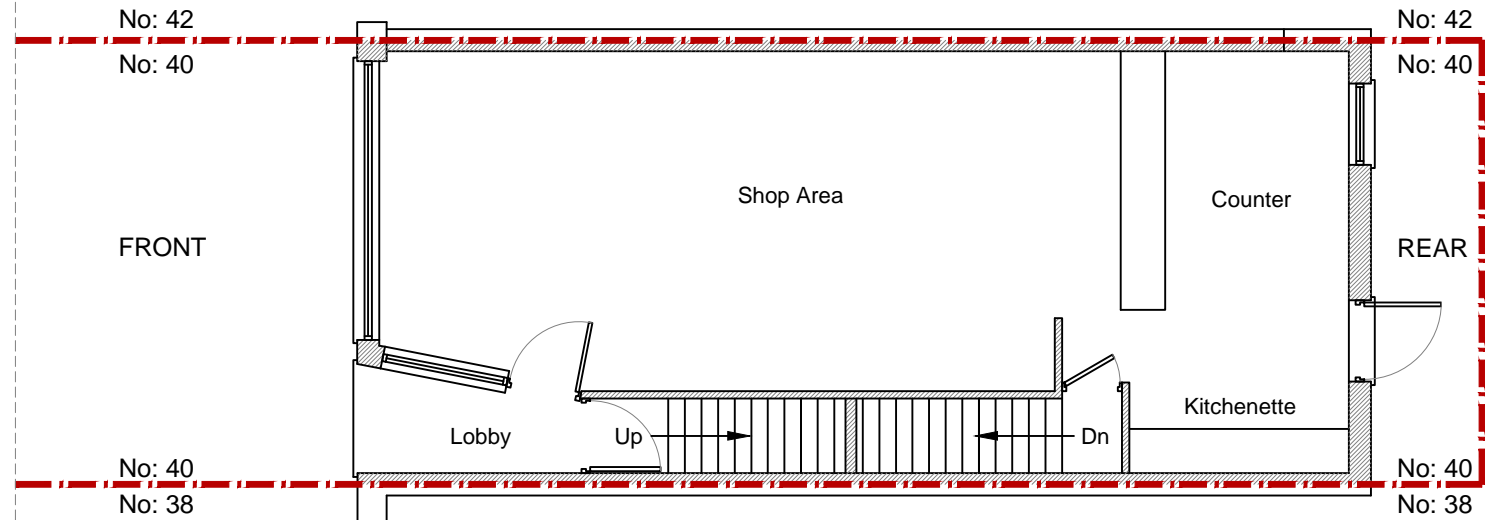


GRAYS INN

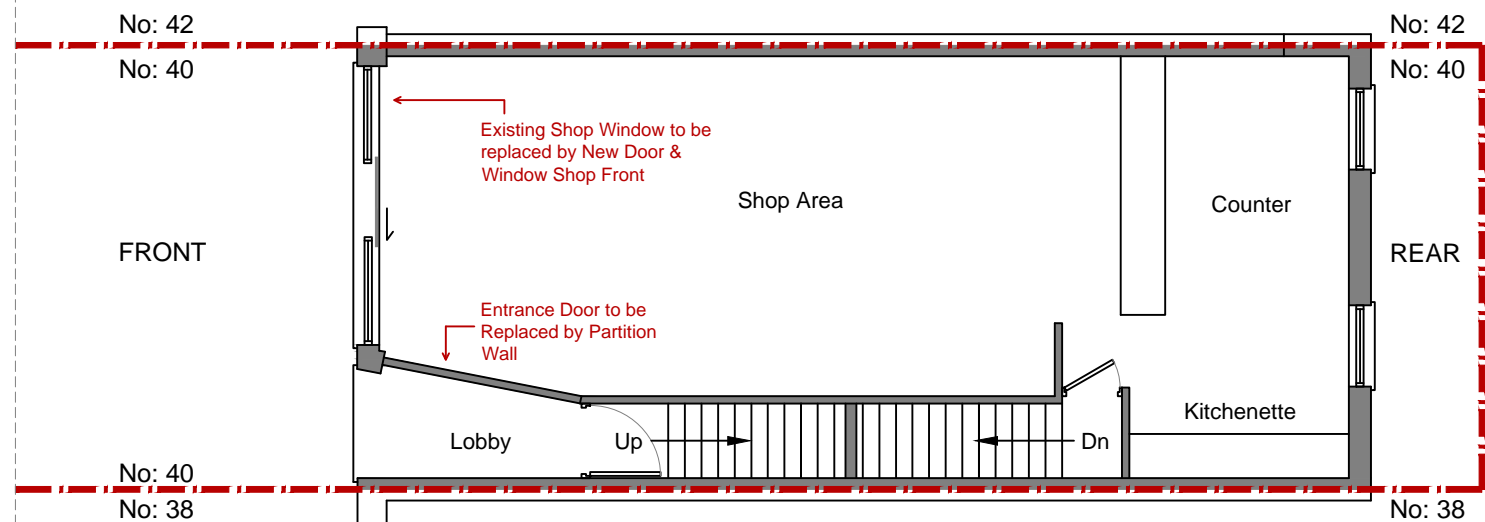

AS BUILT GROUND FLOOR PLAN



			CLIENT  MR SAQLAIN RAZA	PROJECT  40 GRAY'S INN HOLBORN WC1X 8LR	SCALE 1:100@A3	DRAWING NO.	REV.	AARKZ Design Associates		
					DATE OCT 20	DRAWN WN	01			
				DRAWINGS TO BE READ IN CONJUNCTION WITH RELEVANT DRAWING AND SPECS. DRAWINGS NOT TO BE SCALED. FIGURED DIMENSIONS ONLY. ANY DISCREPANCIES ARE TO BE POINTED TO THE ARCHITECT. THE ARCHITECT IS NOT LIABLE FOR ANY FAULTS NOT RAISED. DRAWINGS NOT TO BE SCALED FOR LAND TRANSFER PURPOSES	DRAWING TITLE  PRE-EXISTING & AS BUILT PLAN				186 FOREST ROAD, LOUGHTON, IG10 1EG TEL: 0750 645 9645 E.mail: aarkzdesign@gmail.com	
REV	DATE	NOTES				Meters @ 1:100 @ A3				