



PRE-EXISTING FRONT ELEVATION

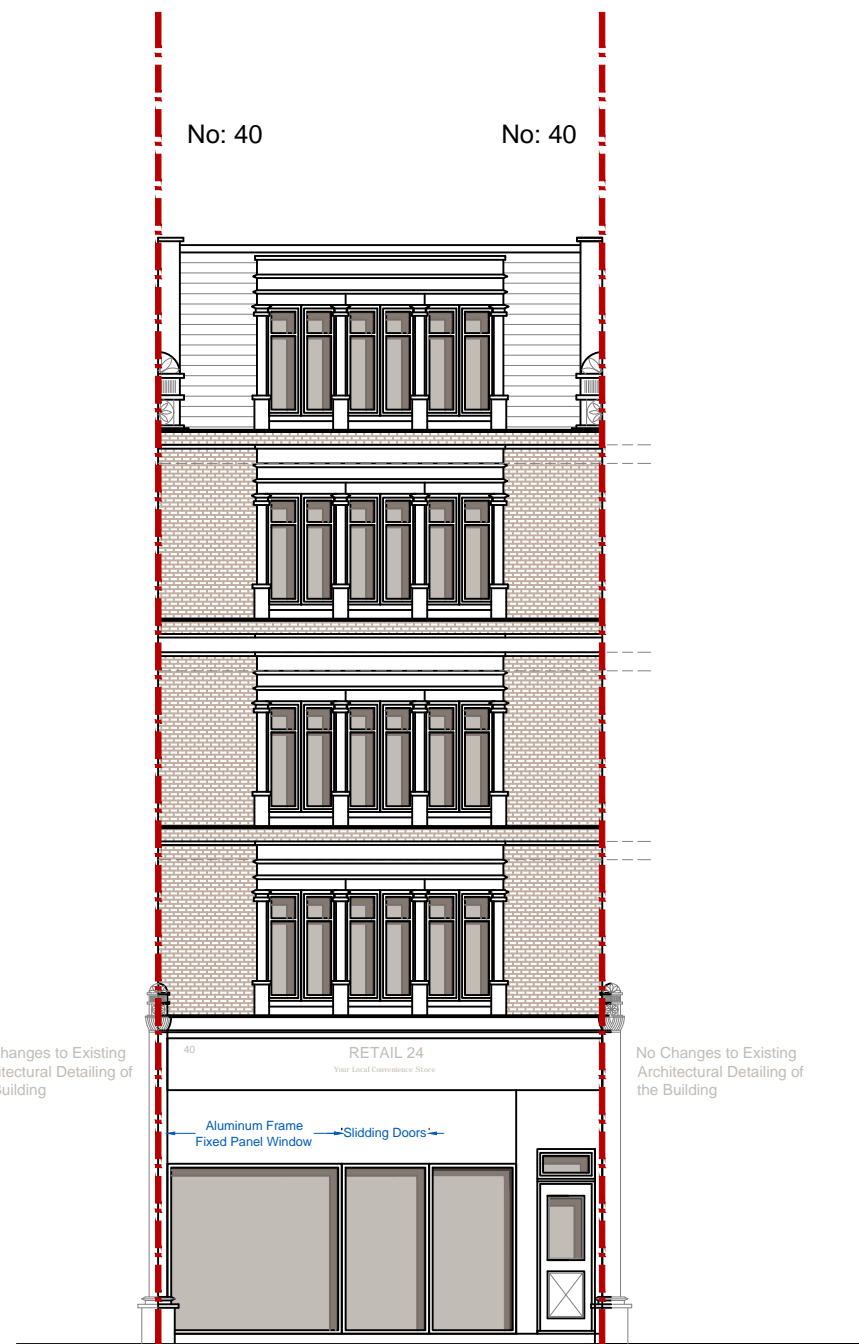

AS BUILT FRONT ELEVATION

			CLIENT MR SAQLAIN RAZA	PROJECT 40 GRAY'S INN HOLBORN WC1X 8LR	SCALE 1:100@A3	DRAWING NO.	REV.	AARKZ Design Associates	
					DATE OCT 20	DRAWN WN	03		
					 Meters @ 1:100 @ A3				
REV	DATE	NOTES	DRAWINGS TO BE READ IN CONJUNCTION WITH RELEVANT DRAWING AND SPECS. DRAWINGS NOT TO BE SCALED. FIGURED DIMENSIONS ONLY. ANY DISCREPANCIES ARE TO BE POINTED TO THE ARCHITECT. THE ARCHITECT IS NOT LIABLE FOR ANY FAULTS NOT RAISED. DRAWINGS NOT TO BE SCALED FOR LAND TRANSFER PURPOSES	DRAWING TITLE PRE-EXISITNG & AS BUILT ELEVATIONS				186 FOREST ROAD, LOUGHTON, IG10 1EG TEL: 0750 645 9645 E.mail: aarkzdesign@gmail.com	