

1. All dimensions to be checked on site before fabrication,
2. Contractor to refer to engineers drawings before proceeding with works.
3. All drawings and designs are covered by design right (intellectual property), and may not be distributed, copied or issued without written permission by the Architect.
4. All design concepts are the sole property of the Architect and no adaptations, reproductions or copies may be made without written permission of the Architect.
5. These drawings are subject to any variation required or recommendation by any statutory authority, or for the better carrying out of the works.
6. Samples to be provided by contractor for XUL Architecture's approval.
7. All finishes to XUL Architecture's satisfaction.
8. All drawings to be approved by XUL Architecture prior to construction.

<u>Issue key:</u>	Tender (T)
Information (I)	Construction (C)
Planning (P)	As Built (B)


EXISTING & PROPOSED
First Floor Plan

Dwg. No.
PA-01

Rev.
-02

Project Number	21006
----------------	-------


Issue For:
INFORMATION

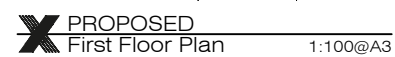


PLEASE NOTE:

1. All dimensions to be checked on site before fabrication,
2. Contractor to refer to engineers drawings before proceeding with works.
3. All drawings and designs are covered by design right (intellectual property), and may not be distributed, copied or issued without written permission by the Architect.
4. All design concepts are the sole property of the Architect and no adaptations, reproductions or copies may be made without written permission of the Architect.
5. These drawings are subject to any variation required or recommendation by any statutory authority, or for the better carrying out of the works.
6. Samples to be provided by contractor for XUL Architecture's approval.
7. All finishes to XUL Architecture's satisfaction.
8. All drawings to be approved by XUL Architecture prior to construction.


ADDITIONNAL NOTE:

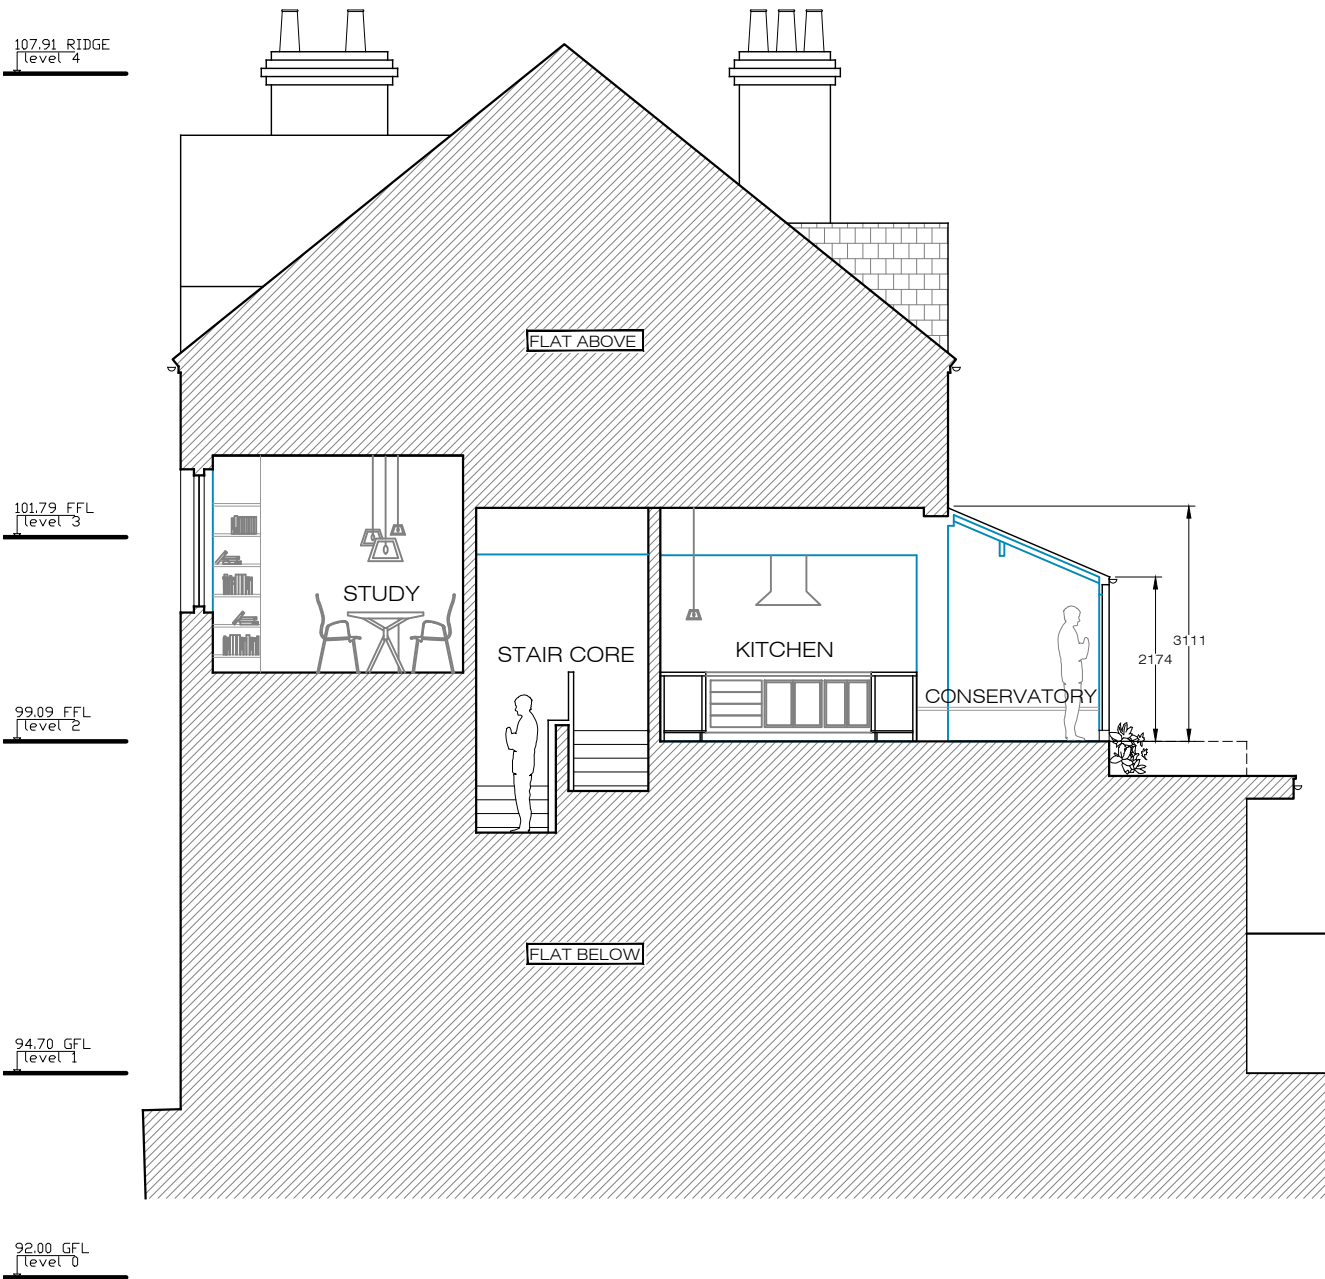

X EXISTING - SIDE SECTION
A-A 1:100@A3

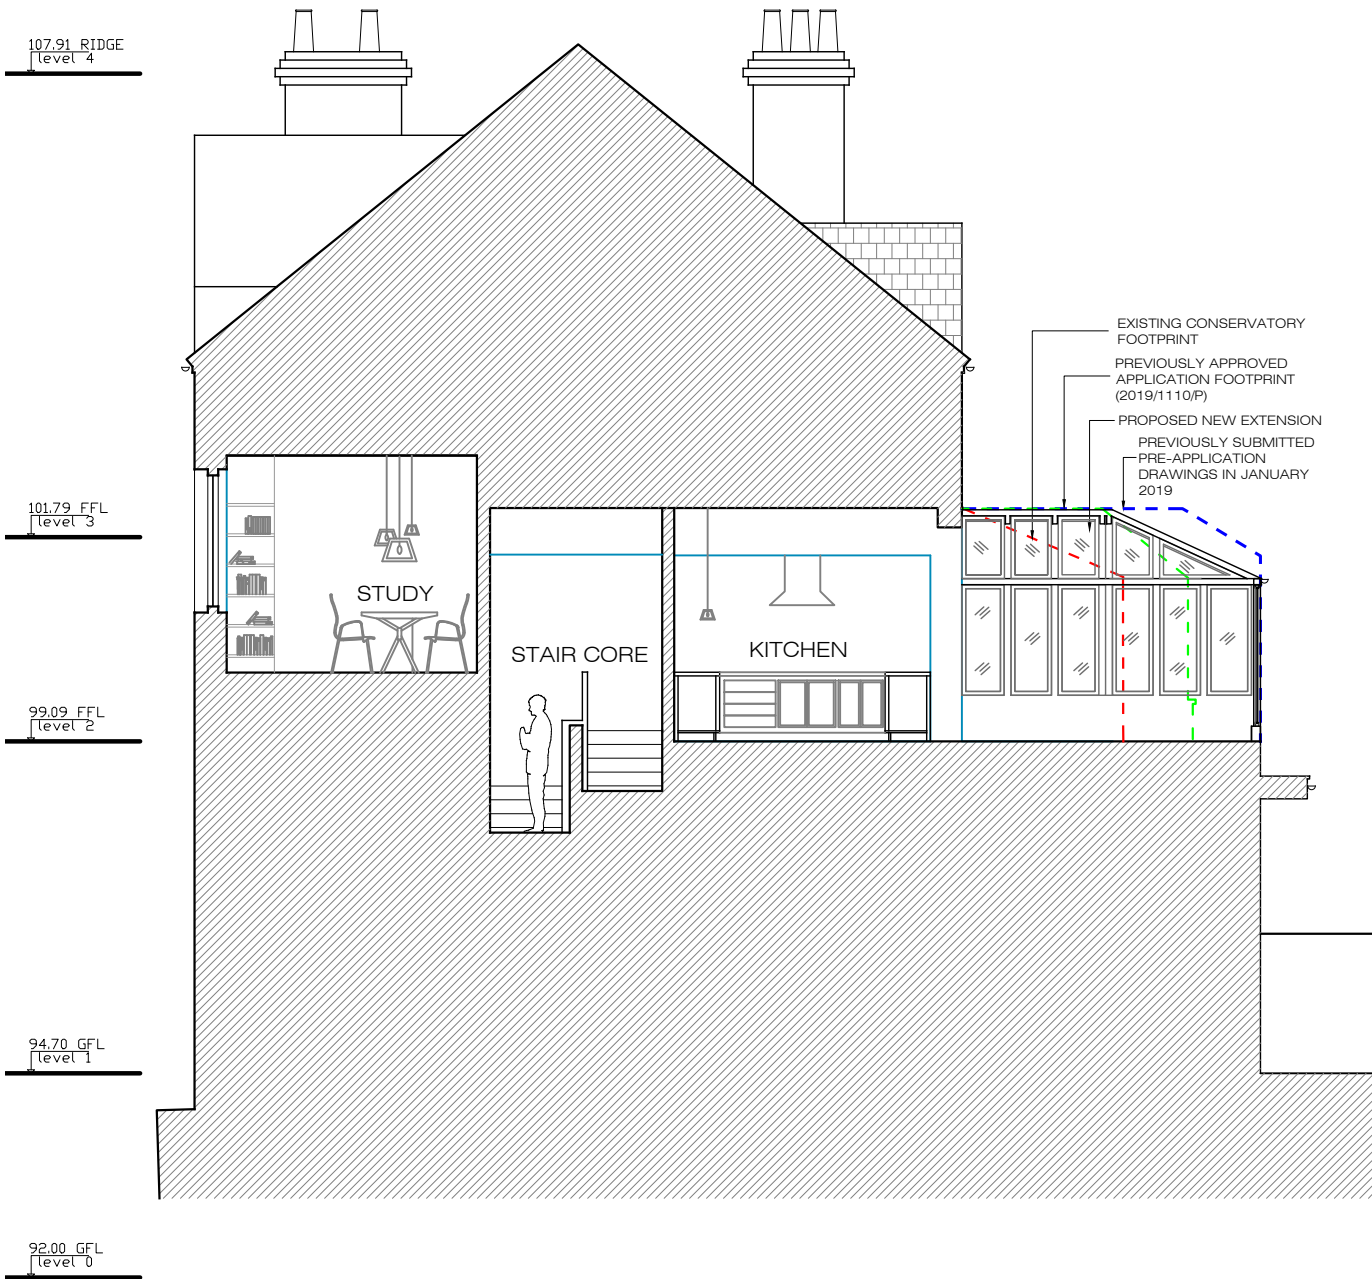

X PROPOSED - SIDE SECTION
A-A 1:100@A3

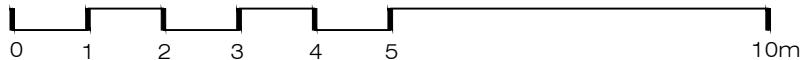

Issue key: Tender (T)
Information (I) Construction (C)
Planning (P) As Built (B)

Project Address
Flat 3, 37 Platt's Lane

EXISTING & PROPOSED
SECTION

Scale 1:100@A3	Dwg. No. PA-02
Rev. Date 13.04.22	Rev. I-02
Drawn SL	Project Number 21006
Checked SS	Issue For: INFORMATION

PLEASE NOTE:

1. All dimensions to be checked on site before fabrication,
2. Contractor to refer to engineers drawings before proceeding with works.
3. All drawings and designs are covered by design right (intellectual property), and may not be distributed, copied or issued without written permission by the Architect.
4. All design concepts are the sole property of the Architect and no adaptations, reproductions or copies may be made without written permission of the Architect.
5. These drawings are subject to any variation required or recommendation by any statutory authority, or for the better carrying out of the works.
6. Samples to be provided by contractor for XUL Architecture's approval.
7. All finishes to XUL Architecture's satisfaction.
8. All drawings to be approved by XUL Architecture prior to construction.

ADDITIONNAL NOTE:

EXISTING CONSERVATORY FOOTPRINT
PREVIOUSLY APPROVED APPLICATION FOOTPRINT (2019/1110/P)
PREVIOUSLY SUBMITTED PRE-APPLICATION DRAWINGS IN JANUARY 2019



PROPOSED NEW EXTENSION CLEAR GLASS



X EXISTING - REAR ELEVATION
1:100@A3



X PROPOSED - REAR ELEVATION
1:100@A3

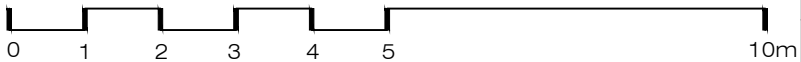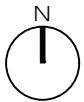

Issue key:	Tender (T)
Information (I)	Construction (C)
Planning (P)	As Built (B)

Project Address
Flat 3, 37 Platt's Lane

EXISTING & PROPOSED
ELEVATIONS

Scale 1:100@A3	Dwg. No. PA-03
Rev. Date 13.04.22	Rev. I-02
Drawn SL	Project Number 21006
Checked SS	Issue For: INFORMATION

- PLEASE NOTE:
1. All dimensions to be checked on site before fabrication,
 2. Contractor to refer to engineers drawings before proceeding with works.
 3. All drawings and designs are covered by design right (intellectual property), and may not be distributed, copied or issued without written permission by the Architect.
 4. All design concepts are the sole property of the Architect and no adaptations, reproductions or copies may be made without written permission of the Architect.
 5. These drawings are subject to any variation required or recommendation by any statutory authority, or for the better carrying out of the works.
 6. Samples to be provided by contractor for XUL Architecture's approval.
 7. All finishes to XUL Architecture's satisfaction.
 8. All drawings to be approved by XUL Architecture prior to construction.

ADDITIONNAL NOTE:

Issue key:	Tender (T)
Information (I)	Construction (C)
Planning (P)	As Built (B)

Project Adress
Flat 3, 37 Platt's Lane

EXISTING & PROPOSED
SIDE ELEVATION -01



Scale 1:100@A3	Dwg. No. PA-04
Rev. Date 13.04.22	Rev. I-02
Drawn SL	Project Number 21006
Checked SS	Issue For: INFORMATION



X EXISTING - SIDE ELEVATION
1:100@A3



X PROPOSED - SIDE ELEVATION
1:100@A3

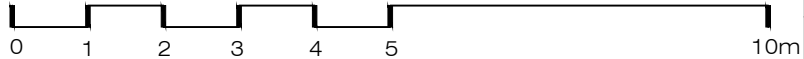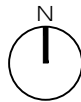


PLEASE NOTE:

1. All dimensions to be checked on site before fabrication,
2. Contractor to refer to engineers drawings before proceeding with works.
3. All drawings and designs are covered by design right (intellectual property), and may not be distributed, copied or issued without written permission by the Architect.
4. All design concepts are the sole property of the Architect and no adaptations, reproductions or copies may be made without written permission of the Architect.
5. These drawings are subject to any variation required or recommendation by any statutory authority, or for the better carrying out of the works.
6. Samples to be provided by contractor for XUL Architecture's approval.
7. All finishes to XUL Architecture's satisfaction.
8. All drawings to be approved by XUL Architecture prior to construction.



ADDITIONNAL NOTE:



X EXISTING - SIDE ELEVATION
1:100@A3

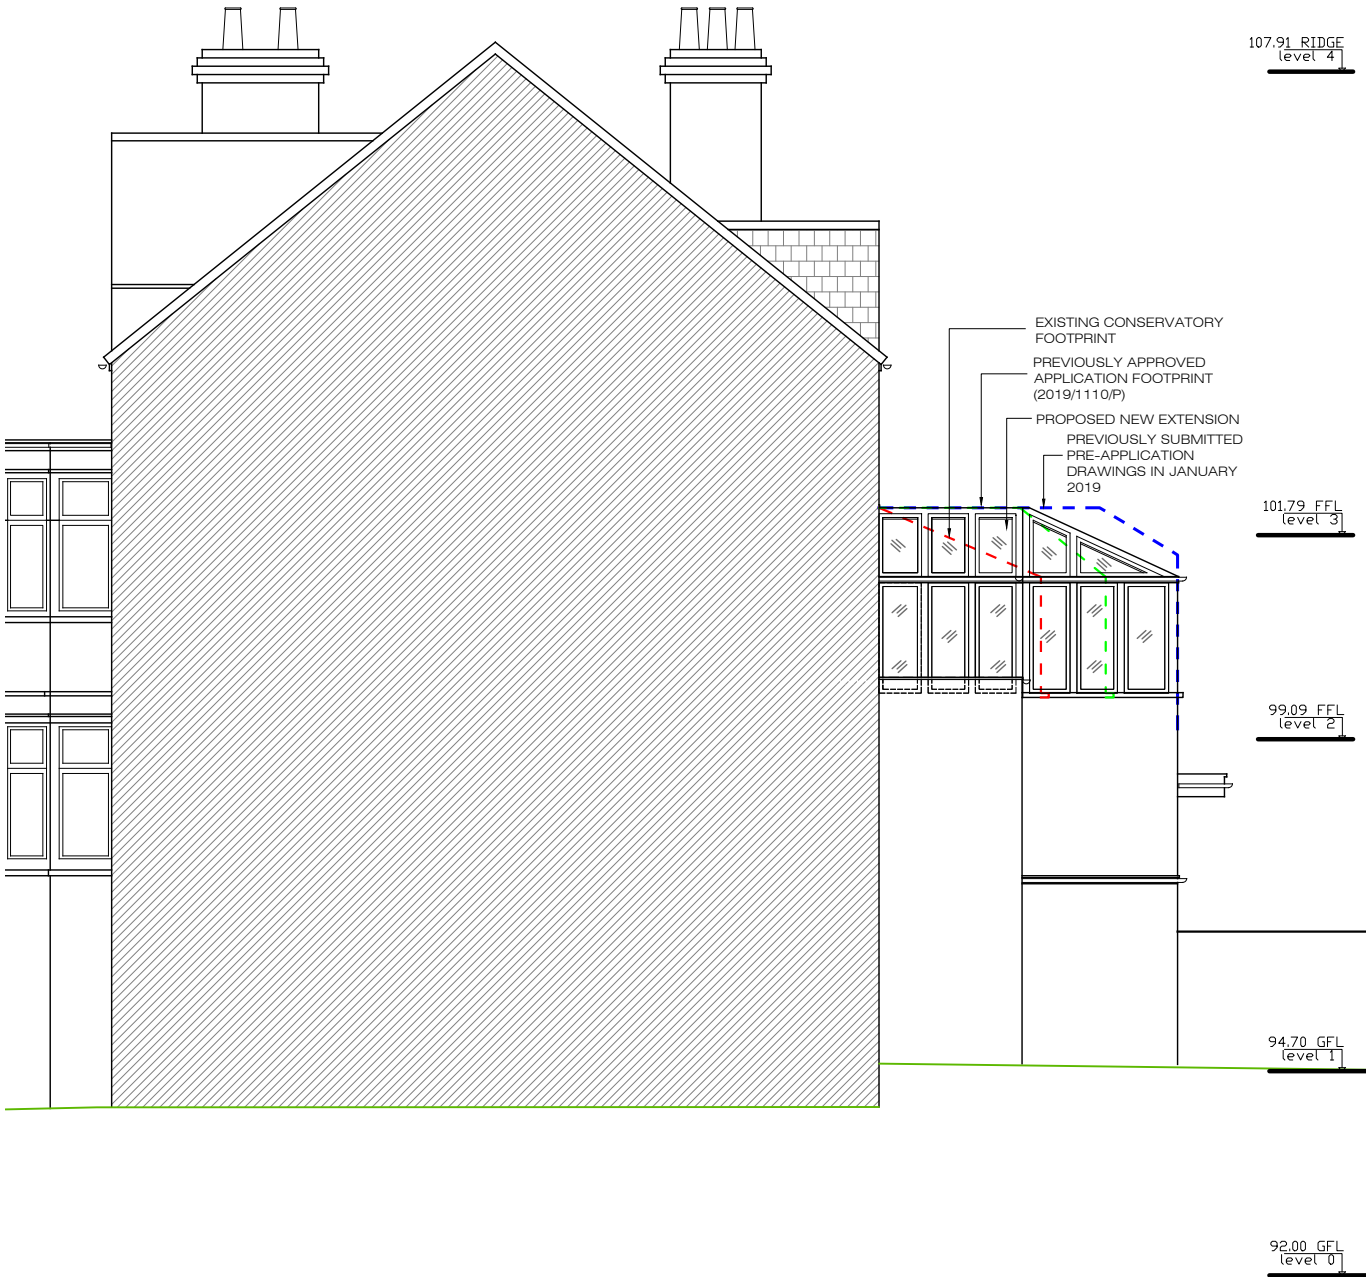

X PROPOSED - SIDE ELEVATION
1:100@A3

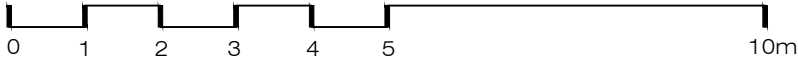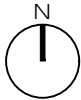

Issue key:	Tender (T)
Information (I)	Construction (C)
Planning (P)	As Built (B)

Project Adress
Flat 3, 37 Platt's Lane

EXISTING & PROPOSED
SIDE ELEVATION -02

Scale 1:100@A3	Dwg. No. PA-05
Rev. Date 13.04.22	Rev. I-02
Drawn SL	Project Number 21006
Checked SS	Issue For: INFORMATION

PLEASE NOTE:

1. All dimensions to be checked on site before fabrication,
2. Contractor to refer to engineers drawings before proceeding with works.
3. All drawings and designs are covered by design right (intellectual property), and may not be distributed, copied or issued without written permission by the Architect.
4. All design concepts are the sole property of the Architect and no adaptations, reproductions or copies may be made without written permission of the Architect.
5. These drawings are subject to any variation required or recommendation by any statutory authority, or for the better carrying out of the works.
6. Samples to be provided by contractor for XUL Architecture's approval.
7. All finishes to XUL Architecture's satisfaction.
8. All drawings to be approved by XUL Architecture prior to construction.

ADDITIONNAL NOTE:

Issue key: Tender (T)
Information (I) Construction (C)
Planning (P) As Built (B)


Project Address
Flat 3, 37 Platt's Lane

EXISTING & PROPOSED
FRONT ELEVATION

Scale 1:100@A3	Dwg. No. PA-06
Rev. Date 13.04.22	Rev. I-02
Drawn SL	Project Number 21006
Checked SS	Issue For: INFORMATION



X EXISTING - FRONT ELEVATION
1:100@A3

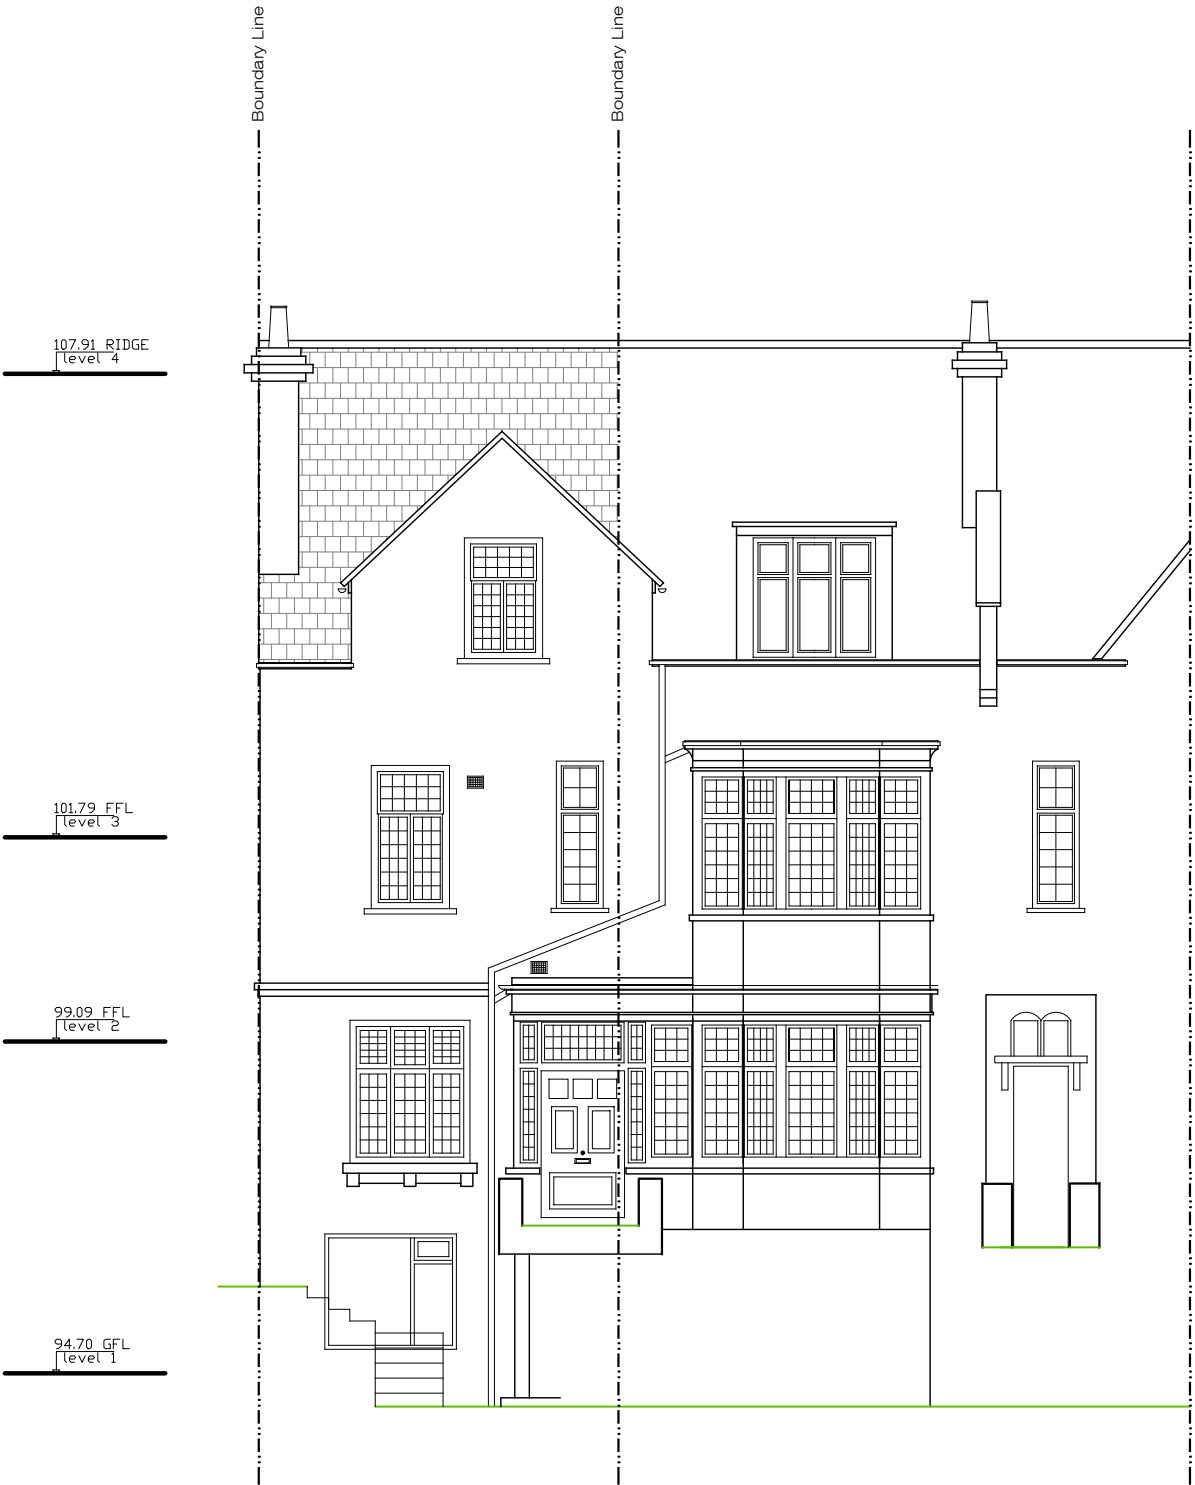

X PROPOSED - FRONT ELEVATION
1:100@A3

