




**X** KEY PLAN  
Upper Ground Floor NTS

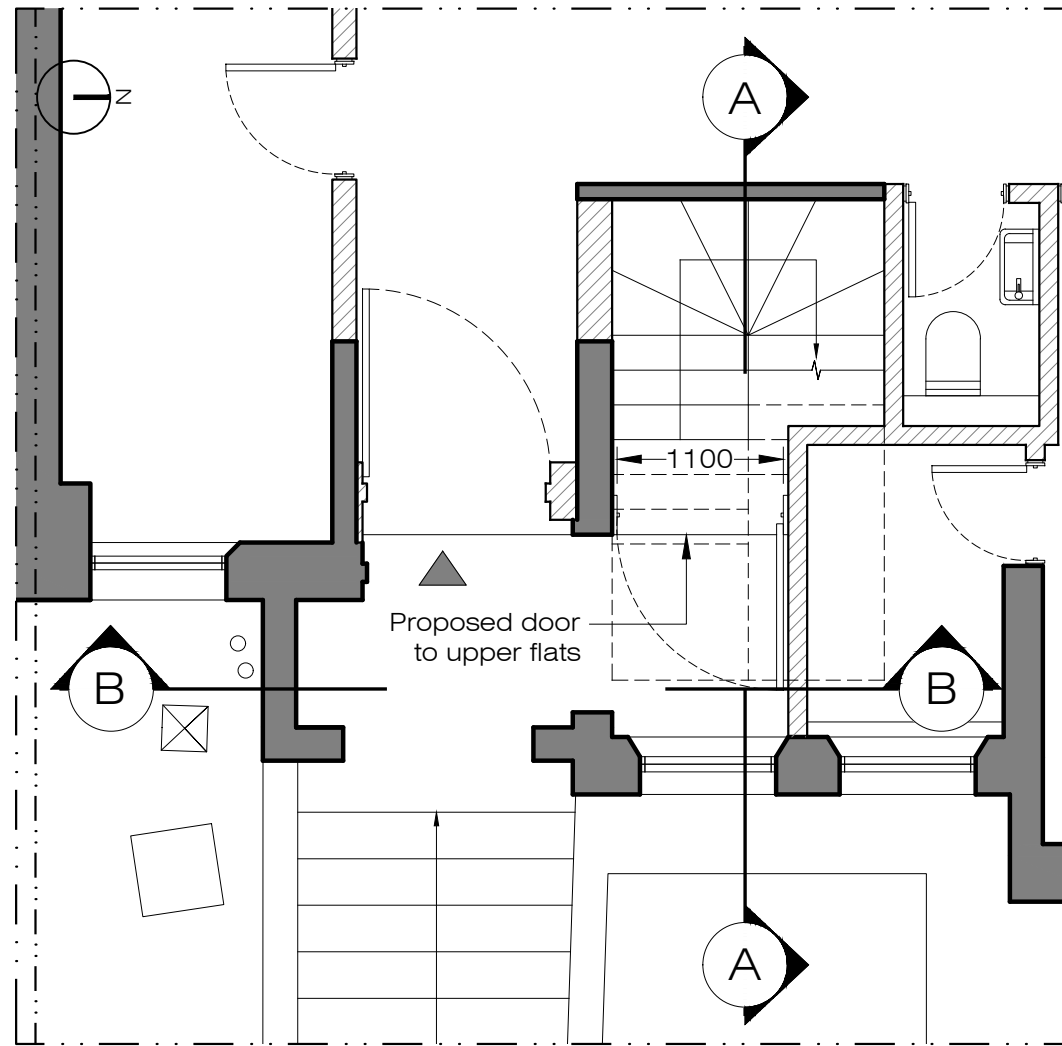


**X** PROPOSED  
Upper Ground Floor Plan 1:50@A3

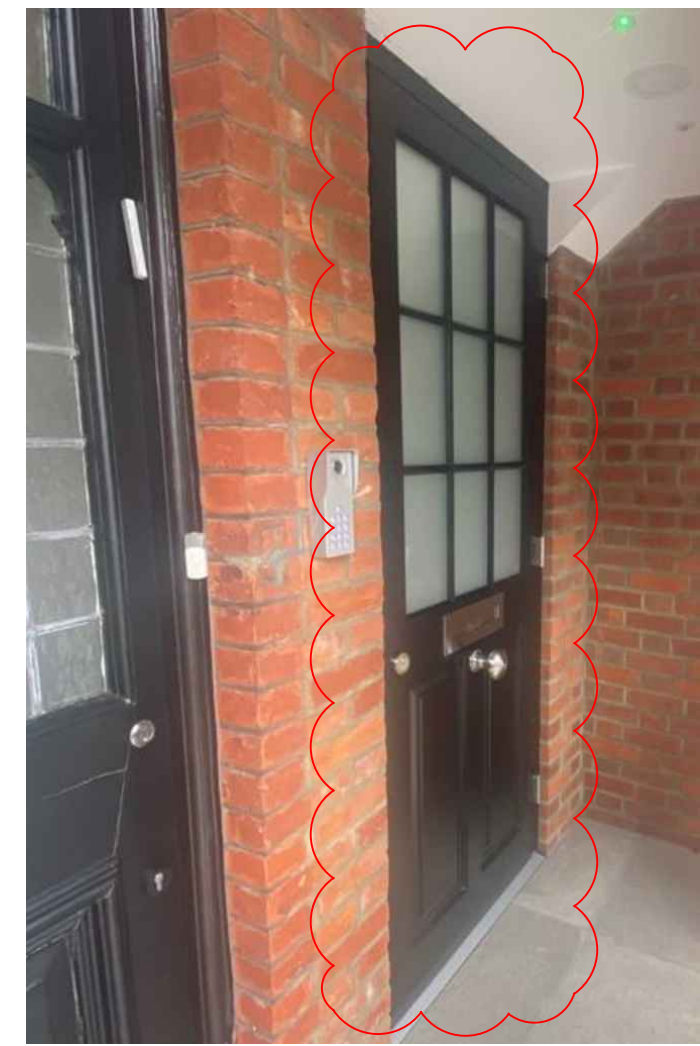


Proposed door to upper flats shown in red

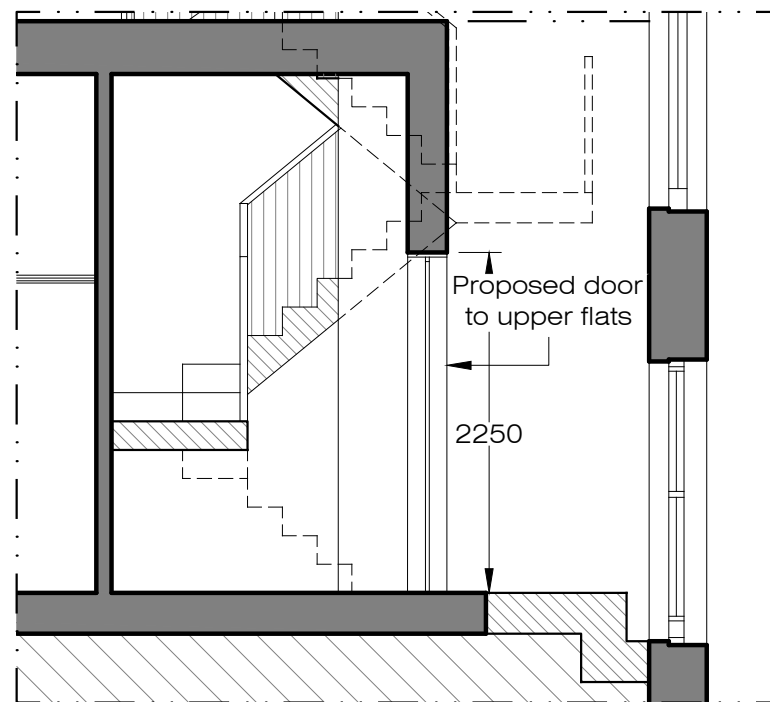

**X** PROPOSED  
Section AA 1:50@A3

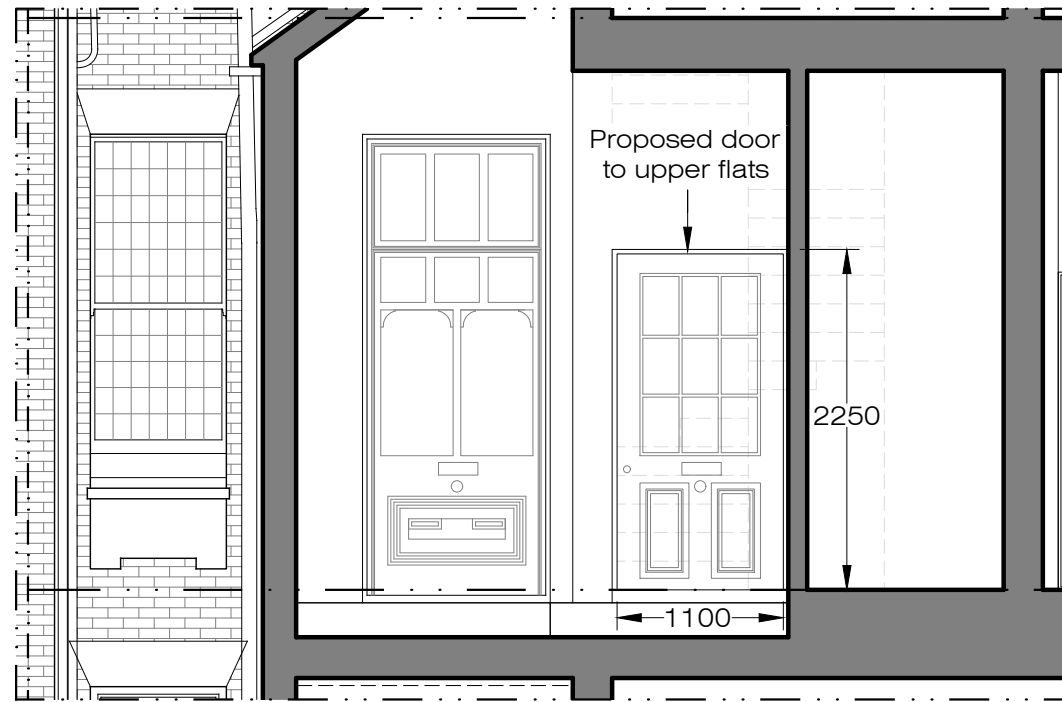

**X** PROPOSED  
Section BB 1:50@A3

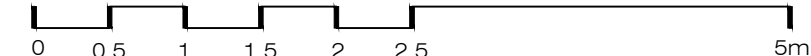

Ground Floor Office  
33 Beisize Lane  
London NW3 5AS  
Office: +44 (0) 207 431 9014  
info@xularchitecture.co.uk  
www.xularchitecture.co.uk

PLEASE NOTE:

- All dimensions to be checked on site before fabrication.
- Contractor to refer to engineers drawings before proceeding with works.
- All drawings and designs are covered by design right (intellectual property), and may not be distributed, copied or issued without written permission by the Architect.
- All design concepts are the sole property of the Architect and no adaptations, reproductions or copies may be made without written permission of the Architect.
- These drawings are subject to any variation required or recommendation by any statutory authority, or for the better carrying out of the works.
- Samples to be provided by contractor for XUL Architecture's approval.
- All finishes to XUL Architecture's satisfaction.
- All drawings to be approved by XUL Architecture prior to construction.

ADDITIONAL NOTE:

Issue key:	Information (I)	Project Address	29 Maresfield Gardens, NW3 5SD	Issue For:	PLANNING
Planning (P)		Scale	varies@A3	PROPOSED	
Tender (T)		Rev. Date	29.04.22	Plan & Sections	
Construction (C)		Drawn	AT	Dwg. No.	PA-01
As Built (B)		Checked	SC	Rev.	P-00
			Project Number		19071