

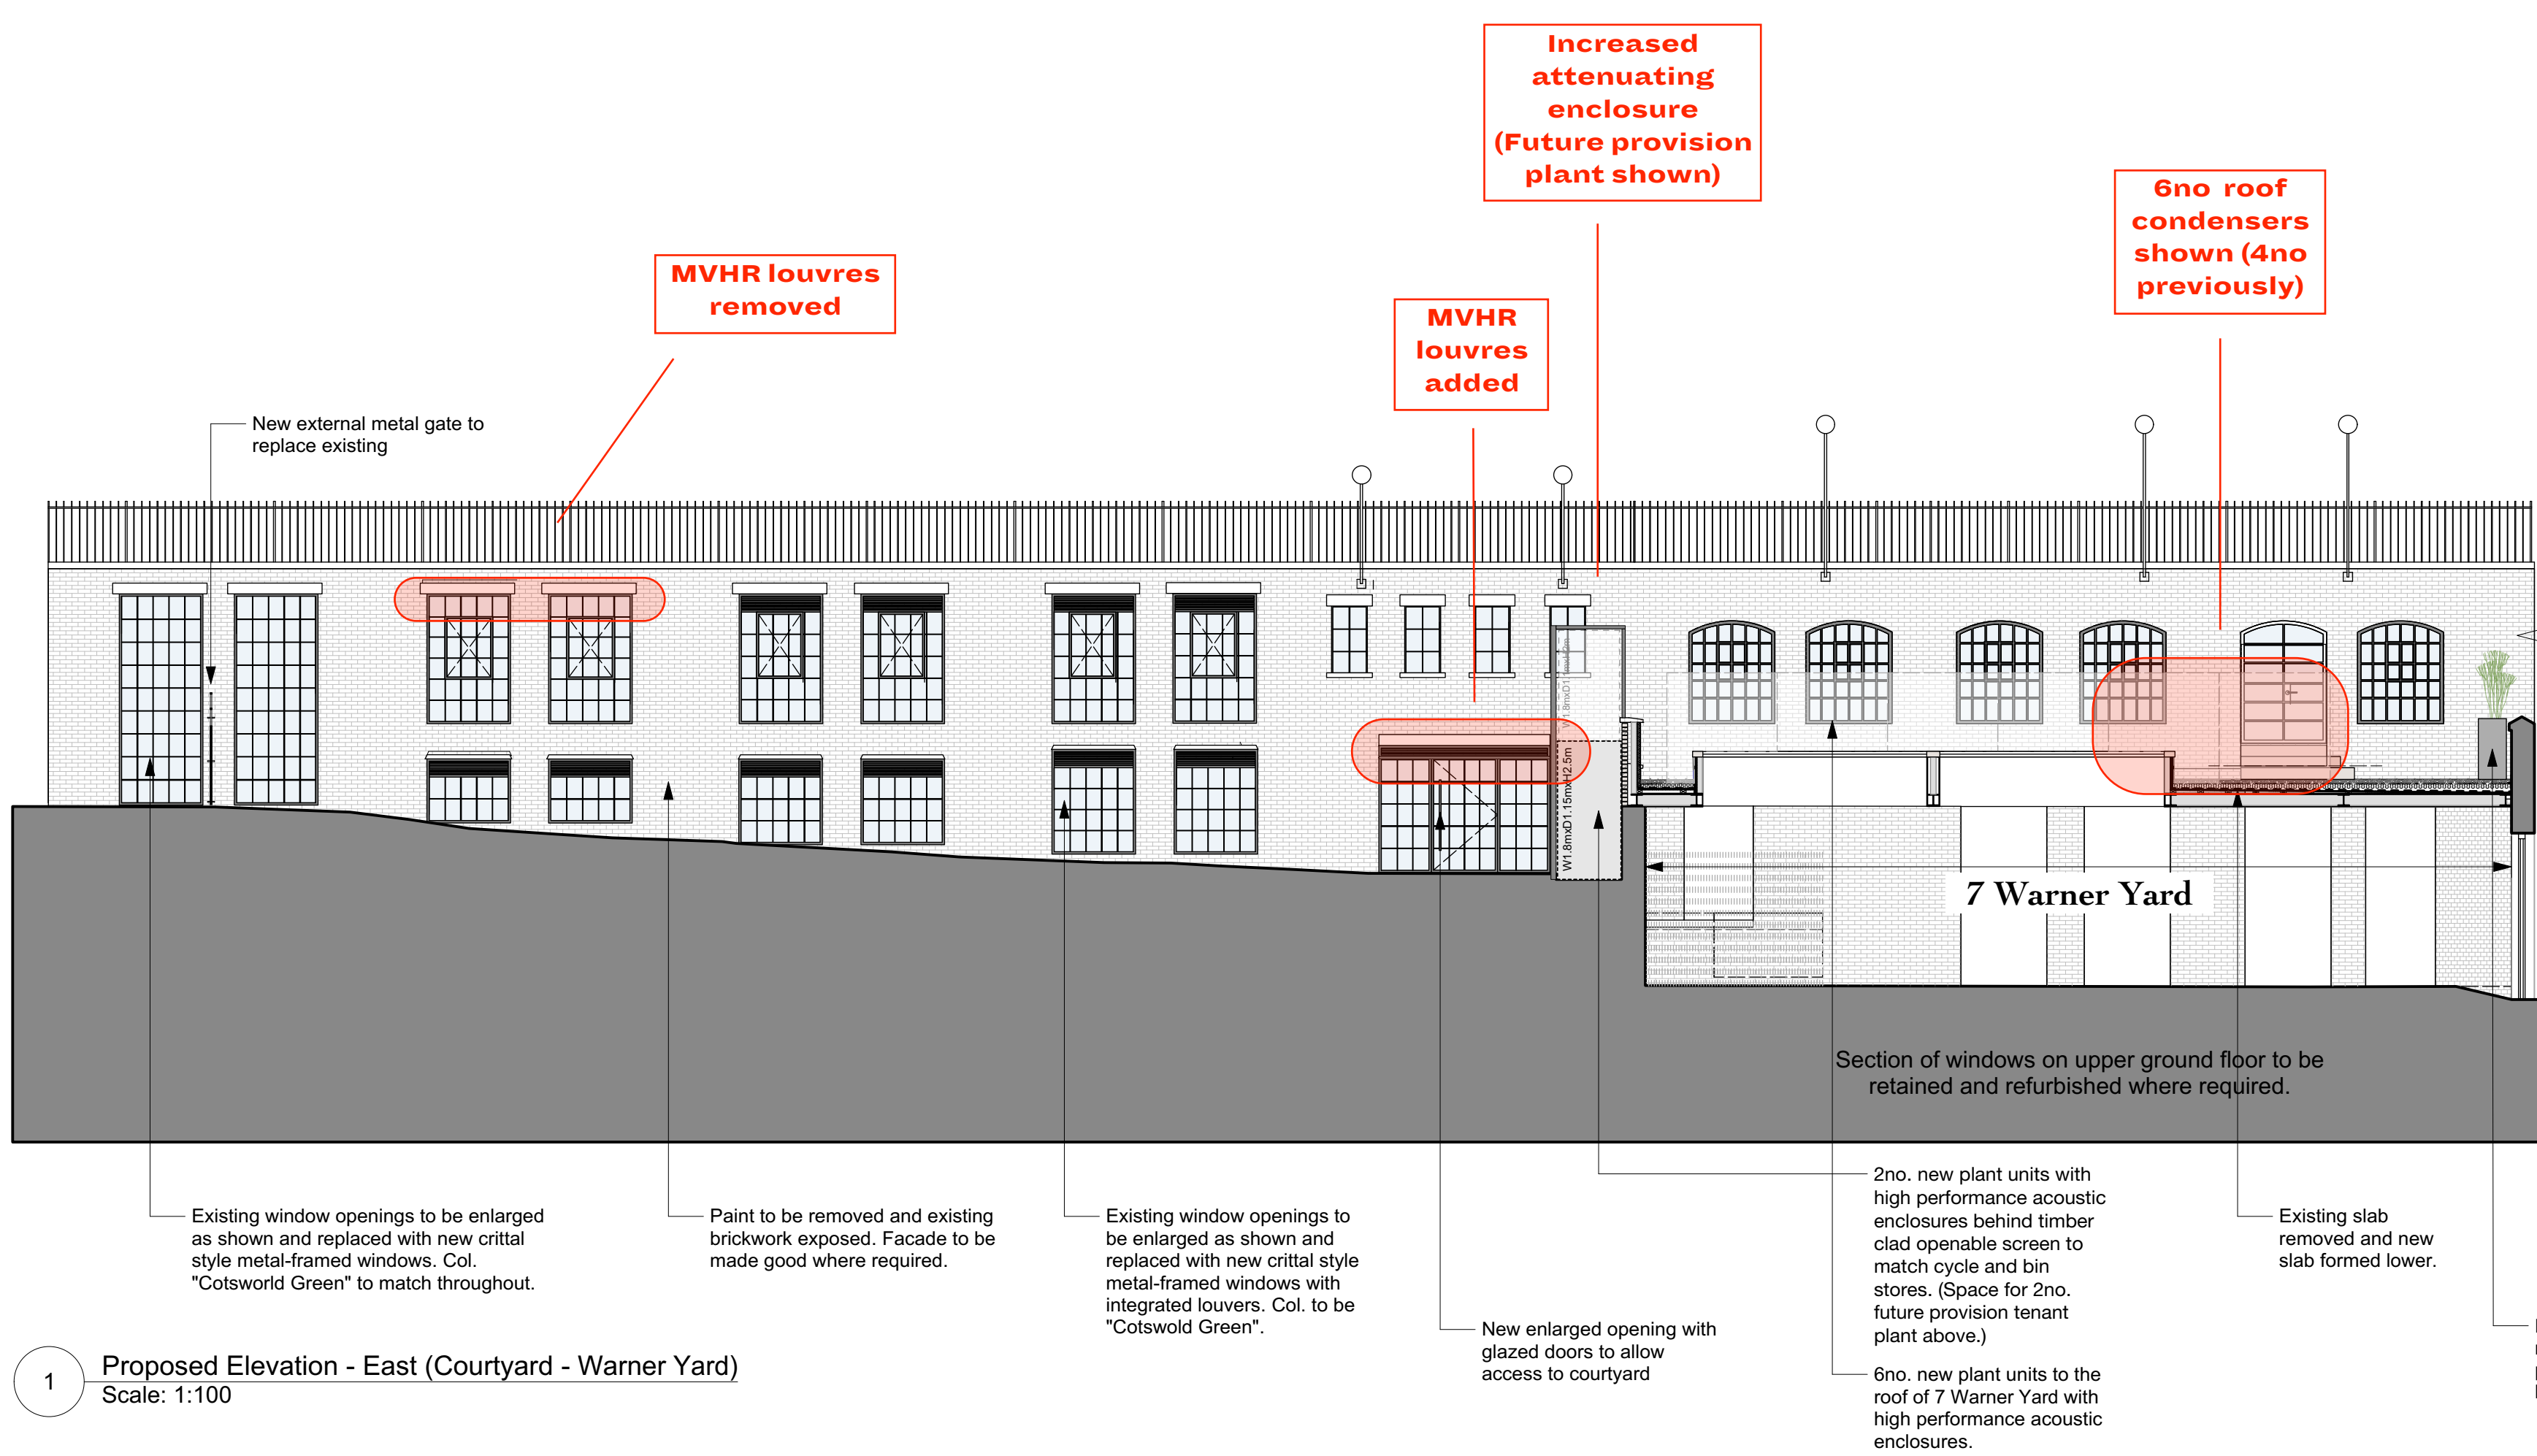


Vine Hill

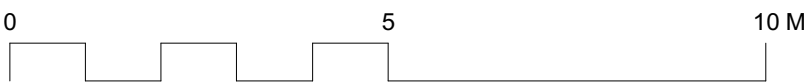

1 Proposed Elevation - East (Courtyard - Warner Yard)
Scale: 1:100

Warner
Yard

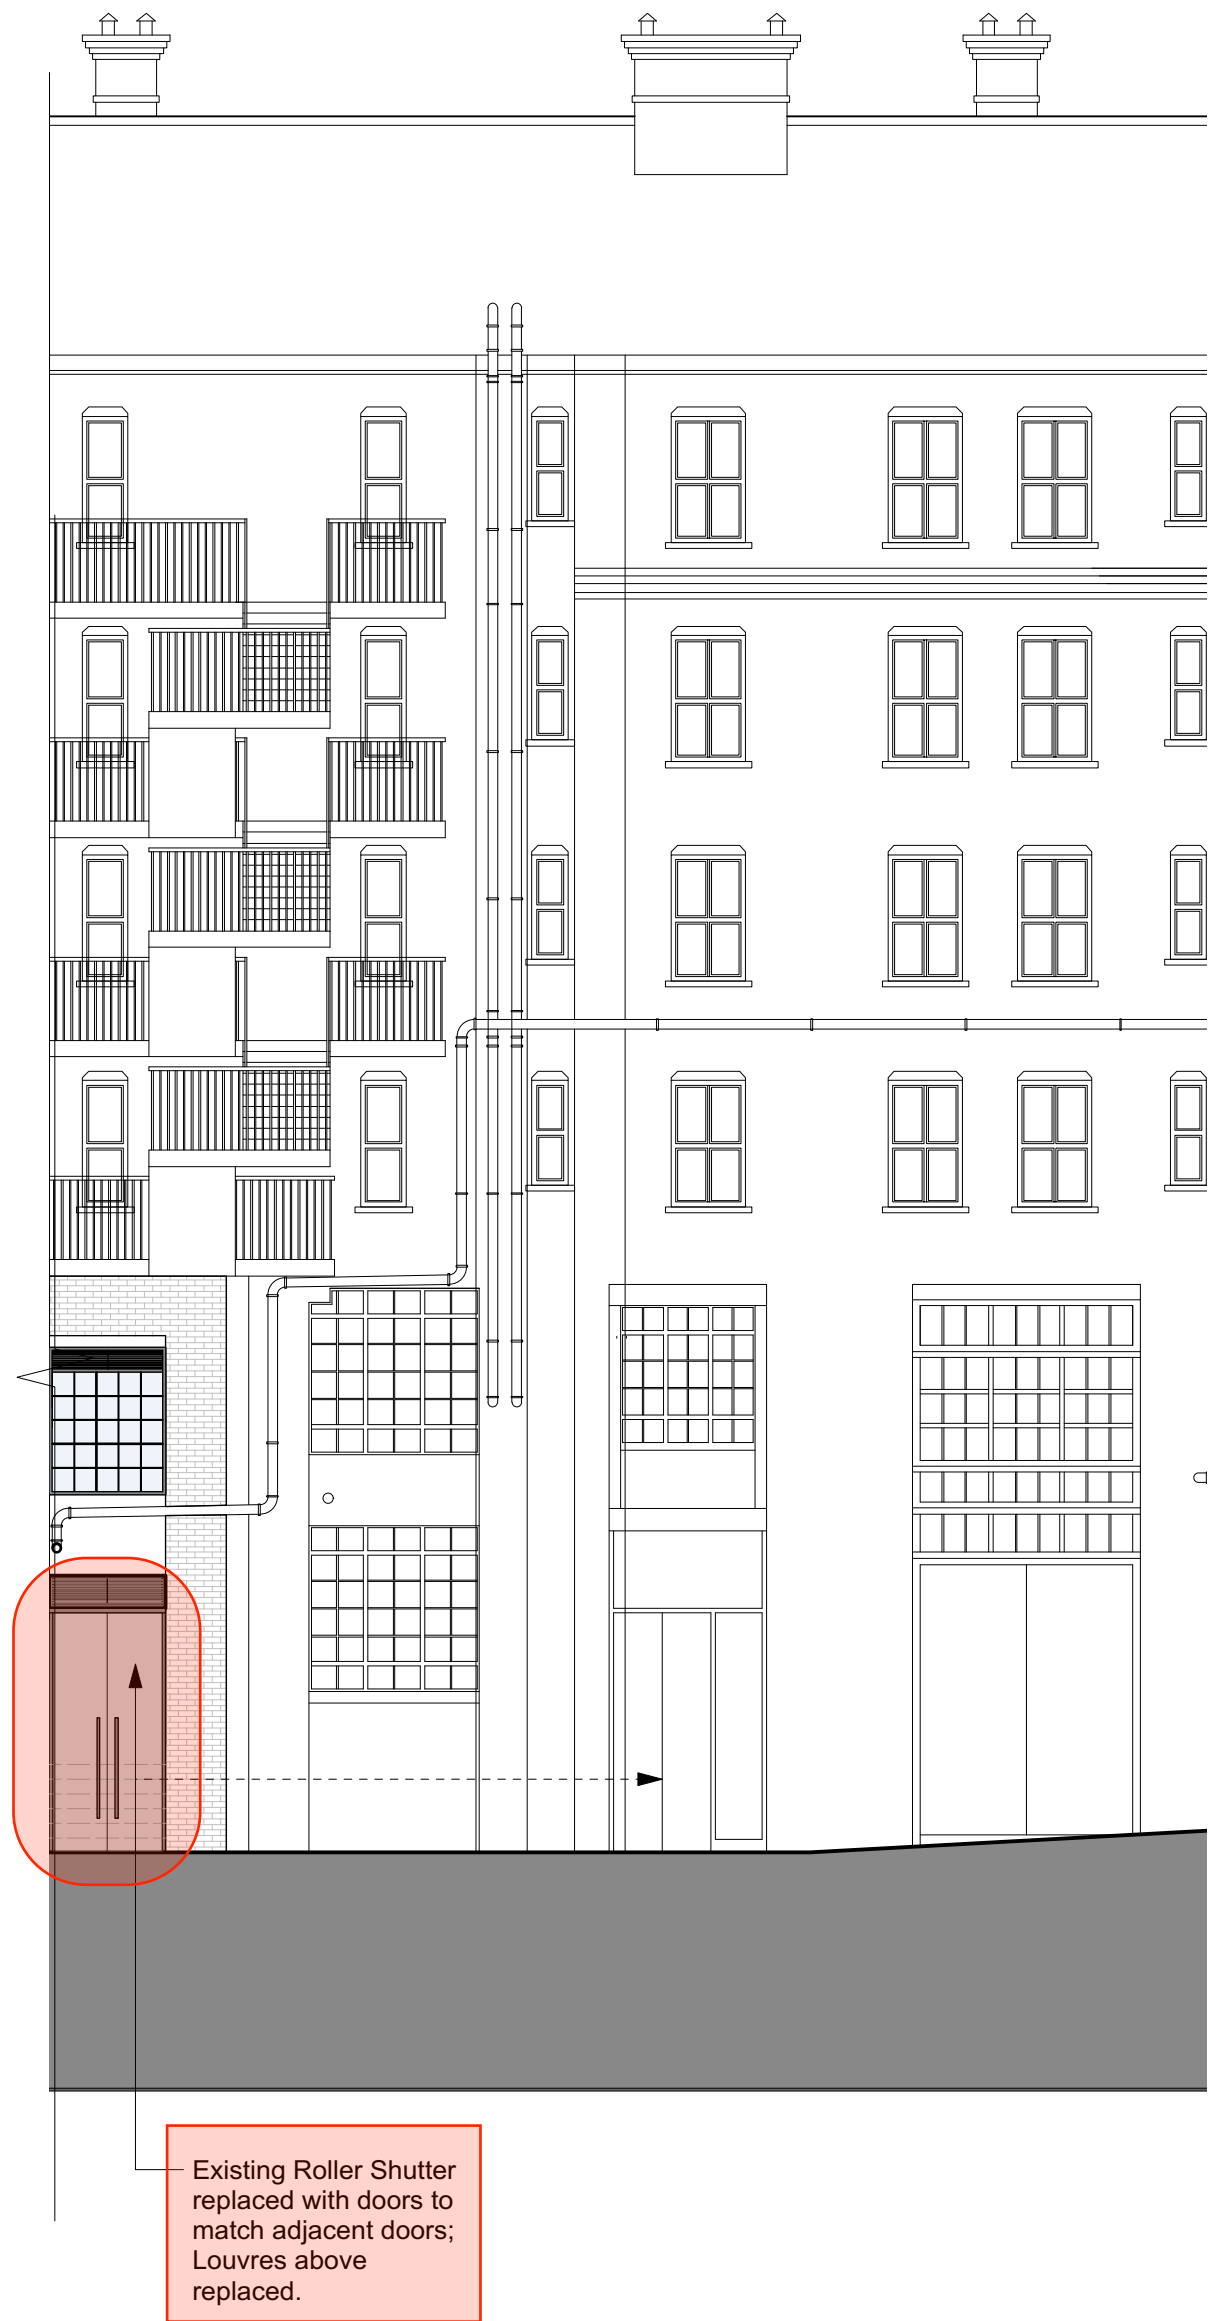

DRAWING NOTES:
All dimensions to be checked on site prior to commencement of any works, and/or preparation of any shop drawings.
Sizes of and dimensions to any structural elements are indicative only. See structural engineers drawings for actual sizes/dimensions.
Sizes of and dimensions to any service elements are indicative only. See service engineers drawings for actual sizes and dimensions.
This drawing to be read in conjunction with all other Architect's drawings, specifications and other Consultants' information.
All proprietary systems shown on this drawing are to be installed strictly in accordance with the Manufacturers/Suppliers recommended details.
Any discrepancies between information shown on this drawing and any other contract information or manufacturers/suppliers recommendations is to be brought to the attention of the Architect.
DO NOT SCALE FROM THIS DRAWING.

MARK-UP

P3 For S73 Submission P2 For S73 P1 For Planning STATUS REVISION	25/01/2022 13/12/2021 05/03/2021 DATE	DRAWING PROPOSED ELEVATIONS East Elevation		Buckley Gray Yeoman Studio 4.04 The Tea Building 56 Shoreditch High Street London E1 6JJ T: 020 7033 9913
		SCALE 1:100 @ A1 (1:200 @ A3)	DRAWING FILE REF 1134_PL-GE-01.vwx	
		DATE March 2021	DRAWN BY WH	
		DWG No. 1134_PL-GE-01	REVISION P3	CLIENT Vine 1 & Vine 2 Ltd
		DRAWING STATUS PLANNING		PROJECT 22-26 Vine Hill