

Existing brickwork to this facade to be retained and made good where required.

New glazed doors and windows to replace existing

1 Proposed elevation - North  
Scale: 1:100



Existing public stair will be retained, but not shown on drawings

MVHR louvres (active portion at 3m distance from stair)

Adjusted door position

Paint to existing lintels to be removed, made good and decorated.


Paint to be removed and existing brickwork exposed. Facade to be made good where required.

Existing window openings to be enlarged as shown and replaced with new crittal style metal-framed windows. Integrated louvres above. Frame colour to be Cotswold Green.

New crittal style metal doors to reception entrance.


New metal gate to match the style of cycle and bin stores to the courtyard.

2 Proposed Elevation - South  
Scale: 1:100

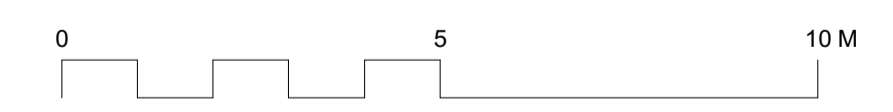

**DRAWING NOTES:**  
All dimensions to be checked on site prior to commencement of any works, and/or preparation of any shop drawings.  
Sizes of and dimensions to any structural elements are indicative only. See structural engineers drawings for actual sizes/dimensions.  
Sizes of and dimensions to any service elements are indicative only. See service engineers drawings for actual sizes and dimensions.  
This drawing to be read in conjunction with all other Architect's drawings, specifications and other Consultants' information.  
All proprietary systems shown on this drawing are to be installed strictly in accordance with the Manufacturers/Suppliers recommended details.  
Any discrepancies between information shown on this drawing and any other contract information or manufacturers/suppliers recommendations is to be brought to the attention of the Architect.  
DO NOT SCALE FROM THIS DRAWING.

**DRAWING NOTES:**  
**MARK-UP**

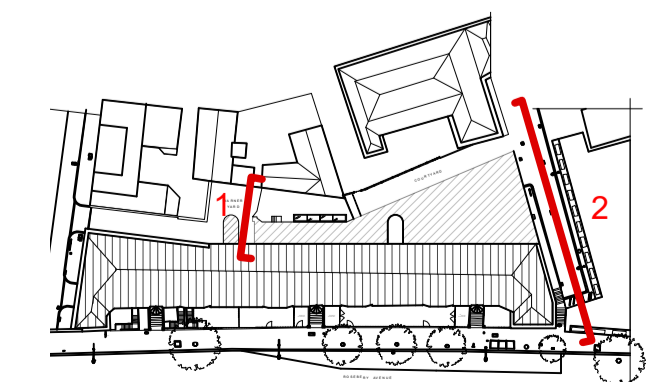

P2	For S73	13/12/2021
P1	For Planning	05/03/2021
STATUS	REVISION	DATE

DRAWING PROPOSED ELEVATIONS North and South Elevations	
SCALE 1:100 @ A1 (1:200 @ A3)	DRAWING FILE REF 1134_PL-GE-02.vwx
DATE March 2021	DRAWN BY WH
DWG No. 1134_PL-GE-02	REVISION P2
DRAWING STATUS PLANNING	

Buckley Gray Yeoman	
Studio 4.04 The Tea Building 56 Shoreditch High Street London E1 6JJ T: 020 7033 9913	
CLIENT	Vine 1 & Vine 2 Ltd
PROJECT	22-26 Vine Hill