



Increased attenuating enclosure (Future provision plant shown)
Please note quantum of condensers unchanged - 4no condensers in yard outlined previously, please refer to acoustic assessments.

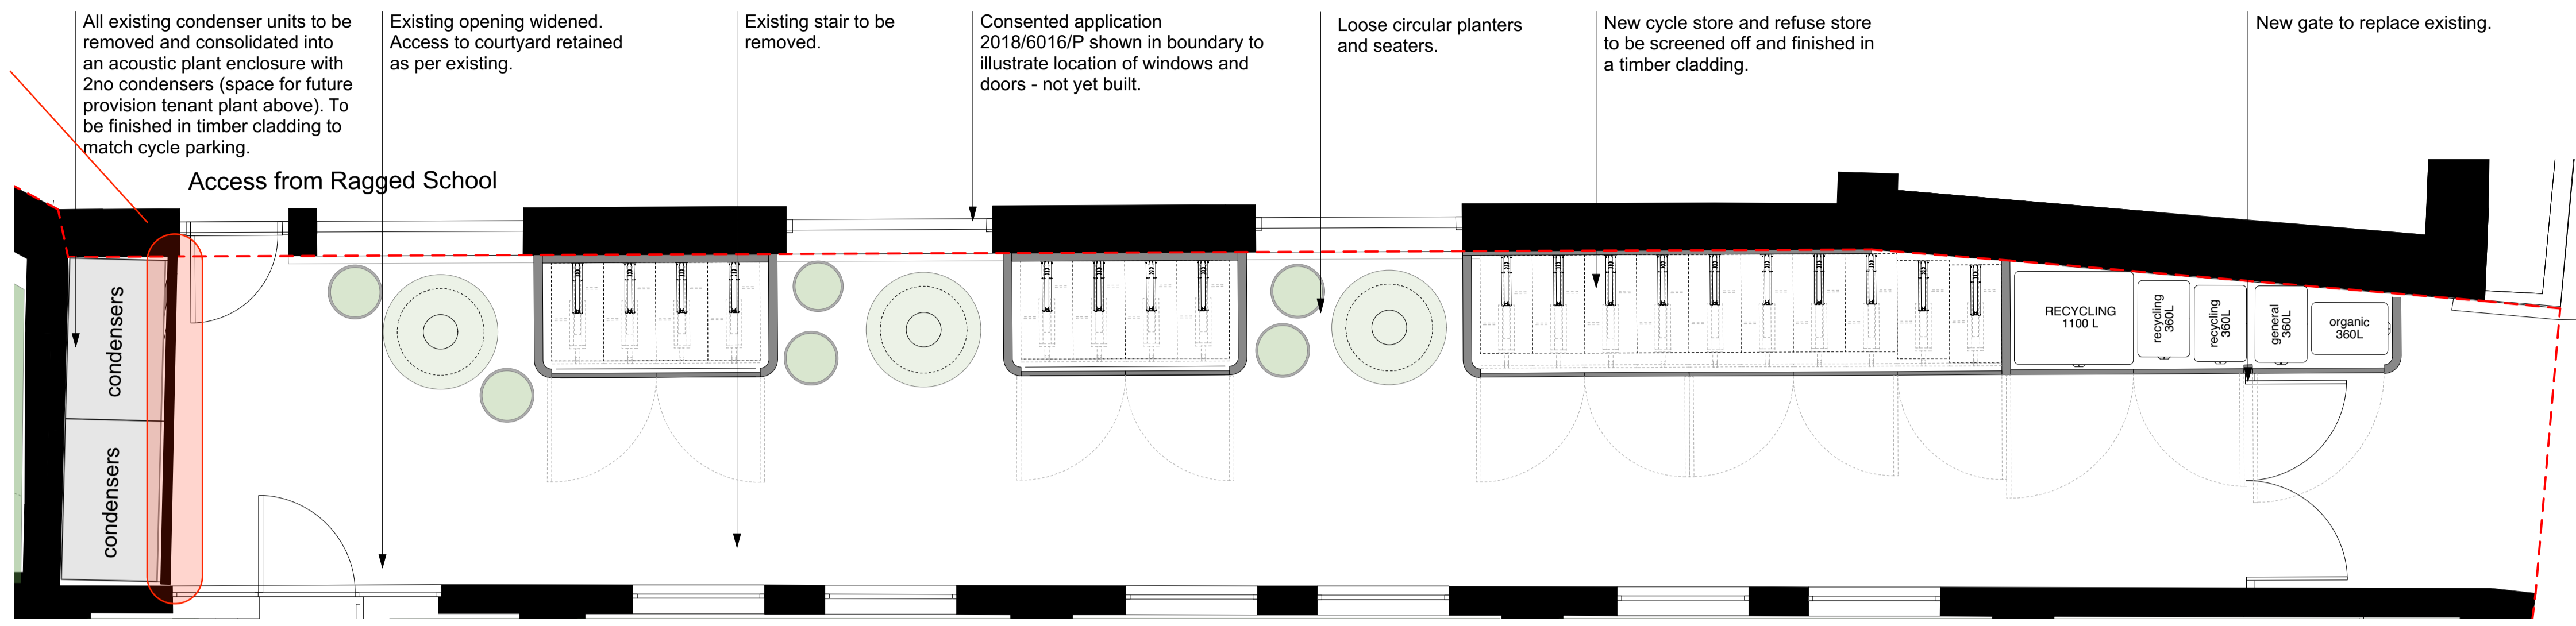


1 Proposed Plan - Courtyard
1:50 @ A1

6no roof condensers shown instead of 4no.

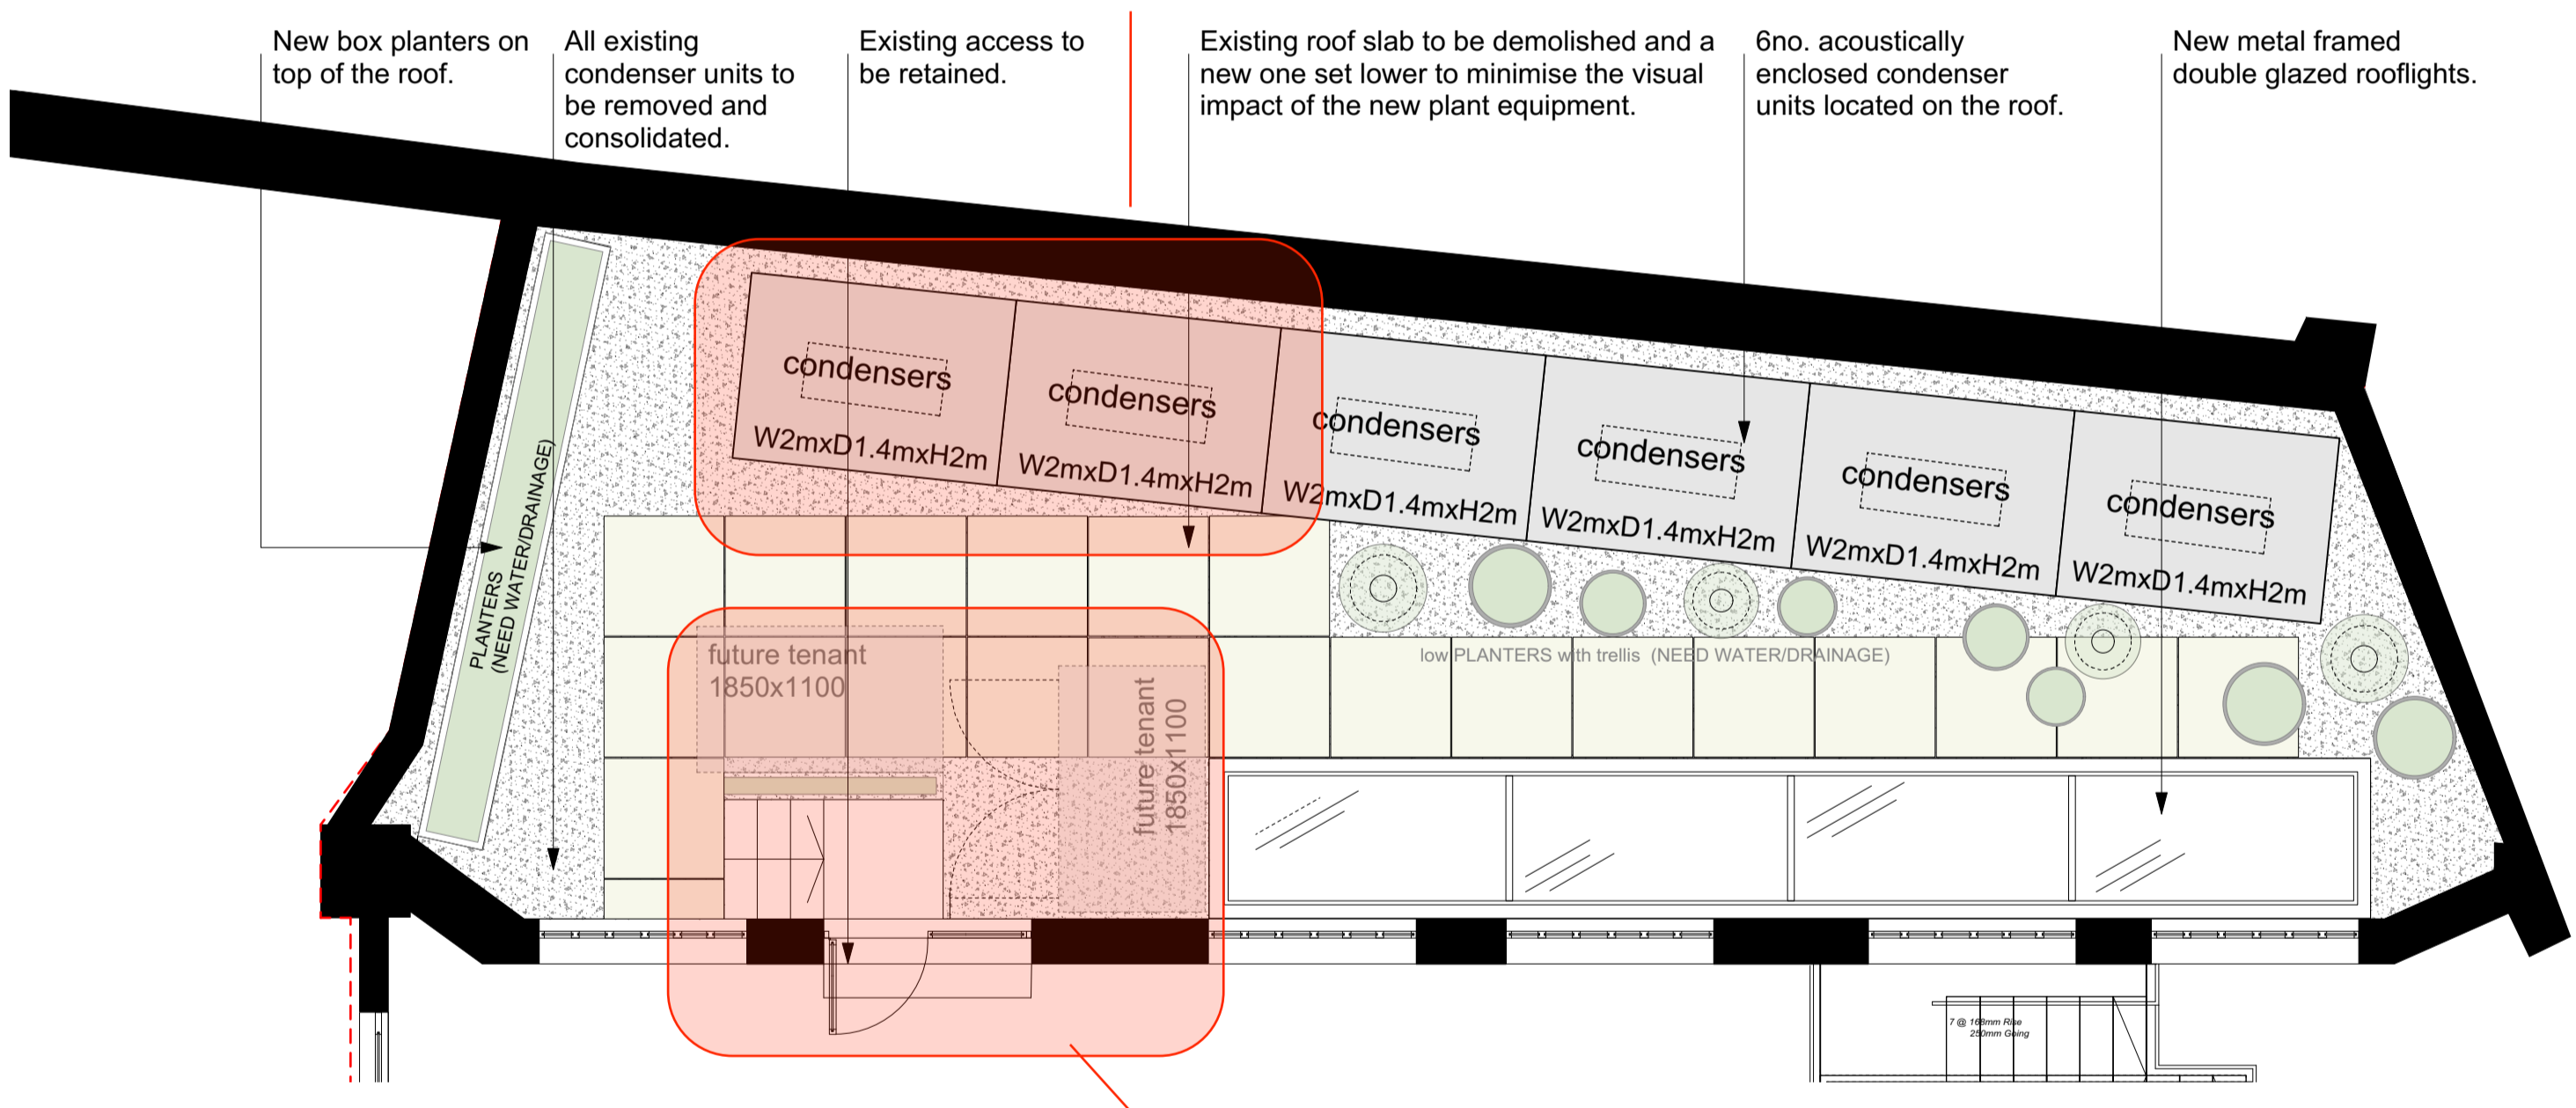

2 Proposed Plan - 7 Warner Yard Roof
1:50 @ A1

Minor access changes and Future provision Tenant Plant indicated

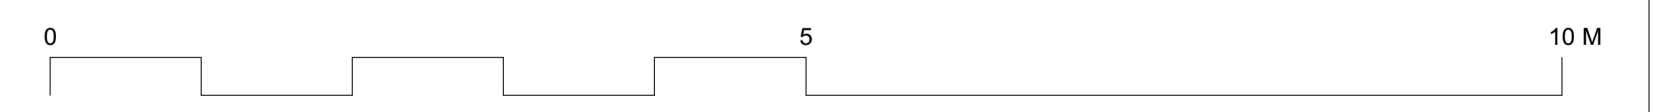

DRAWING NOTES:
 All dimensions to be checked on site prior to commencement of any works, and/or preparation of any shop drawings.
 Sizes of and dimensions to any structural elements are indicative only. See structural engineers drawings for actual sizes/dimensions.
 Sizes of and dimensions to any service elements are indicative only. See service engineers drawings for actual sizes and dimensions.
 This drawing to be read in conjunction with all other Architect's drawings, specifications and other Consultants' information.
 All proprietary systems shown on this drawing are to be installed strictly in accordance with the Manufacturers/Suppliers recommended details.
 Any discrepancies between information shown on this drawing and any other contract information or manufacturers/suppliers recommendations is to be brought to the attention of the Architect.
 DO NOT SCALE FROM THIS DRAWING.

DRAWING NOTES:

MARK-UP

P2 For S73 P1 For Planning STATUS REVISION	13/12/2021 05/03/2021 DATE	DRAWING STATUS PLANNING		CLIENT Vine 1 & Vine 2 Ltd PROJECT 22-26 Vine Hill
		DRAWING FILE REF 1134_PL-GA-00.vwx DRAWN BY WH REVISION P2		
DRAWING PROPOSED PLANS		SCALE 1:50 @ A1 (1:100 @ A3)	DATE March 2021	Buckley Gray Yeoman Studio 4.04 The Tea Building 56 Shoreditch High Street London E1 6JJ T: 020 7033 9913
DWG No. 1134_PL-GA-00				