

**Design notes:**

The trellis constructed of 38 x 20mm (or similar size) Siberian Larch battens set at 6mm gaps. The battens are set in 'stretcher bond' which breaks up the joints between batten layers, giving a more attractive effect than if the joints were all lined up. It is recommended that rear support battens are set regularly behind the joints, and if long battens are used then some additional support battens may need to be added at appropriate spacings.

The fence is Jacksons Shadow Line Panel which is constructed from high quality pressured treated softwood and Jack-posts.  
<https://www.jacksons-fencing.co.uk/fencing/fencing-panels/shadowline>

**Notes:**



Do not scale from this drawing.  
 Check all measurements on site.

Report all errors and omissions to the designer immediately.



Photo of actual build

**Scale**

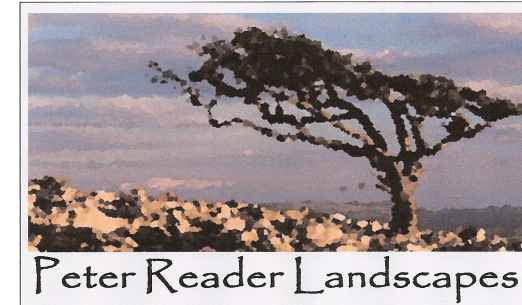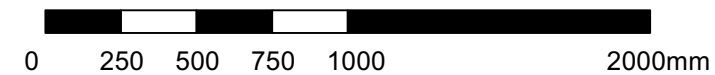

24 Bisham Gardens, Highgate  
 London, N6 6DD  
 0208 348 4730 / 07941 829 162

Doll-Steinberg 1The Old Orchard NW3 2TR

Trellis/Fence: as built

Drawing 4.1

Version 8.0

Scale 1:25 @ A3

26th May 2022