



01 Mock-up EES-450 - Elevation

02 Mock-up EES-450 - Section 1


03 Mock-up EES-450 - Section 2

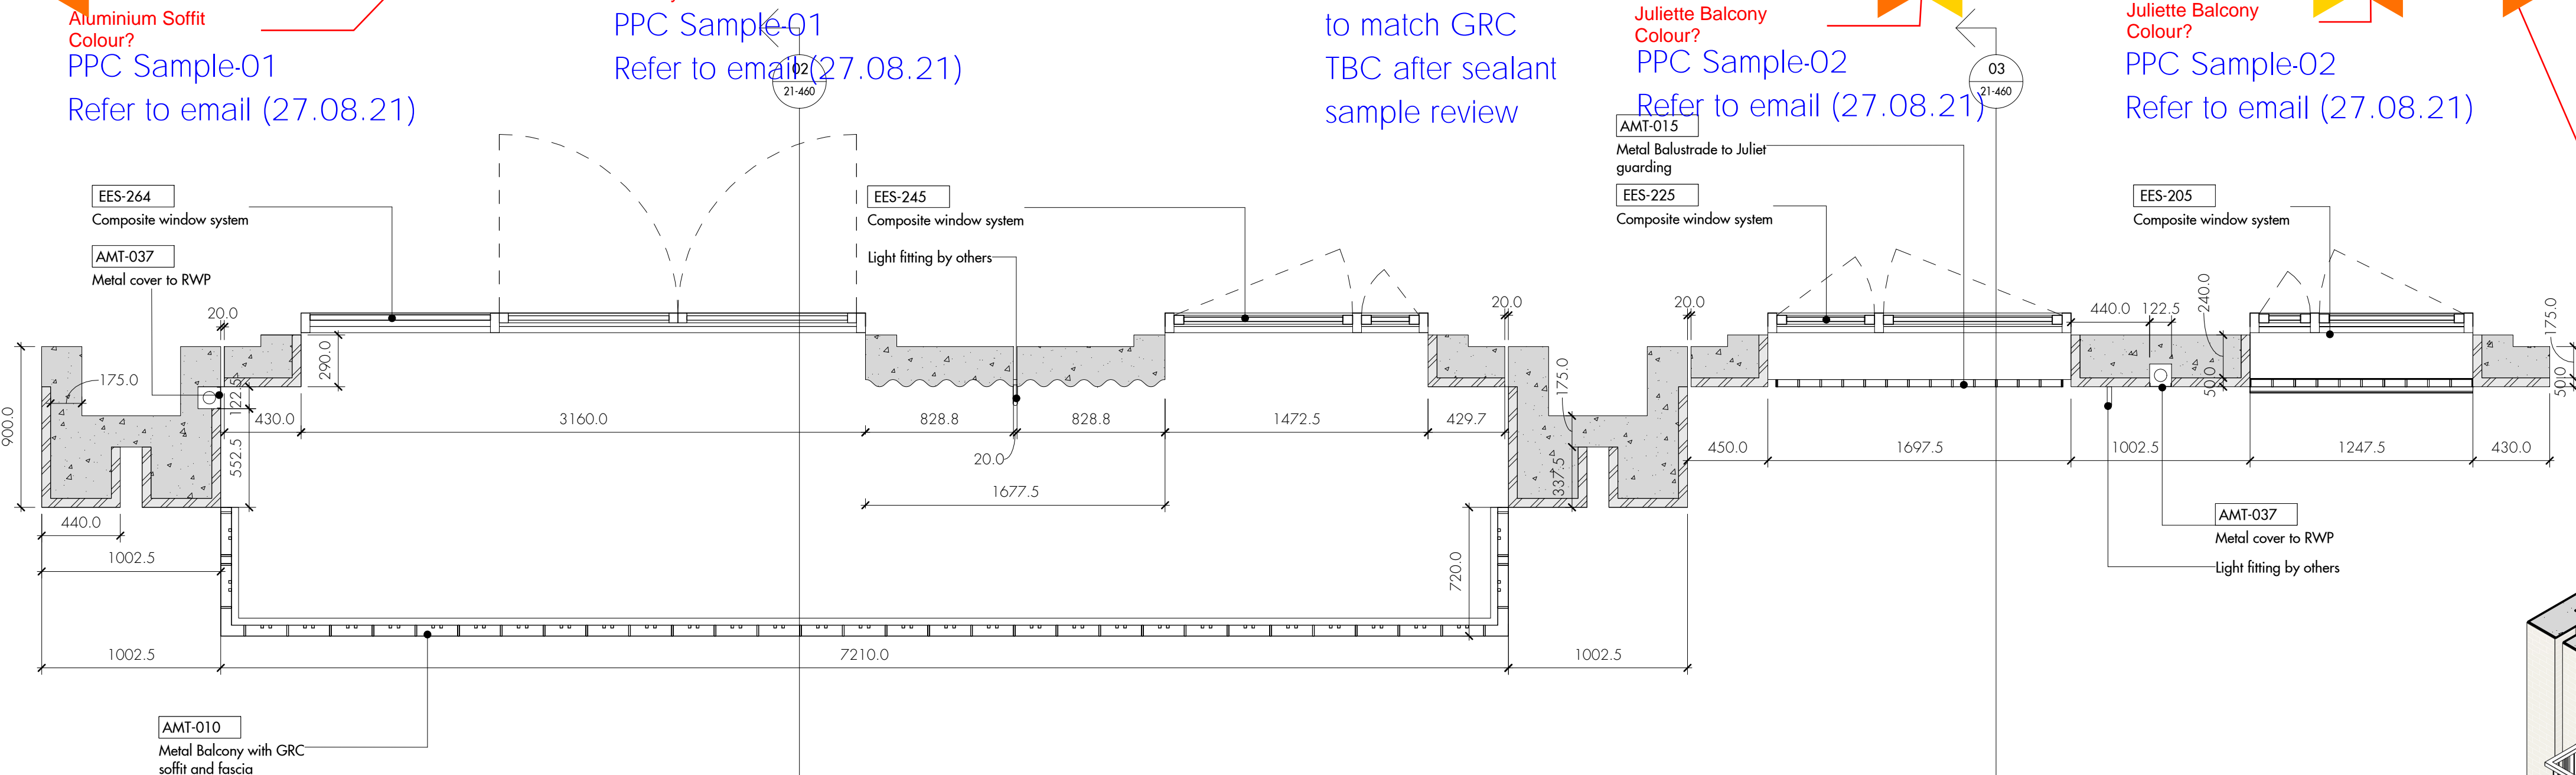

04 Mock-up EES-450 - Plan

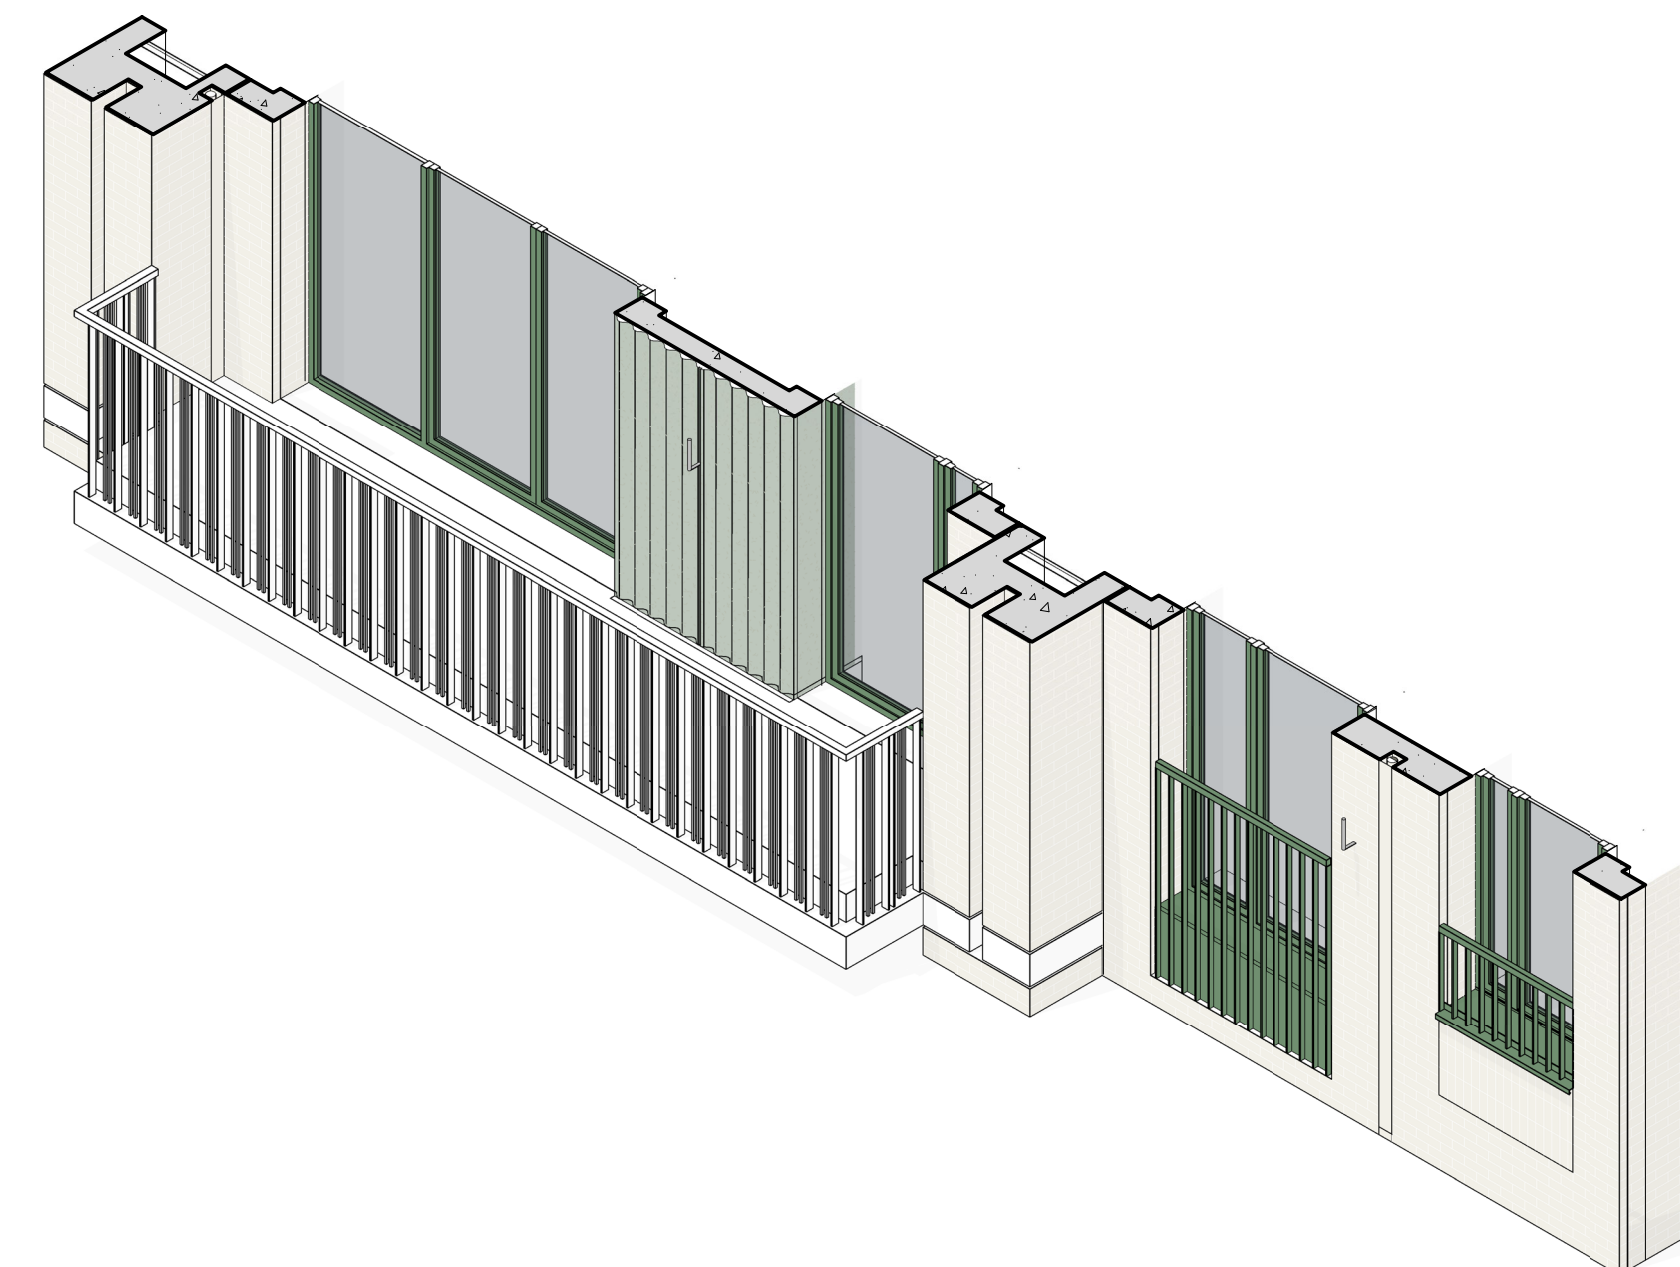

A&M Comment: Mortar profile extent confirmed
25/10/21

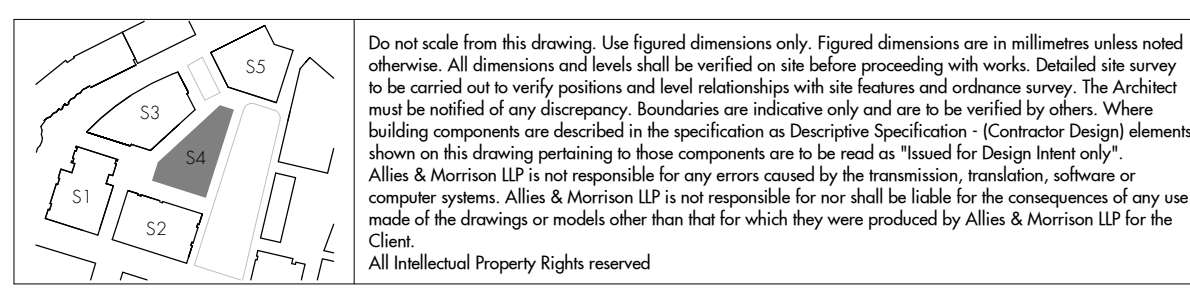

REV	DATE	DESCRIPTION	CKD
P1	26/02/21	Stage 3 Issue	AT

KXS4 VMU Colours Mark up -
Request A&M
LOR - KL - 24/08/2021

Allies and Morrison LLP
85 Southwark Street
London SE1 0XH
telephone 020 7921 0100
facsimile 020 7921 0101
email studio@alliesandmorrison.com

KINGS CROSS S4
Performance and visual facade mock-up
BAY STUDY
KXC-S4-001-A-19075-21-460-P1

A&M JOB No: 19075

SCALE 1 : 25 @A1 1 : 50 @A3

P1

Revision