

Rear


No. 66

No. 64


No. 62




New lead pipe overflow

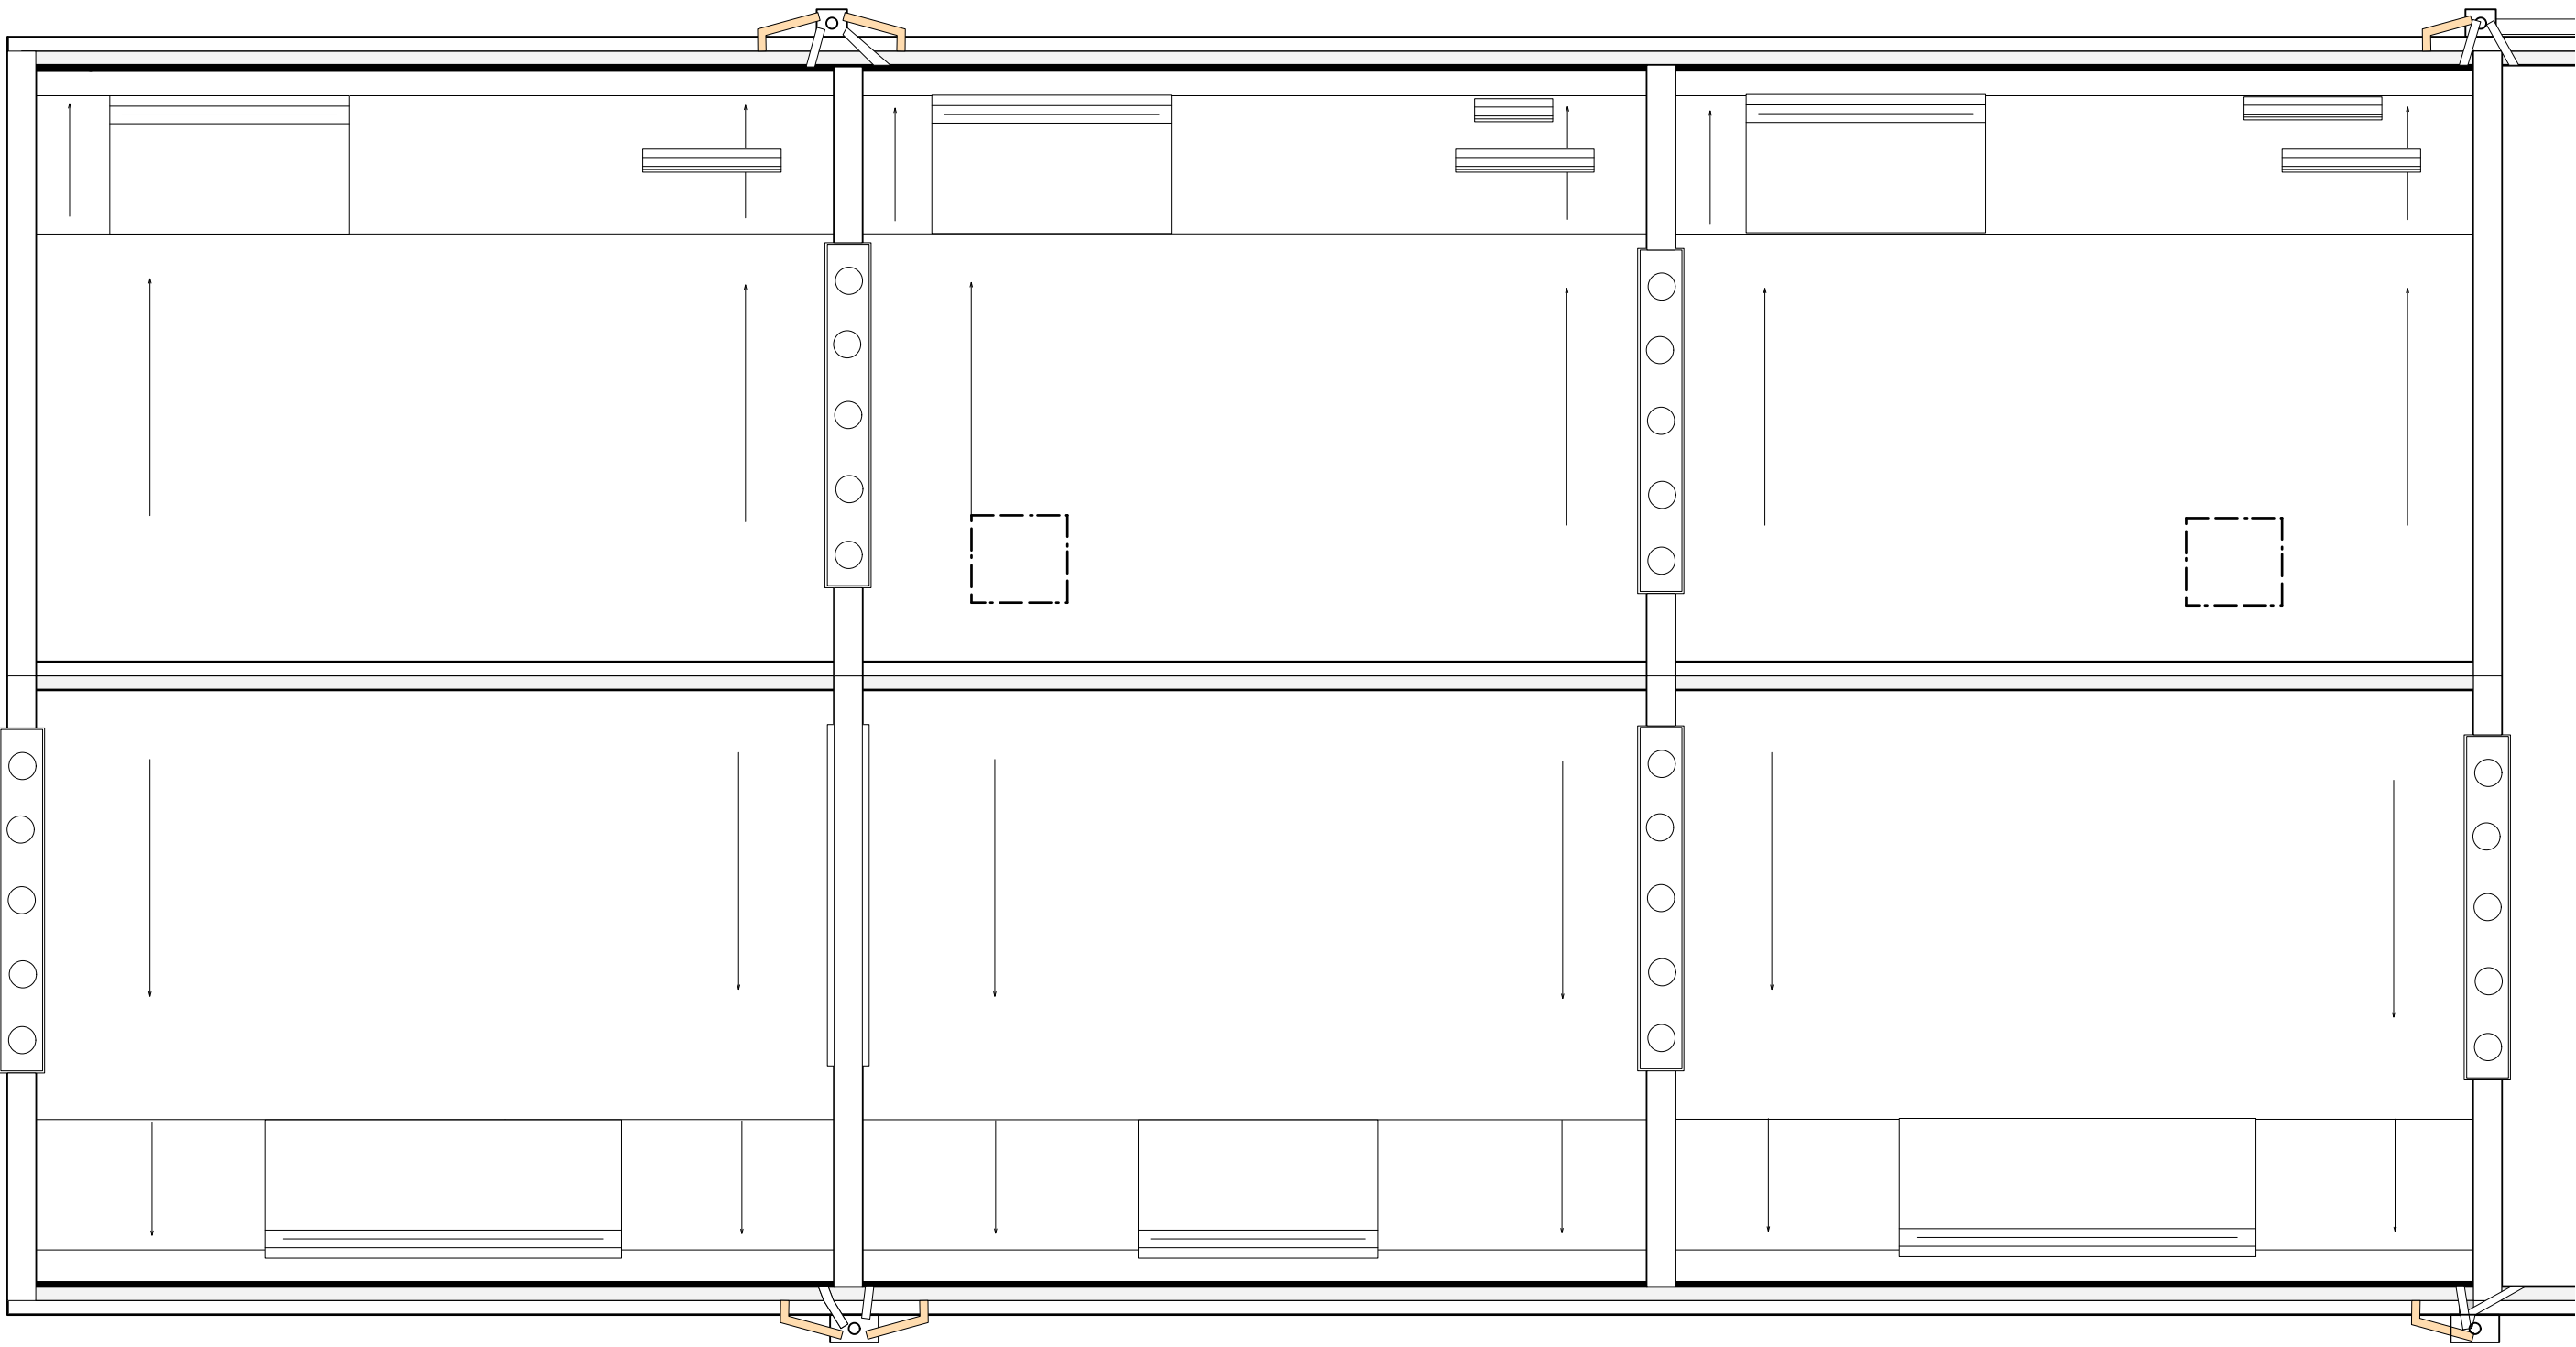

Front

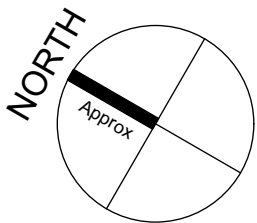

0 2.5 5.0 7.5 10.0 M

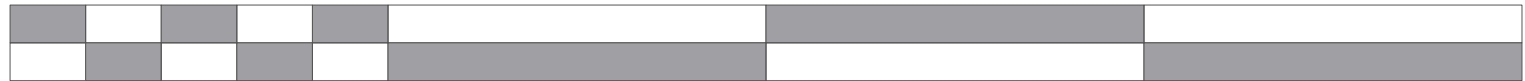

Scale 1:50 @ A2



Chartered Architects
Chartered Building Surveyors
Interior Designers
CDM Services

Suite 3, Sandford House
1b Claremont Rd, Teddington
TW11 8DH
+44 (0)20 8943 5300
www.kendallkingscott.co.uk

Project
Paul's House Refurbishment

Client
CLIC Sargent

Scale 1:50
Paper Size A2
Filename 180575.vwx
© Copyright Do not scale this drawing

D 23/09/2020 CB GC Update to As-Built Issue
C 25/10/19 CB GC Update to Construction Issue
B 10/10/19 JC GC Contract Issue
A 16/05/19 JC CB Tender Issue
Rev Date By Ap Note

Drawing Title
As-Built Roof Plan

Project Number Drawing Number - Revision

180575 L(2)06 D

Date 03/03/19 Drawn JC Checked EQ Status AS-BUILT

Check all dimensions and levels on site

Only to be used on the site for which designed. The electronic transmission of designs/information contained in this drawing is carried out entirely at the User's risk and Kendall Kingscott Ltd. will have no liability for any errors or inaccuracies arising therefrom. The production of amended or updated information from the said designs/information by the User is entirely the responsibility of the User and Kendall Kingscott Ltd. shall have no responsibility in respect thereof whatsoever.