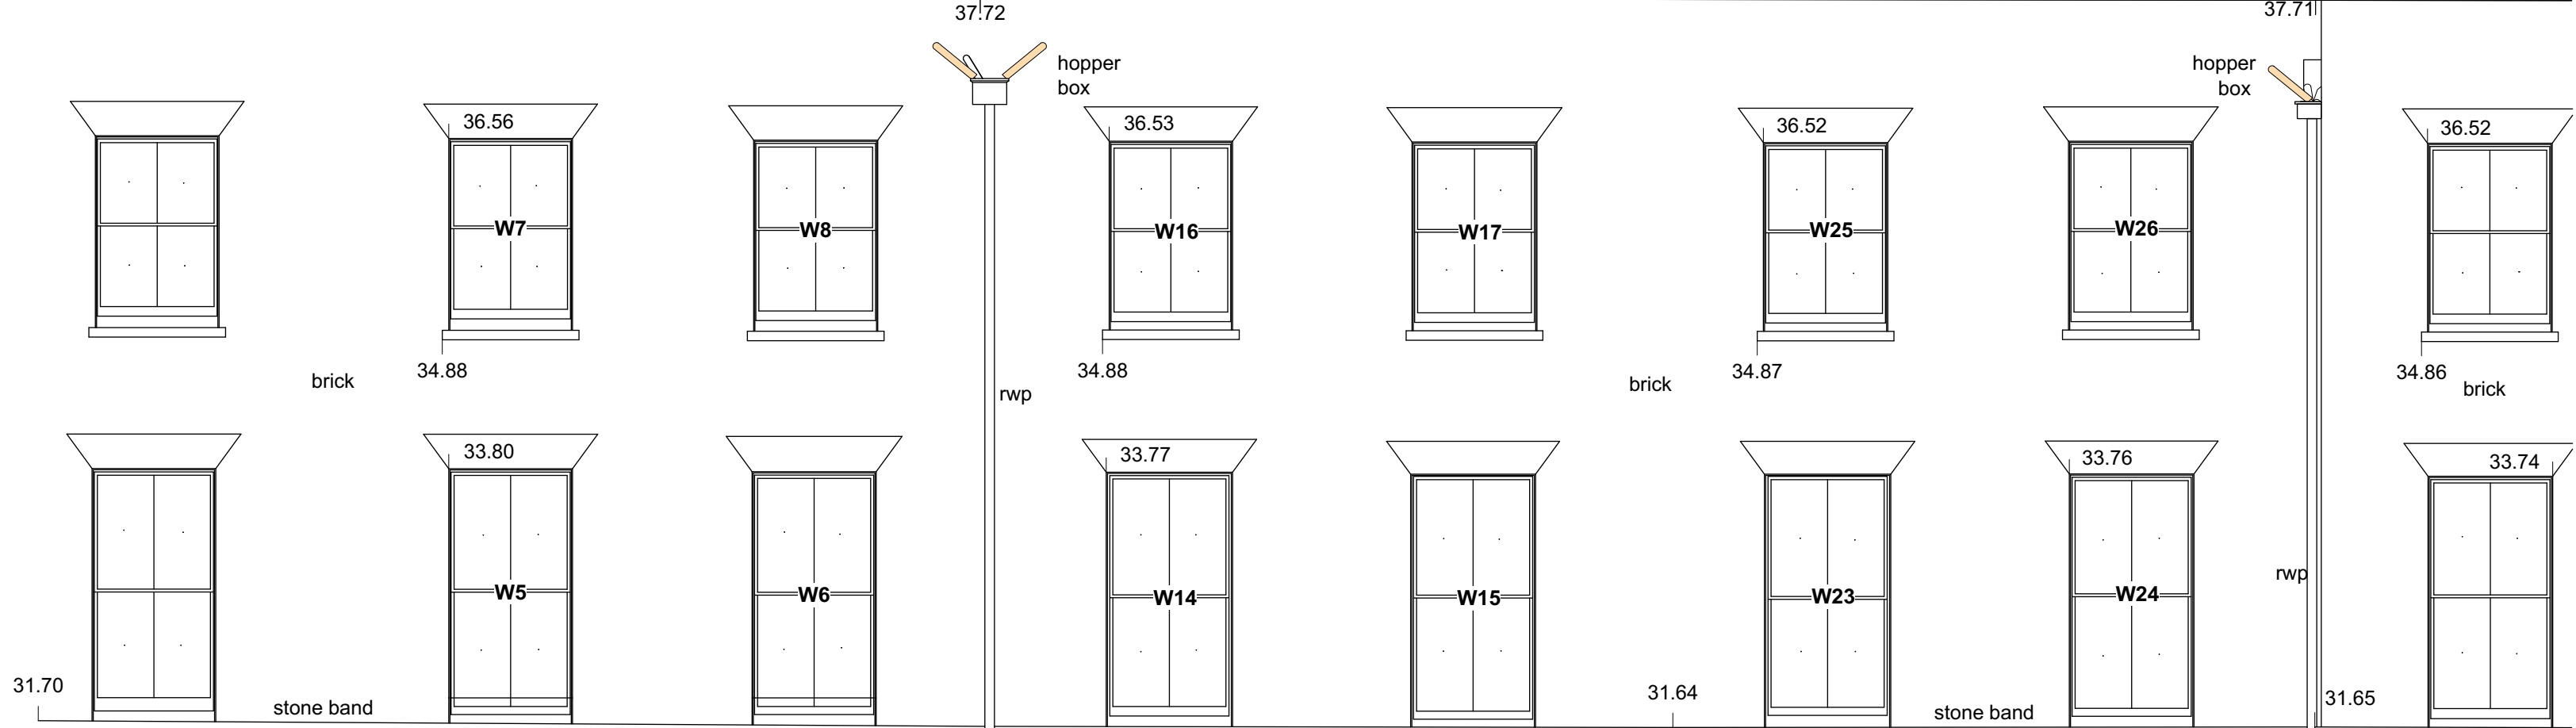
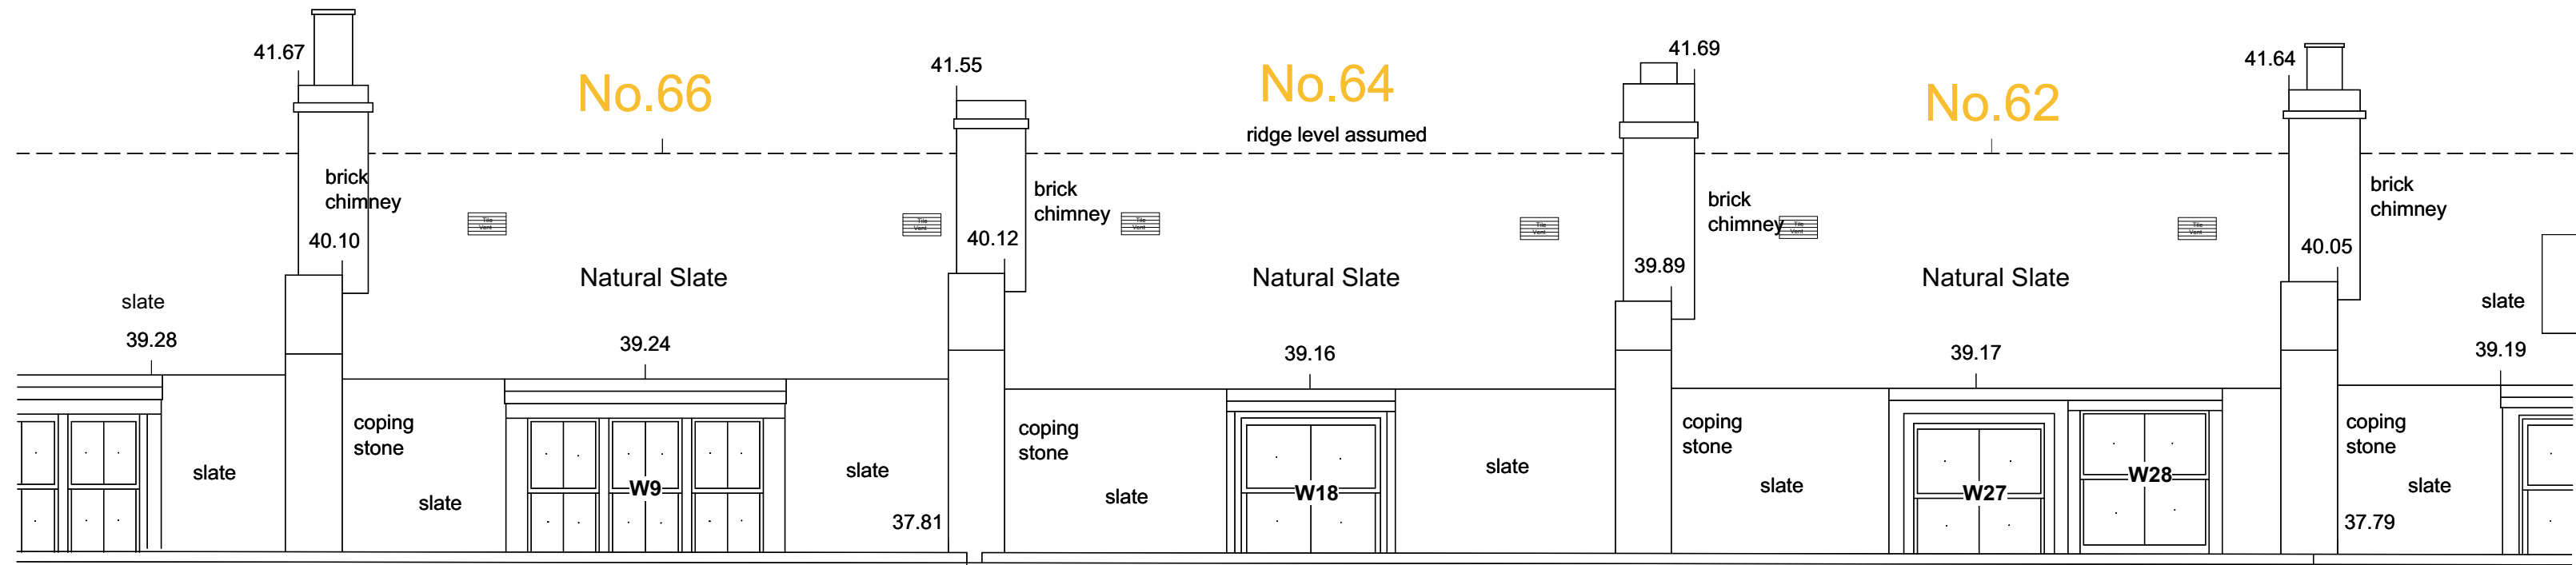


Scale 1:50 @ A2

**Kendall Kingscott**  
Suite 3 Sandford House  
1B Claremont Road  
Teddington TW11 8DH  
+44 (0)2089 435 300  
www.kendallkingscott.co.uk

Chartered Architects  
Chartered Building Surveyors  
Interior Designers  
CDM Services

Project  
**Paul's House Refurbishment**

Client  
**CLIC Sargent**

Scale 1:50  
Paper Size A2  
Filename 180575.vwx

F 09/03/22 MM LBC Submission  
E 05/05/2021 KA MM Lead Sleeve Added  
D 23/09/2020 CB GC Update to As-Built  
Rev Date By Ap Note

Drawing Title  
**As-Built Front Elevation**

Project Number Drawing Number - Revision

**180575 L(2)07 F**

Date Drawn Checked Status  
05/05/2021 KA MM AS-BUILT

Check all dimensions and levels on site © Copyright Do not scale this drawing

Only to be used on the site for which designed. The electronic transmission of designs/information contained in this drawing is carried out entirely at the User's risk and Kendall Kingscott Ltd. will have no liability for any errors or inaccuracies arising therefrom. The production of amended or updated information from the said designs/information by the User is entirely the responsibility of the User and Kendall Kingscott Ltd. shall have no responsibility in respect thereof whatsoever.