

Suite 3 Sandford House
1B Claremont Road
Teddington TW11 8DH
+44 (0)2089 435 300
www.kendallkingscott.co.uk

Chartered Architects
Chartered Building Surveyors
Interior Designers
CDM Services

Project
Paul's House Refurbishment

Client
CLIC Sargent

Scale 1:50
Paper Size A2
Filename 180575.vwx

G 09/03/22 MM LBC Submission
F 05/05/2021 KA MM Lead Sleeve Added
E 23/09/2020 CB GC Update to As-Built Issue
Rev Date By Ap Note


Drawing Title
As-Built Rear Elevation

Project Number Drawing Number - Revision
180575 L(2)08 G

Date Drawn Checked Status
05/05/2021 KA MM AS-BUILT

Check all dimensions and levels on site © Copyright Do not scale this drawing

0 2.5 5.0 7.5 10.0 M

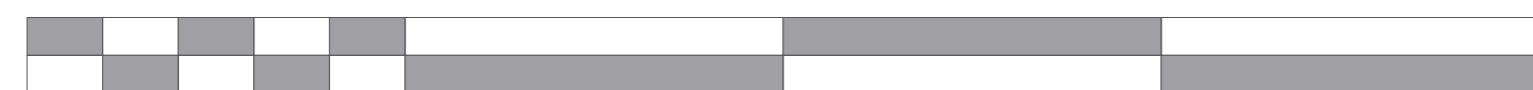

Scale 1:50 @ A2

Only to be used on the site for which designed. The electronic transmission of designs/information contained in this drawing is carried out entirely at the User's risk and Kendall Kingscott Ltd. will have no liability for any errors or inaccuracies arising therefrom. The production of amended or updated information from the said designs/information by the User is entirely the responsibility of the User and Kendall Kingscott Ltd. shall have no responsibility in respect thereof whatsoever.