

External Facade Elevation With Grille Location  
 Scale: 1:50 @ A1



North Elevation - pt 1 of 2

Revision	Date	Description
1.0	21-12-2020	Issued for planning application
2.0	19-07-2022	Markups of grilles for planning application issue

Do not reproduce this drawing without written permission.  
 All dimensions are in millimetres unless stated otherwise.

Drawing Not For Construction

High Speed (HS2) Limited  
 1st-3rd Floor  
 The Podium  
 1 Eversholt Street  
 London NW1 2DN

Costain Skanska Joint Venture  
 3rd Floor  
 Addison Lee Compound  
 Granby Terrace  
 London NW1 3SA

Site Address 3-14 Mornington Terrace, London, NW1			
Drawing Title External Elevation-Proposed			
Drawn by AP	Reviewed by AP	Checked by MA	Presentation Scale 1:50 @ A1
Date 18-12-2020	Drawing No. EW-NI-MORNINGTON TER-PR-EL-01	Revision 2.0	

External Facade Elevation With Grille Location  
 Scale: 1:50 @ A1



North Elevation - pt 2 of 2

Revision	Date	Description
1.0	21-12-2020	Issued for planning application
2.0	19-07-2022	Markups of grilles for planning application issue

Do not reproduce this drawing without written permission.  
 All dimensions are in millimetres unless stated otherwise.


**High Speed (HS2) Limited**  
 1st-3rd Floor  
 The Podium  
 1 Eversholt Street  
 London NW1 2DN

**Costain Skanska Joint Venture**  
 3rd Floor  
 Addison Lee Compound  
 Granby Terrace  
 London NW1 3SA

Site Address 3-14 Mornington Terrace, London, NW1			
Drawing Title External Elevation-Proposed			
Drawn by AP	Reviewed by AP	Checked by MA	Presentation Scale 1:50 @ A1
Date 18-12-2020	Drawing No. EW-NI-MORNINGTON TER-PR-EL-01		Revision 2.0

Drawing Not For Construction

External Facade Elevation With Grille Location  
 Scale: 1:50 @ A1

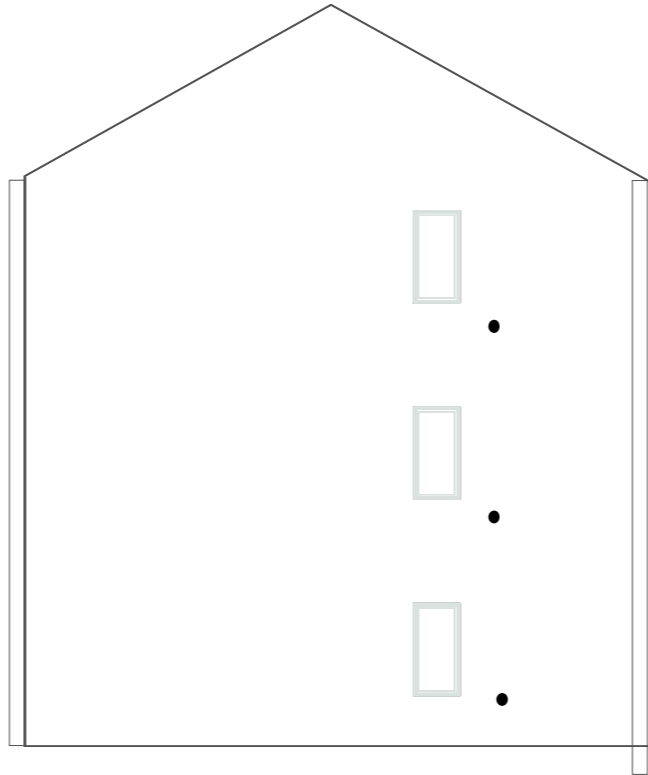

West Elevation

Revision	Date	Description
1.0	21-12-2020	Issued for planning application
2.0	19-07-2022	Markups of grilles for planning application issue

Do not reproduce this drawing without written permission.  
 All dimensions are in millimetres unless stated otherwise.

Drawing Not For Construction


**High Speed (HS2) Limited**  
 1st-3rd Floor  
 The Podium  
 1 Eversholt Street  
 London NW1 2DN

**Costain Skanska Joint Venture**  
 3rd Floor  
 Addison Lee Compound  
 Granby Terrace  
 London NW1 3SA

Site Address 3-14 Mornington Terrace, London, NW1			
Drawing Title External Elevation-Proposed			
Drawn by AP	Reviewed by AP	Checked by MA	Presentation Scale 1:50 @ A1
Date 18-12-2020	Drawing No. EW-NI-MORNINGTON TER-PR-EL-01		Revision 2.0

External Facade Elevation With Grille Location

Scale: 1:50 @ A1

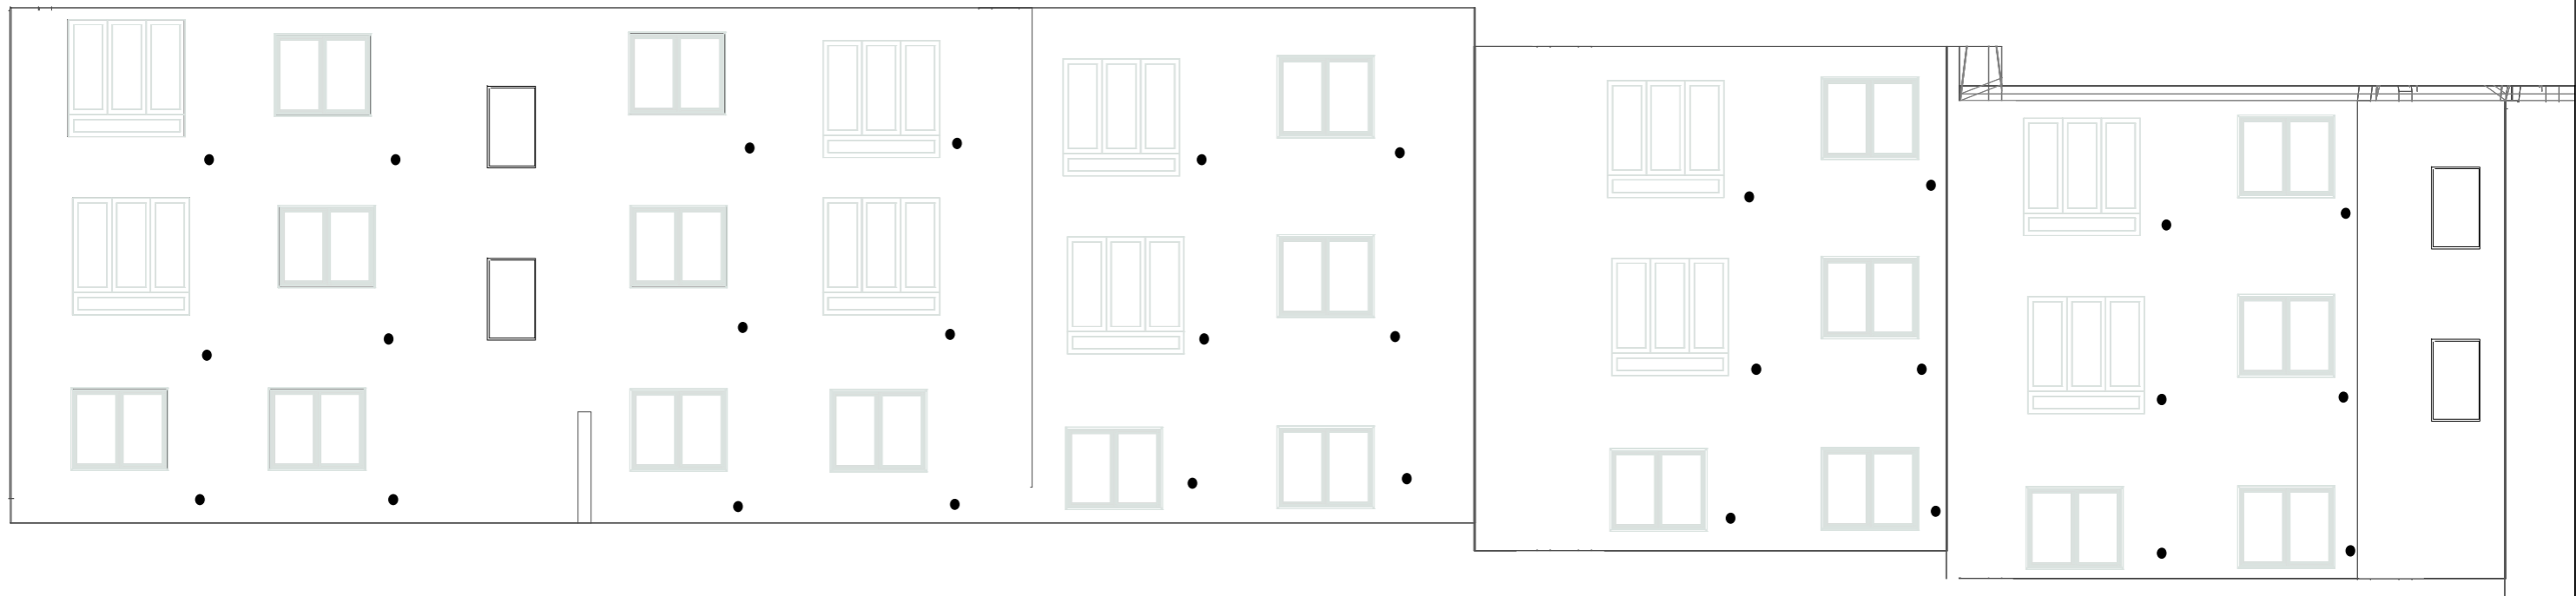

South Elevation - pt 1 of 2

Revision	Date	Description
1.0	21-12-2020	Issued for planning application
2.0	19-07-2022	Markups of grilles for planning application issue

Do not reproduce this drawing without written permission.  
All dimensions are in millimetres unless stated otherwise.


Drawing Not For Construction

High Speed (HS2) Limited  
1st-3rd Floor  
The Podium  
1 Eversholt Street  
London NW1 2DN

Costain Skanska Joint Venture  
3rd Floor  
Addison Lee Compound  
Granby Terrace  
London NW1 3SA

Site Address 3-14 Mornington Terrace, London, NW1			
Drawing Title External Elevation-Proposed			
Drawn by AP	Reviewed by AP	Checked by MA	Presentation Scale 1:50 @ A1
Date 18-12-2020	Drawing No. EW-NI-MORNINGTON TER-PR-EL-01		Revision 2.0

External Facade Elevation With Grille Location  
 Scale: 1:50 @ A1

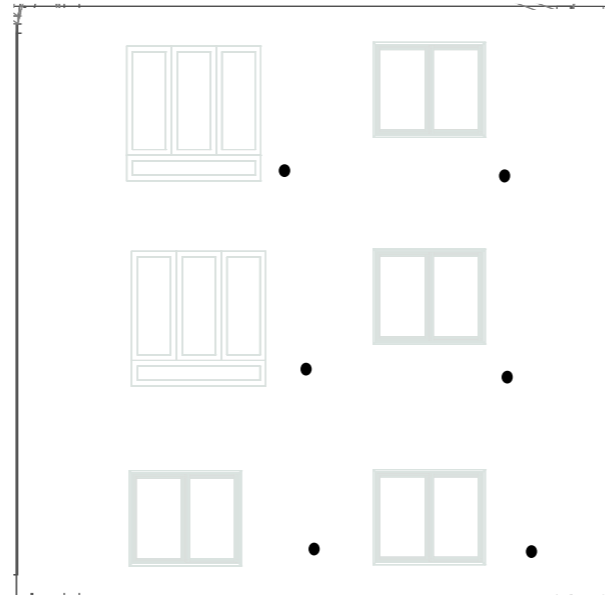

South Elevation - pt 2 of 2

Revision	Date	Description
1.0	21-12-2020	Issued for planning application
2.0	19-07-2022	Markups of grilles for planning application issue

Do not reproduce this drawing without written permission.  
 All dimensions are in millimetres unless stated otherwise.

Drawing Not For Construction

**High Speed (HS2) Limited**  
 1st-3rd Floor  
 The Podium  
 1 Eversholt Street  
 London NW1 2DN

**Costain Skanska Joint Venture**  
 3rd Floor  
 Addison Lee Compound  
 Granby Terrace  
 London NW1 3SA

Site Address 3-14 Mornington Terrace, London, NW1			
Drawing Title External Elevation-Proposed			
Drawn by AP	Reviewed by AP	Checked by MA	Presentation Scale 1:50 @ A1
Date 18-12-2020	Drawing No. EW-NI-MORNINGTON TER-PR-EL-01		Revision 2.0