

PLEASE NOTE:

1. All dimensions to be checked on site before fabrication,
2. Contractor to refer to engineers drawings before proceeding with works.
3. All drawings and designs are covered by design right (intellectual property), and may not be distributed, copied or issued without written permission by the Architect.
4. All design concepts are the sole property of the Architect and no adaptations, reproductions or copies may be made without written permission of the Architect.
5. These drawings are subject to any variation required or recommendation by any statutory authority, or for the better carrying out of the works.
6. Samples to be provided by contractor for XUL Architecture's approval.
7. All finishes to XUL Architecture's satisfaction.
8. All drawings to be approved by XUL Architecture prior to construction.

ADDITIONAL NOTE:

Issue key: Tender (T)
 Information (I) Construction (C)
 Planning (P) As Built (B)

Project Address
 6 Provost Rd, NW3 4ST

PROPOSED
 Site Plan

Scale
 1:100@A3

Dwg. No.
 PA-00

Rev. Date
 25.05.22


Rev.
 P-02

Drawn
 CS

Project Number
 21155

Checked
 SS


Issue For:
 PLANNING

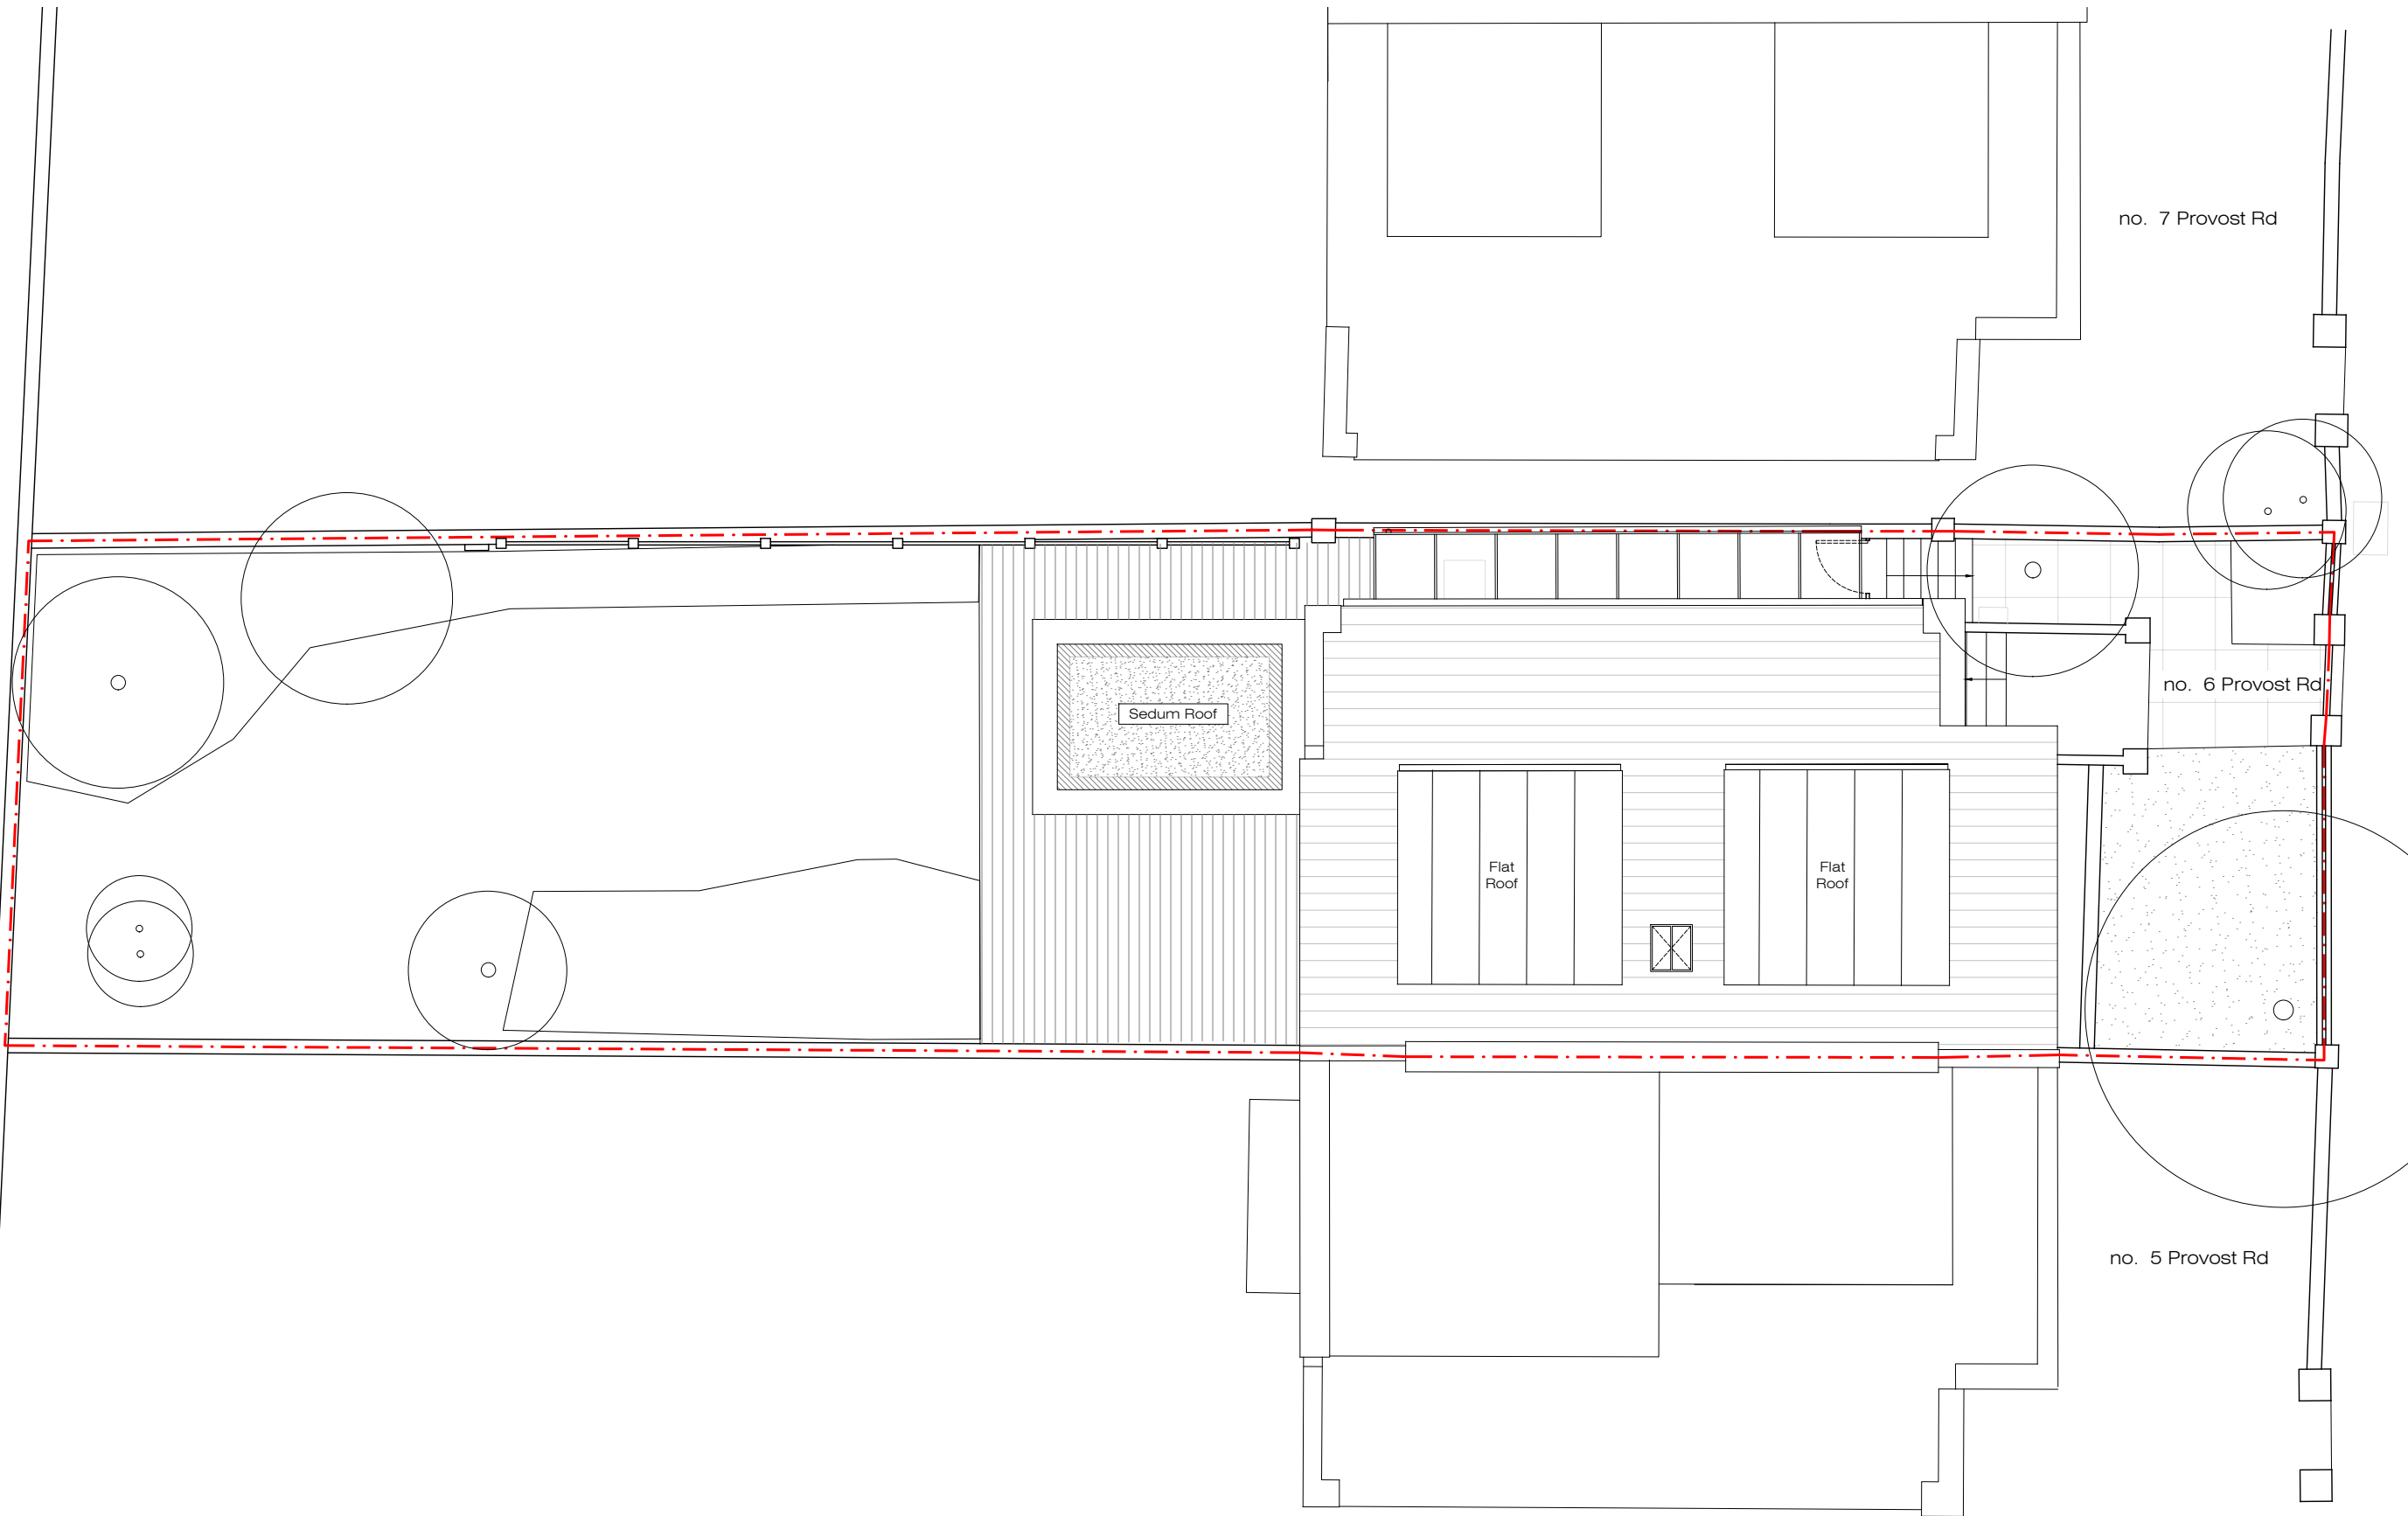

PLEASE NOTE:

1. All dimensions to be checked on site before fabrication,
2. Contractor to refer to engineers drawings before proceeding with works.
3. All drawings and designs are covered by design right (intellectual property), and may not be distributed, copied or issued without written permission by the Architect.
4. All design concepts are the sole property of the Architect and no adaptations, reproductions or copies may be made without written permission of the Architect.
5. These drawings are subject to any variation required or recommendation by any statutory authority, or for the better carrying out of the works.
6. Samples to be provided by contractor for XUL Architecture's approval.
7. All finishes to XUL Architecture's satisfaction.
8. All drawings to be approved by XUL Architecture prior to construction.


ADDITIONAL NOTE:

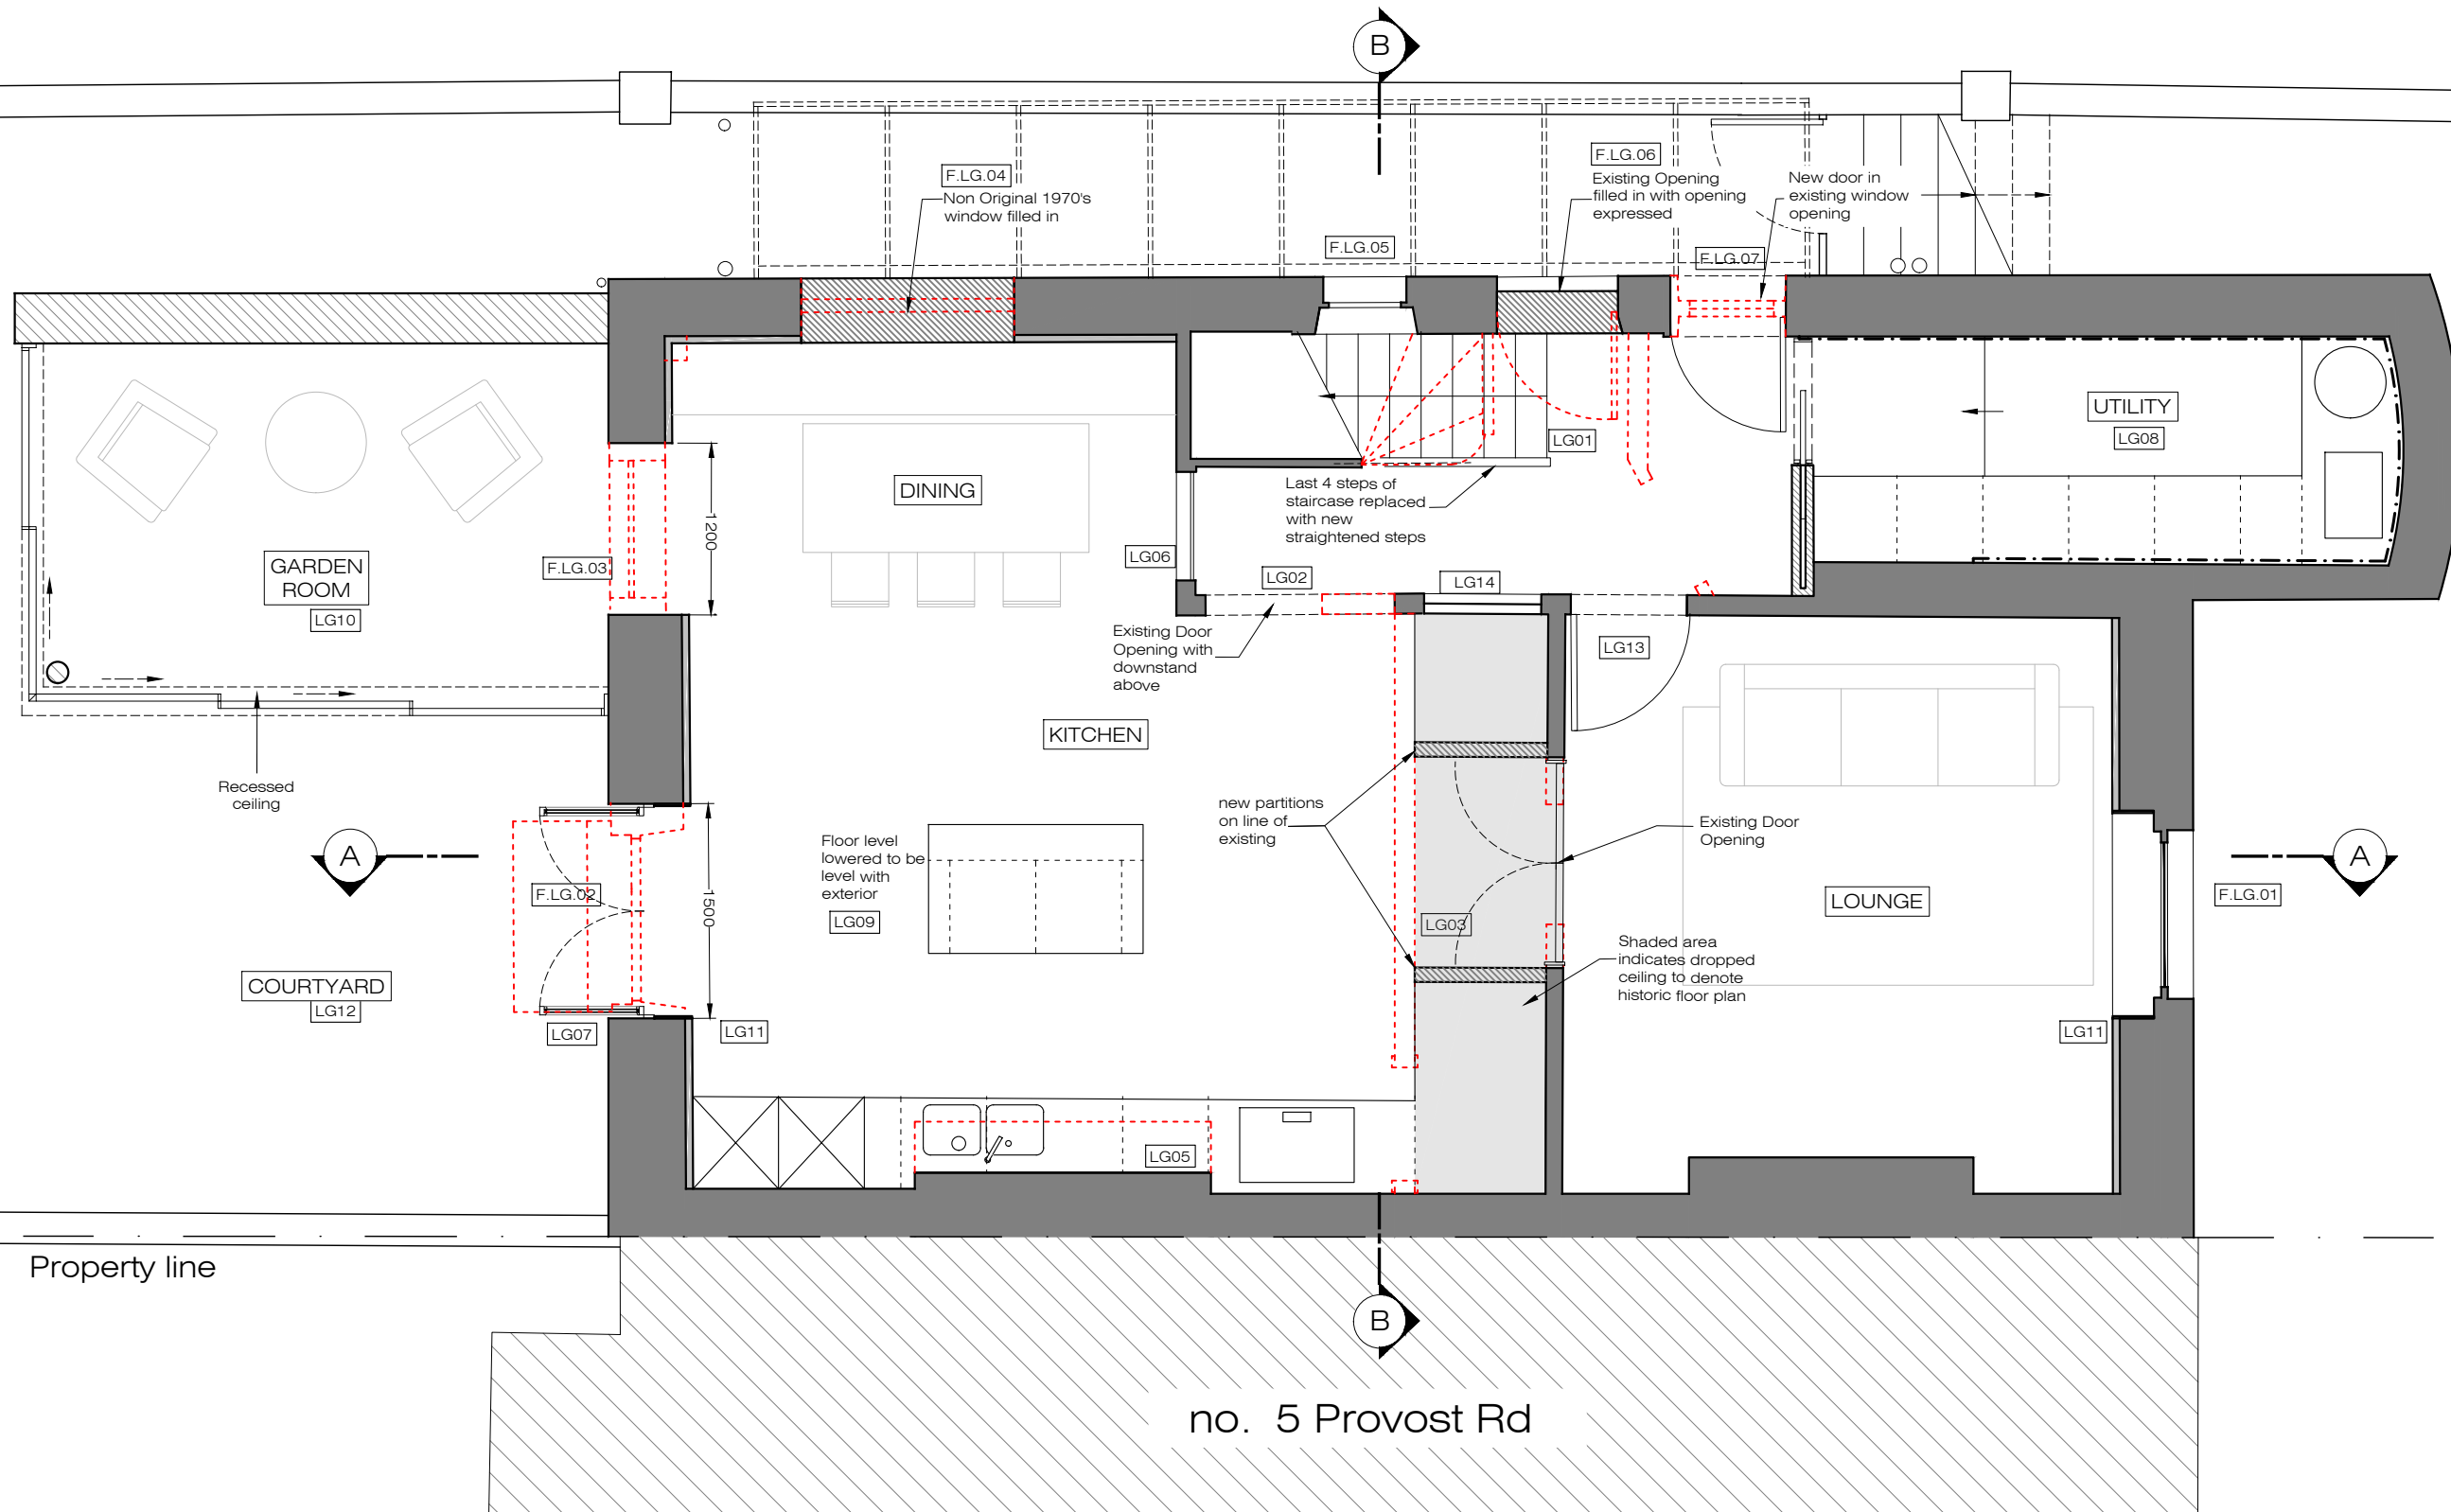

Property line

no. 5 Provost Rd

X PROPOSED
Lower Ground Floor Plan 1:50@A3

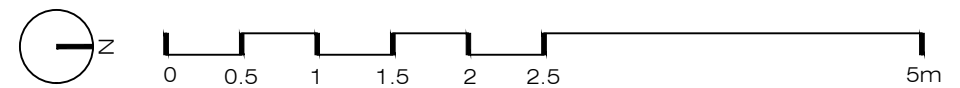


Issue key: Tender (T)
Information (I) Construction (C)
Planning (P) As Built (B)


Project Address
6 Provost Rd, NW3 4ST

PROPOSED
Lower Ground Floor Plan


Scale 1:50@A3	Dwg. No. PA-01
Rev. Date 10.08.22	Rev. P-08
Drawn CS	Project Number 21155
Checked SS	Issue For: PLANNING

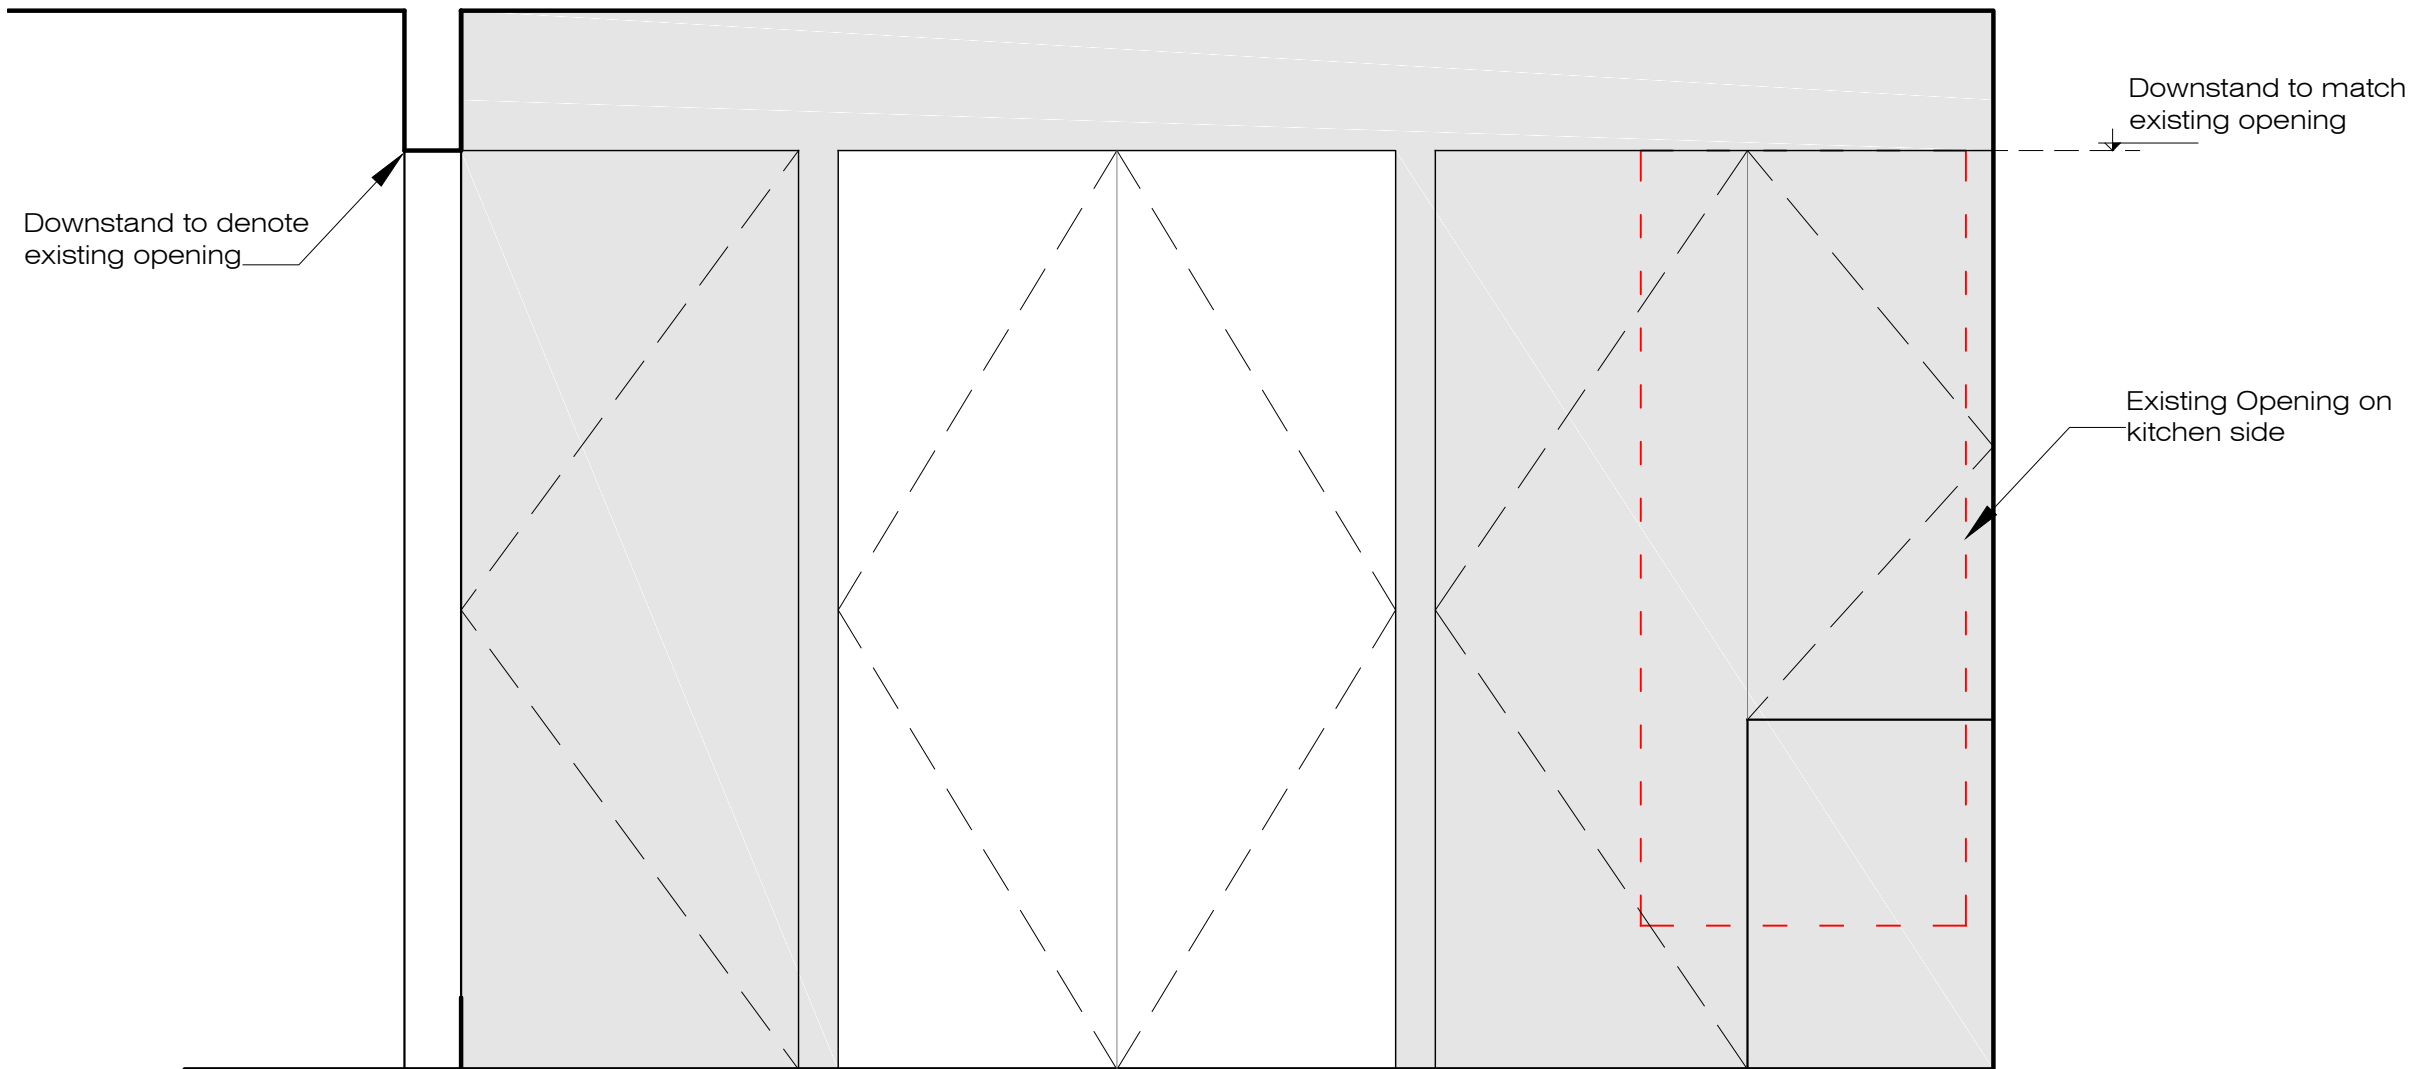

Internal Elevation

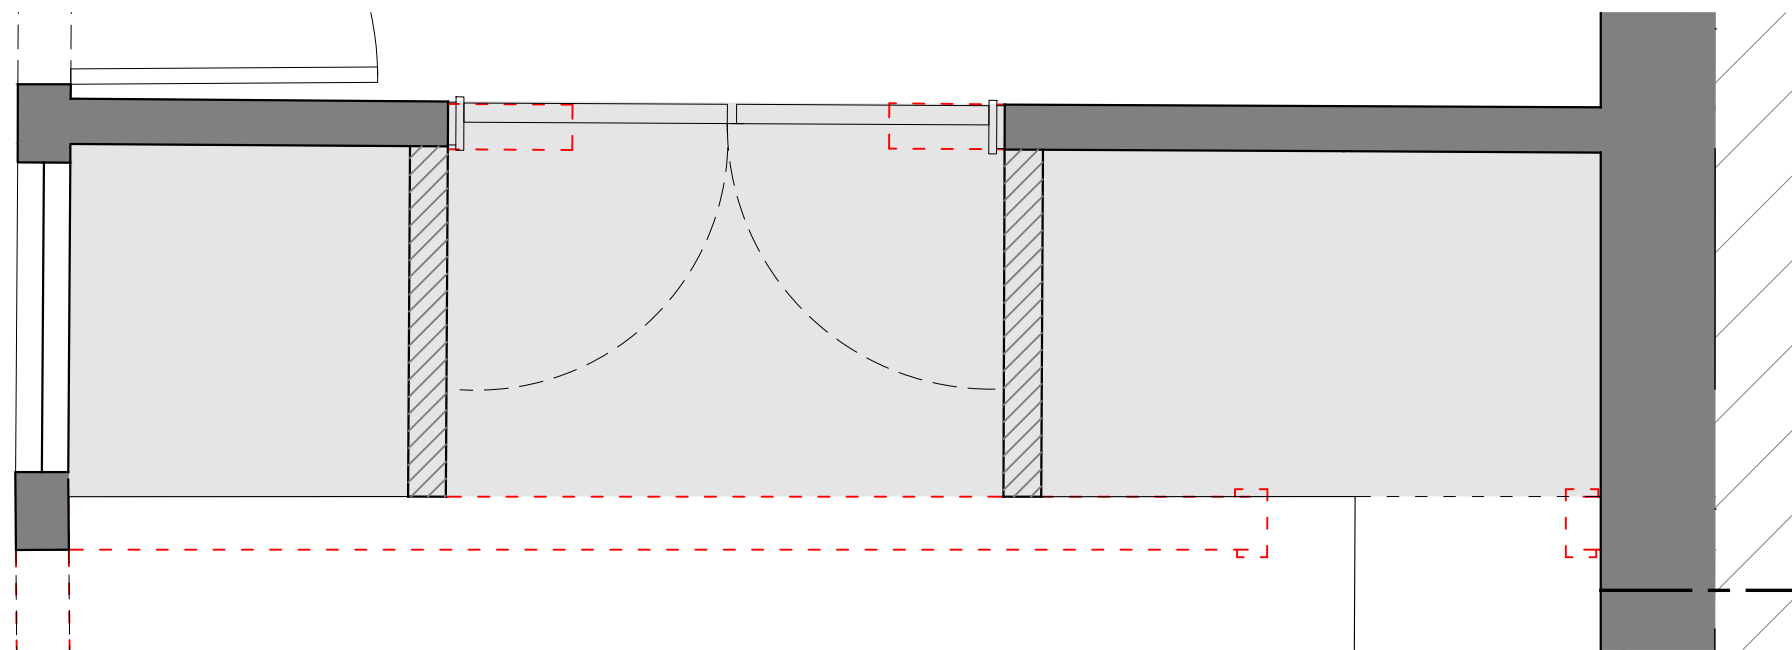

Extract from LGF plan

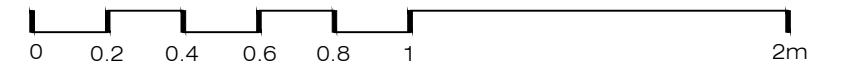

Ground Floor Office
33 Beisize Lane
London NW3 5AS
Office: +44 (0) 207 431 9014
info@xularchitecture.co.uk
www.xularchitecture.co.uk

PLEASE NOTE:

1. All dimensions to be checked on site before fabrication,
2. Contractor to refer to engineers drawings before proceeding with works.
3. All drawings and designs are covered by design right (intellectual property), and may not be distributed, copied or issued without written permission by the Architect.
4. All design concepts are the sole property of the Architect and no adaptations, reproductions or copies may be made without written permission of the Architect.
5. These drawings are subject to any variation required or recommendation by any statutory authority, or for the better carrying out of the works.
6. Samples to be provided by contractor for XUL Architecture's approval.
7. All finishes to XUL Architecture's satisfaction.
8. All drawings to be approved by XUL Architecture prior to construction.

ADDITIONAL NOTE:

Issue key:

- Information (I)
- Planning (P)
- Tender (T)
- Construction (C)
- As Built (B)

Project Address
6 Provost Rd, NW3 4ST

Scale 1:20@A3 PROPOSED

Rev. Date 10.08.22 LGF Internal Elevation

Drawn	CS	Dwg. No.	SK-01	Rev.	P-03
Checked	SS	Project Number	21155		

Issue For:
PLANNING

PLEASE NOTE:

1. All dimensions to be checked on site before fabrication,
2. Contractor to refer to engineers drawings before proceeding with works.
3. All drawings and designs are covered by design right (intellectual property), and may not be distributed, copied or issued without written permission by the Architect.
4. All design concepts are the sole property of the Architect and no adaptations, reproductions or copies may be made without written permission of the Architect.
5. These drawings are subject to any variation required or recommendation by any statutory authority, or for the better carrying out of the works.
6. Samples to be provided by contractor for XUL Architecture's approval.
7. All finishes to XUL Architecture's satisfaction.
8. All drawings to be approved by XUL Architecture prior to construction.

ADDITIONAL NOTE:

Issue key: Tender (T)
 Information (I) Construction (C)
 Planning (P) As Built (B)

Project Address
 6 Provost Rd, NW3 4ST


PROPOSED
 Upper Ground Floor Plan

Scale
 1:50@A3 Dwg. No.
 PA-02


Rev. Date
 01.08.22 Rev.
 P-02

Drawn
 CS Project Number
 21155

Checked
 SS Issue For:
 PLANNING

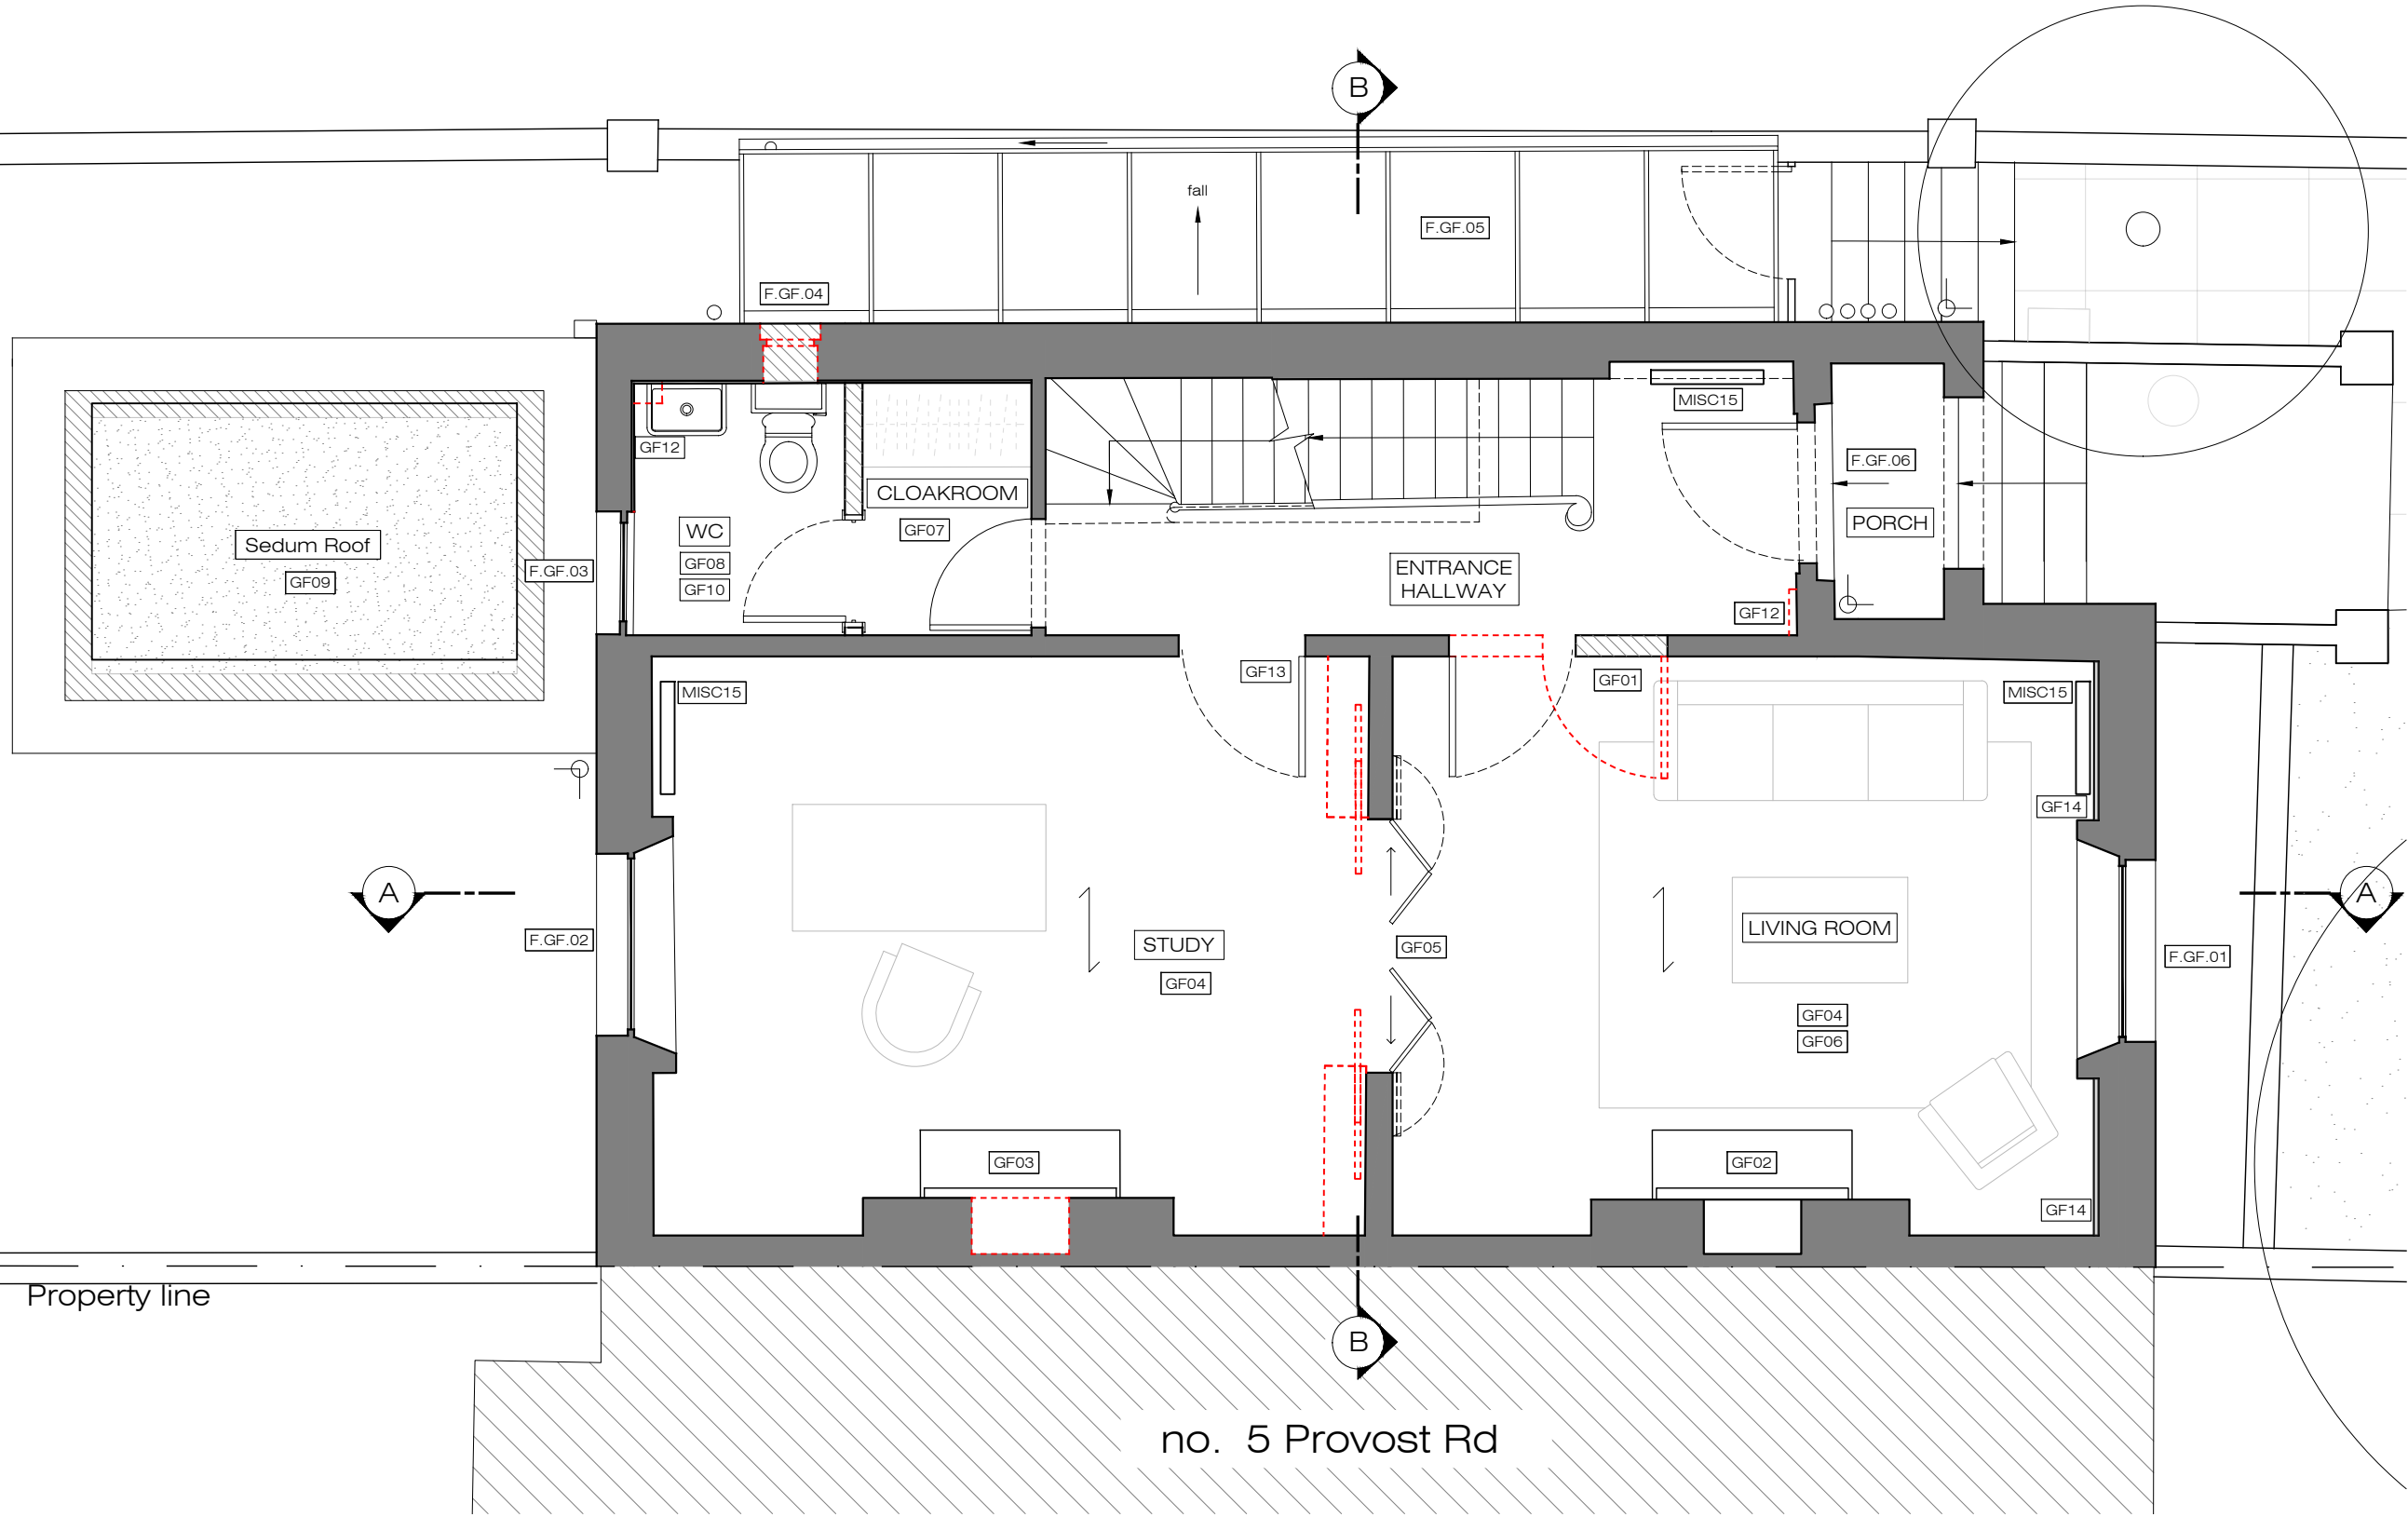


X PROPOSED
 Upper Ground Floor Plan 1:50@A3

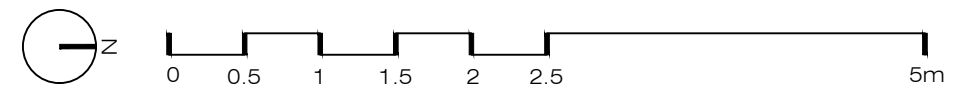

PLEASE NOTE:

1. All dimensions to be checked on site before fabrication,
2. Contractor to refer to engineers drawings before proceeding with works.
3. All drawings and designs are covered by design right (intellectual property), and may not be distributed, copied or issued without written permission by the Architect.
4. All design concepts are the sole property of the Architect and no adaptations, reproductions or copies may be made without written permission of the Architect.
5. These drawings are subject to any variation required or recommendation by any statutory authority, or for the better carrying out of the works.
6. Samples to be provided by contractor for XUL Architecture's approval.
7. All finishes to XUL Architecture's satisfaction.
8. All drawings to be approved by XUL Architecture prior to construction.

ADDITIONAL NOTE:

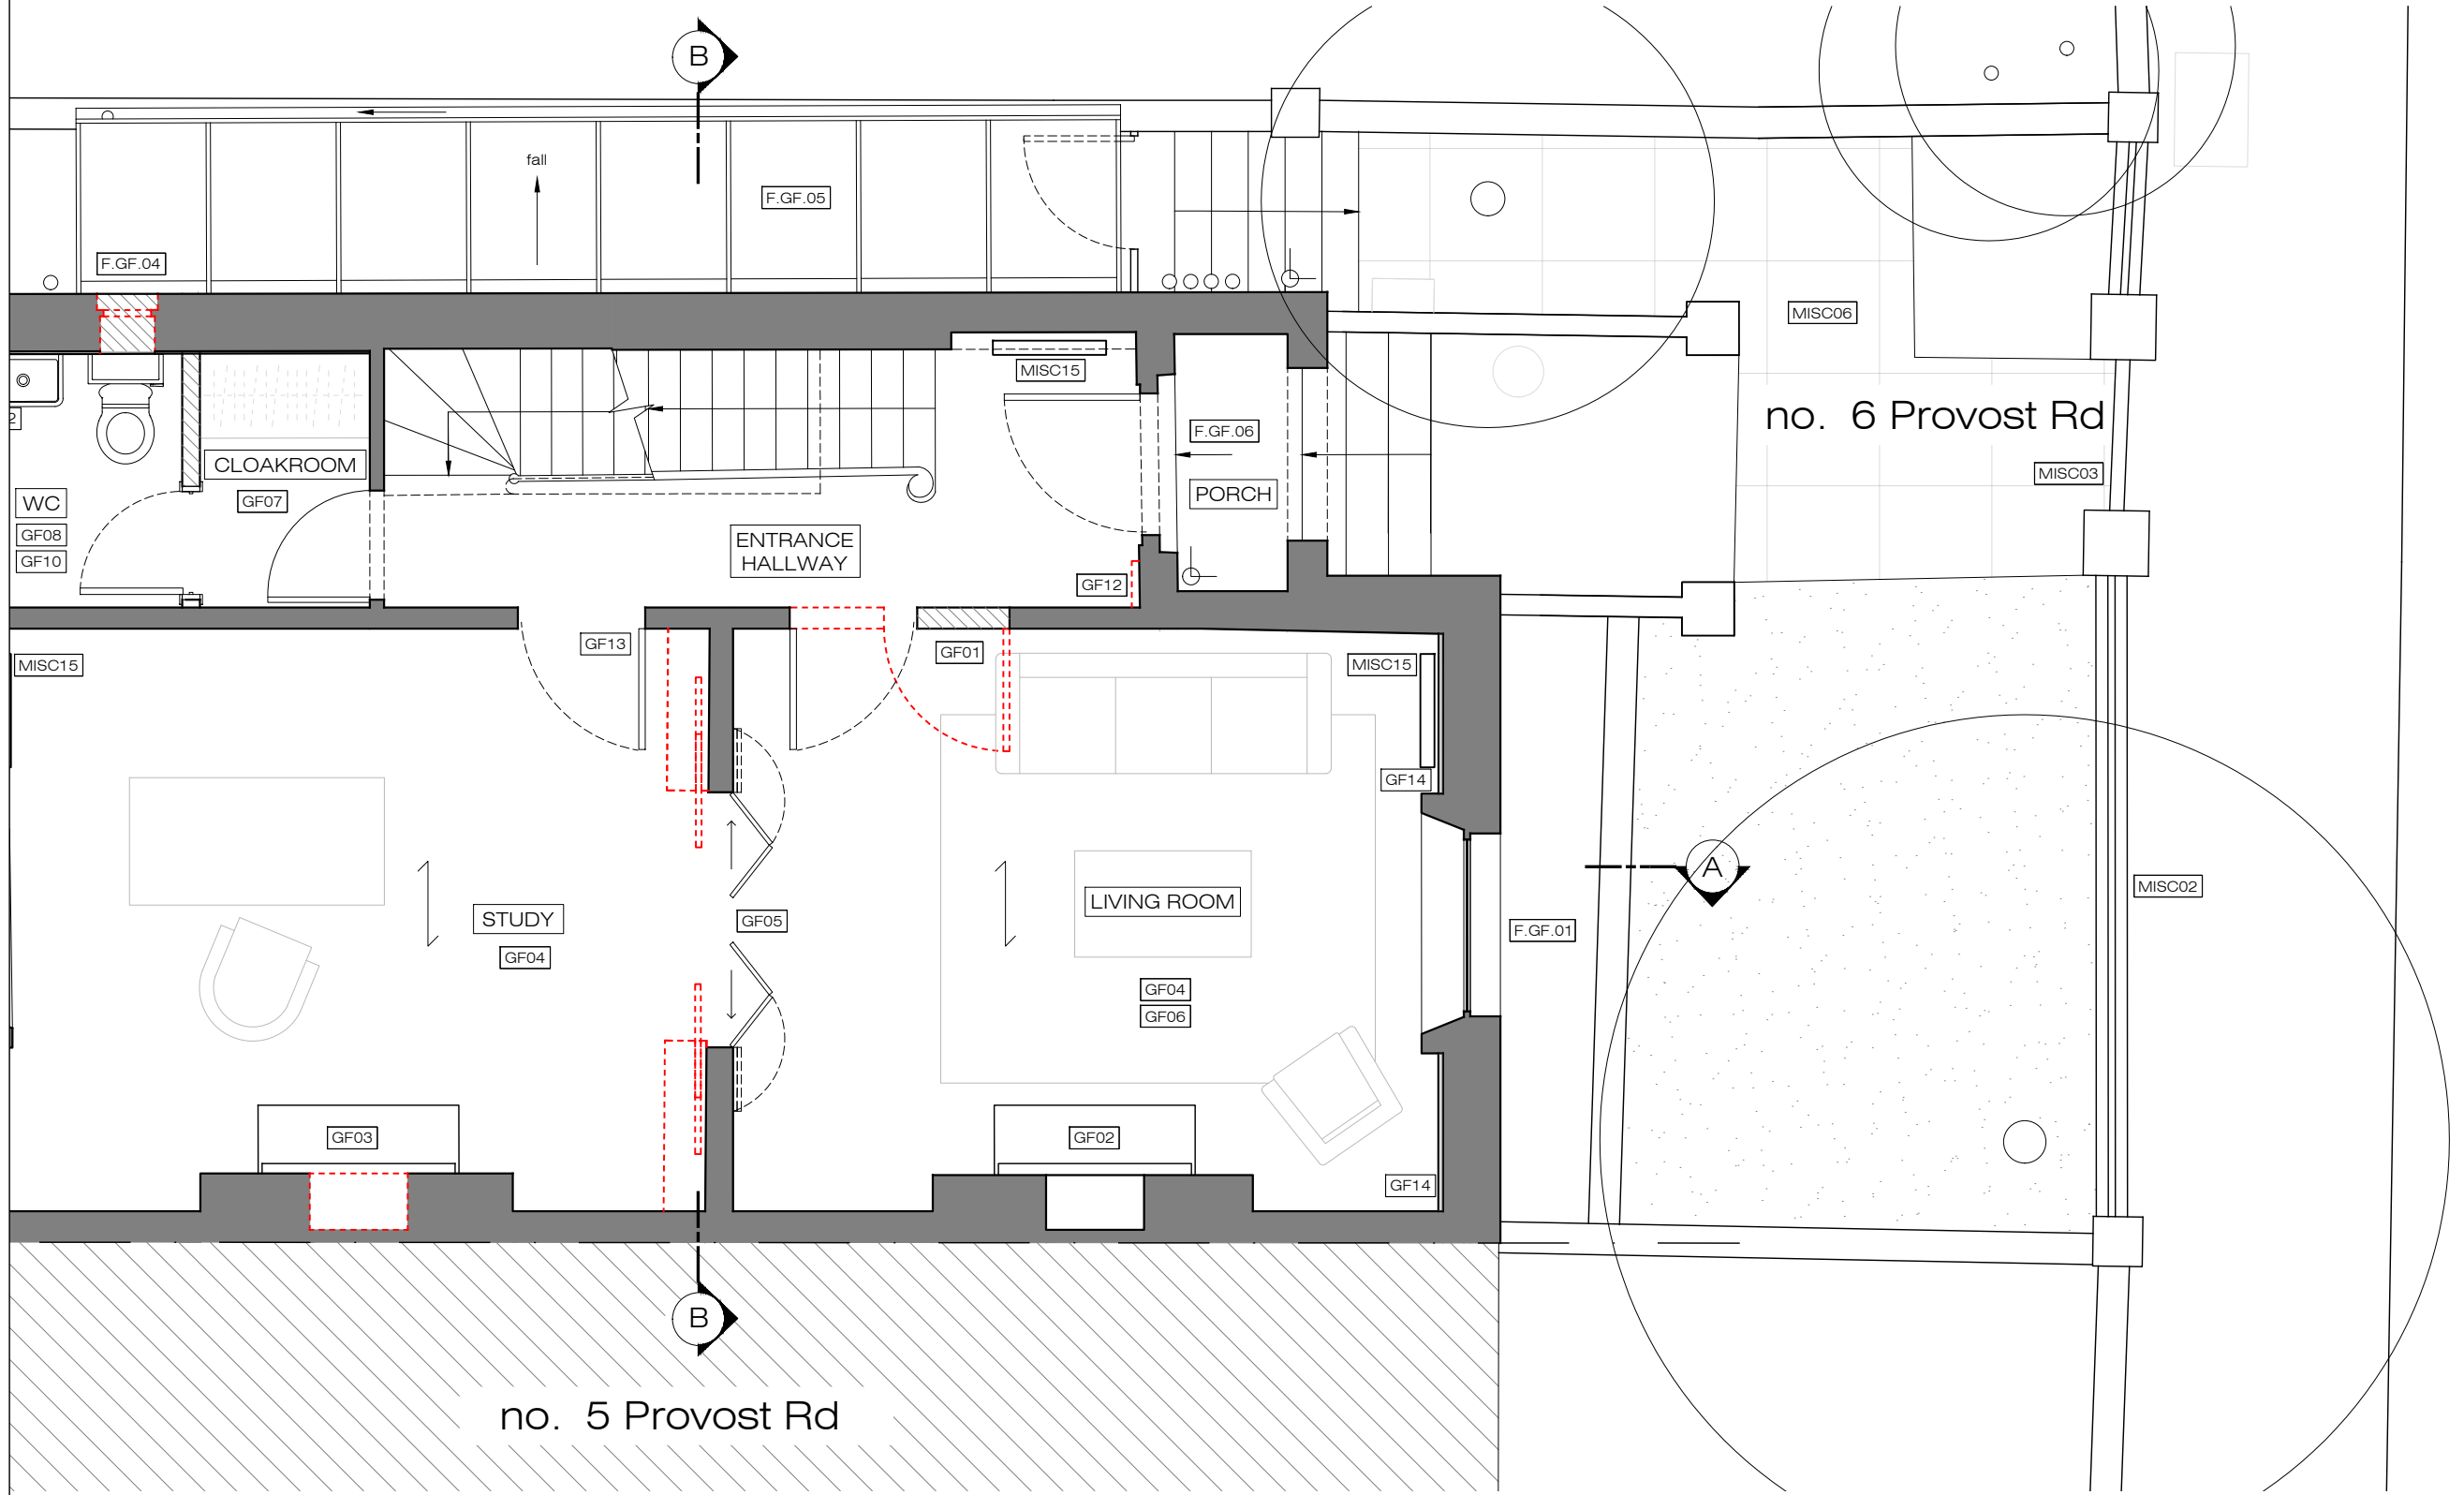


X PROPOSED
Upper Ground Floor Plan - Front Garden 1:50@A3

Issue key: Tender (T)
Information (I) Construction (C)
Planning (P) As Built (B)

Project Address
6 Provost Rd, NW3 4ST

PROPOSED
Upper Ground Floor Plan - Front Garden

Scale 1:50@A3	Dwg. No. PA-03
Rev. Date 01.08.22	Rev. P-03
Drawn AT	Project Number 21155
Checked SS	Issue For: PLANNING

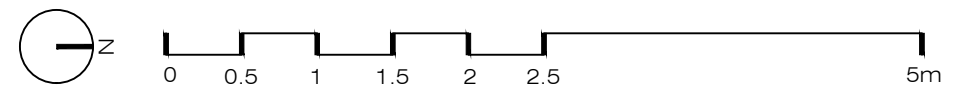

PLEASE NOTE:

1. All dimensions to be checked on site before fabrication,
2. Contractor to refer to engineers drawings before proceeding with works.
3. All drawings and designs are covered by design right (intellectual property), and may not be distributed, copied or issued without written permission by the Architect.
4. All design concepts are the sole property of the Architect and no adaptations, reproductions or copies may be made without written permission of the Architect.
5. These drawings are subject to any variation required or recommendation by any statutory authority, or for the better carrying out of the works.
6. Samples to be provided by contractor for XUL Architecture's approval.
7. All finishes to XUL Architecture's satisfaction.
8. All drawings to be approved by XUL Architecture prior to construction.

ADDITIONAL NOTE:

Issue key: Tender (T)
 Information (I) Construction (C)
 Planning (P) As Built (B)

Project Address
 6 Provost Rd, NW3 4ST



PROPOSED
 First Floor Plan

Scale 1:50@A3 Dwg. No. PA-04

Rev. Date 01.08.22 Rev. P-03

Drawn CS Project Number 21155


Checked SS Issue For: PLANNING

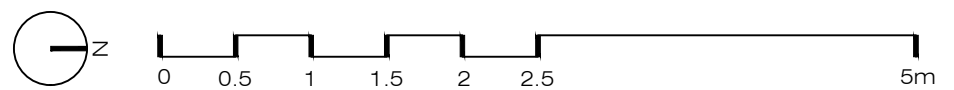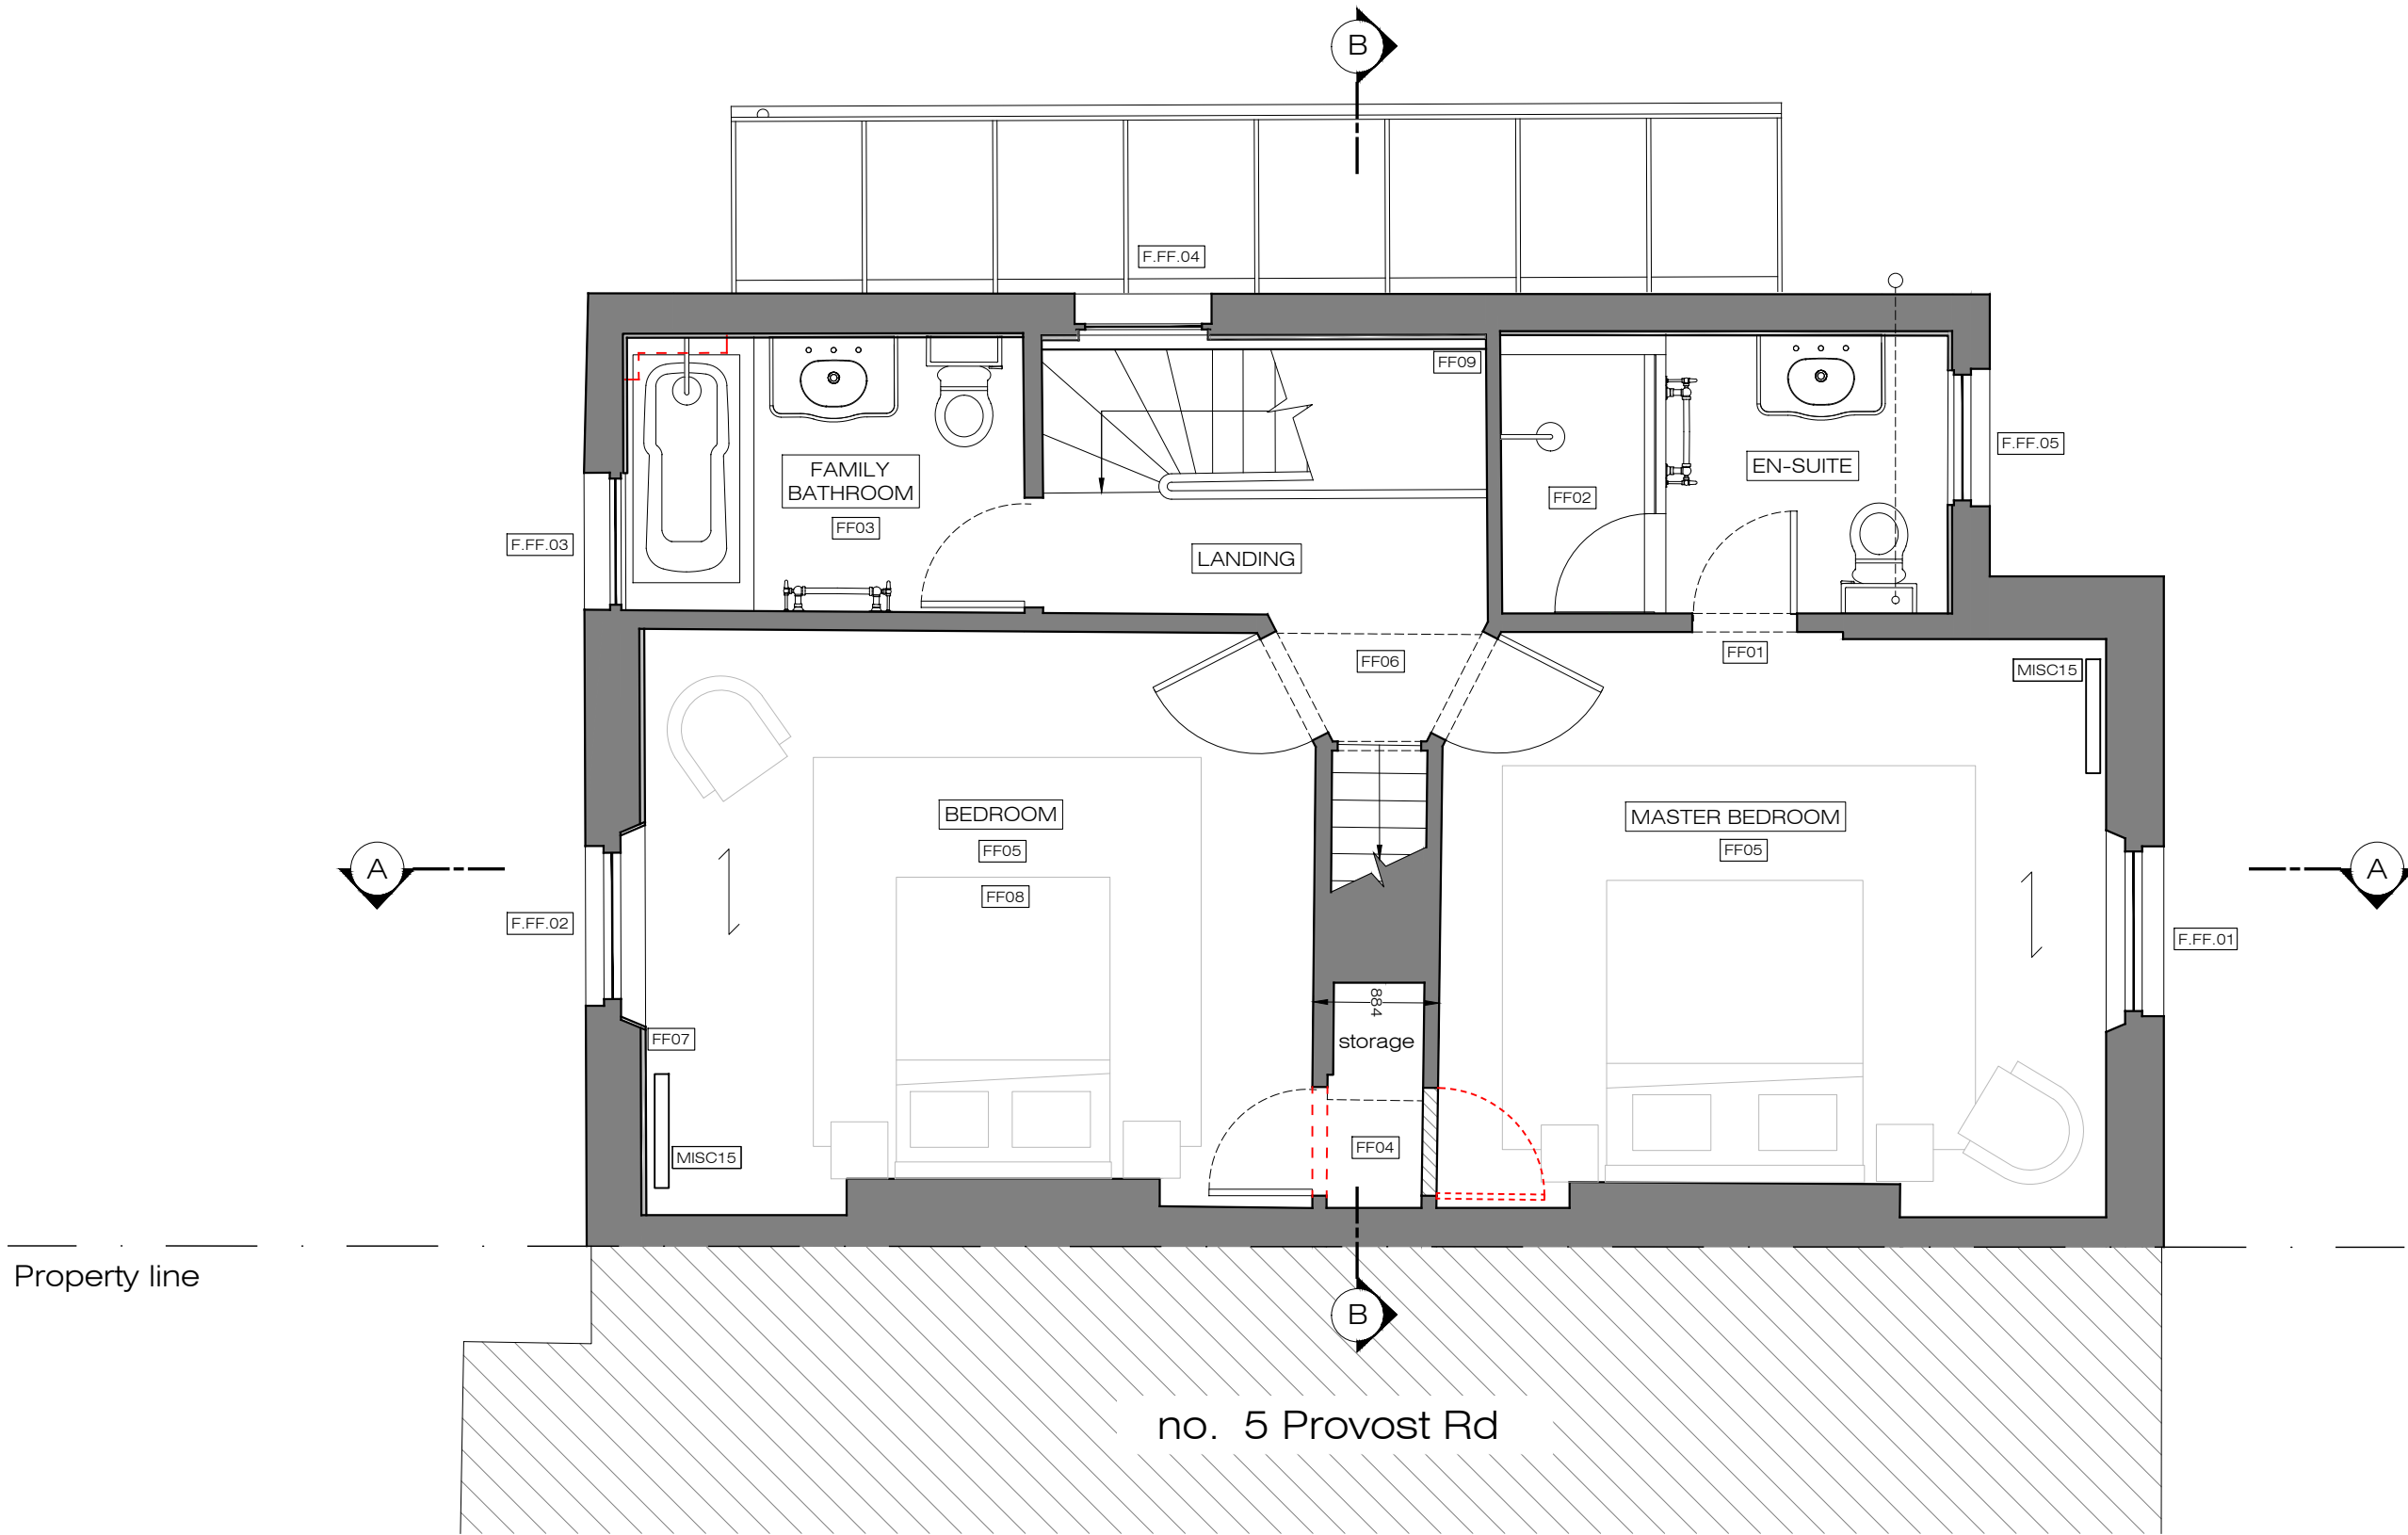

PLEASE NOTE:

1. All dimensions to be checked on site before fabrication,
2. Contractor to refer to engineers drawings before proceeding with works.
3. All drawings and designs are covered by design right (intellectual property), and may not be distributed, copied or issued without written permission by the Architect.
4. All design concepts are the sole property of the Architect and no adaptations, reproductions or copies may be made without written permission of the Architect.
5. These drawings are subject to any variation required or recommendation by any statutory authority, or for the better carrying out of the works.
6. Samples to be provided by contractor for XUL Architecture's approval.
7. All finishes to XUL Architecture's satisfaction.
8. All drawings to be approved by XUL Architecture prior to construction.


ADDITIONAL NOTE:

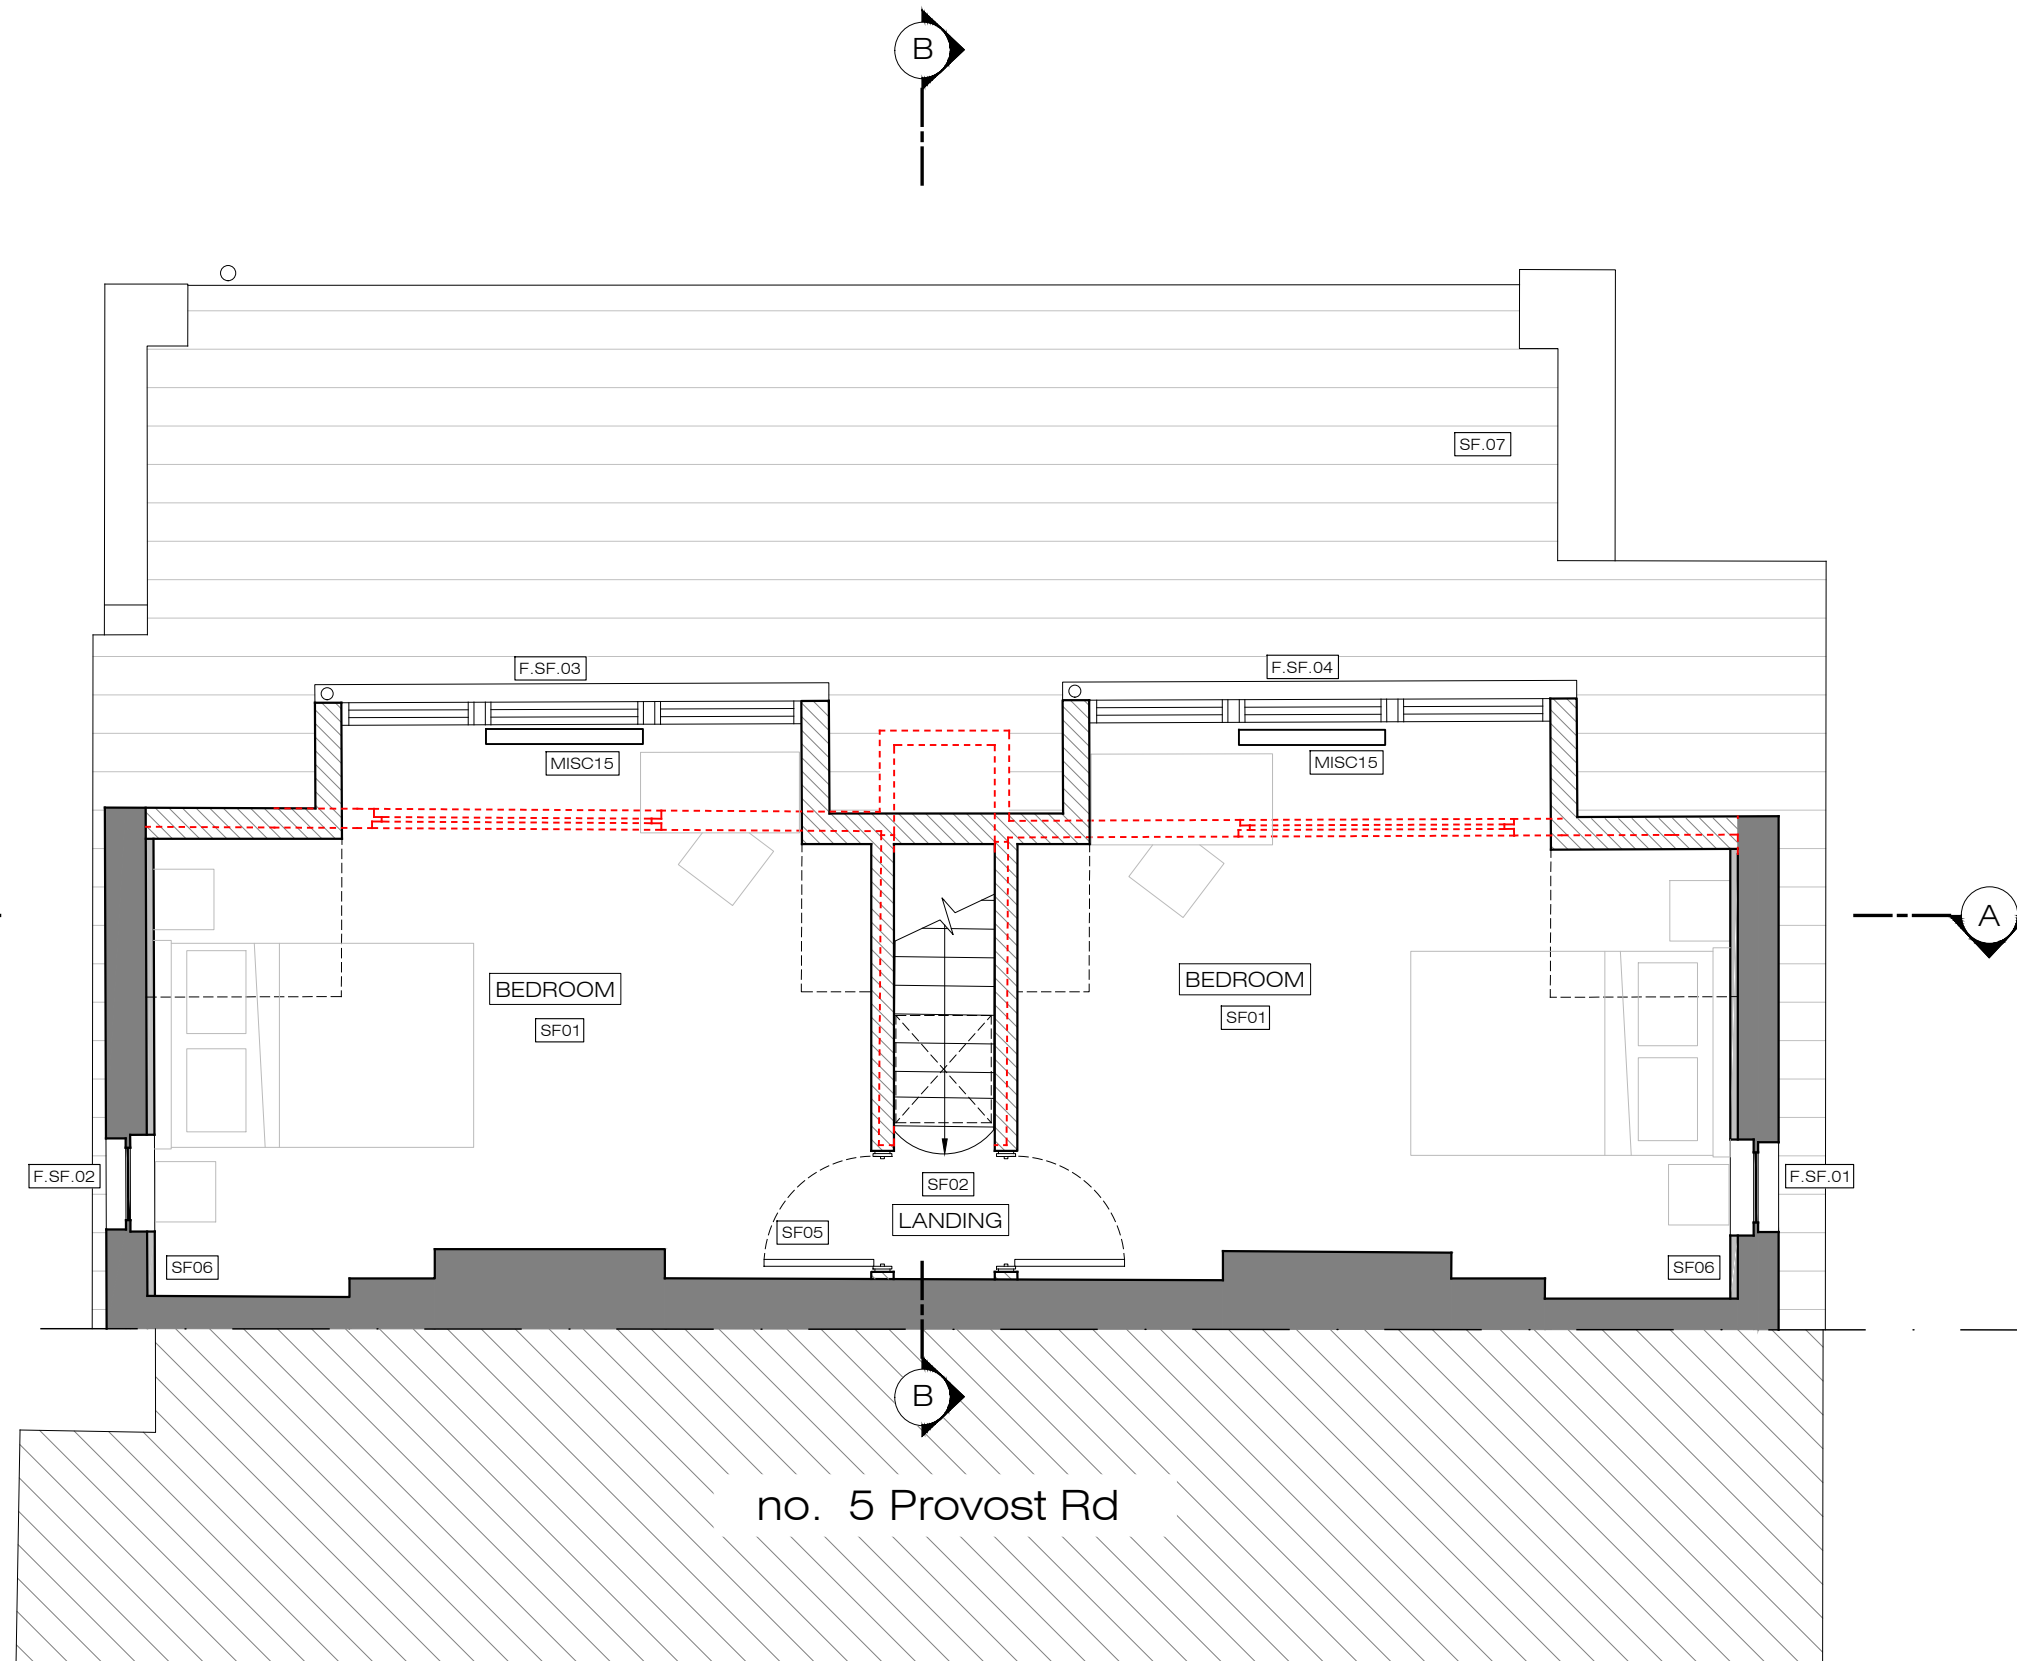

Property line

no. 5 Provost Rd

X PROPOSED
Loft Plan 1:50@A3

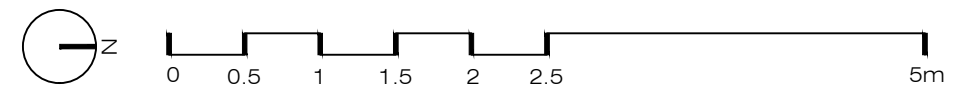

Issue key: Tender (T)
Information (I) Construction (C)
Planning (P) As Built (B)

Project Address
6 Provost Rd, NW3 4ST

PROPOSED
Second Floor Plan

Scale 1:50@A3 Dwg. No. PA-05

Rev. Date 01.08.22 Rev. P-03

Drawn CS Project Number 21155

Checked SS Issue For: PLANNING

PLEASE NOTE:

1. All dimensions to be checked on site before fabrication,
2. Contractor to refer to engineers drawings before proceeding with works.
3. All drawings and designs are covered by design right (intellectual property), and may not be distributed, copied or issued without written permission by the Architect.
4. All design concepts are the sole property of the Architect and no adaptations, reproductions or copies may be made without written permission of the Architect.
5. These drawings are subject to any variation required or recommendation by any statutory authority, or for the better carrying out of the works.
6. Samples to be provided by contractor for XUL Architecture's approval.
7. All finishes to XUL Architecture's satisfaction.
8. All drawings to be approved by XUL Architecture prior to construction.

ADDITIONAL NOTE:

Issue key: Tender (T)
Information (I) Construction (C)
Planning (P) As Built (B)

Project Address
6 Provost Rd, NW3 4ST

PROPOSED
Roof Plan

Scale
1:50@A3

Dwg. No.
PA-06

Rev. Date
01.08.22

Rev.
P-03

Drawn
CS

Project Number
21155

Checked
SS

Issue For:
PLANNING

B

A

A

F.RL.01

SF.07



Flat Roof

Flat Roof

Flat Roof

Flat Roof

Property line

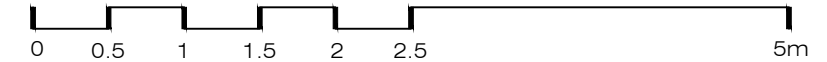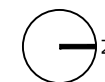

PLEASE NOTE:

1. All dimensions to be checked on site before fabrication,
2. Contractor to refer to engineers drawings before proceeding with works.
3. All drawings and designs are covered by design right (intellectual property), and may not be distributed, copied or issued without written permission by the Architect.
4. All design concepts are the sole property of the Architect and no adaptations, reproductions or copies may be made without written permission of the Architect.
5. These drawings are subject to any variation required or recommendation by any statutory authority, or for the better carrying out of the works.
6. Samples to be provided by contractor for XUL Architecture's approval.
7. All finishes to XUL Architecture's satisfaction.
8. All drawings to be approved by XUL Architecture prior to construction.

ADDITIONAL NOTE:

Issue key: Tender (T)
 Information (I) Construction (C)
 Planning (P) As Built (B)

Project Address
 6 Provost Rd, NW3 4ST

PROPOSED
 Front Elevation

Scale 1:50@A3 Dwg. No. PA-07


Rev. Date 01.08.22 Rev. P-04

Drawn CS Project Number 21155

Checked SS Issue For: PLANNING



Property line

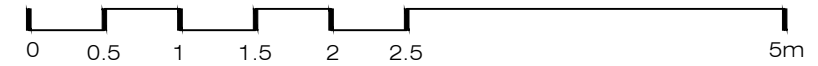

PLEASE NOTE:

1. All dimensions to be checked on site before fabrication,
2. Contractor to refer to engineers drawings before proceeding with works.
3. All drawings and designs are covered by design right (intellectual property), and may not be distributed, copied or issued without written permission by the Architect.
4. All design concepts are the sole property of the Architect and no adaptations, reproductions or copies may be made without written permission of the Architect.
5. These drawings are subject to any variation required or recommendation by any statutory authority, or for the better carrying out of the works.
6. Samples to be provided by contractor for XUL Architecture's approval.
7. All finishes to XUL Architecture's satisfaction.
8. All drawings to be approved by XUL Architecture prior to construction.

ADDITIONAL NOTE:

Issue key: Tender (T)
Information (I) Construction (C)
Planning (P) As Built (B)

Project Address
6 Provost Rd, NW3 4ST

PROPOSED
Rear Elevation

Scale
1:50@A3

Dwg. No.
PA-08

Rev. Date
01.08.22


Rev.
P-04

Drawn
CS

Project Number
21155

Checked
SS

Issue For:
PLANNING

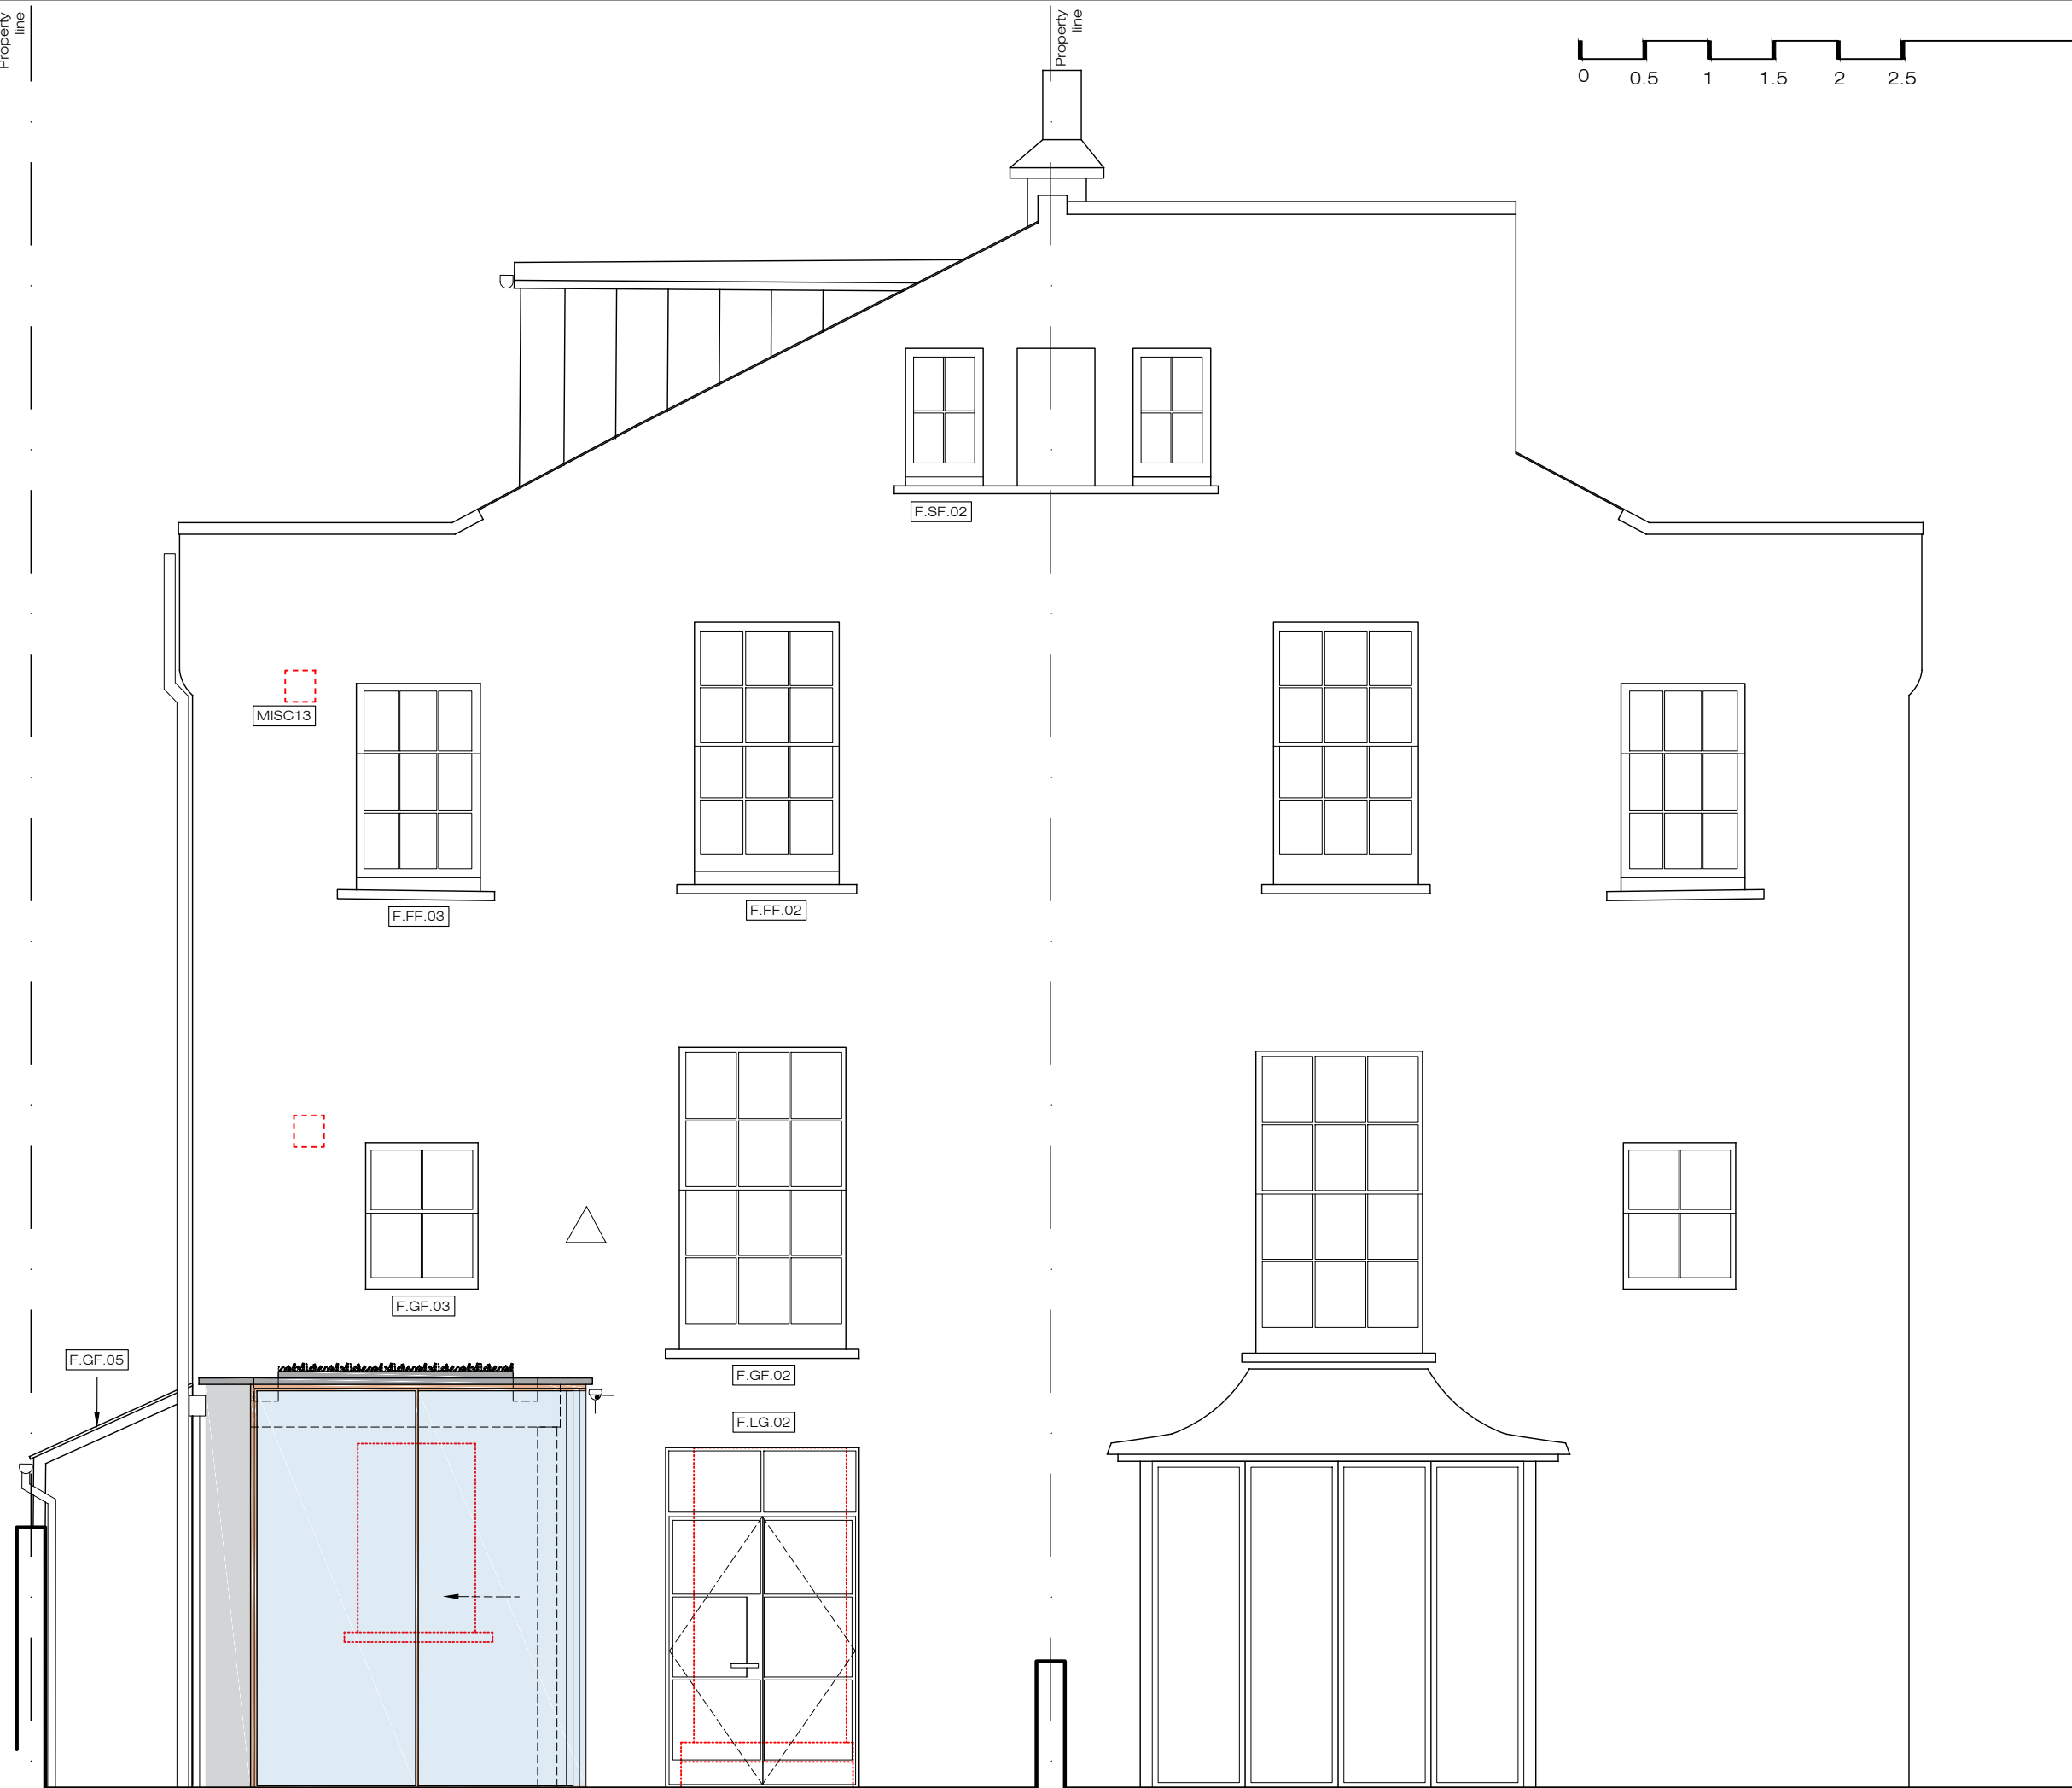

PLEASE NOTE:

1. All dimensions to be checked on site before fabrication,
2. Contractor to refer to engineers drawings before proceeding with works.
3. All drawings and designs are covered by design right (intellectual property), and may not be distributed, copied or issued without written permission by the Architect.
4. All design concepts are the sole property of the Architect and no adaptations, reproductions or copies may be made without written permission of the Architect.
5. These drawings are subject to any variation required or recommendation by any statutory authority, or for the better carrying out of the works.
6. Samples to be provided by contractor for XUL Architecture's approval.
7. All finishes to XUL Architecture's satisfaction.
8. All drawings to be approved by XUL Architecture prior to construction.

ADDITIONAL NOTE:

Issue key: Tender (T)
 Information (I) Construction (C)
 Planning (P) As Built (B)

Project Address
 6 Provost Rd, NW3 4ST


PROPOSED
 Side Elevation


Scale 1:50@A3 Dwg. No. PA-09

Rev. Date 01.08.22 Rev. P-06

Drawn CS Project Number 21155

Checked SS Issue For: PLANNING

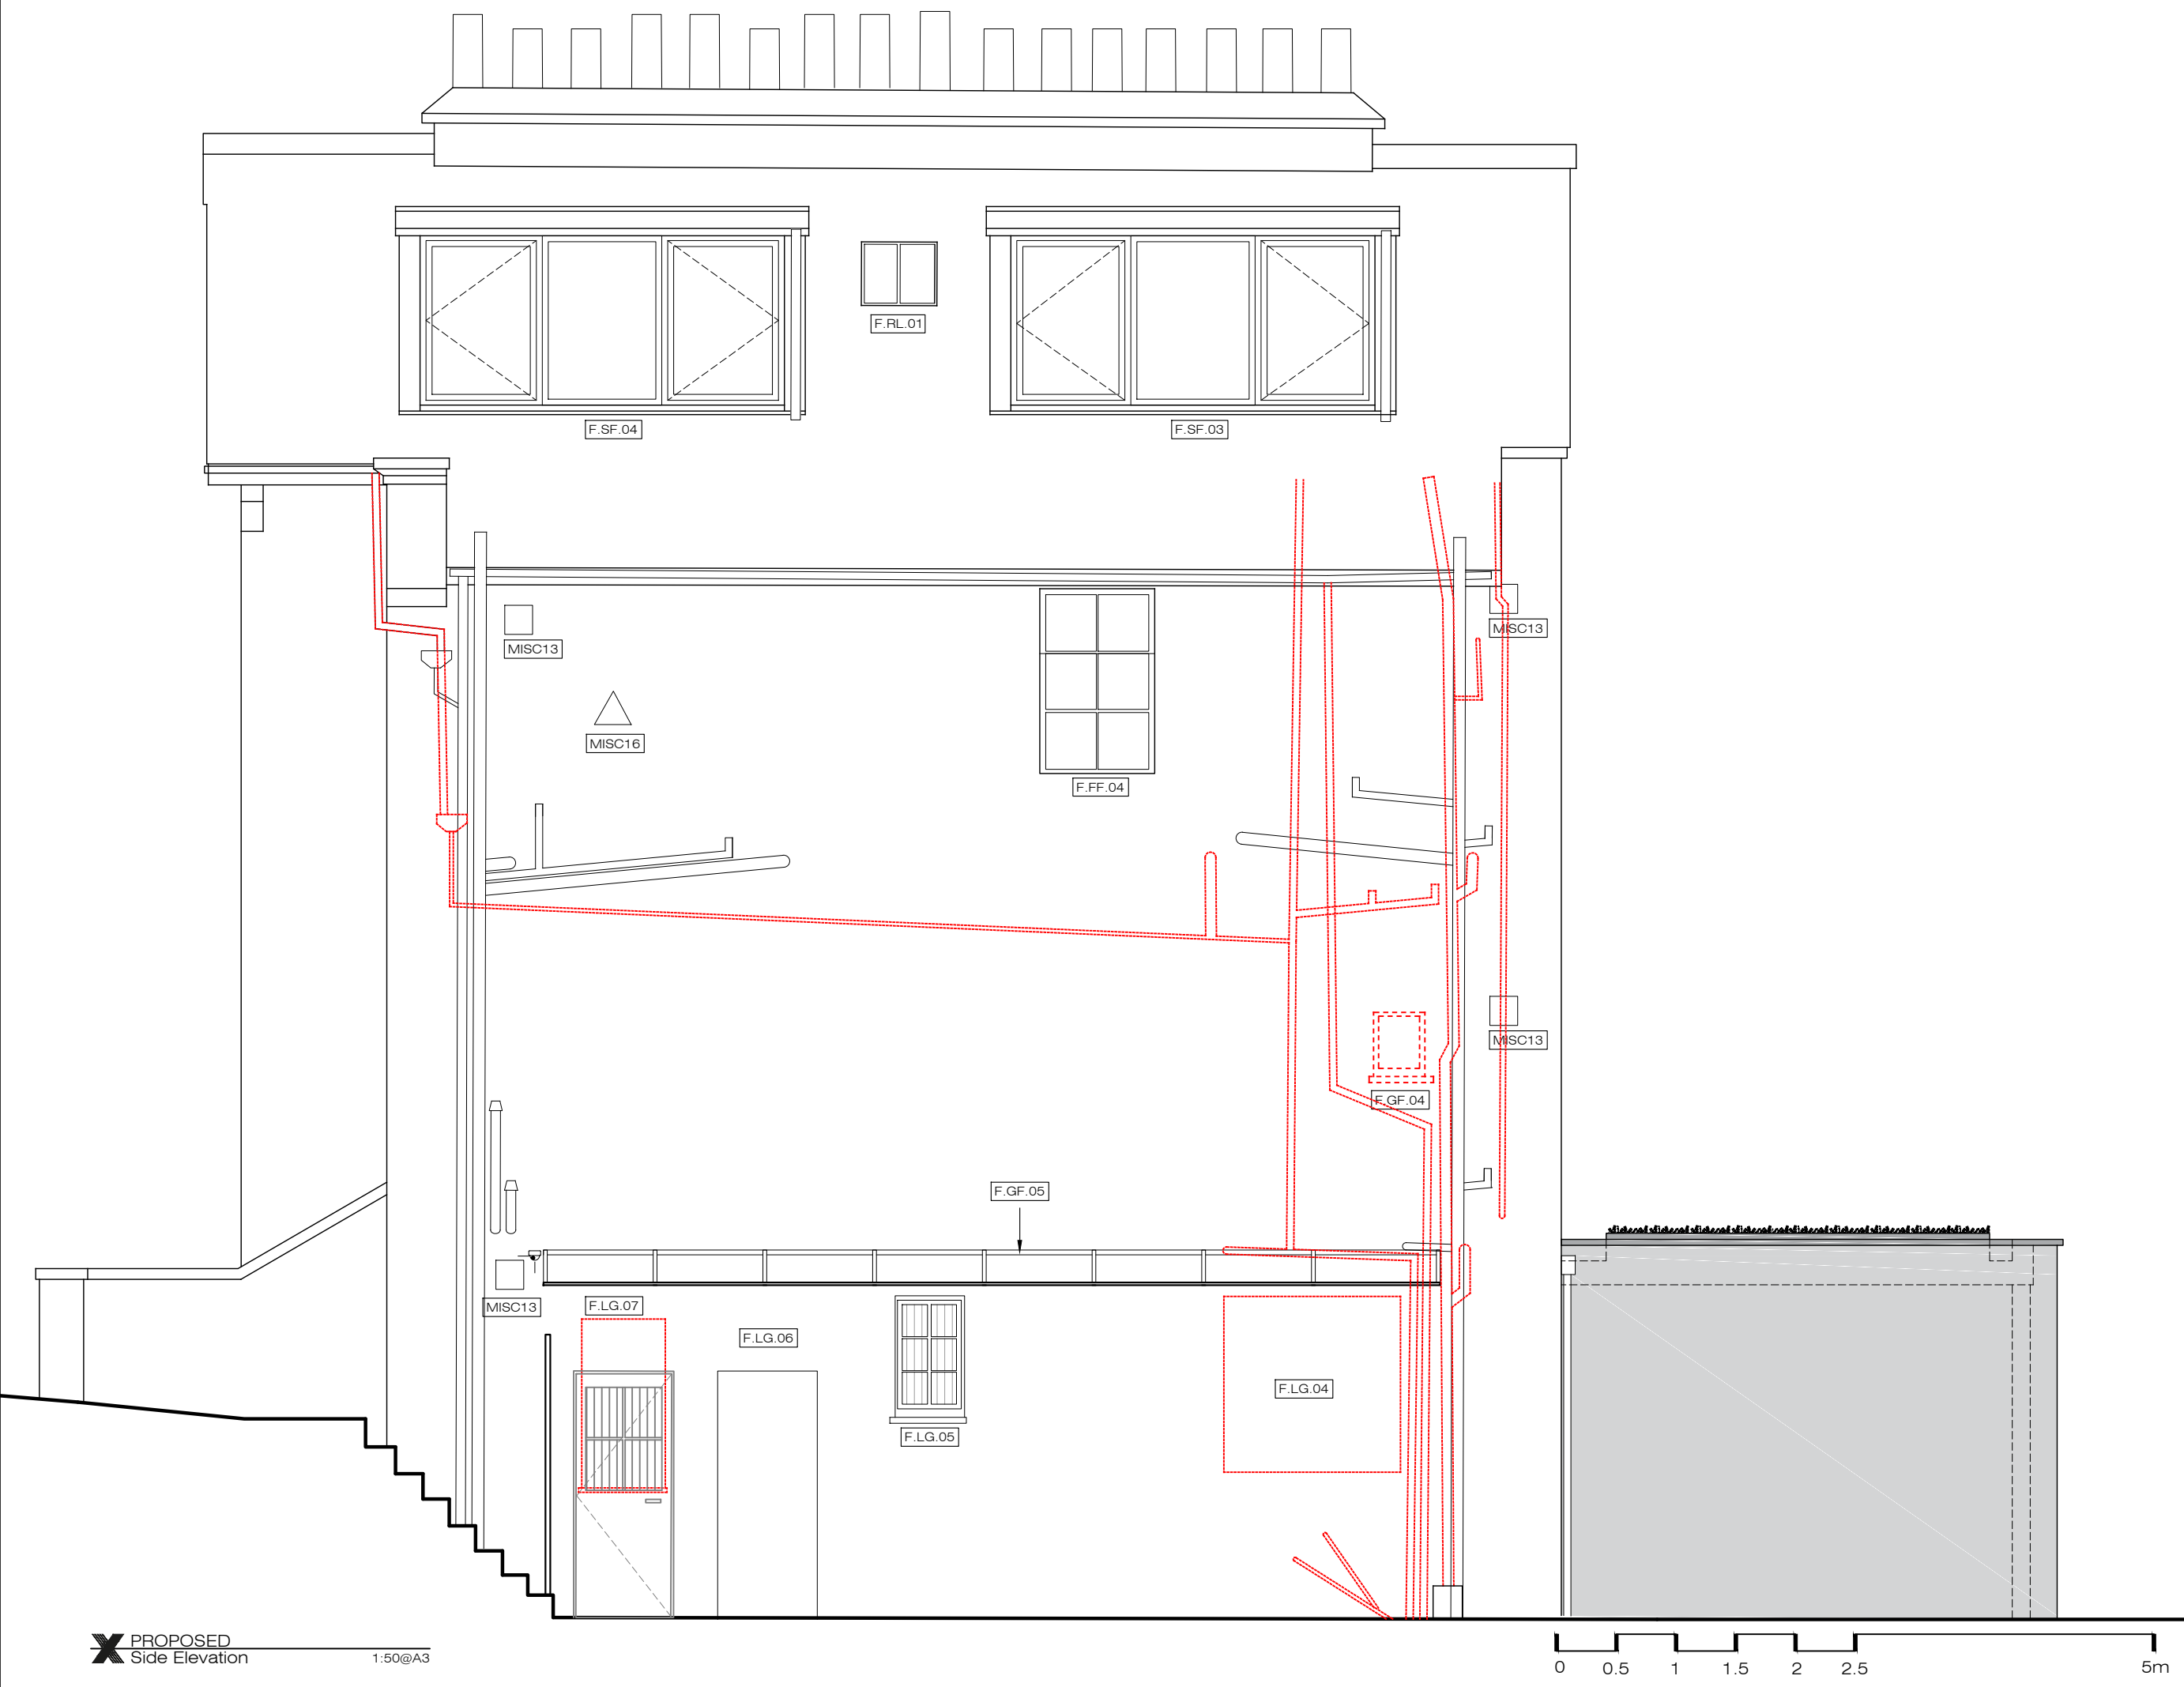

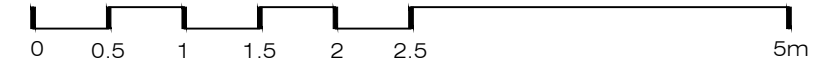

PLEASE NOTE:

1. All dimensions to be checked on site before fabrication,
2. Contractor to refer to engineers drawings before proceeding with works.
3. All drawings and designs are covered by design right (intellectual property), and may not be distributed, copied or issued without written permission by the Architect.
4. All design concepts are the sole property of the Architect and no adaptations, reproductions or copies may be made without written permission of the Architect.
5. These drawings are subject to any variation required or recommendation by any statutory authority, or for the better carrying out of the works.
6. Samples to be provided by contractor for XUL Architecture's approval.
7. All finishes to XUL Architecture's satisfaction.
8. All drawings to be approved by XUL Architecture prior to construction.

ADDITIONAL NOTE:

Issue key:	Tender (T)
Information (I)	Construction (C)
Planning (P)	As Built (B)

Project Address
6 Provost Rd, NW3 4ST


PROPOSED
Section AA

Scale 1:50@A3	Dwg. No. PA-10
------------------	-------------------

Rev. Date 24.05.22	Rev. P-03
-----------------------	--------------

Drawn CS	Project Number 21155
-------------	-------------------------

Checked SS	Issue For: PLANNING
---------------	------------------------

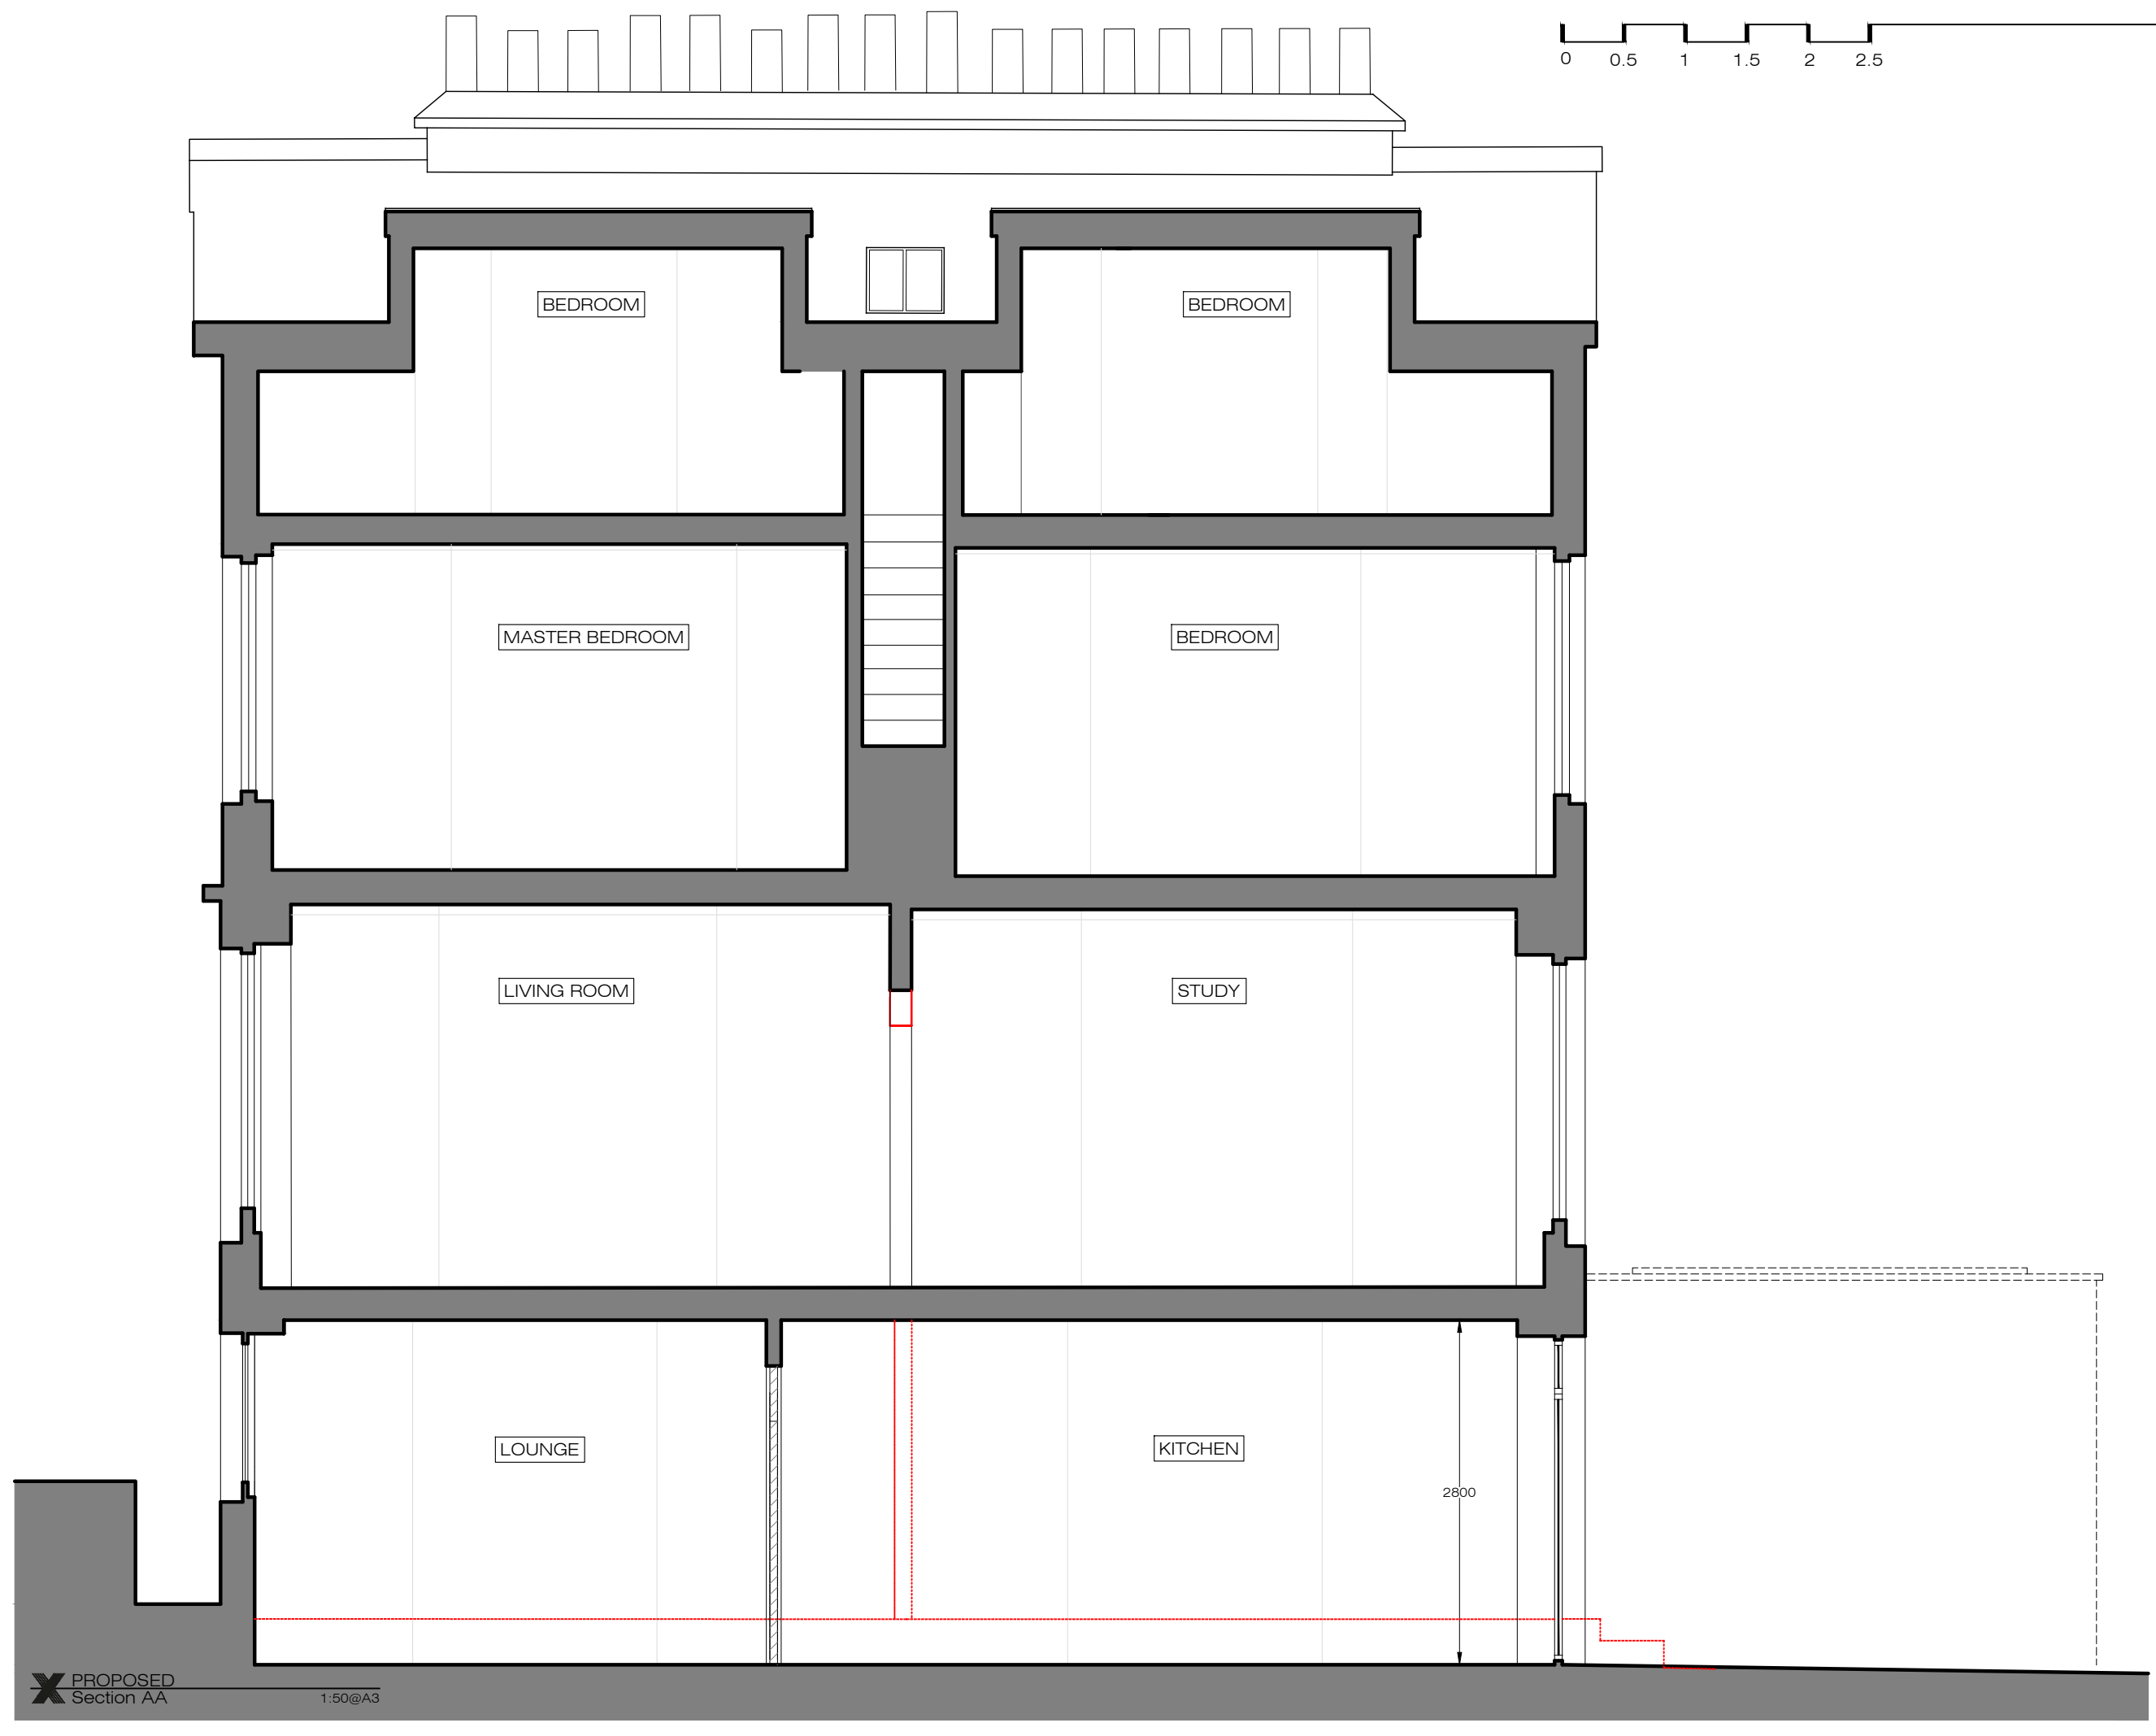

PLEASE NOTE:

1. All dimensions to be checked on site before fabrication,
2. Contractor to refer to engineers drawings before proceeding with works.
3. All drawings and designs are covered by design right (intellectual property), and may not be distributed, copied or issued without written permission by the Architect.
4. All design concepts are the sole property of the Architect and no adaptations, reproductions or copies may be made without written permission of the Architect.
5. These drawings are subject to any variation required or recommendation by any statutory authority, or for the better carrying out of the works.
6. Samples to be provided by contractor for XUL Architecture's approval.
7. All finishes to XUL Architecture's satisfaction.
8. All drawings to be approved by XUL Architecture prior to construction.

ADDITIONAL NOTE:

Issue key: Tender (T)
 Information (I) Construction (C)
 Planning (P) As Built (B)

Project Address
 6 Provost Rd, NW3 4ST


PROPOSED
 Section BB

Scale 1:50@A3 Dwg. No. PA-11

Rev. Date 27.07.22 Rev. P-02

Drawn AT Project Number 21155


Checked SS Issue For: PLANNING

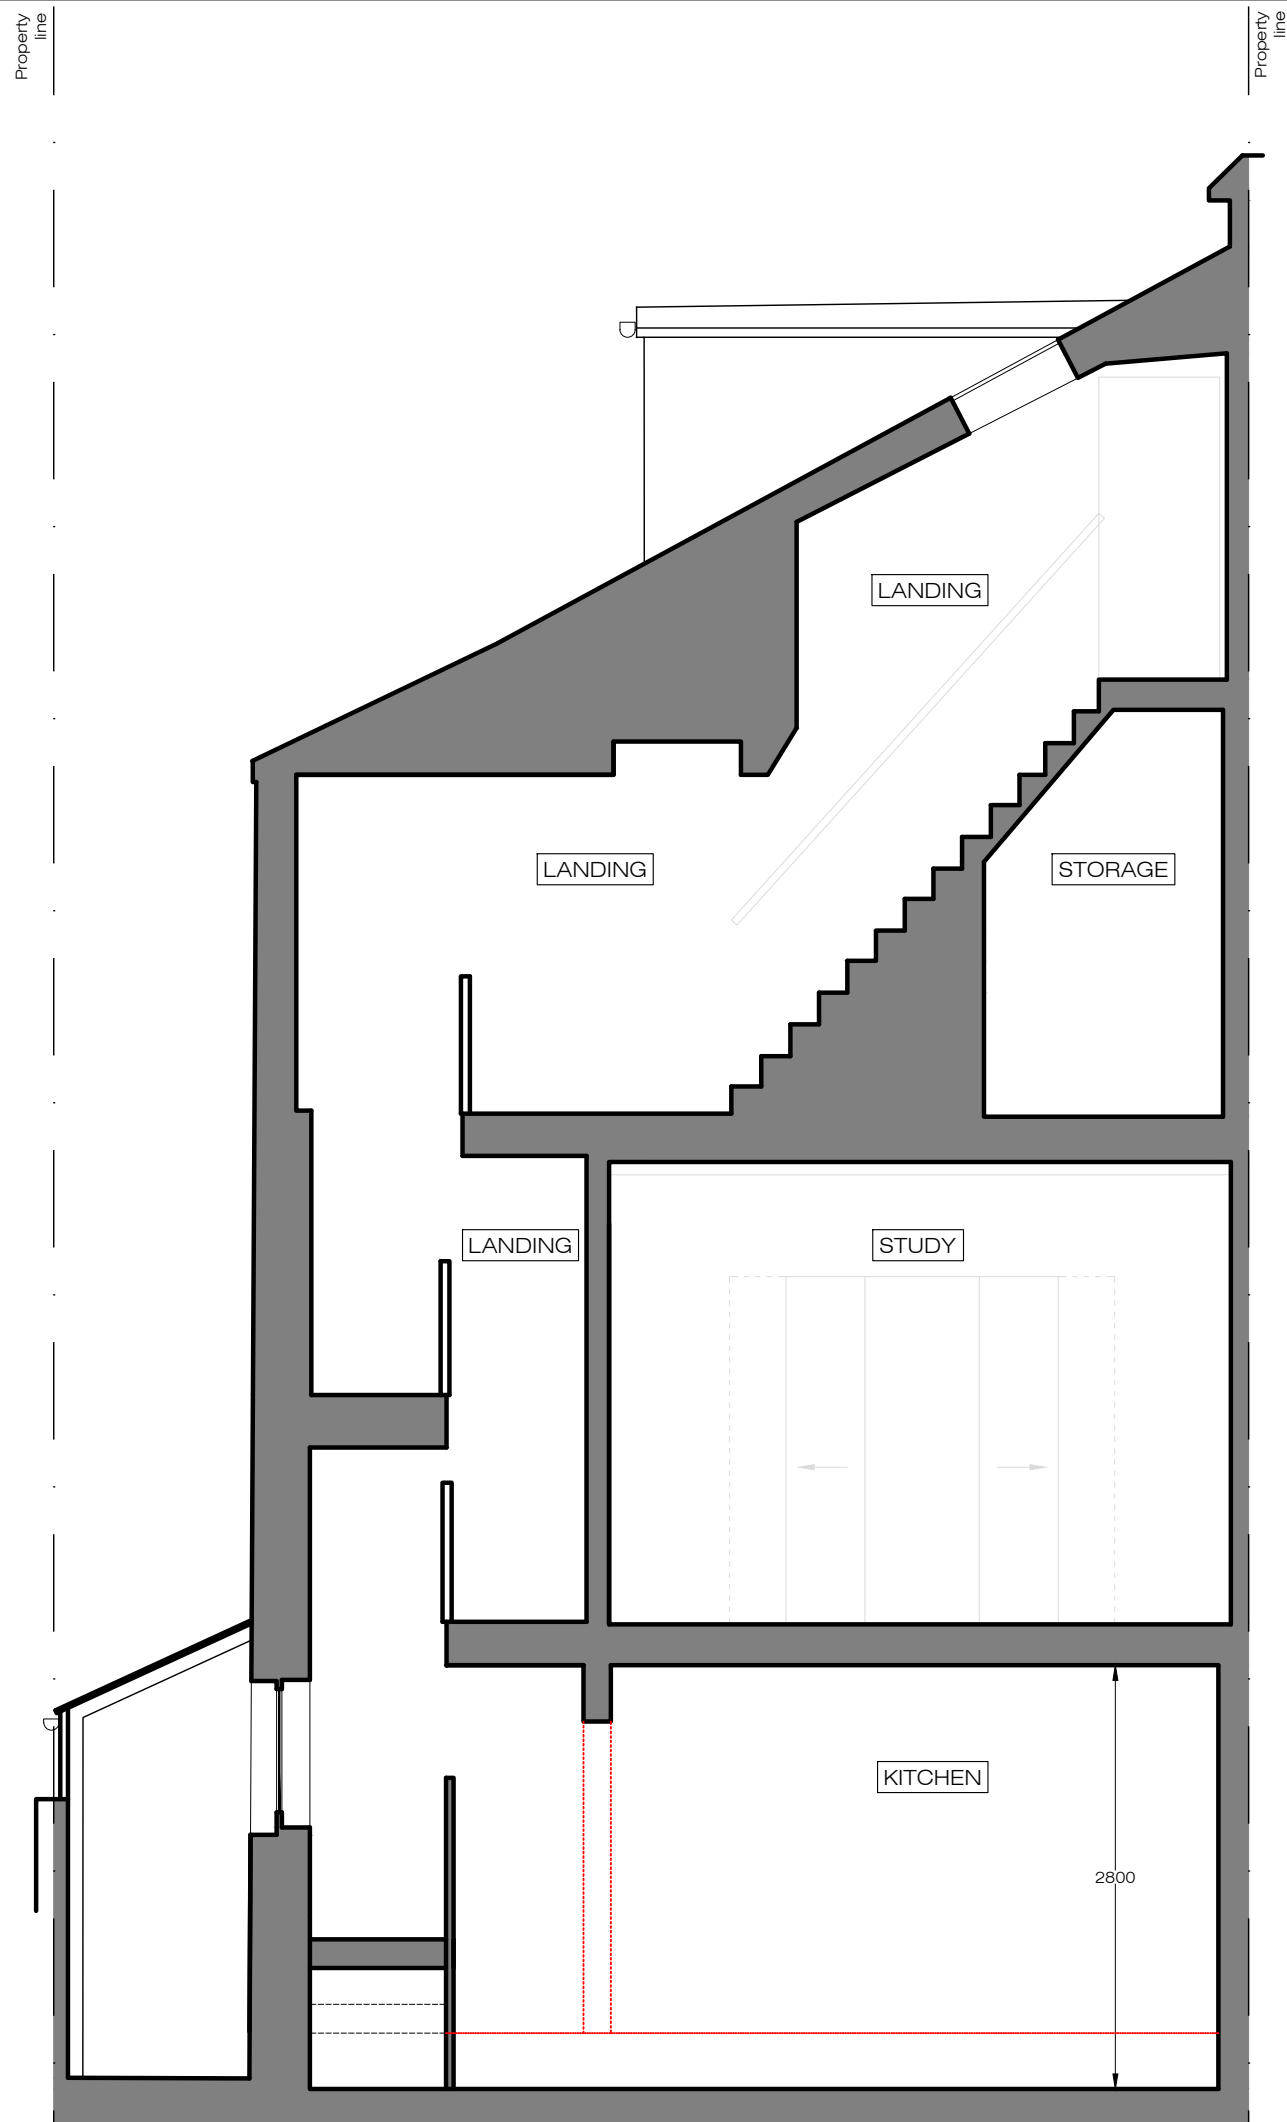

PLEASE NOTE:

1. All dimensions to be checked on site before fabrication,
2. Contractor to refer to engineers drawings before proceeding with works.
3. All drawings and designs are covered by design right (intellectual property), and may not be distributed, copied or issued without written permission by the Architect.
4. All design concepts are the sole property of the Architect and no adaptations, reproductions or copies may be made without written permission of the Architect.
5. These drawings are subject to any variation required or recommendation by any statutory authority, or for the better carrying out of the works.
6. Samples to be provided by contractor for XUL Architecture's approval.
7. All finishes to XUL Architecture's satisfaction.
8. All drawings to be approved by XUL Architecture prior to construction.

ADDITIONAL NOTE:

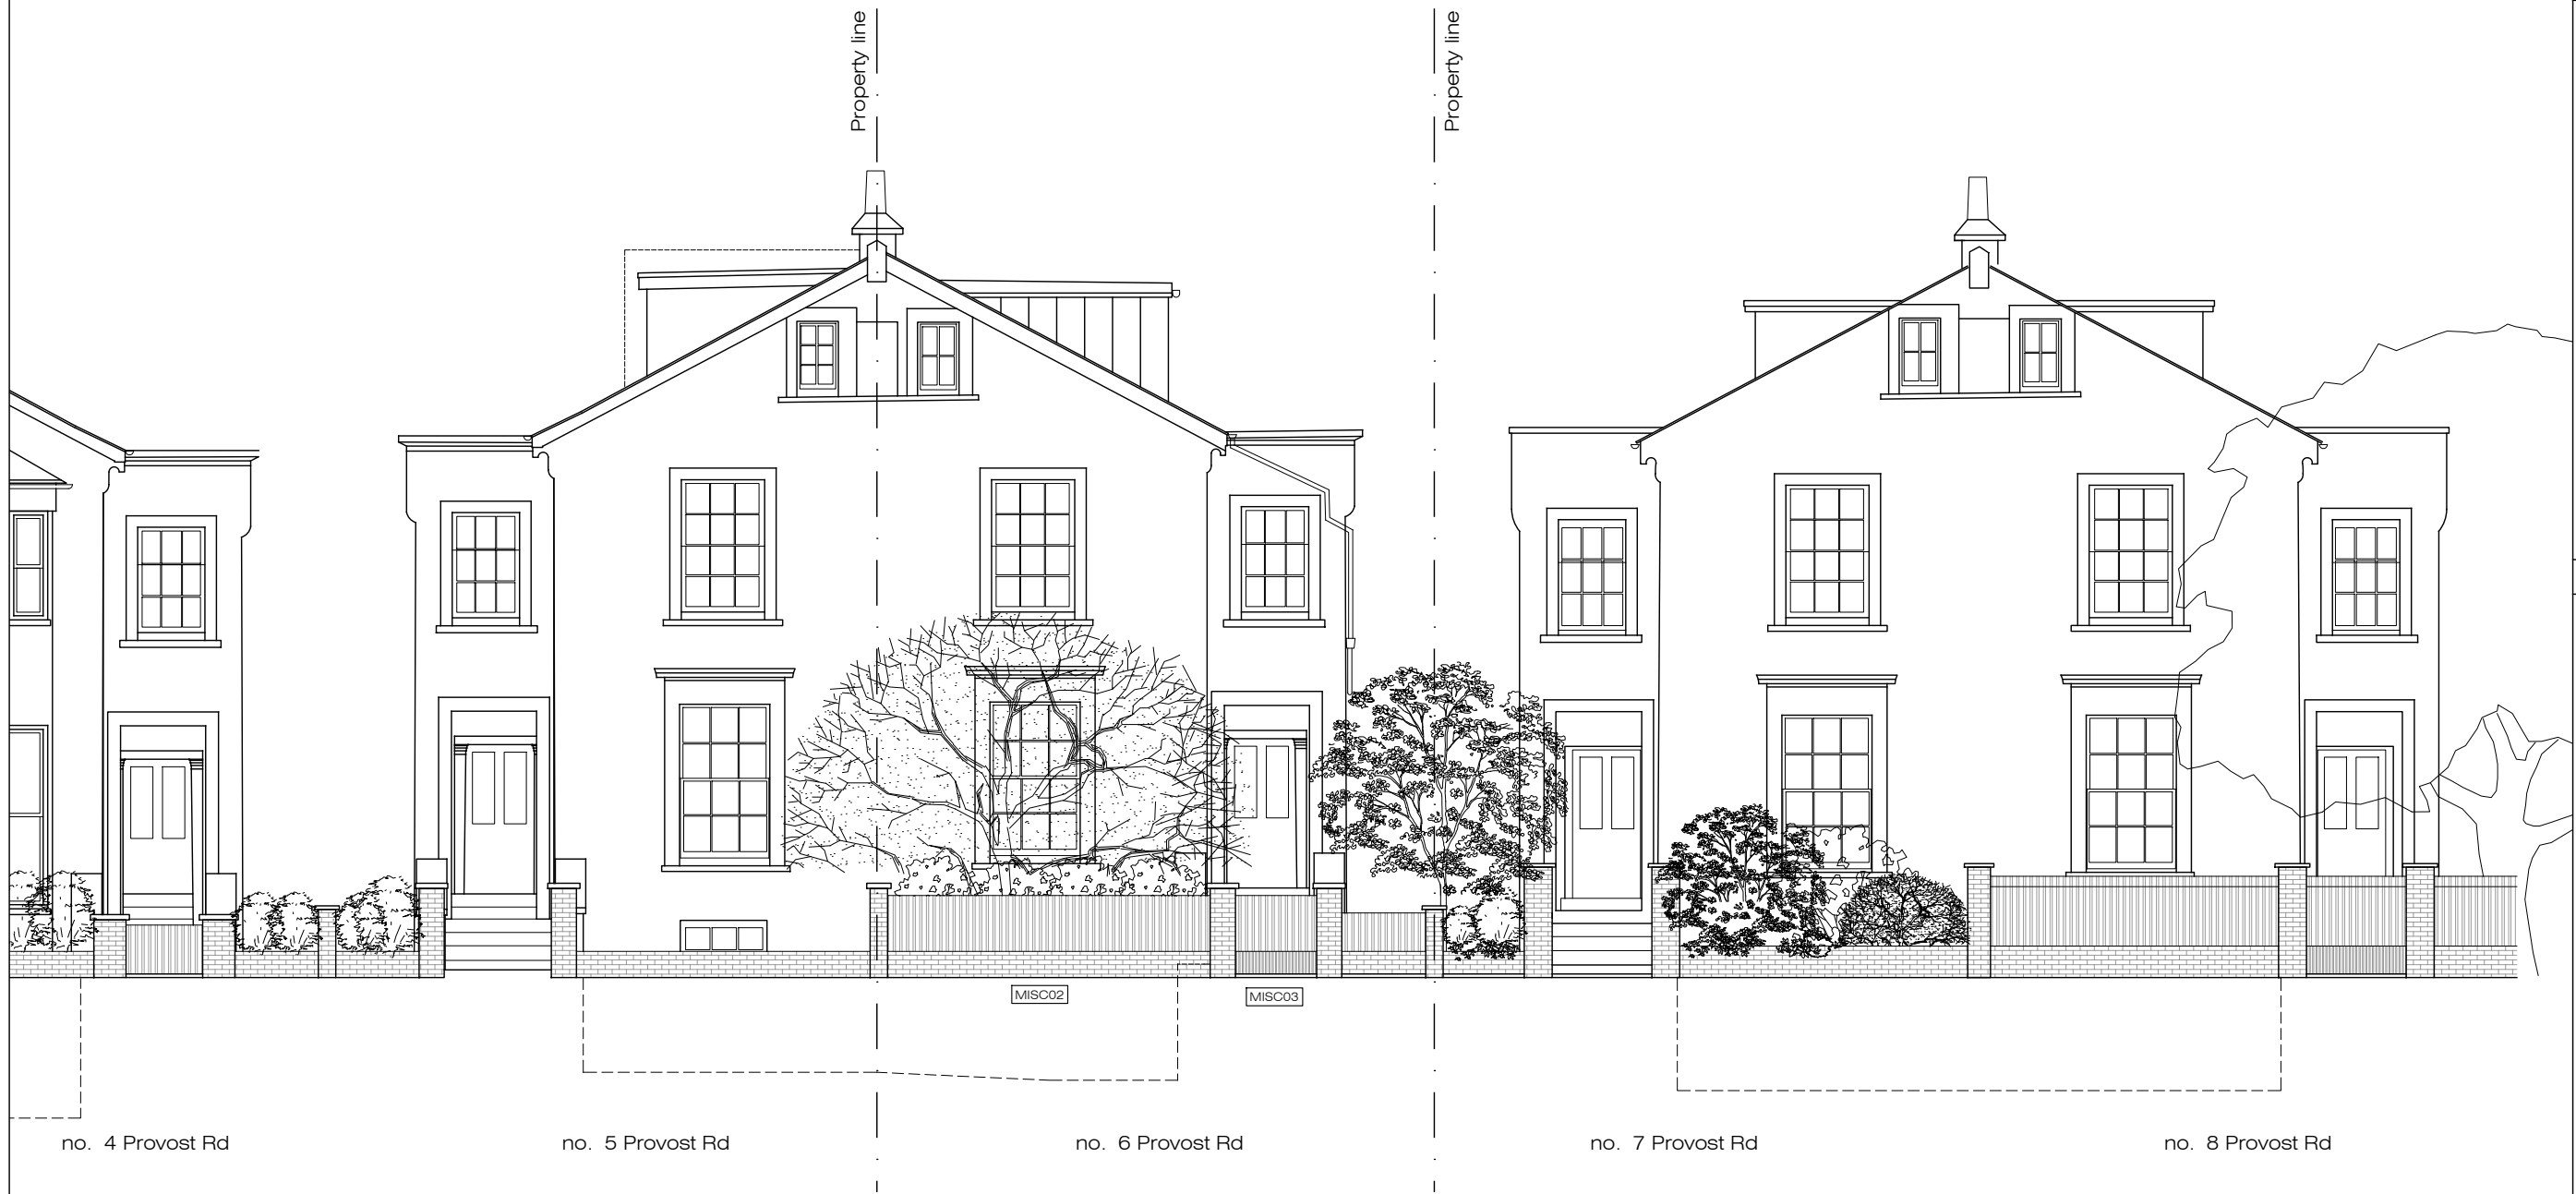

Issue key: Tender (T)
Information (I) Construction (C)
Planning (P) As Built (B)

Project Address
6 Provost Rd, NW3 4ST


PROPOSED
Street view

Scale 1:100@A3 Dwg. No. PA-12

Rev. Date 01.08.22 Rev. P-03

Drawn CS Project Number 21155


Checked SS Issue For: PLANNING

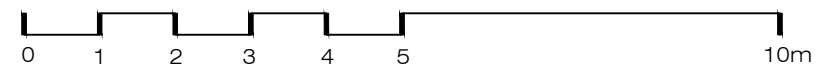


PLEASE NOTE:

1. All dimensions to be checked on site before fabrication,
2. Contractor to refer to engineers drawings before proceeding with works.
3. All drawings and designs are covered by design right (intellectual property), and may not be distributed, copied or issued without written permission by the Architect.
4. All design concepts are the sole property of the Architect and no adaptations, reproductions or copies may be made without written permission of the Architect.
5. These drawings are subject to any variation required or recommendation by any statutory authority, or for the better carrying out of the works.
6. Samples to be provided by contractor for XUL Architecture's approval.
7. All finishes to XUL Architecture's satisfaction.
8. All drawings to be approved by XUL Architecture prior to construction.


ADDITIONAL NOTE:

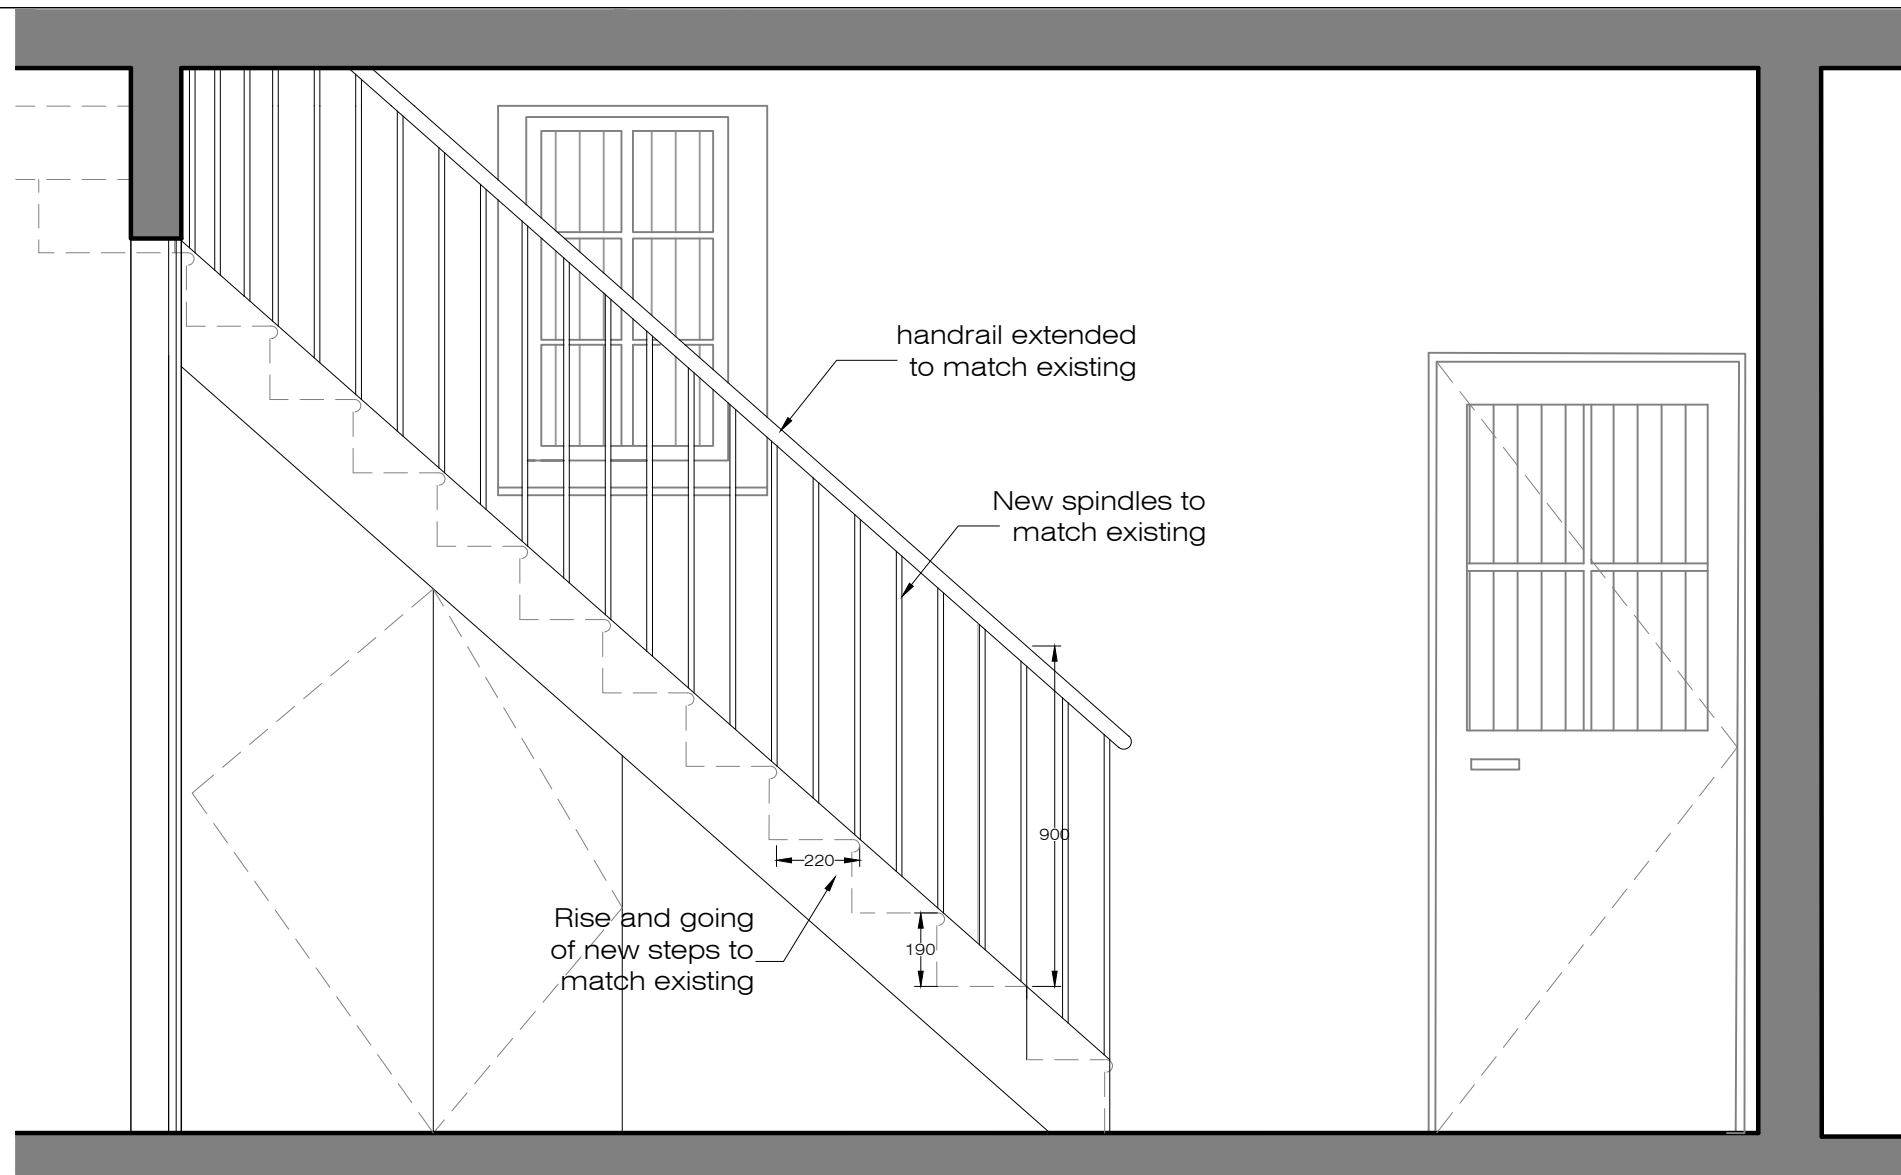

X PROPOSED
Staircase Detail - Section SS 1:20@A3

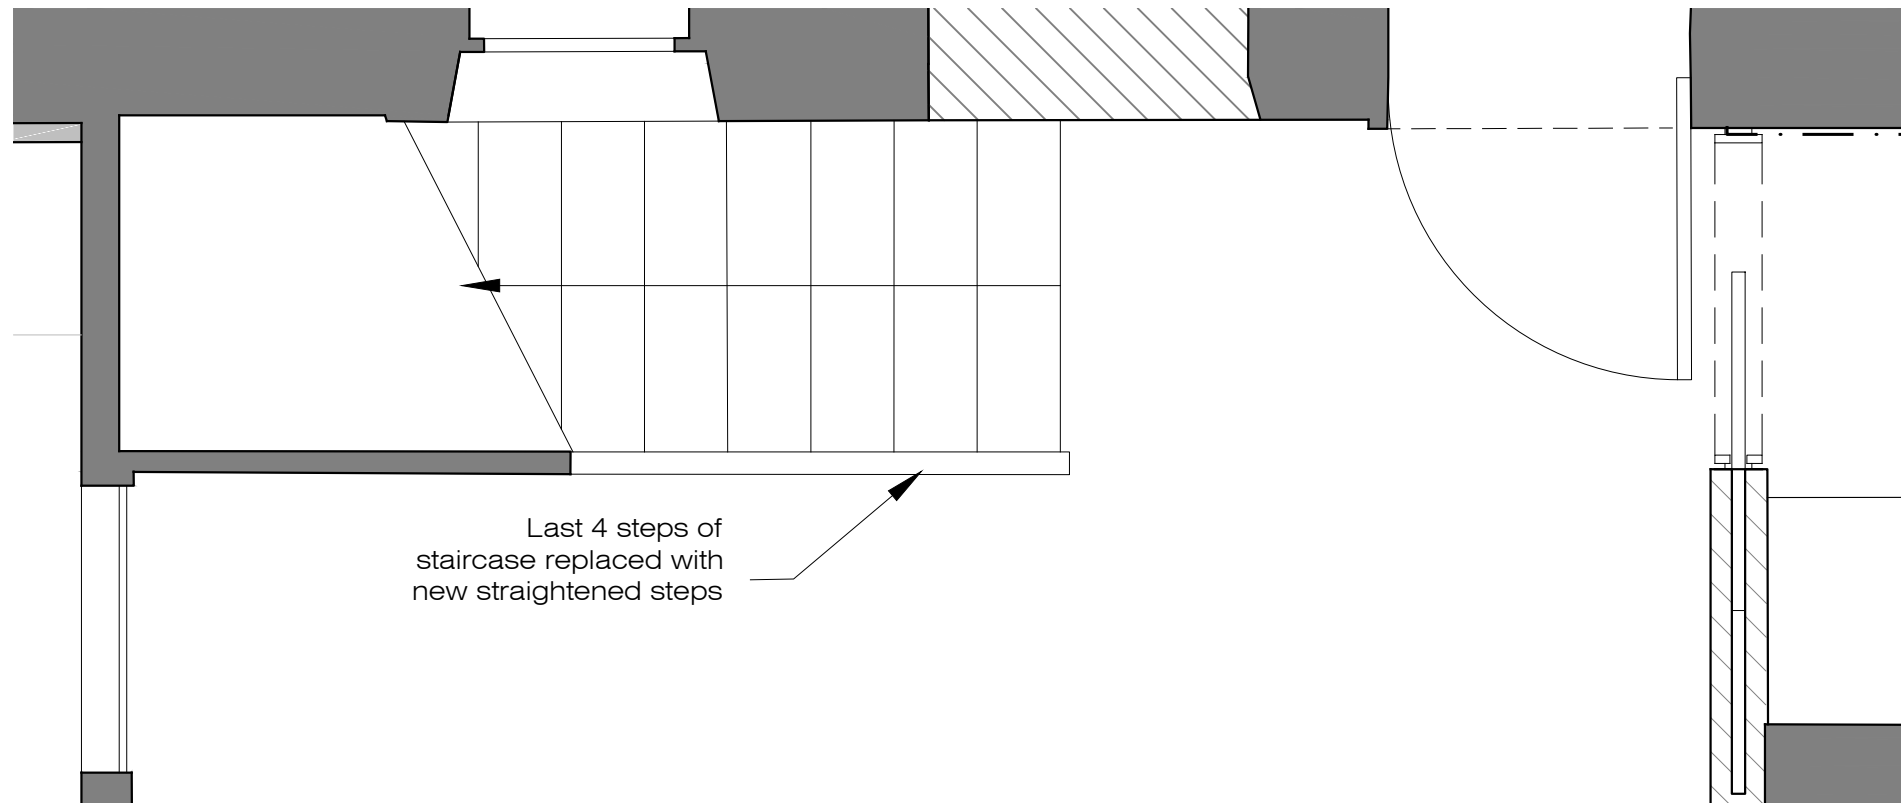

X PROPOSED
Staircase Detail - Plan 1:20@A3

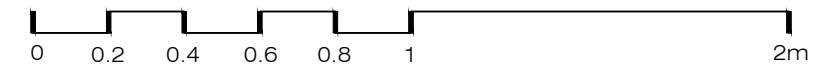

Issue key:	Tender (T)
Information (I)	Construction (C)
Planning (P)	As Built (B)

Project Address
6 Provost Rd, NW3 4ST

PROPOSED
LGF - Staircase Detail

Scale 1:20@A3	Dwg. No. DD-01
Rev. Date 25.07.22	Rev. P-03
Drawn CS	Project Number 21155
Checked SS	Issue For: PLANNING