



EXTERIOR CHAIRS

460w 525d 855h powder coated metal framed chair in **black** with teak shaped slates inset and fixed along rear elevation & underside, slat dim 410x60, refer to nuts & bolts SD-200-10.



SMALL EXTERIOR TABLES

500w 500d 730h moulded hinge to table top allowing table to fold away for ease of storage, stainless steel table support & base, rubber stoppers to feet, tops pastel grey laminate with black profile, ref. trespa exterior grade A.03.1.0 refer to nuts & bolts SD-200-12.



SEATING BALUSTRADES

1500 wide with logo applied by AEL Leisure ltd nuts & bolts SD-200-13. Free standing branded canvas balustrades on weighted aluminium posts.

FURNITURE : TOTAL COVERS = 30 No.
exterior furniture to be brought in to store outside trading hours




SMALL EXTERIOR TABLES - 15no.
refer to adjacent details.



EXTERIOR CHAIRS BLACK - 30no.
refer to adjacent details.



SEATING BALUSTRADES - 07no.
refer to adjacent details. 4no with logos applied where shown

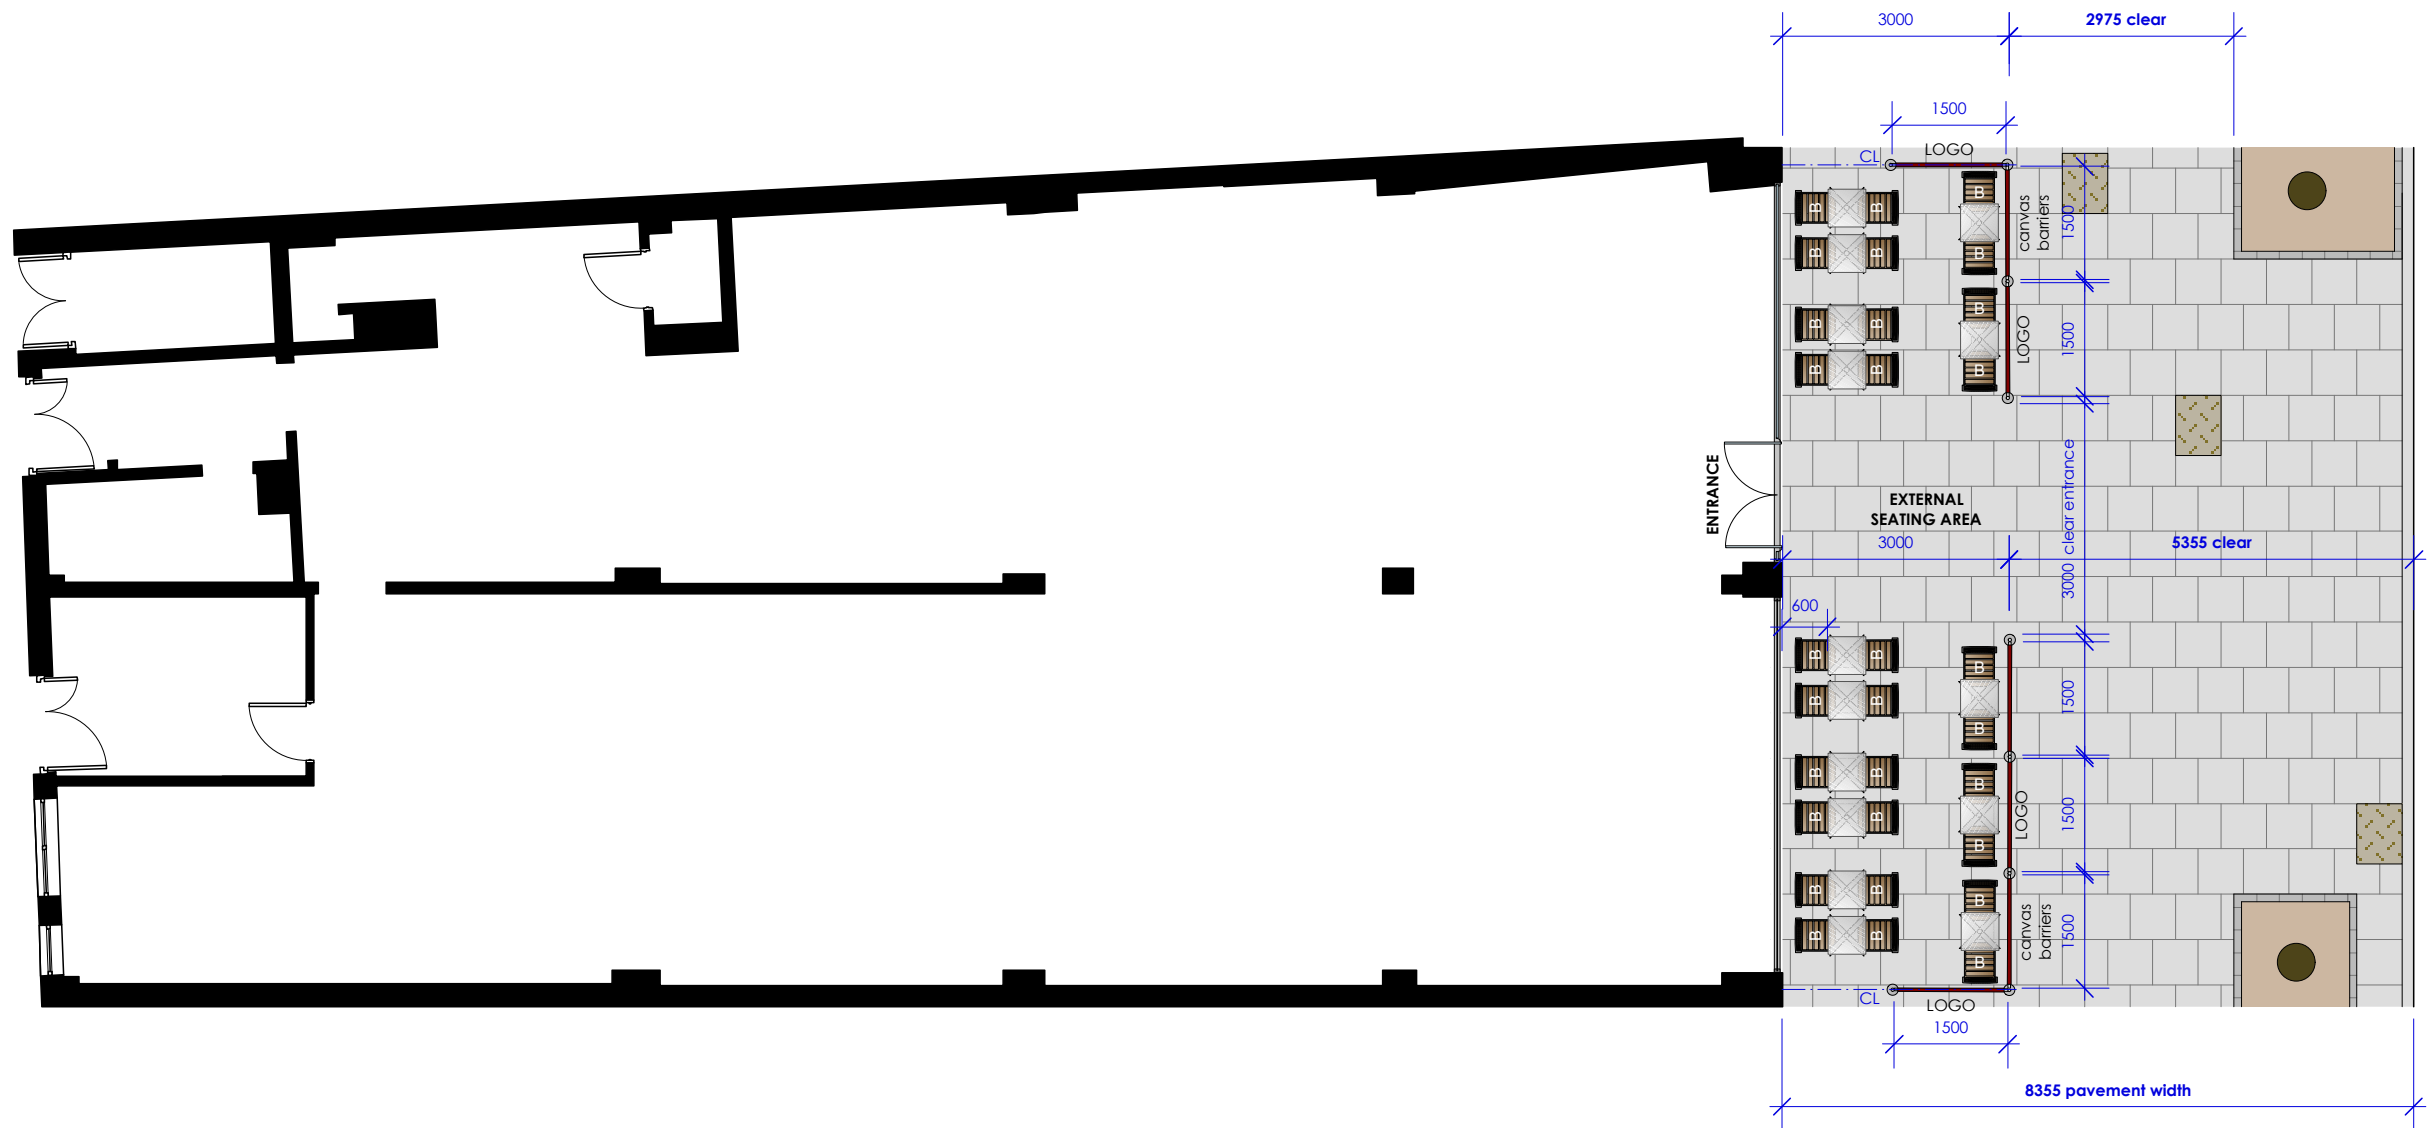

REVISIONS

PROJECT
★ **PRET A MANGER** ★

LOCATION
100 Tottenham Court Road
LONDON W1T 4TT

TITLE
proposed
external seating plan

DRAWING No.
TD12-PM15-02

REVISION DATE SCALE @ A3
AS BUILT 08.05.15 1:100

 **TANNERdesign**
2b/4b gosport street lynton hamshire SO41 9BE
TEL 01590 689609 EMAIL studio@tannerdesign.co.uk

please do not scale from this drawing
all dimensions to be confirmed on site by contractor
all elements to comply with statutory requirements
copyright TANNERdesign limited