
UCLH Roof Mounted Solar PV Systems Load Assessment Report

CNM Project: 11237
Author: John Matthews
Date: 24 May 2022
Revision: P1

1.0 Introduction

Clarke Nicholls Marcel (CNM) has been instructed by Mitie FM Ltd to complete a load assessment report the installation of multiple flat roof mounted solar PV systems at the University College London Hospital (UCLH) campus.

Initially PV systems were to be mounted on the Podium building roof, Tower building roof and EGA building roof.

However following a site visit CNM understand that it has been decided that the Tower roof will not be used due to concerns about wind loading.

Therefore this load assessment report only considers the Podium and EGA roof structure.

This report should be read in conjunction with all other Consultants drawings, reports and specifications.

2.0 Existing Structure

The Podium building was opened in 2005 at the same time as the Tower building.

The building structure is primarily constructed using a reinforced concrete frame with some structural steelwork on the southern elevation over the loading bays.

The main central roof slab is 250mm deep and laid to falls with a ridge line running east-west along the length of the building and hip lines into the corners.

This central roof area has no higher level structure or plant, which CNM understand is related to the original planning requirements.

The Podium roof level was therefore designed for a nominal roof imposed loading of 1.5kN/m² only.

FLOOR LOADINGS (kN/m ²)			
LOCATION		ROOF GENERALLY	
LIVE LOAD	1.5	FINISHES	2.2
		CEILING/ SERVICES	1.0
		PARTITIONS	
FIRE PERIOD	1.5 HRS. GENERALLY		

Figure 2.1 – Podium roof loading data from GA drawing

An 1850mm wide lower level roof runs around the northern, western, and southern perimeters of the building. The eastern perimeter abuts the steel framed Atrium sail roof structure.

The roof level general arrangement drawing 27/PGA/111 revision 17 and level 5 (roof) sections drawing 20/PGA/211 revision 11 are both contained in the appendix of this report.

The EGA building formed the second phase of the original UCLH PFI development and was opened in 2008.

The building structure is constructed using a reinforced concrete frame.

The main roof slab varies between a minimum of 300mm deep and a maximum of 400mm deep with the top level laid to falls, primarily from the central area and the corners to an internal valley line, and the soffit level constant.

This central roof area has an almost rectangular plantroom structure constructed using reinforced concrete to enclose the lift motor rooms and other plant above the central lift and stair core.

The main roof structure was future-proofed at design stage to allow for a roof garden.

The roof level was therefore designed for a nominal roof imposed loading of 5.0kN/m².

FLOOR LOADINGS (kN/m ²)			
LOCATION		ROOF	
LIVE LOAD	5.0	FINISHES	3.2
		CEILING/ SERVICES	1.0
		PARTITIONS	
FIRE PERIOD	1.5 HOURS		

Figure 2.2 – EGA roof loading data from GA drawing

The EGA roof level general arrangement drawing 27/EGA/110 revision 09 and level 5 (roof) sections drawing 20/EGA/210 revision 08 are both contained in the appendix of this report.

3.0 Roof Mounted Solar PV System

CNM have received the Mitie Energy UCLH PV Solar Assessment and Design report dated 07/12/21 by email from Ross Holt of Mitie on 4 May 2022.

This report indicates that it is proposed to use the Podium, Tower and EGA roofs for roof mounted solar PV systems, as shown on the following figure.

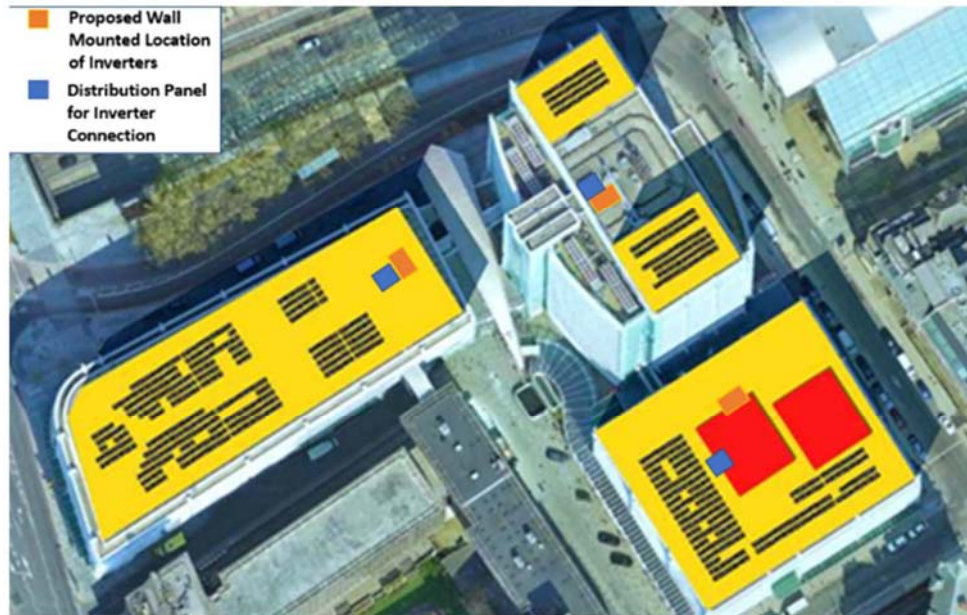


Figure 3.1 – Proposed solar PV system layout taken from Mitie report.

CNM received a further email from Ross Holt on Mitie on 19 May 2022 stating the following:

I met with Photon on Tuesday to survey the roofs. The plan is to not use the Tower now due to the potentially high winds, and so spread everything over Podium and EGA.

Therefore this report is only assessing the Podium and EGA roof loading capacity.

3.1 Solar PV System Loading

Section 15 of the Mitie Energy report states that a structural loading assessment is required, per the following figure.

15 Structural Assessment

A structural assessment will be required to ensure the building can accommodate additional roof loadings. Roof loadings vary depending on systems size on each building.

For the Tower, given the height of the building, it is recommended that consoles are installed and directly affixed to the building. This will require a specific design and specification by the manufacturer, Van der Valk delivered free of charge.

Action: Van der Valk will need details of the roof structure to facilitate this design.

For the podium and the EGA roofs the system will be self-ballasted and has been calculated with loadings of 0.27 kN/m². The report for these lower roofs accompanies this document.

Figure 3.2 – Section 15 of the Mitie Energy report.

The Tower loading information in the text is now no longer required as this area is not being used.

The text states that for the Podium and EGA roofs the system will be self-ballasted and has been calculated with loadings of 0.27kN/m².

4.0 Load Assessment

The following sections summarise the load assessment for each of the building roofs.

4.1 Podium Block Roof Load Assessment

The existing roof slab was designed for an imposed load capacity of 1.5kN/m^2 and the proposed solar PV systems loading requirement is 0.27kN/m^2 .

Therefore the existing roof slab can support the proposed solar PV system whilst also still retaining a sufficient redundancy for snow and loading.

4.2 EGA Block Roof Load Assessment

The existing roof slab was future-proof designed for an imposed load capacity of 5.0kN/m^2 to allow for an accessible roof garden space for Trust staff use.

The proposed solar PV systems loading requirement is 0.27kN/m^2 .


Therefore the existing roof slab can support the proposed solar PV system whilst also still retaining a significant redundancy for snow loading.

5.0 Appendix A

5.1 Record Structural Drawings

The following CNM record structural general arrangement drawings are contained in this appendix.













- 8141/27/PGA/111 revision 17 Existing Podium Block Roof Plan
- 8141/20/PGA/211 revision 11 Existing Podium Block Level 5 (Roof) Sections
- 8141/27/EGA/110 revision 09 Existing EGA Block Roof Plan
- 8141/20/EGA/210 revision 08 Existing EGA Block Level 5 (Roof) Sections

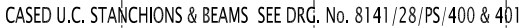

NOTE
1. FOR BUILDERS WORK OVER PLANTROOMS
SEE DOC. REF. No. 01219/10.003/SCH001.
FINAL BUILDERS WORK REQUIREMENTS
TO BE AGREED WITH STRUCTURAL ENGINEER.

2. FOR ROOF DRAINAGE HOLES SEE DOC. REF
No. 01219/10.003/SCH001.

Scale 1:100 @ A0		
Date 10.09.99	Drawn TRD	Checked JS
Job Number 8141	Drawing Number 27/PGA/111	Revision 17

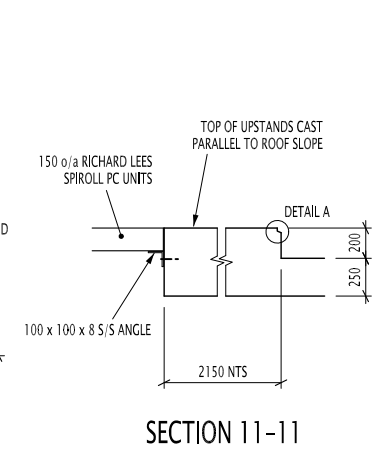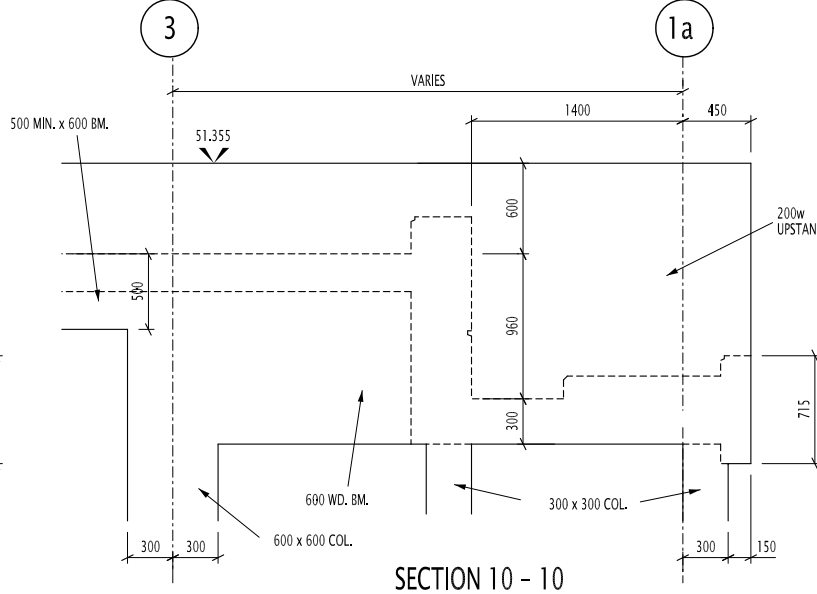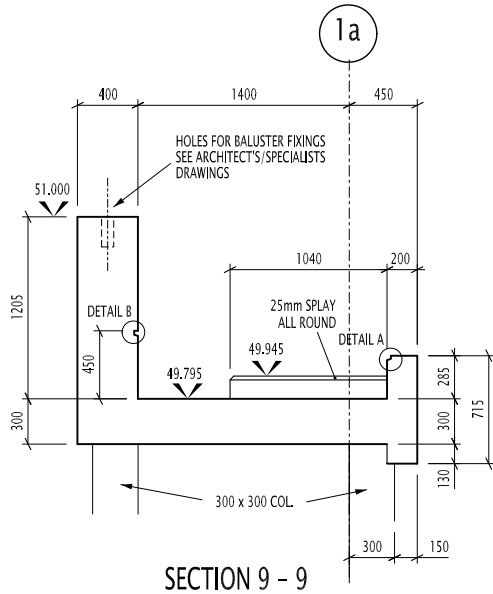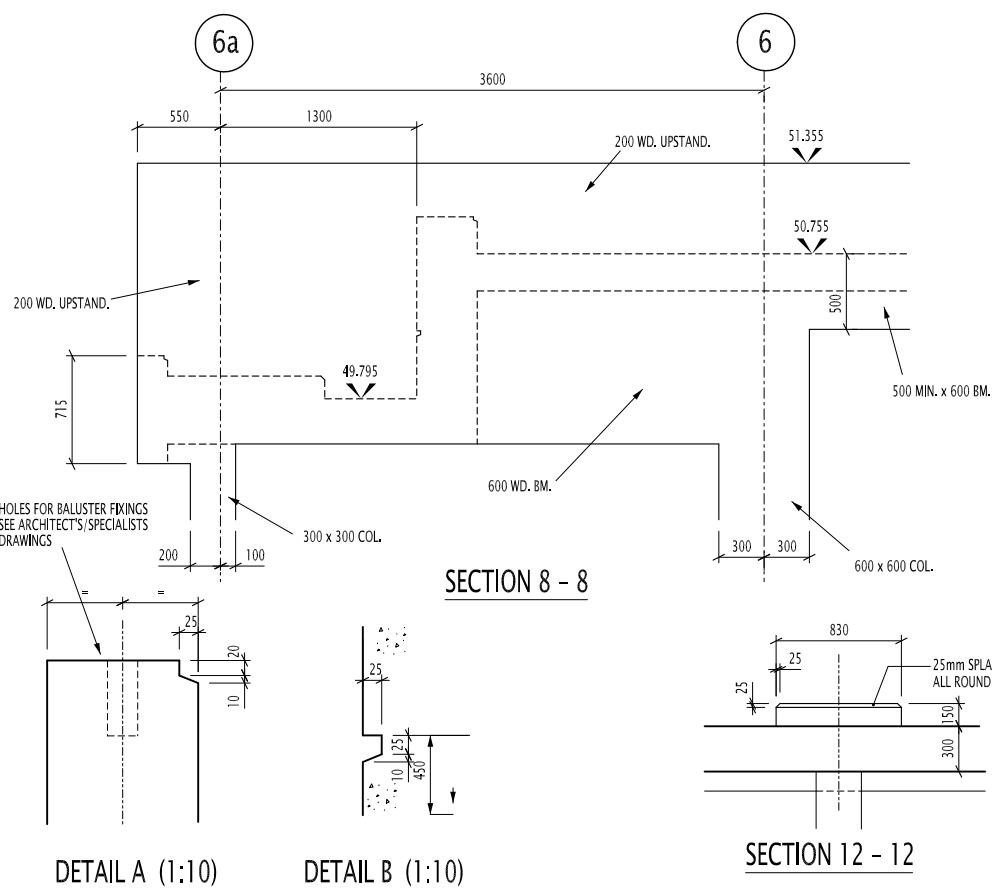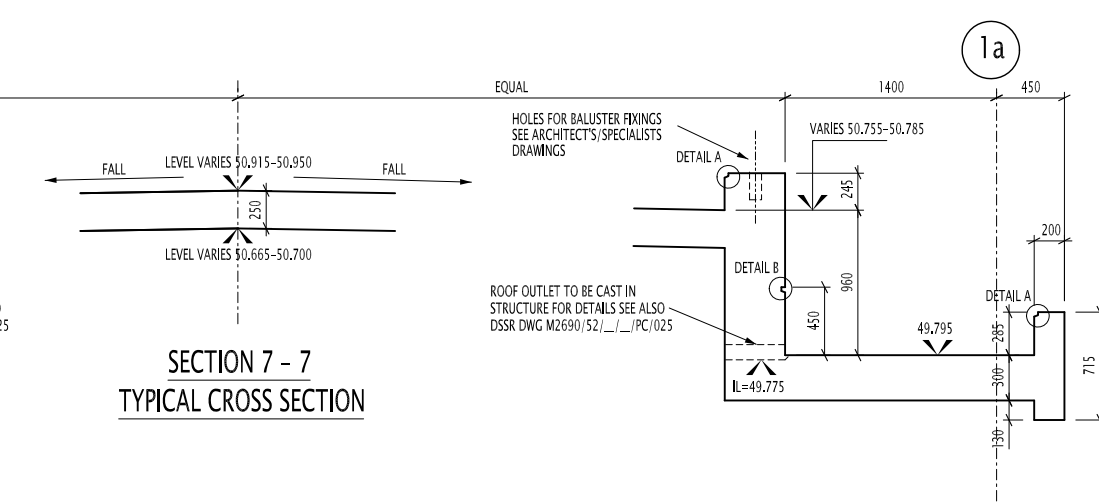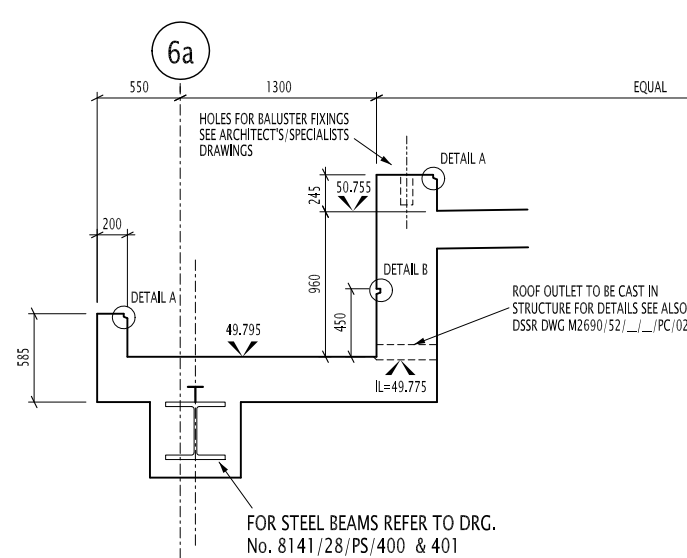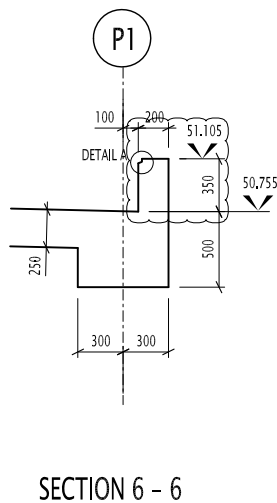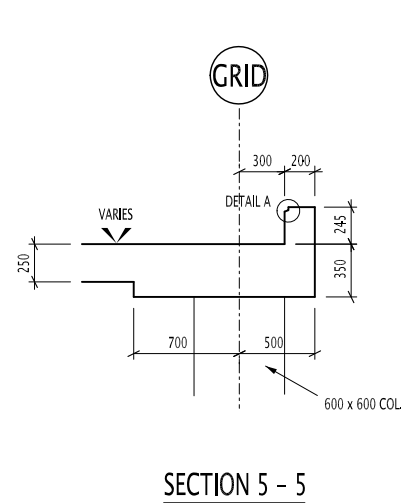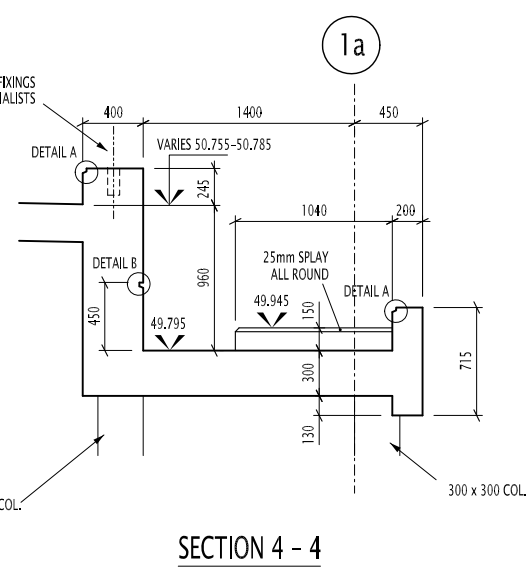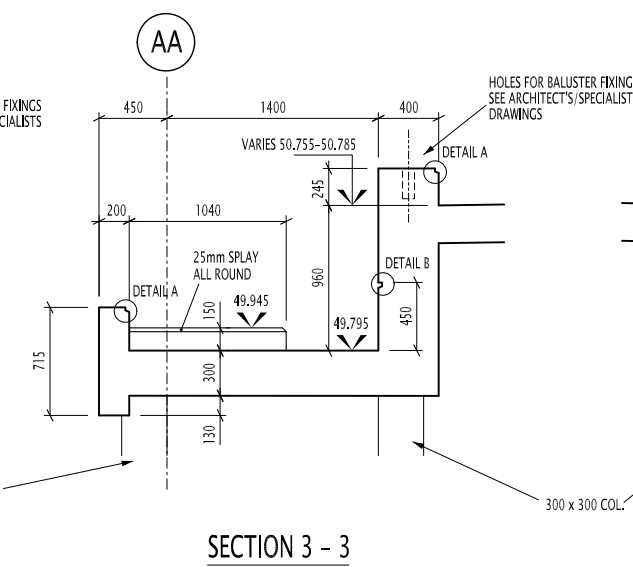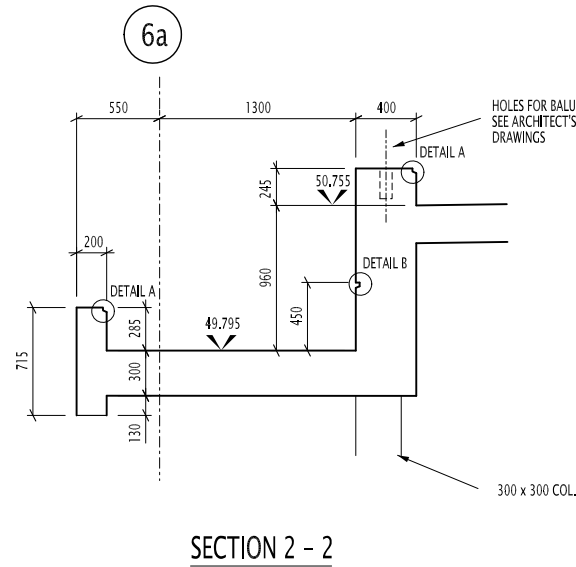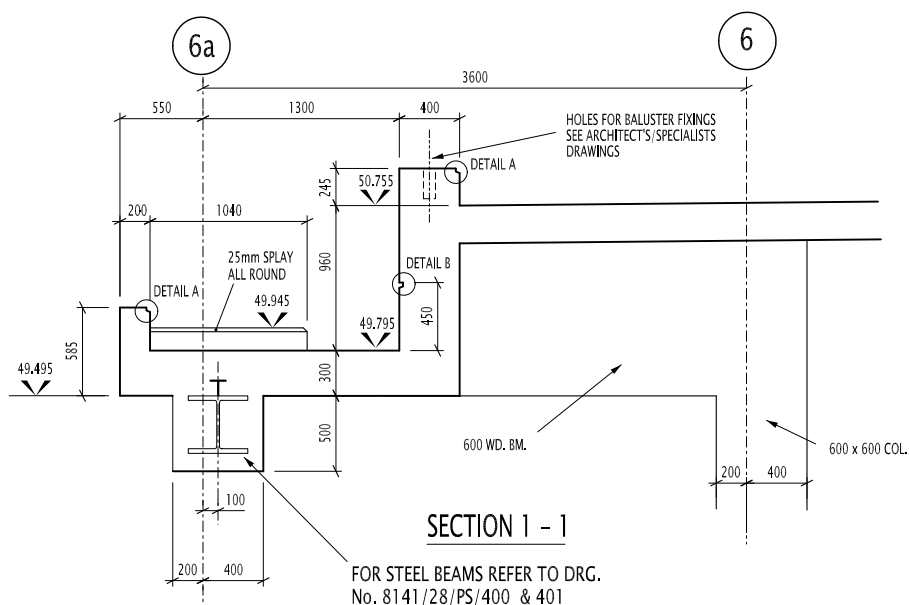

FOR LOCATION OF SECTIONS
REFER TO DRG. No.8141/27/PGA/111
FOR CAST- IN INSERTS SEE
ARCHITECTS/SPECIALISTS DRAWINGS

NOTES
DO NOT SCALE, WORK TO FIGURED DIMENSIONS ONLY, ALL DIMENSIONS ARE QUOTED IN MILLIMETRES. THE CONTRACTOR IS TO CHECK ALL DIMENSIONS AND ANY ERRORS OR OMISSIONS ARE TO BE REPORTED TO THE ENGINEERS. ALL SIZES AND POSITIONS OF HOLES SHOWN ON THIS DRAWING SHOULD BE IN ACCORDANCE WITH THE LATEST REVISION OF THE RELEVANT SERVICES ENGINEERS DRAWINGS AT THE TIME OF ISSUE. HOLES HAVE BEEN DIMENSIONED AND/OR POSITIONED ON R.C. DRAWINGS IN CERTAIN CASES WHERE THEY ARE PARTICULARLY IMPORTANT TO THE STRUCTURE. FINAL POSITION OF HOLES SHOULD BE TAKEN FROM SERVICES DRAWINGS ONLY AND ANY DISCREPANCIES BETWEEN THE LATTER AND THE R.C. DRAWINGS MUST BE REPORTED TO THE ENGINEERS.

CONCRETE DATA					
MEMBER	MIX	AGG.	28 DAY CUBE	MIN.CEM/CONT	W/C RATIO
FOUNDATIONS					
COLUMNS	C40	20mm	40 N/mm ²	300	
WALLS	C40	20mm	40 N/mm ²	300	
SLABS	C40	20mm	40 N/mm ²	300	
BEAMS	C40	20mm	40 N/mm ²	300	

Revisions	Date	By
A ISSUED FOR COMMENTS.	22.11.99	WJS
B ISSUED FOR COMMENTS.	17.12.99	WJS
C ISSUED FOR INCLUSION IN PFI CONTRACTORS TENDER DOCUMENTATION.	27.01.00	WJS
00 STATUS REVISED TO CONSTRUCTION.	01.06.00	CY
01 STOODING BOLT SIZES ADDED.	10.08.00	CY
02 STATUS REVISED TO TENDER.	06.10.00	CY
03 HANGING CRADLE FIXINGS ADDED, WINDOW CLEANING TRACK, PUNTHS, HOLDING DOWN DETAIL etc ALL OMITTED, PUNTHS ADDED AT LOW LEVEL.	26.02.02	PT/JA
04 SLABS AROUND PERIMETER 400w BEAMS DEPTH INCREASED, SECTIONS REVISED TO SUIT AND DETAIL A ADDED, SECTION 11-11 ADDED, DETAIL B ADDED, ARCHITECT CONFIRMATION NOTES ADDED, LEVELS REVISED SECTION 7, UPSTAND ADDED SECTION 5, UPSTAND HEIGHT REVISED SECTION 6, STATUS REVISED TO CONSTRUCTION.	11.04.02	CY
05 SECTION 12 ADDED, PUNTHS REVISED, DELETED SECTIONS 1, 2, 3, 4, 7, 8, BEAM LEVEL REVISED SECTIONS 8 & 10, UPSTAND PROFILE REVISED SECTION 9.		
06 CUTTER PUNTHS REVISED AT ARCHITECT'S REQUEST.	10.07.02	JA
07 LEVELS REVISED SECTION 7-7.	03.08.02	JPC
08 UPSTAND WIDTH REVISED SECTION 5-5, ROOF OUTLET ADDED TO SECTION 7.	02.10.02	JPC
09 SECTIONS 1-1 & 7-7 REVISED, HOLES FOR BALUSTRADE FRINGS INDICATED.	06.11.02	WJS
10 SECTION 6-6 REVISED.	27.11.02	CJB
11 SECTION 11-11 REVISED.	19.12.02	JA
AS BUILT ISSUE.	01.12.04	JA

User Client
University College London Hospitals NHS Trust

Project Co.
HEALTH MANAGEMENT (UCLH) plc

Contractor
BEJ
Project Office, 301-305 Euston Road, London. NW1 3AD



CN&M
CLARKE • NICHOLLS • MARCEL
CONSULTING CIVIL & STRUCTURAL ENGINEERS
Galena House • Galena Road • Hammersmith • London • W6 0LT
● 020 8748 8511 ● 020 8741 8171 ● cnm@cnmlondon.com

The Redevelopment of
University College London Hospitals
Euston Road Proposal

Drawing Title
Podium Block Level 5 Sections

North	Drawing Status
	AS BUILT

Scale	1:25
Date	10.10.99
Drawn	WJS
Checked	JS
Job Number	8141
Drawing Number	20/PGA/211
Revision	11

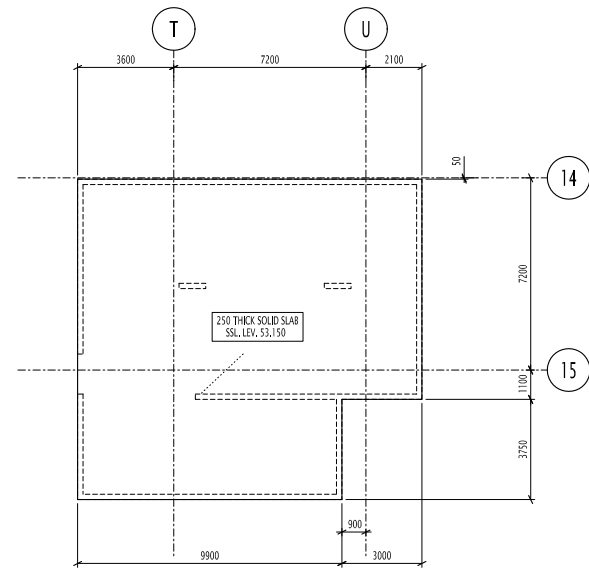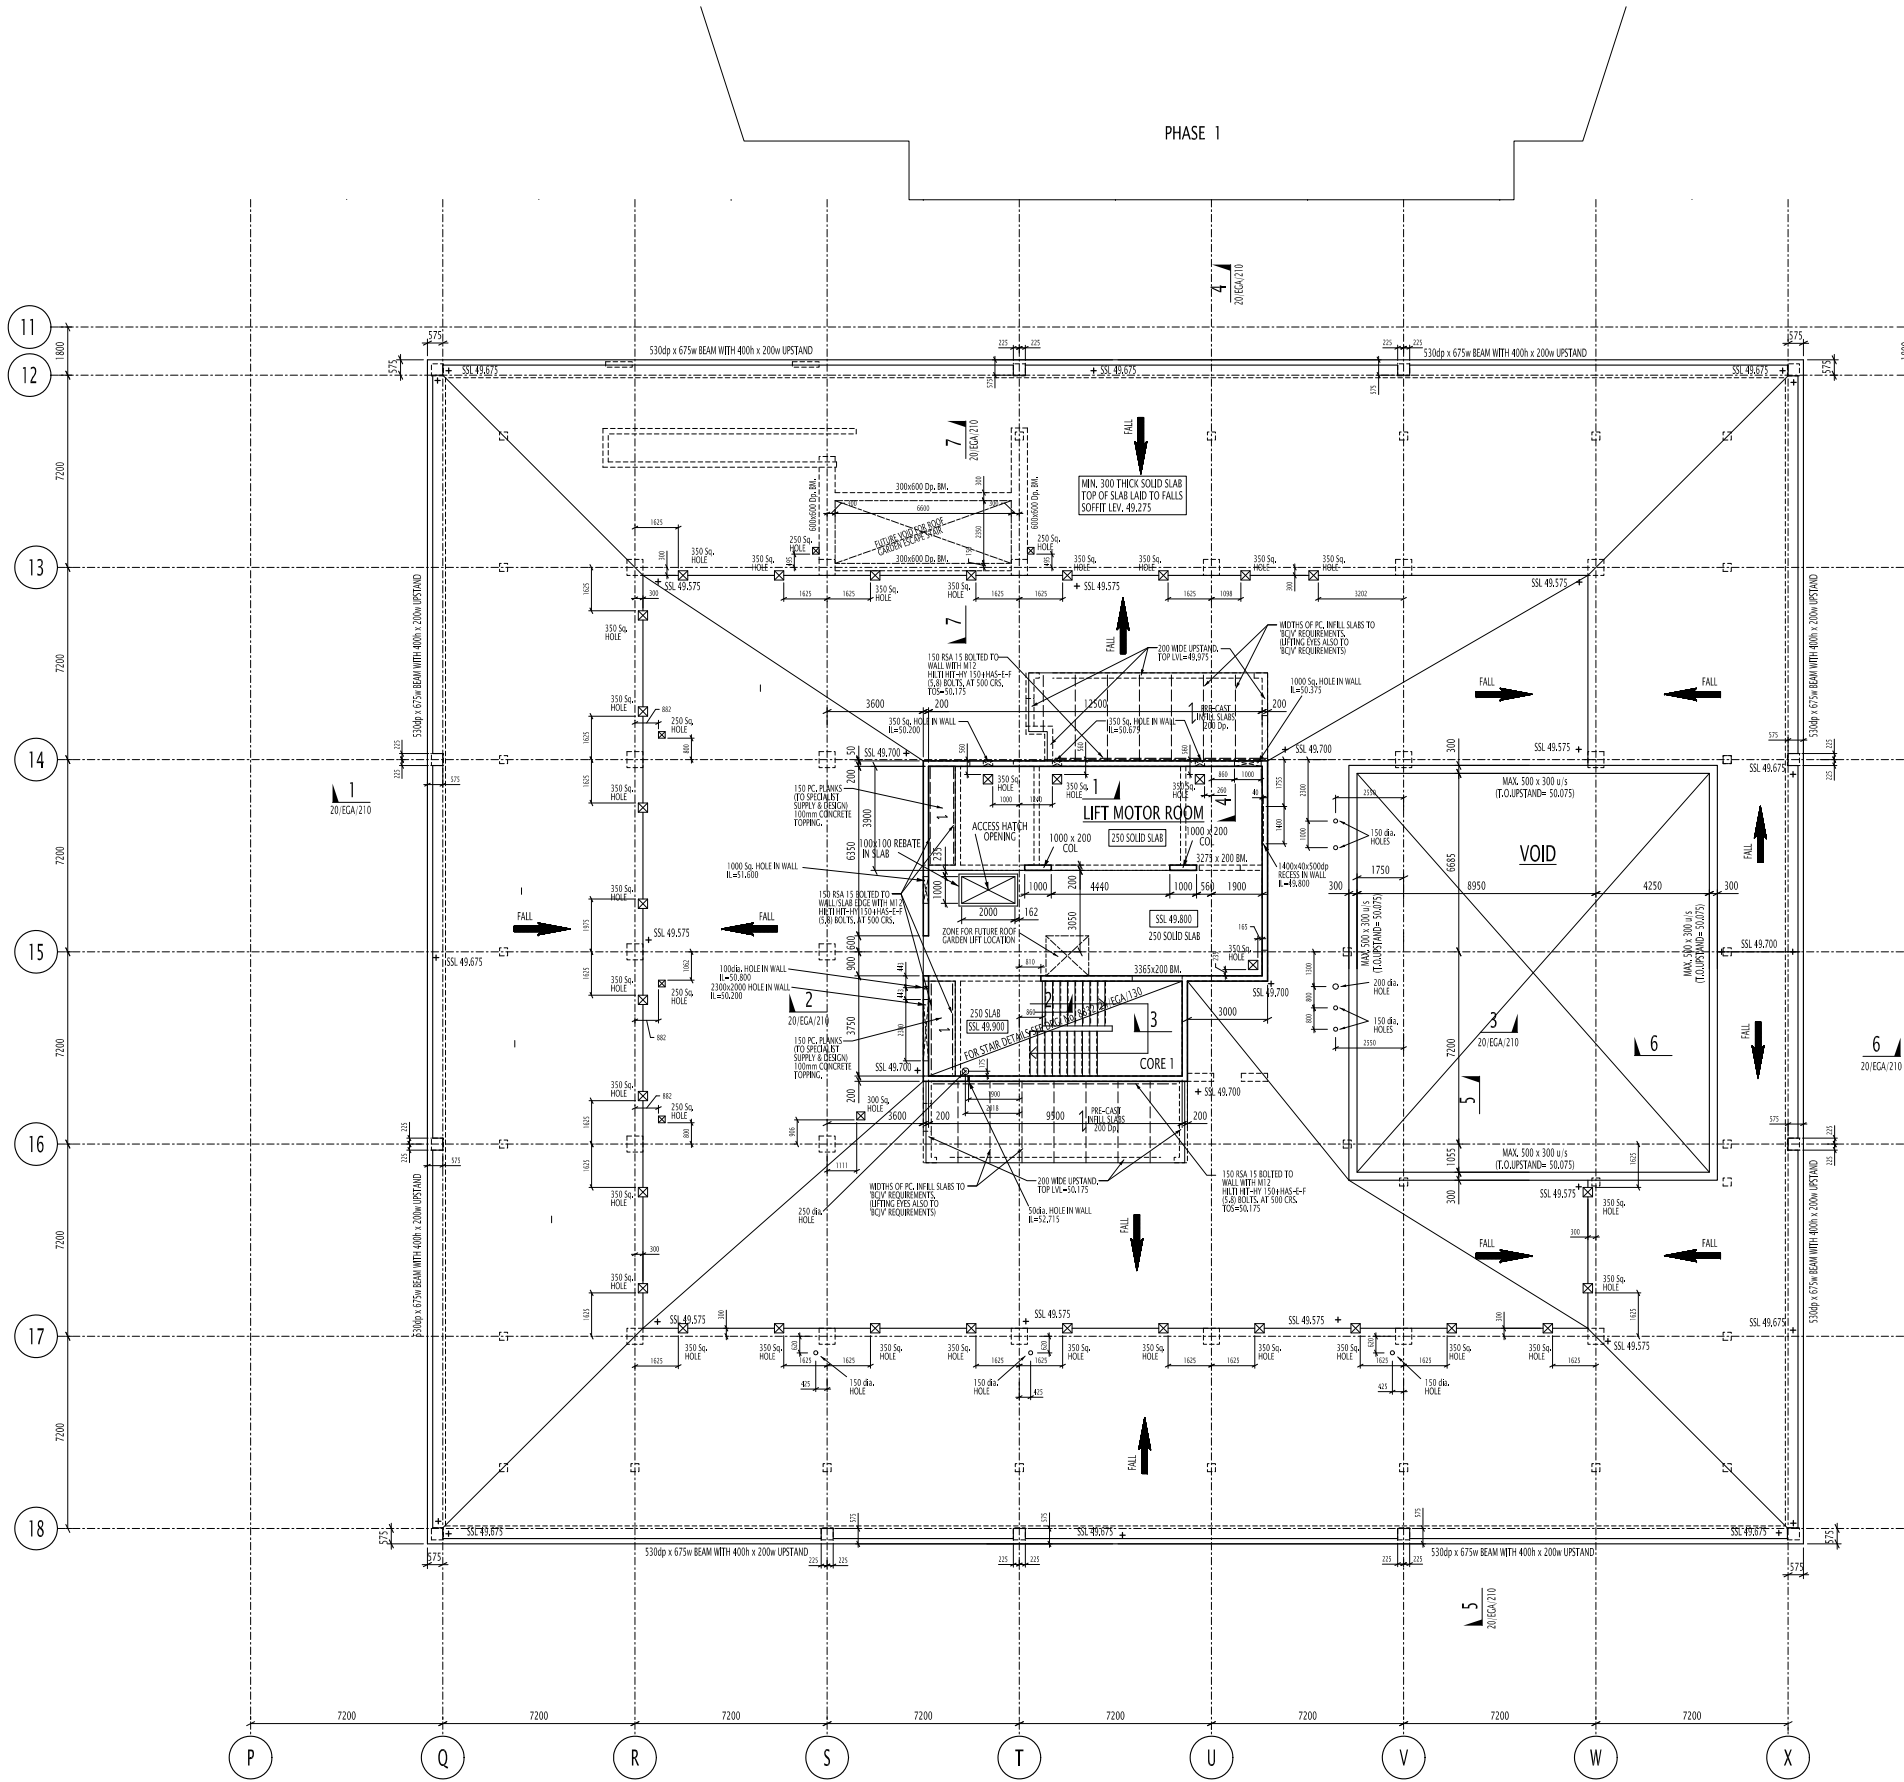

ROOF PLAN TO LIFT MOTOR ROOM AND STAIRS

- NOTES:
- 1) ALL WALLS 200th UNO.
 - 2) FOR SECTIONS SEE DWG. 8832/20/EGA/210.
 - 3) FOR CAST-IN INSERTS SEE ARCHITECT/SPECIALIST DRAWINGS.
 - 4) FOR ROOF DRAINAGE SEE ALSO DSSR DRAWINGS.
 - 5) FOR WINDOW CLEANING CRADLE TRACK PLINTH SETTING OUT SEE CEN TO ENGINEERING CO. Ltd. DRAWING No. 12.027/E-14310
 - 6) FOR HOLES THROUGH LIFT MOTOR ROOM SLAB REFER TO SPECIALIST'S DRAWINGS

NOTES

DO NOT SCALE. WORK TO FIGURED DIMENSIONS ONLY. ALL DIMENSIONS ARE QUOTED IN MILLIMETRES. THE CONTRACTOR IS TO CHECK ALL DIMENSIONS AND ANY ERRORS OR OMISSIONS ARE TO BE REPORTED TO THE ENGINEERS IN ACCORDANCE WITH THE LATEST EDITION OF THE RELEVANT SERVICES ENGINEERS DRAWINGS AT THE TIME OF ISSUE.

HOLES HAVE BEEN DIMENSIONED AND/OR POSITIONED ON R.C. DRAWINGS IN CERTAIN CASES WHERE THEY ARE PARTICULARLY IMPORTANT TO THE STRUCTURE. FINAL POSITION OF HOLES SHOULD BE TAKEN FROM SERVICES DRAWINGS ONLY AND ANY DISCREPANCIES BETWEEN THE LATTER AND THE R.C. DRAWINGS MUST BE REPORTED TO THE ENGINEERS.

CONCRETE DATA (DESIGNATED CONCRETE)				
MEMBER	NO.	ACC.	STRENGTH CLASS	EXPOSURE CLASS
FOUNDATIONS				
COLUMNS	RC40	20	C32/40	XC1
WALLS	RC40	20	C32/40	XC1
SLABS	RC40	20	C32/40	XC1
BEAMS	RC40	20	C32/40	XC1

FLOOR LOADINGS (kN/m ²)			
LOCATION			
LINE LOAD	5.0	FINISHES	3.2
		CEILING / SERVICES	1.0
		PARTITIONS	
FIRE PERIOD			
1.5 HOURS			
LOCATION			
LINE LOAD		FINISHES	
		CEILING / SERVICES	
		PARTITIONS	
FIRE PERIOD			
PARTITIONS			

Revisions	Date	By	
F1	UPDATED TO LATEST ARCHITECTS DRAWINGS.	16.11.04	JY
F2	LIFT MOTOR ROOM ADDED. ROOF TO LIFT MOTOR ROOM.	20.01.05	JY
F3	NOV TERM ADDED.		
F4	DIMENSIONS ADDED. LEVELS AND FALLS OF SLAB SHOWN.	11.04.05	MS
F5	EDGE BEAM ALONG PERIMETER ADDED.		
F6	POWER CRANE OPENING DIMENSIONED.	19.07.05	MS
F7	LIFT MOTOR ROOM LEVELS REBID. WALL OPENING REBID.	19.08.05	JC
F8	UPSTAND HEIGHT ADDED.		
F9	LIFT MOTOR ROOM ROOF REBID.	07.10.05	MS
F10	REBID FOR CONSTRUCTION.		
F11	BUILDING PERIMETER REBID.	16.12.05	JA
F12	HEIGHT OF UPSTANDS AROUND VOID REBID.		
F13	BUILDING PERIMETER REBID TO CLADDING.	06.06.06	JA
F14	NO-CONTACT REQUIREMENTS AND EDGE BEAMS REBID.		
F15	SECTION MARK S-4 ADDED. VOID ABOVE CHILLER ENCLOSURE RELOCATED.		
F16	UPSTAND TO LIFT MOTOR ROOM REMOVED. DRAWING UPDATED TO.	25.09.06	JCM
F17	NOV EMBY CHILLER COMPOUND INCREASED & NOV EAST ROOF GARDEN PLANTING PROPOSED REQUIREMENTS.		
F18	BEAM SHOWN UNDER S-4. ZONES FOR FUTURE ROOF GARDEN.	16.10.06	MS
F19	LIFT ELEV. TERM SHOWN.		
F20	AREAS SHOWN AS PRE-CAST IN CORE. AREA 11.5x4 REBID.	07.12.06	JCM
F21	DOCK OPENING LANE CORN 1 AREA ADDED. DOCK OPENING IN CORE 1 WALL. TO 16 REMOVED.		
F22	250 SL. HOLE IN LIFT MOTOR-ROOM SLAB AND WALL 11.5x4 ADDED.	16.12.06	JCM
F23	250 SL. HOLE IN CORE 1 WALLS ADDED. CORE 11.5x4 TO 16 REMOVED.	01.01.07	JCM
F24	8.5x15.4. FANTRIP ROOF FINISHES ADDED.		
F25	WALL EXISTENCE REDUCED & SLAB EXTENDED AROUND CORE 11.5x4.	26.02.07	MS
F26	MINOR BUILDING/ROOM HOLES THROUGH SLAB ADDED. HOLES ADDED THROUGH CORE 1 WALLS AROUND CORE 11.5x4 TO 16.	12.02.08	MS
F27	HOLES FORMED IN CORE 1 WALLS AROUND CORE 11.5x4 TO 16. AS BUILT.		

User Client

University College London Hospitals NHS Trust

Project Co.

HEALTH MANAGEMENT (UCLH) plc

Contractor

B&W

Project Office, 301-305 Euston Road, London, NW1 3AD

CN&M

CONSULTING CIVIL & STRUCTURAL ENGINEERS

Galsina House • Galsina Road • Hammersmith • London • W6 8LT

020 8248 8111 • 020 8741 8177 • info@cnandm.co.uk

The Redevelopment of University College London Hospitals Euston Road Proposal

Drawing Title

EGA Block Roof

North








Drawing Status

AS BUILT

Scale 1:100 @ A0

Date	Drawn	JA	Checked	JRM
28.02.03				

Job Number	Drawing Number	Revision
8832	27/EGA/110	09

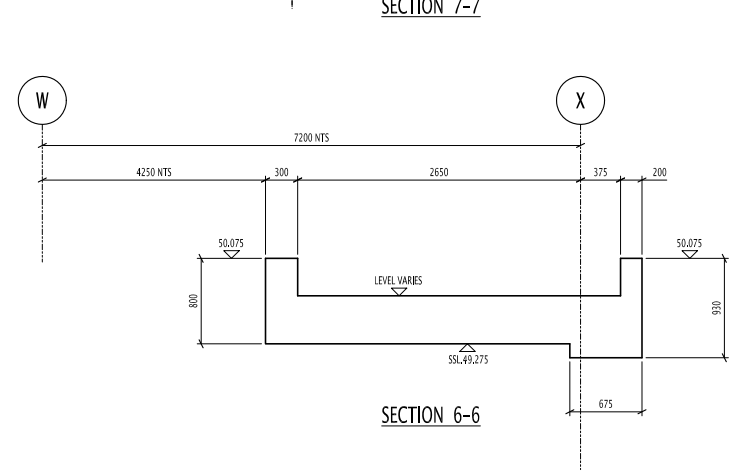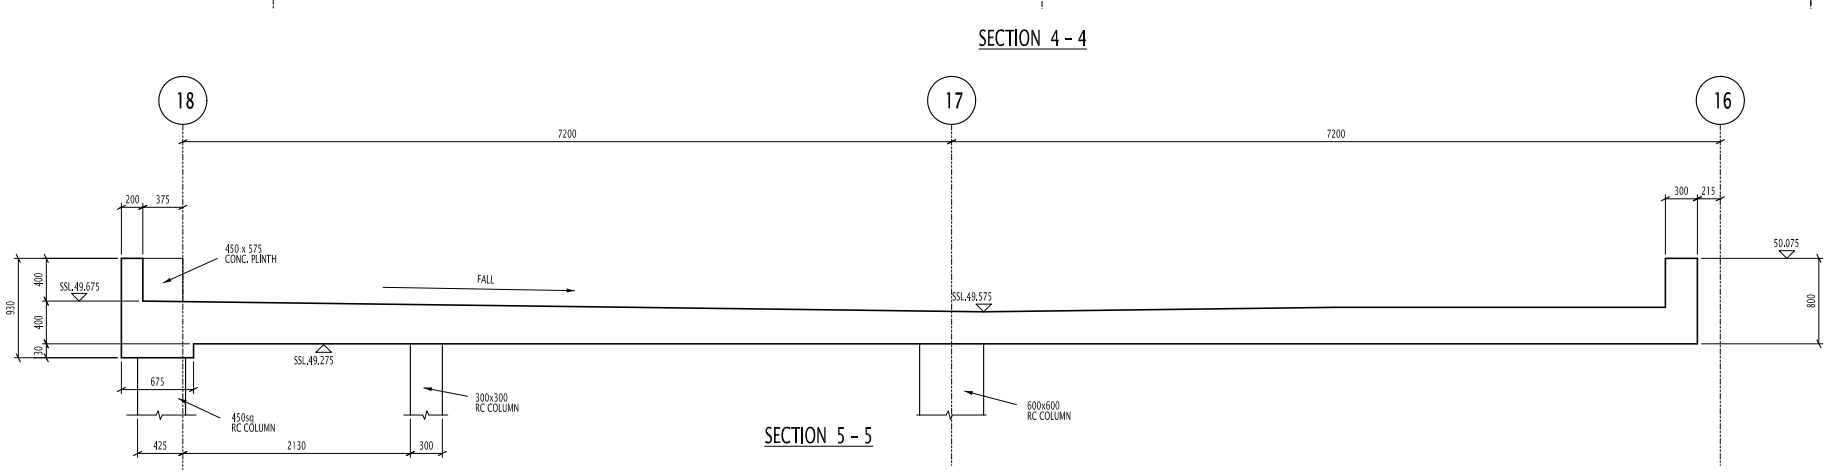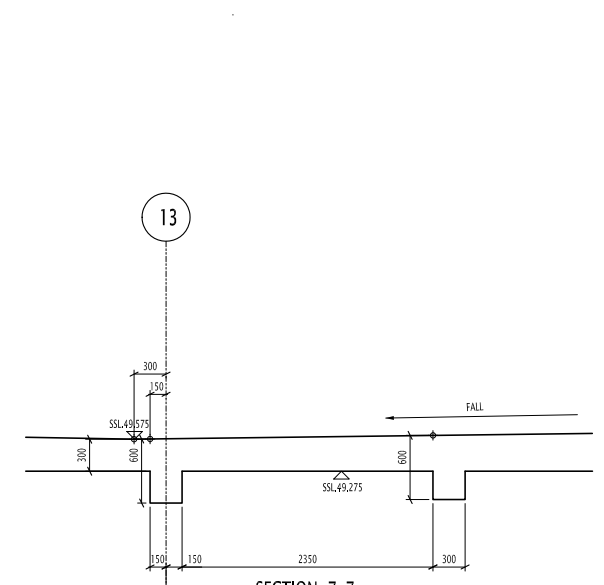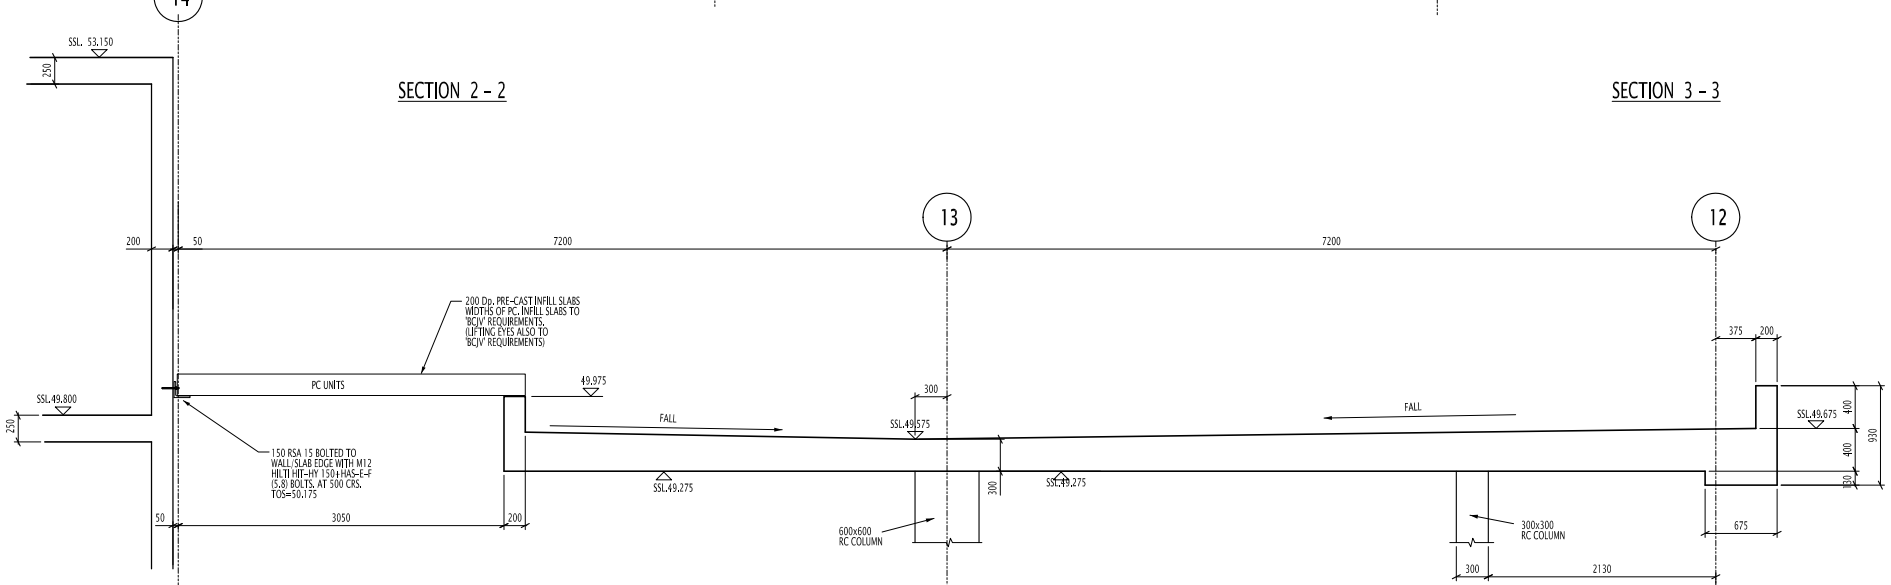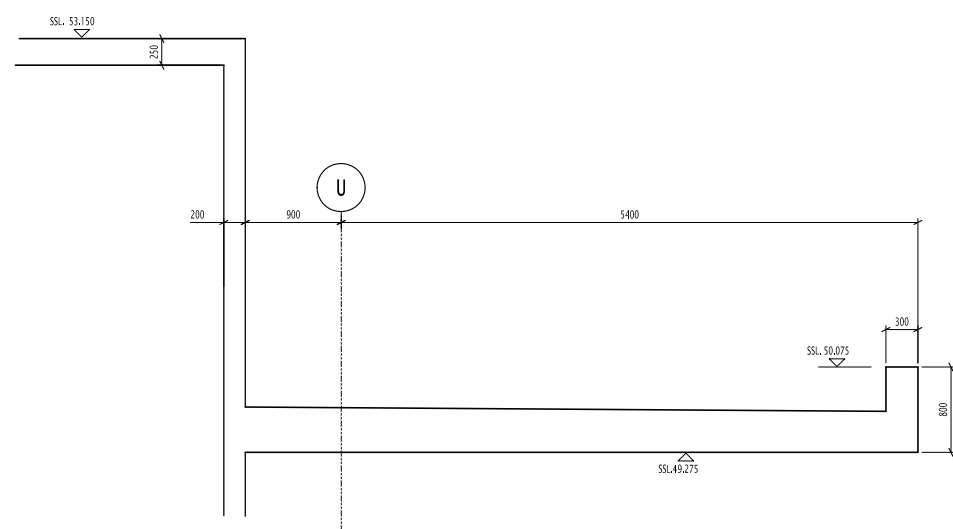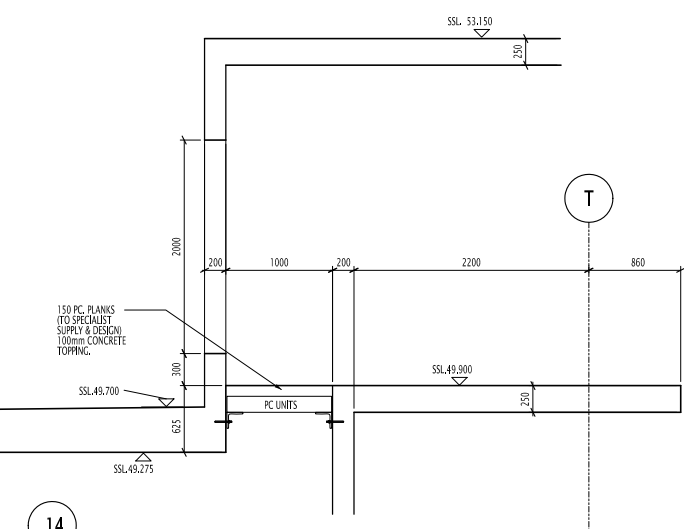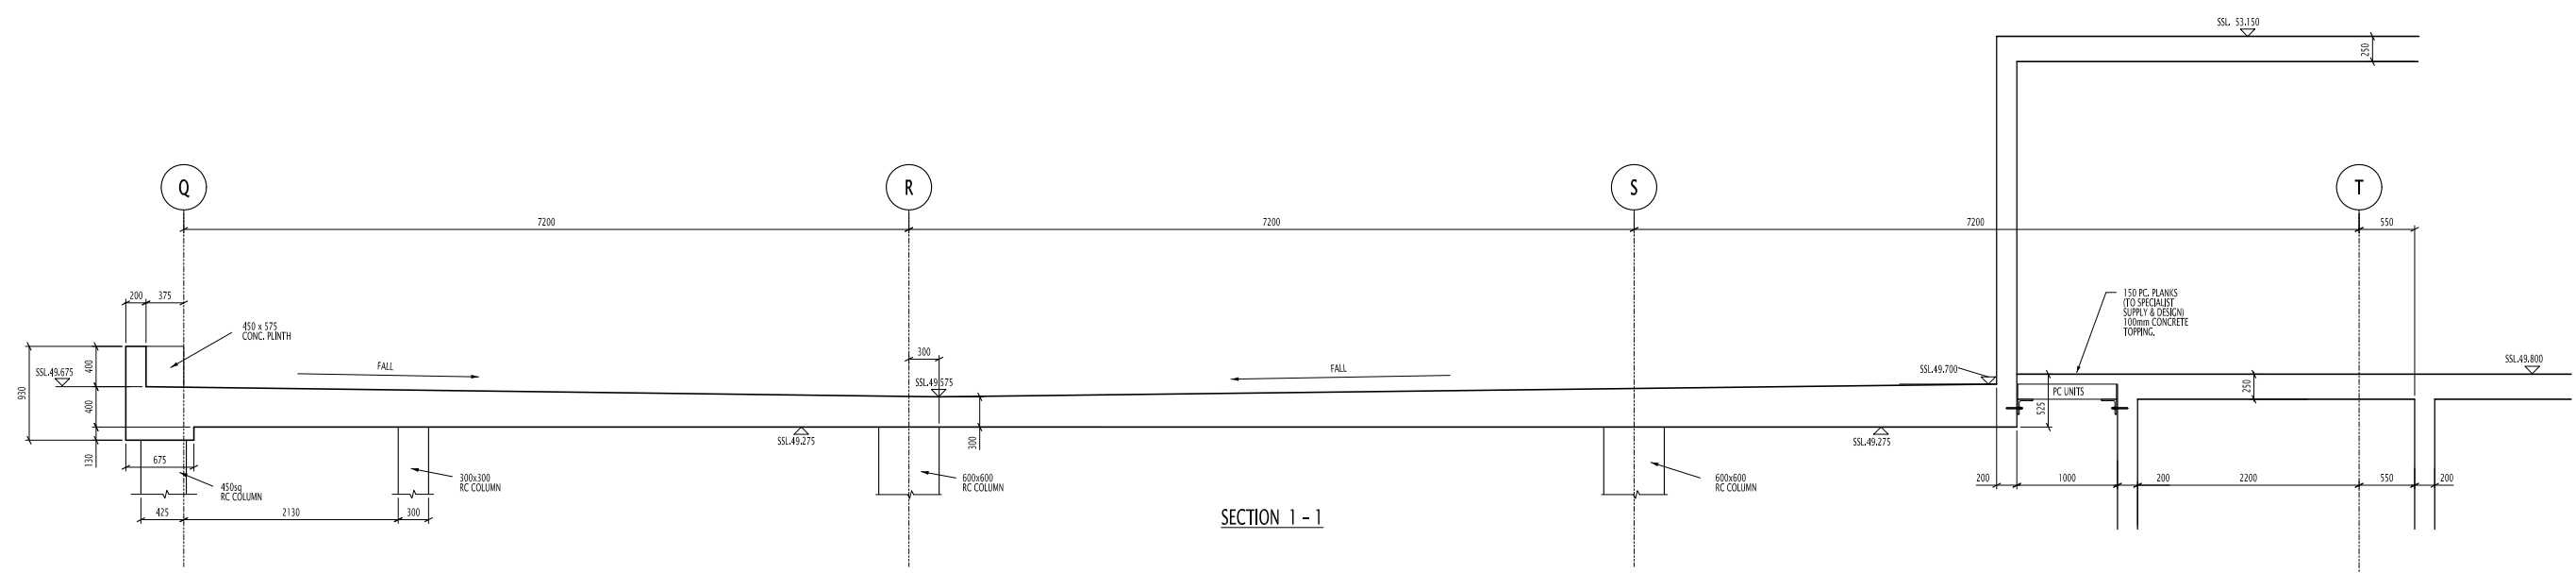

NOTES:
DO NOT SCALE. WORK TO FIGURED DIMENSIONS ONLY. ALL DIMENSIONS ARE QUOTED IN MILLIMETRES. THE CONTRACTOR IS TO CHECK ALL DIMENSIONS AND ANY ERRORS OR OMISSIONS ARE TO BE REPORTED TO THE ENGINEERS. ALL SIZES AND POSITIONS OF HOLES SHOWN ON THIS DRAWING SHOULD BE IN ACCORDANCE WITH THE LATEST REVISION OF THE RELEVANT SERVICES ENGINEERS DRAWINGS AT THE TIME OF ISSUE.
HOLES HAVE BEEN DIMENSIONED AND/OR POSITIONED ON R.C. DRAWINGS IN CERTAIN CASES WHERE THEY ARE PARTICULARLY IMPORTANT TO THE STRUCTURE. FINAL POSITION OF HOLES SHOULD BE TAKEN FROM SERVICES DRAWINGS ONLY AND ANY DISCREPANCIES BETWEEN THE LATER AND THE R.C. DRAWINGS MUST BE REPORTED TO THE ENGINEERS.

NOTE:
1. FOR LOCATION OF SECTIONS SEE DRG. 8832/23 EGA/110.

Revisions	Date	By
#1	11.04.08	MS
#2	19.08.08	JC
#3	07.10.08	MS
#4	16.12.08	JM
#5	16.12.08	JM
#6	16.12.08	JM
#100	16.12.08	JM

User Client
University College London Hospitals NHS
NHS Trust

Project Co.
UCLH

HEALTH MANAGEMENT (UCLH) plc

Contractor
BCW
Project Office, 301-305 Euston Road, London, NW1 3AD

CN&M
CLARK, NICHOLLS & MARCEL
CONSULTING CIVIL & STRUCTURAL ENGINEERS
Galena House • Galena Road • Hammersmith • London • W6 8LT
● 020 8248 8811 ● 020 8741 8171 ● info@cnm.co.uk

The Redevelopment of
University College London Hospitals
Euston Road Proposal

Drawing Title
EGA Block Sections Level 5

North
AS BUILT

Scale 1:50 @ A0

Date	Drawn	WJS	Checked	JRM
MAR.05				

Job Number	Drawing Number	Revision
8832	20/EGA/210	08