

General Notes

Local authorities (Planning Group or Building Control) might request for additional items / information to be added / revised.

Contractor, sub-contractor or supplier is to report any errors, omission or discrepancies on the drawings, and shall not vary any work shown on the drawings without obtaining prior approval from the Architect. Contractor, sub-contractor or supplier is responsible for requesting any additional information from the architect for the correct execution of the works.

Contractor, sub-contractor or supplier shall supply to the Architect all shop drawings, illustrations, specifications, etc. of all specialist work to be incorporated into the main contract works, and shall immediately inform the Architect if any work shown on this drawing is not in accordance with the relevant codes of practice recognized as good practice throughout the industry or if it does not comply with the relevant local authority bye-laws or building regulations.

Contractor to verify all dimensions on site before commencing any work on site or preparing any shop drawings. Figured dimensions to take precedence over scaled dimensions.

Contractor, sub-contractor or supplier shall immediately advise the Architect / quantity surveyor of the effect upon program and cost of any alterations to the proposed works shown on this drawing.

All materials, components and workmanship to comply with the relevant British Standards, Codes of Practice and appropriate manufacturers' recommendations that from time to time shall apply.

This drawing superseded all previous issues of the same drawing number with earlier revisions. This drawing and design is copyright to QR Architects and remains the property of QR Architects, and as such the contents must not be disclosed to anyone or reproduced in any way without prior consent from QR Architects.

Project
 9 Maresfield Gardens
 London NW3 5SJ

Client
 Mr and Mrs. Mandell
 Mr. Curtis

Zone A	Discipline ARCHITECTURE	Status PLANNING
Level	Drawing Number 9MG-PP-03C	Revision C
Paper Size A3 SHEET	Drawing Title Proposed Roof Plan	
Scale 1:100	Date 06/09/2022	Drawn BMG
Project Title 9 Maresfield Gardens	Checked BMG	

q|R

ARCHITECTS

LONDON

phone +44 (0) 203 287 0055
 email info@qrarchitects.co.uk
 website www.qrarchitects.co.uk



Proposed East (Front) Elevation
Scale 1:50



General Notes

Local authorities (Planning Group or Building Control) might request for additional items / information to be added / revised.

Contractor, sub-contractor or supplier is to report any errors, omission or discrepancies on the drawings, and shall not vary any work shown on the drawings without obtaining prior approval from the Architect. Contractor, sub-contractor or supplier is responsible for requesting any additional information from the architect for the correct execution of the works.

Contractor, sub-contractor or supplier shall supply to the Architect all shop drawings, illustrations, specifications, etc. of all specialist work to be incorporated into the main contract works, and shall immediately inform the Architect if any work shown on this drawing is not in accordance with the relevant codes of practice recognized as good practice throughout the industry or if it does not comply with the relevant local authority bye-laws or building regulations.

Contractor to verify all dimensions on site before commencing any work on site or preparing any shop drawings. Figured dimensions to take precedence over scaled dimensions.

Contractor, sub-contractor or supplier shall immediately advise the Architect / quantity surveyor of the effect upon program and cost of any alterations to the proposed works shown on this drawing.

All materials, components and workmanship to comply with the relevant British Standards, Codes of Practice and appropriate manufacturers' recommendations that from time to time shall apply.

This drawing superseded all previous issues of the same drawing number with earlier revisions. This drawing and design is copyright to QR Architects and remains the property of QR Architects, and as such the contents must not be disclosed to anyone or reproduced in any way without prior consent from QR Architects.

Project

9 Maresfield Gardens
London NW3 5SJ

Client

Mr and Mrs. Mandell
Mr. Curtis


Zone A	Discipline ARCHITECTURE	Status PLANNING	
Level	Drawing Number 9MG-PP-06-A	Revision A	
Paper Size	A3 SHEET		
Drawing Title	Proposed East (Front) Elevation Section		
Scale 1:100	Date 06/09/2022	Drawn BMG	Checked BMG
Project Title	9 Maresfield Gardens		


ARCHITECTS
 LONDON

phone +44 (0) 203 287 0055
 email info@qrarchitects.co.uk
 website www.qrarchitects.co.uk



As built East (Front) Elevation -
Street View
Scale 1:50

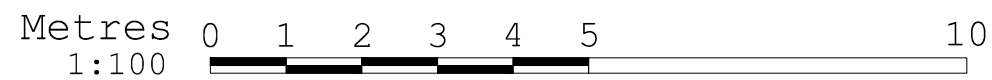

General Notes

Local authorities (Planning Group or Building Control) might request for additional items / information to be added / revised.

Contractor, sub-contractor or supplier is to report any errors, omission or discrepancies on the drawings, and shall not vary any work shown on the drawings without obtaining prior approval from the Architect. Contractor, sub-contractor or supplier is responsible for requesting any additional information from the architect for the correct execution of the works.

Contractor, sub-contractor or supplier shall supply to the Architect all shop drawings, illustrations, specifications, etc. of all specialist work to be incorporated into the main contract works, and shall immediately inform the Architect if any work shown on this drawing is not in accordance with the relevant codes of practice recognized as good practice throughout the industry or if it does not comply with the relevant local authority bye-laws or building regulations.

Contractor to verify all dimensions on site before commencing any work on site or preparing any shop drawings. Figured dimensions to take precedence over scaled dimensions.

Contractor, sub-contractor or supplier shall immediately advise the Architect / quantity surveyor of the effect upon program and cost of any alterations to the proposed works shown on this drawing.

All materials, components and workmanship to comply with the relevant British Standards, Codes of Practice and appropriate manufacturers' recommendations that from time to time shall apply.

This drawing superseded all previous issues of the same drawing number with earlier revisions. This drawing and design is copyright to QR Architects and remains the property of QR Architects, and as such the contents must not be disclosed to anyone or reproduced in any way without prior consent from QR Architects.

Project

9 Maresfield Gardens
London NW3 5SJ

Client

Mr and Mrs. Mandell
Mr. Curtis

Zone A	Discipline ARCHITECTURE	Status PLANNING	
Level	Drawing Number 9MG-PP-07A	Revision A	
Paper Size	A3 SHEET		
Drawing Title	Proposed East (Front) Elevation Street View		
Scale 1:100	Date 06/09/2022	Drawn BMG	Checked BMG
Project Title	9 Maresfield Gardens		


ARCHITECTS
 LONDON

phone +44 (0) 203 287 0055
 email info@qrarchitects.co.uk
 website www.qrarchitects.co.uk



Pre-Existing East (Front)
Elevation - Street View
Scale 1:50



Pre-Existing Left Side Elevation
Scale 1:100



As built East (Front) Elevation -
Street View
Scale 1:50



As built Left Side Elevation
Scale 1:100

General Notes

Local authorities (Planning Group or Building Control) might request for additional items / information to be added / revised.

Contractor, sub-contractor or supplier is to report any errors, omission or discrepancies on the drawings, and shall not vary any work shown on the drawings without obtaining prior approval from the Architect. Contractor, sub-contractor or supplier is responsible for requesting any additional information from the architect for the correct execution of the works.

Contractor, sub-contractor or supplier shall supply to the Architect all shop drawings, details, illustrations, specifications, etc. of all specialist work to be incorporated into the main contract works, and shall immediately inform the Architect if any work shown on this drawing is not in accordance with the relevant codes of practice recognized as good practice throughout the industry or if it does not comply with the relevant local authority bye-laws or building regulations.

Contractor to verify all dimensions on site before commencing any work on site or preparing any shop drawings. Figured dimensions to take precedence over scaled dimensions.

Contractor, sub-contractor or supplier shall immediately advise the Architect / quantity surveyor of the effect upon program and cost of any alterations to the proposed works shown on this drawing. All materials, components and workmanship to comply with the relevant British Standards, Codes of Practice and appropriate manufacturers' recommendations that from time to time shall apply.

This drawing superseded all previous issues of the same drawing number with earlier revisions.

This drawing and design is copyright to qR Architects Ltd and remains the property of qR Architects Ltd, and as such the contents must not be disclosed to anyone or reproduced in any way without prior consent from qR Architects Ltd.

Project

9 Maresfield Gardens
London NW3 5SJ





Client

Mr. & Mrs. Mandell
Mr. Curtis

Zone A	Discipline ARCHITECTURE	Status PLANNING
Level	Drawing Number 9MG-PP-08A	Revision A
Paper Size A1 SHEET	Drawing Title Existing Rear and Side Elevations	
Scale 1:100	Date 06/09/22	Drawn BMG
Project Title 9 Maresfield Gardens	Checked BMG	

q|R
ARCHITECTS
LONDON

phone +44 (0) 203 2879 937
email info@qrchitects.co.uk
website www.qrchitects.co.uk

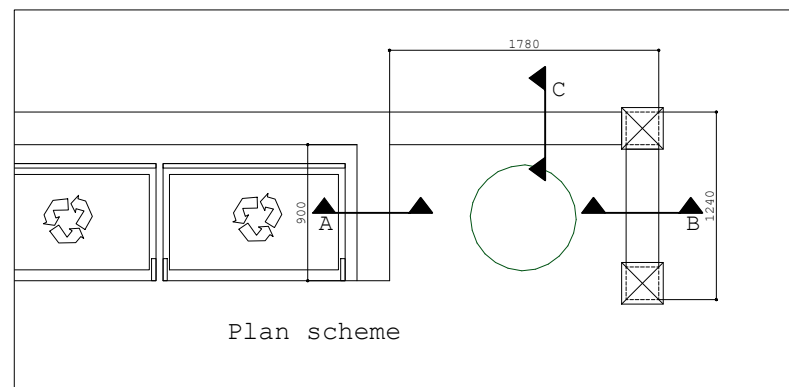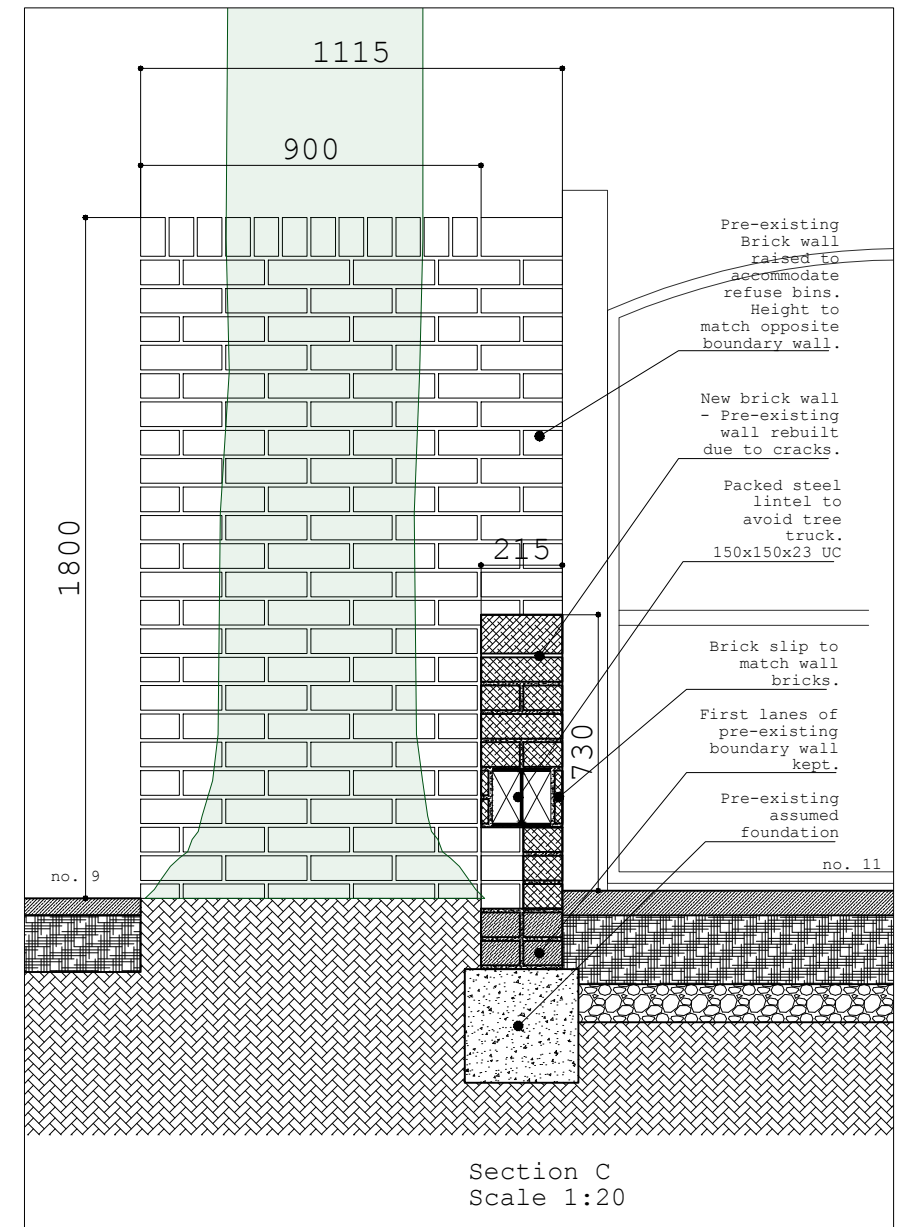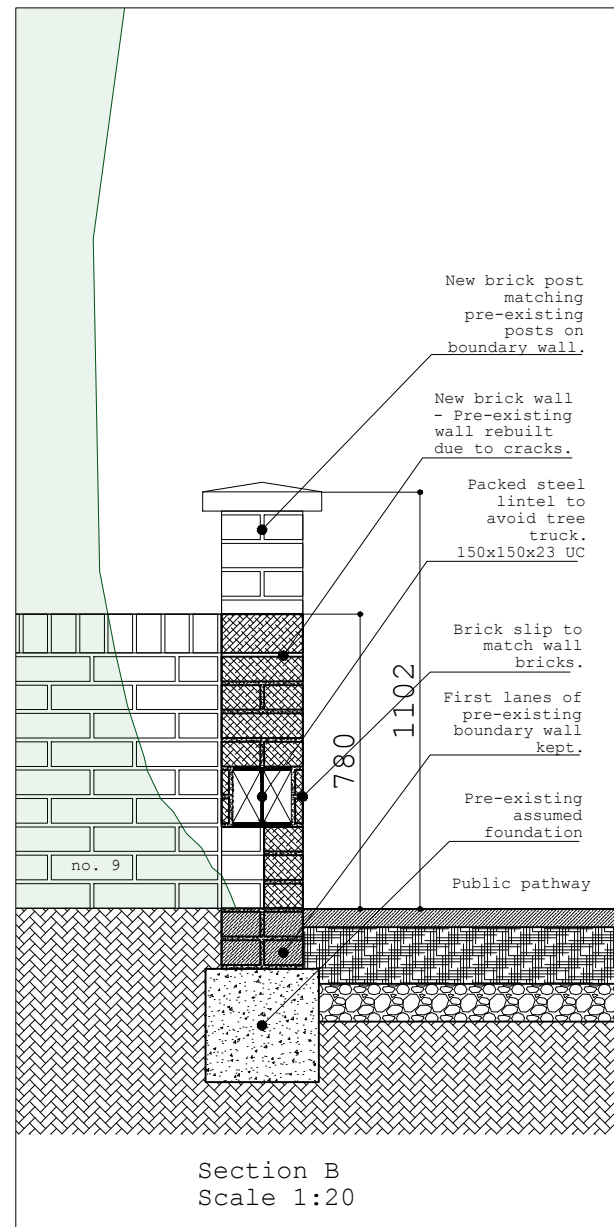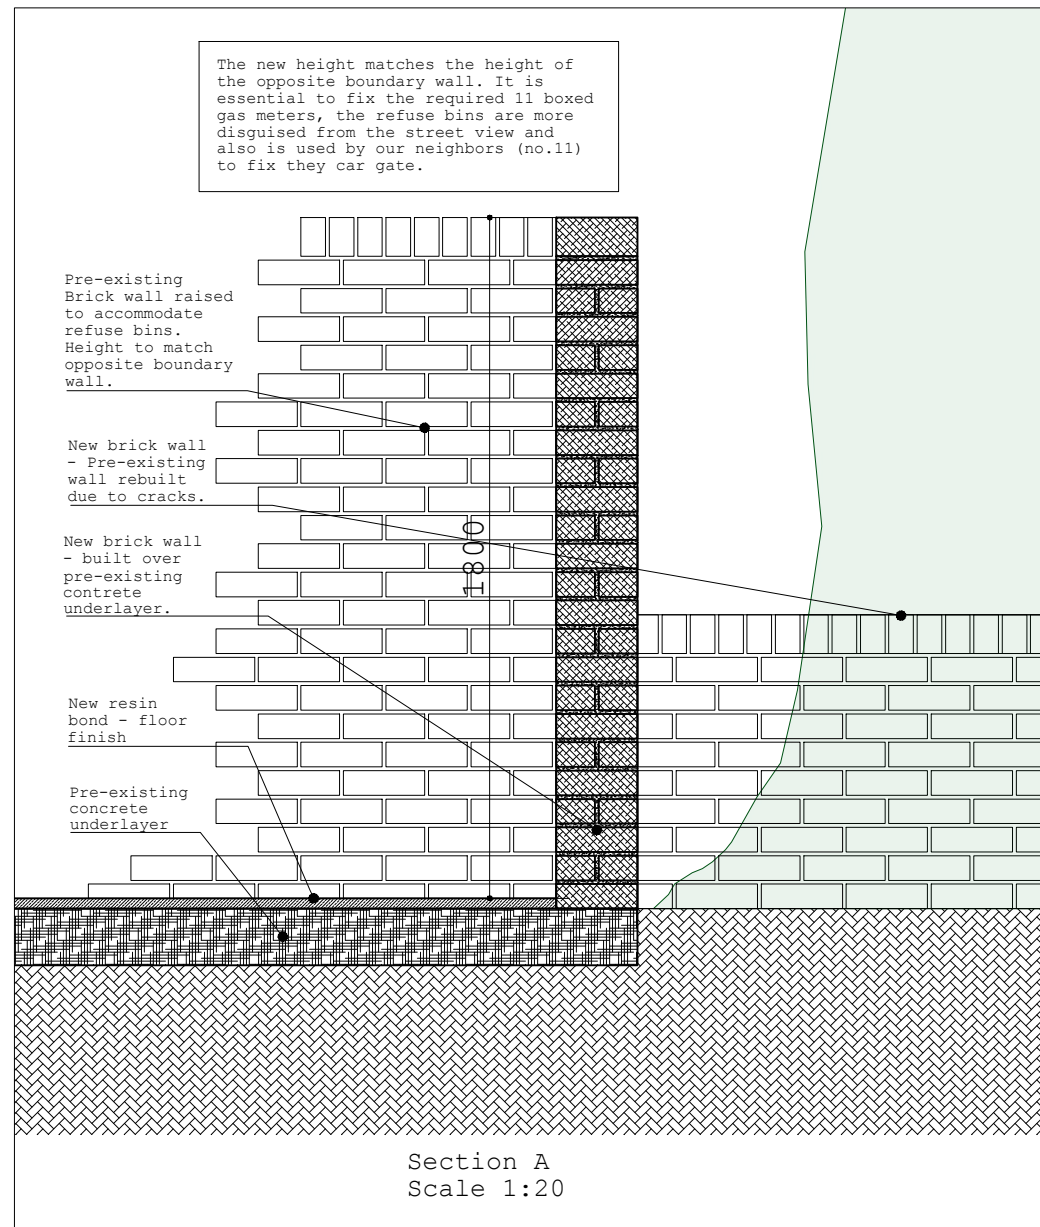

General Notes

Local authorities (Planning Group or Building Control) might request for additional items / information to be added / revised.

Contractor, sub-contractor or supplier is to report any errors, omission or discrepancies on the drawings, and shall not vary any work shown on the drawings without obtaining prior approval from the Architect. Contractor, sub-contractor or supplier is responsible for requesting any additional information from the architect for the correct execution of the works.

Contractor, sub-contractor or supplier shall supply to the Architect all shop drawings, illustrations, specifications, etc. of all specialist work to be incorporated into the main contract works, and shall immediately inform the Architect if any work shown on this drawing is not in accordance with the relevant codes of practice recognized as good practice throughout the industry or if it does not comply with the relevant local authority bye-laws or building regulations.

Contractor to verify all dimensions on site before commencing any work on site or preparing any shop drawings. Figured dimensions to take precedence over scaled dimensions.

Contractor, sub-contractor or supplier shall immediately advise the Architect / quantity surveyor of the effect upon program and cost of any alterations to the proposed works shown on this drawing.

All materials, components and workmanship to comply with the relevant British Standards, Codes of Practice and appropriate manufacturers' recommendations that from time to time shall apply.

This drawing superseded all previous issues of the same drawing number with earlier revisions. This drawing and design is copyright to QR Architects and remains the property of QR Architects, and as such the contents must not be disclosed to anyone or reproduced in any way without prior consent from QR Architects.

Project

9 Maresfield Gardens
London NW3 5SJ

Client

Mr and Mrs. Mandell
Mr. Curtis

Zone	Discipline	Status	
A	ARCHITECTURE	PLANNING	
Level	Drawing Number	Revision	
	9MG-PP-09A	A	
Paper Size	A3 SHEET		
Drawing Title	Boundary section details		
Scale	Date	Drawn	Checked
1:20	06/09/2022	BMG	BMG
Project Title	9 Maresfield Gardens		


ARCHITECTS
 LONDON

phone +44 (0) 203 287 0055
 email info@qrarchitects.co.uk
 website www.qrarchitects.co.uk