


REFER TO SOUTH ELEVATION CHANGE MARK-UP AND WEST ELEVATION
CHANGE MARK-UP FOR CHANGES.



Site Section DD Scale 1:500

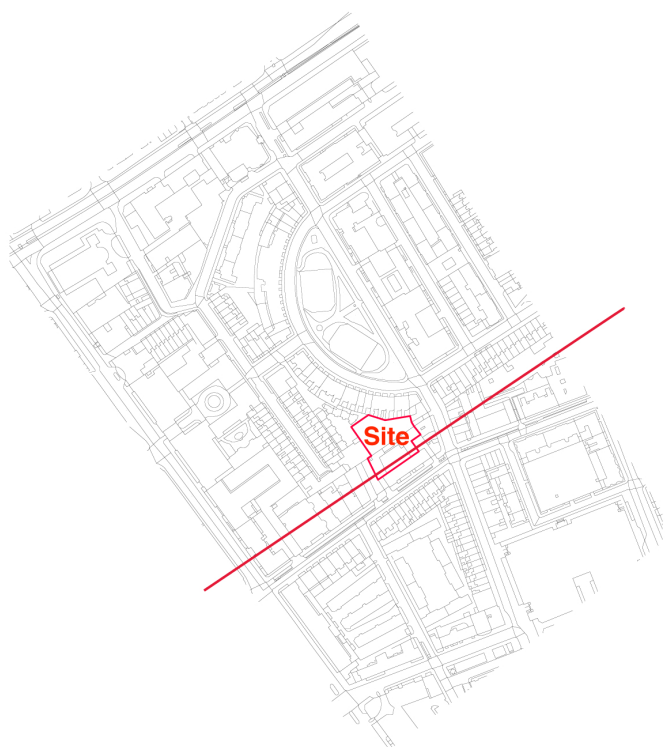

Site Section EE Scale 1:500



0m 10 20 30 40 50 100m