



Disclaimer
Do not scale from this drawing. Check all dimensions on site before fabrication or setting out. This document is copyright and may not be reproduced without permission of the owner.


Notes
Not all revision notes appear on all sheets. Refer to tagged clouds.
Read in conjunction with MEP packages.

- Key :**
- EXT-101 Concrete Paving on pedestals
 - EXT-102 Brick Paving
 - EXT-103 Gravel ballast
 - EXT-208 Green Roof
 - EXT-xxx Granite paving 750x600x65mm
- Planter** with ever green shrubs with ultimate height less than 45cm:
Andromeda polifolia
Arctostaphylos uva-ursi
calluna vulgaris
Daboecia cantabrica
Erica carnea
Vincetoxicum 'variegata'
Vincetoxicum 'Ralph Shugart'
- XB Xenon beacon
 - CCTV camera
 - Wall mounted luminaire
 - Ground recessed luminaire
 - Double Switched Socket (approx 146x86 panel)
 - Bib tap
- Refer to MEP setting out for break glasses

Rev R01 - 19/08/22
Drawing updated to reflect required changes to the courtyard planter to change from brick to aluminium.

| Rev | Reason for Issue | Date | Iss |
|------|------------------|------------|-----|
| RD01 | Record Drawing | 19/08/2022 | Apt |
| RD00 | Record Drawing | 31/05/2022 | Apt |

Consultants
 Structural Engineer: Davies Maguire
 MEP Engineer: GDM Partnership
 Project Manager: CBRE

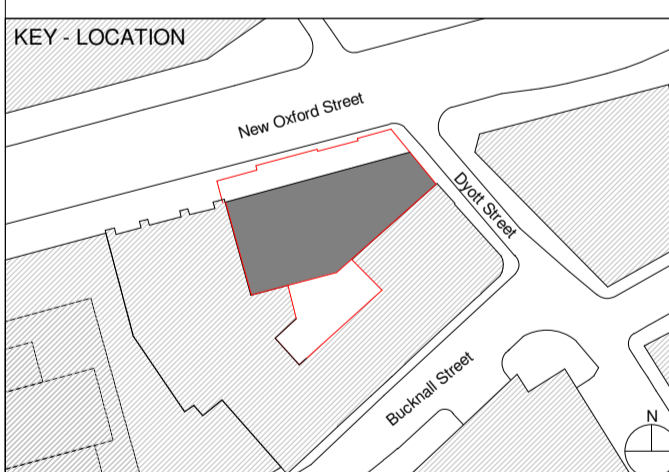

Apt

235 St John Street London EC1V 4NG www.aplondon

Client
Royal London Asset Management

Project
63-69 New Oxford Street

Drawing Title
Landscape
Level 01 Plan
Scope & Setting out

| Scale | Drawn By | Issued By |
|-------------|----------|-----------|
| 1 : 50 @ A1 | Apt | Apt |

Record Drawing

| Project No. | Drawing No. | Revision |
|-------------|-------------|----------|
| 18013 | A_90_101 | RD01 |

