
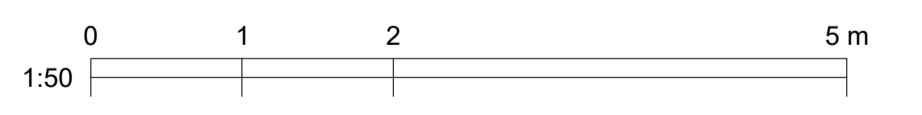


1 SECTION 01  
1:20

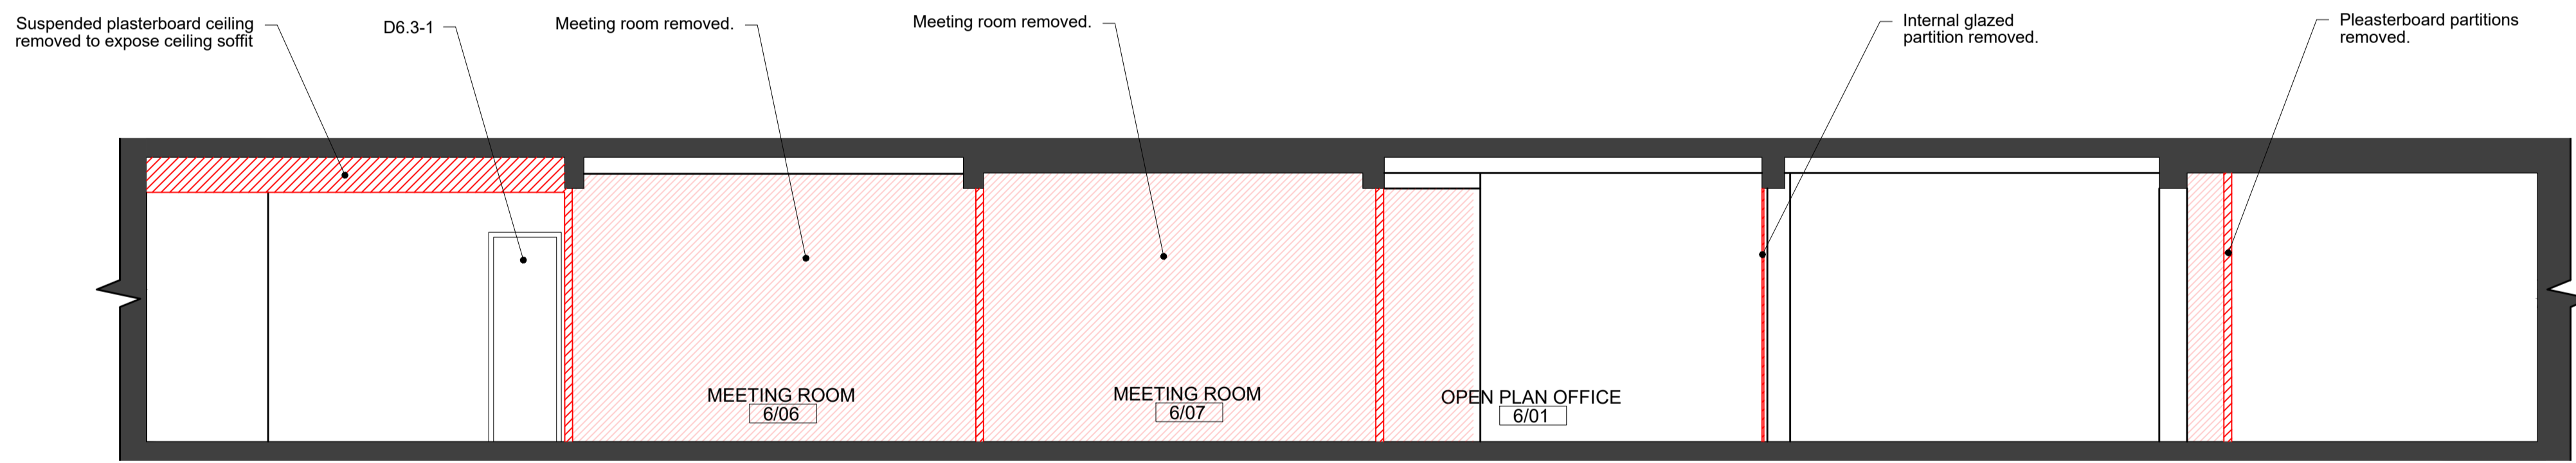

2 SECTION 02  
1:20

KEY	REV	DATE	DESCRIPTION
— (red line)	01	14/09/2022	PLANNING ISSUE
▨ (red hatched)			to be demolished

CLIENT:	GENERAL PROJECTS
STRUCTURAL ENGINEER:	-
M.E.P. ENGINEER:	-

NOTE
1. Do not scale from this drawing. 2. All dimensions to be checked on site by the contractor and such dimensions to be their responsibility. 3. Report all drawings errors, omissions, and discrepancies to the architect. 4. This document may be issued in an uncontrolled CAD format to enable others to use it as background information to make alterations and/or additions. In that instance the file will be accompanied by a PDF version. It is for those making such alterations and additions to ensure that they make use of current background information. WRA Ltd Accepts no liability for any such alterations or additions to the background information or arising out of changes to background information which occur prior to alterations or additions being made.

LOCATION	THE HEAL'S BUILDING 196 TOTTENHAM COURT ROAD LONDON W1T 7LQ
NOT FOR CONSTRUCTION	

WHITE RED ARCHITECTS			
45 Charlotte Road London EC2A 3PD		TEL: 020 7859 4521 whitred.co.uk	
PROJECT NAME: THE HEAL'S BUILDING - 6TH FLOOR			
DRAWING TITLE: DEMOLITION - SECTIONS - SIXTH FLOOR			
DRAWN	CHECKED	SCALE @A1	STATUS
FB	SE	1:50	PLANNING
PROJECT NO.	ZONE	TYPE	SHEET NO. REVISION
5442	-	-	PL_12_306 01