

0 1000 2000 3000 4000 5000 6000 7000 8000 9000 10000

SCALE BAR IN mm

DO NOT SCALE ANY DIMENSIONS OFF THIS DRAWING. ANY DISCREPANCIES BETWEEN THIS DRAWING AND OTHER INFORMATION ARE TO BE REFERRED TO FABRIC (EU) LIMITED WHERE THE DRAWING RELATES TO AN EXISTING BUILDING OR COMPLETED CONSTRUCTION THE CONTRACTOR IS RESPONSIBLE FOR CHECKING THAT THERE IS NO CONFLICT BETWEEN ACTUAL BUILDING DIMENSIONS AND DRAWING DIMENSIONS. IN THE EVENT OF DISCREPANCIES BETWEEN THIS DRAWING AND SUBCONTRACTOR'S APPROVED WORKING DRAWINGS FOR RELEVANT BUILDING COMPONENTS, THE SUBCONTRACTOR'S DRAWINGS SHALL TAKE PRECEDENCE. ANY CONFLICTS ARISING OUT OF INFORMATION AS NOTED ABOVE MUST BE REPORTED IMMEDIATELY TO FABRIC (EU) LIMITED. THIS DRAWING IS THE COPYRIGHT OF FABRIC (EU) LIMITED. ALL DIMENSIONS ARE IN MILLIMETRES UNLESS OTHERWISE STATED.

PARTITIONS KEY

BASE BUILD DEMISE

PARTITIONS TYPES

P-01 DT_323 122MM WIDE ACOUSTIC METAL STUD PARTITION.
STUDS: GYFRAME 70MM S 50 'C' STUDS @ 600MM CENTRES. LININGS: 2 X 12.5MM GYPROC SOUNDBLOC TO EACH SIDE. INSULATION: 25MM ISOVER APR 1200 IN THE CAVITY. FINISHING: 1 COAT OF GYPROC DRYWALL PRIMER, TAPED SEAMLESS FINISH.

P-02 DT_323 100MM SOLID METAL STUD PARTITION.
STUDS: GYFRAME 70MM S 50 'C' STUDS @ 600MM CENTRES. LININGS: 1 X 15MM WALLBOARD TO EACH SIDE. FINISHING: 1 COAT OF GYPROC DRYWALL PRIMER, TAPED SEAMLESS FINISH.

P-03 DT_323 SINGLE GLAZED GLAZING SYSTEM WITH INTEGRATED DOOR AND DECORATIVE MULLIONS BONDED TO GLASS.
FINISHING: FRAMING POWDERCOATED FINISH BLACK - RAL 9005

P-04 DT_323 DOUBLE GLAZED 60 MINUTE FIRE RATED GLAZING SYSTEM WITH INTEGRATED DOOR AND DECORATIVE MULLIONS BONDED TO GLASS.
FINISHING: FRAMING POWDERCOATED FINISH BLACK - RAL 9005

PARTITION LAYOUT NOT ON THE MEASURED SURVEY IN FULL, THEREFORE WE CANNOT VERIFY THE ACCURACY OF THIS DRAWING.

SYMBOLS KEY

(A1) PARTITION TYPE CODE

↓ PATTERNS IN WALLS FOR JOINERY

AV PATTERNS WITHIN WALL: PLYWOOD FROM 1000MM - 2000MM ABOVE FLOOR, 1500MM WIDE.

* RUN PLASTERBOARD PARTITION OR ACOUSTIC Baffle ABOVE CEILING BETWEEN MEETING ROOMS.

MIN 300
DOORS TO BE SET OUT 100mm FROM PARTITION DOORS. DOORS TO BE SET OUT WITH CLEAR 300MM FROM THEIR LEADING EDGE

DOOR NUMBER SYMBOL

DOOR FLOOR NO. TYPE

DOOR TYPE SYMBOL

DOOR TYPE TYPE

NOTES:

- FOR DETAILS OF SKIRTING TYPES REFER TO WALL AND SKIRTING FINISHES DRAWINGS: (42)SERIES OR (40) SERIES COMBINED FINISHES PLANS
- ALL RECESSED AND FLUSH SKIRTING TYPES TO HAVE ACOUSTIC VOID INFILL TO COMPENSATE FOR THE REMOVAL OF PARTITION OUTER LINING.


AB2	16.08.17	AS BUILTS UPDATED TO CLIENT COMMENTS	AJ
AB1	14.08.17	AS BUILTS	AJ
REV	DATE	PURPOSE OF ISSUE	BY

CLIENT BAUER MEDIA
PROJECT ACADEMIC HOUSE
24-28 OVAL ROAD, CAMDEN
DRAWING PARTITIONS PLAN
FIFTH FLOOR

SCALE A1 @ 1:100 STATUS PRELIMINARY
CAD FILE 9100-DRG-(22)105.dwg TENDER
DRAWN AJ CONSTRUCTION
CHECKED IMRV AS BUILT

DRAWING NO. 9100-DRG-(22)105 REV. AB2

FABRIC FABRIC (EU) Ltd
179 Southwark Bridge Road
London SE1 0ED
T 020 7407 6595
E contact@fabric.eu.com
www.fabric.eu.com
INTERIOR DESIGN + ARCHITECTURE

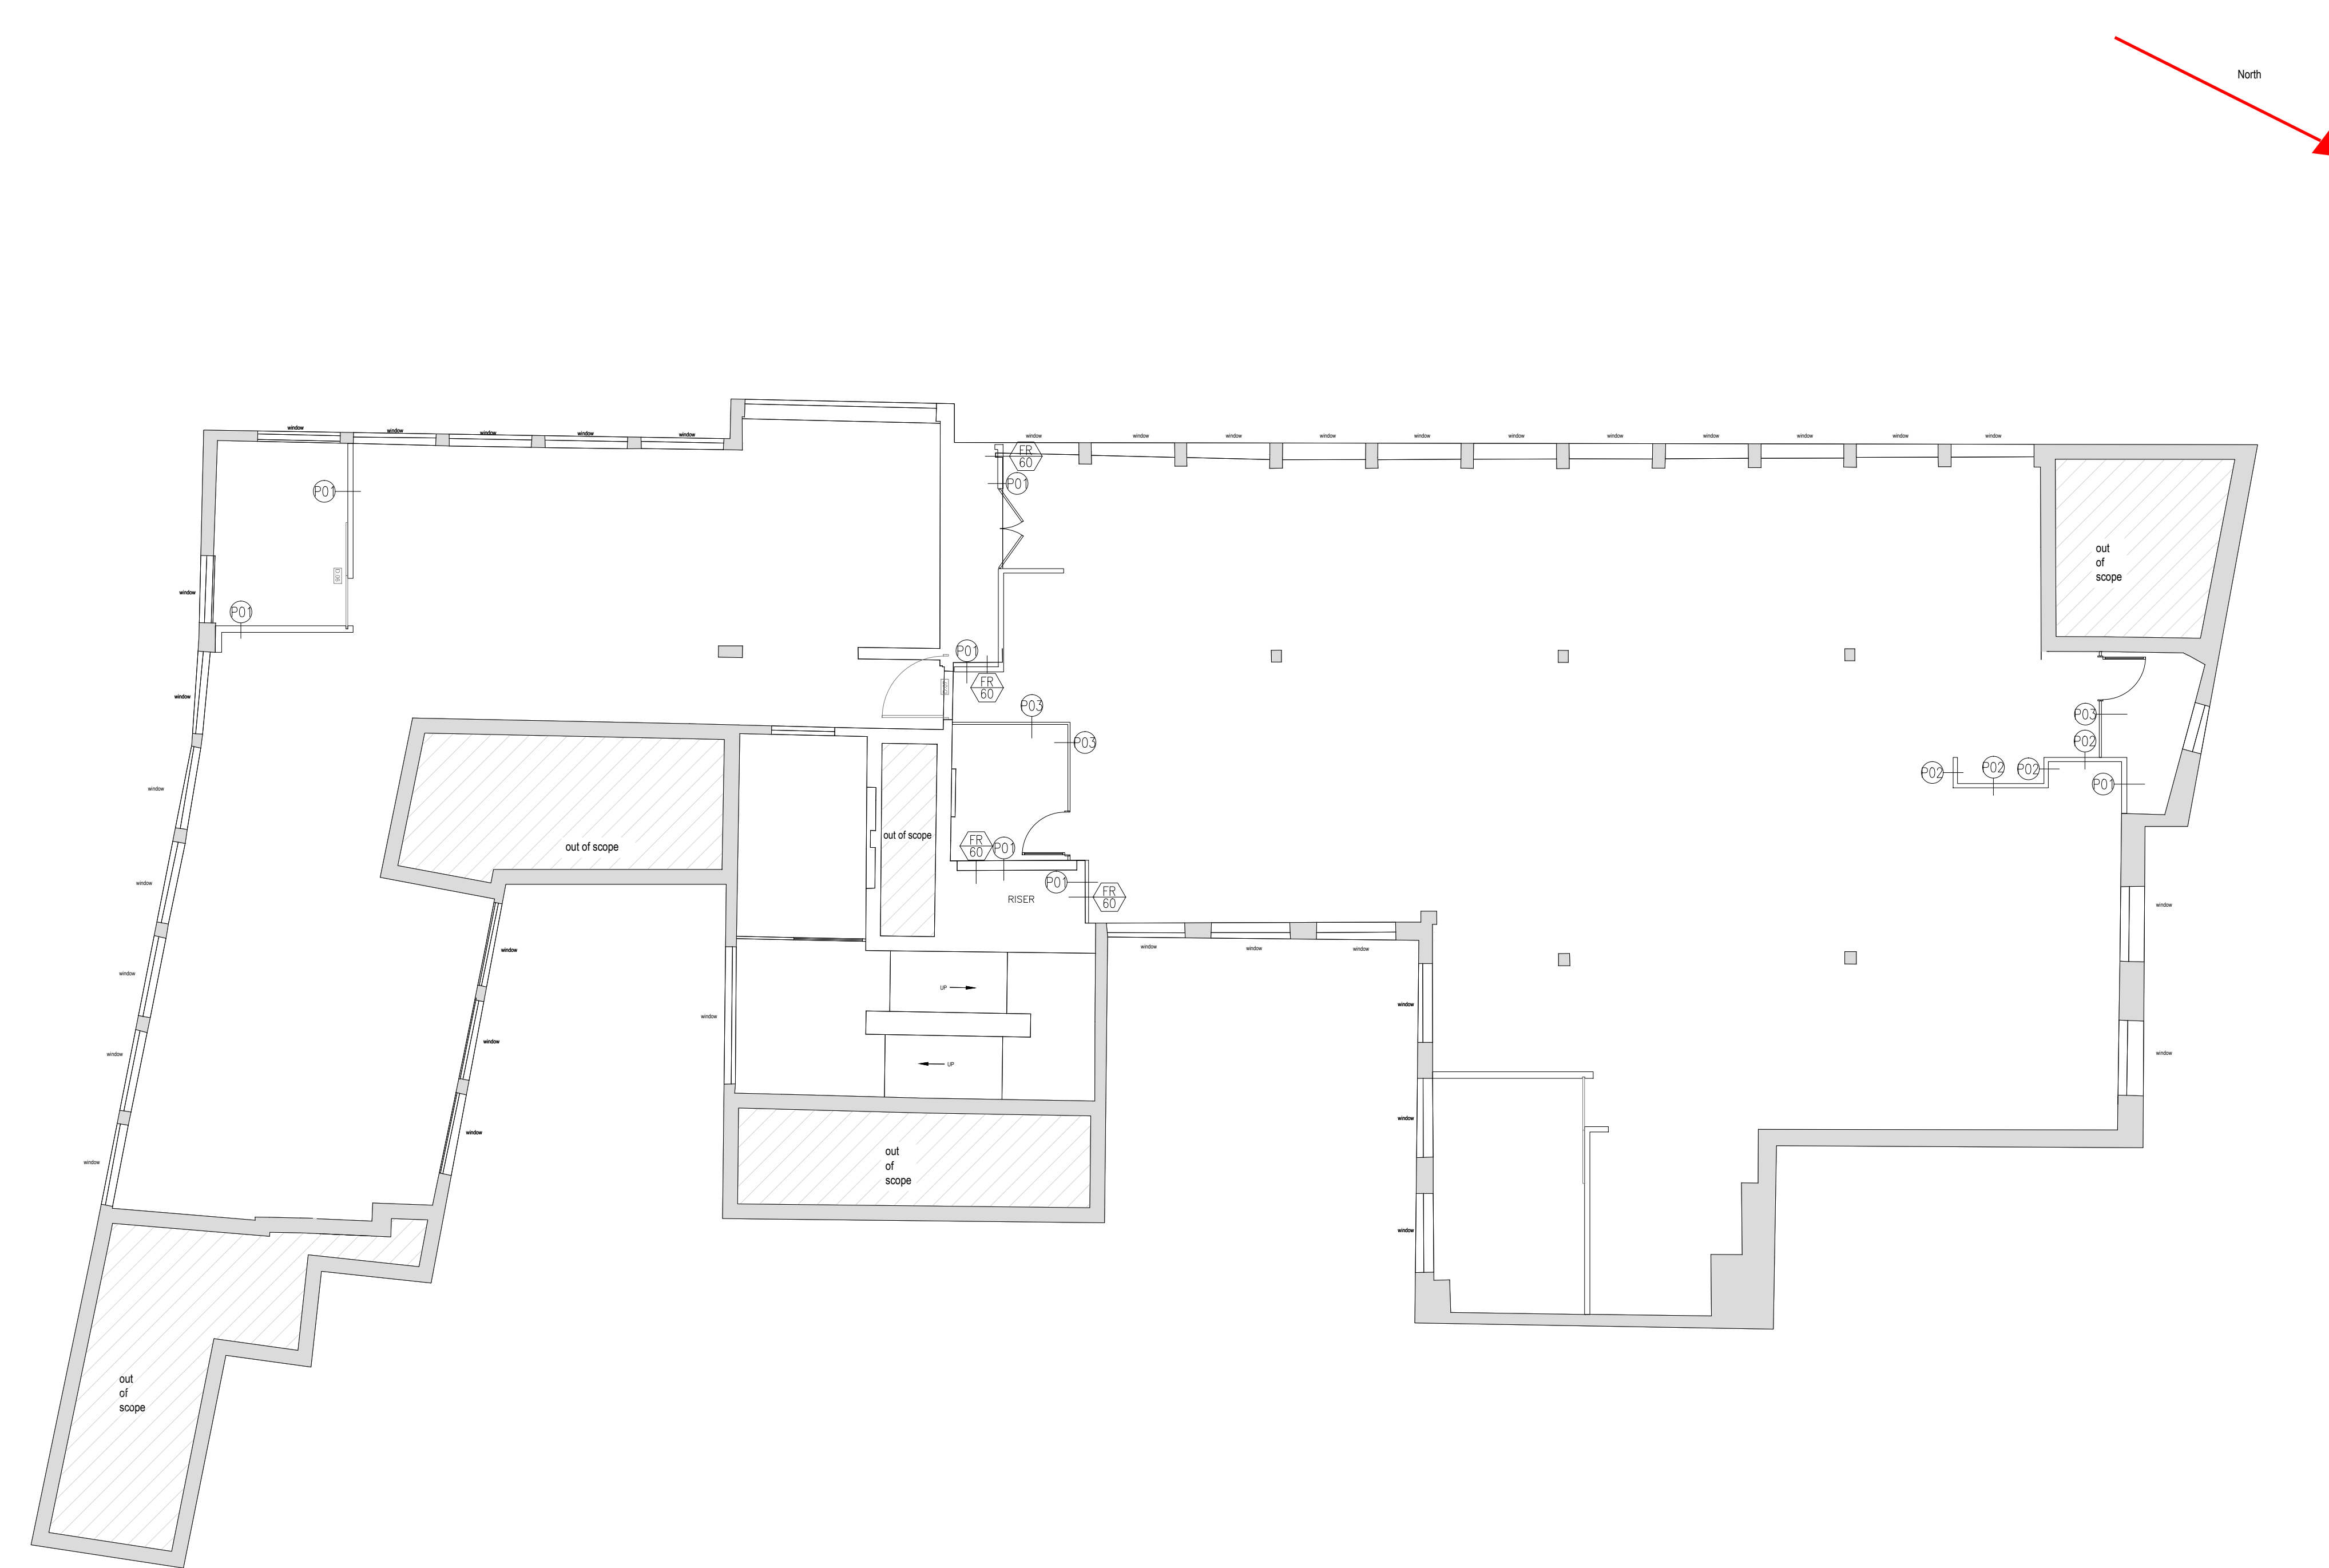

Scale 1:50

Proposed layout