


0 1000 2000 3000 4000 5000 6000 7000 8000 9000 10000

SCALE BAR IN mm

DO NOT SCALE ANY DIMENSIONS OFF THIS DRAWING. ANY DISCREPANCIES BETWEEN THIS DRAWING AND OTHER INFORMATION ARE TO BE REFERRED TO FABRIC (EU) LIMITED WHERE THE DRAWING RELATES TO AN EXISTING BUILDING OR COMPLETED CONSTRUCTION THE CONTRACTOR IS RESPONSIBLE FOR CHECKING THAT THERE IS NO CONFLICT BETWEEN ACTUAL BUILDING DIMENSIONS AND DRAWING DIMENSIONS. IN THE EVENT OF DISCREPANCIES BETWEEN THIS DRAWING AND SUBCONTRACTOR'S APPROVED WORKING DRAWINGS FOR RELEVANT BUILDING COMPONENTS, THE SUBCONTRACTOR'S DRAWINGS SHALL TAKE PRECEDENCE. ANY CONFLICTS ARISING OUT OF INFORMATION AS NOTED ABOVE MUST BE REPORTED IMMEDIATELY TO FABRIC (EU) LIMITED. THIS DRAWING IS THE COPYRIGHT OF FABRIC (EU) LIMITED. ALL DIMENSIONS ARE IN MILLIMETRES UNLESS OTHERWISE STATED.

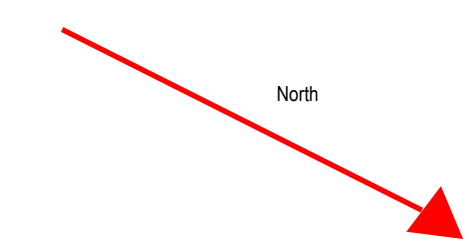

Scale 1:50

Existing Layout

AB1	17.08.14	AS BUILTS	AJ
P3	17.06.09	UPDATED TO CLIENT COMMENTS	AJ
P2	17.05.26	UPDATED TO CLIENT COMMENTS	AJ
P1	17.05.24	FIRST ISSUE	AJ
REV	DATE	PURPOSE OF ISSUE	BY

CLIENT BAUER MEDIA
PROJECT ACADEMIC HOUSE
24-28 OVAL ROAD, CAMDEN
DRAWING FURNITURE AND JOINERY PLAN
THIRD FLOOR

SCALE A1 @ 1:100 STATUS PRELIMINARY
 TENDER
 CONSTRUCTION
 AS BUILT

CAD FILE 9100-DRG-(72)103.dwg
DRAWN AJ
CHECKED IMRV

DRAWING NO. 9100-DRG-(72)103REV.AB1

FABRIC INTERIOR DESIGN + ARCHITECTURE
Fabric (eu) Ltd
179 Southway, Bridge Road
London SE1 0ED
T 020 7407 6395
E contact@fabric.eu.com
www.fabric.eu.com