


0 1000 2000 3000 4000 5000 6000 7000 8000 9000 10000

SCALE BAR IN mm

DO NOT SCALE ANY DIMENSIONS OFF THIS DRAWING. ANY DISCREPANCIES BETWEEN THIS DRAWING AND OTHER INFORMATION ARE TO BE REFERRED TO FABRIC (EU) LIMITED WHERE THE DRAWING RELATES TO AN EXISTING BUILDING OR COMPLETED CONSTRUCTION THE CONTRACTOR IS RESPONSIBLE FOR CHECKING THAT THERE IS NO CONFLICT BETWEEN ACTUAL BUILDING DIMENSIONS AND DRAWING DIMENSIONS. IN THE EVENT OF DISCREPANCIES BETWEEN THIS DRAWING AND SUBCONTRACTOR'S APPROVED WORKING DRAWINGS FOR RELEVANT BUILDING COMPONENTS, THE SUBCONTRACTOR'S DRAWING SHALL TAKE PRECEDENCE. ANY CONFLICTS ARISING OUT OF INFORMATION AS NOTED ABOVE MUST BE REPORTED IMMEDIATELY TO FABRIC (EU) LIMITED. THIS DRAWING IS THE COPYRIGHT OF FABRIC (EU) LIMITED. ALL DIMENSIONS ARE IN MILLIMETRES UNLESS OTHERWISE STATED.

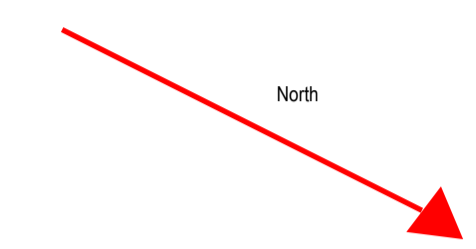

Scale 1:50

### Existing Layout

AB1 17.08.14 AS BUILTS  
REV DATE PURPOSE OF ISSUE BY

CLIENT BAUER MEDIA  
PROJECT ACADEMIC HOUSE  
24-28 OVAL ROAD, CAMDEN  
DRAWING FURNITURE AND JOINERY PLAN  
FOURTH FLOOR

SCALE A1 @ 1:100 STATUS  PRELIMINARY  
CAD FILE 9100-DRG-(72)104.dwg  TENDER  
DRAWN AJ  CONSTRUCTION  
CHECKED IMRV  AS BUILT  
DRAWING NO. 9100-DRG-(72)104-REV.AB1

**FABRIC** Interior Design + Architecture  
Fabric (eu) Ltd  
179 Southway, Bridge Road  
London SE1 0ED  
T 020 7407 6395  
E contact@fabric.eu.com  
www.fabric.eu.com