


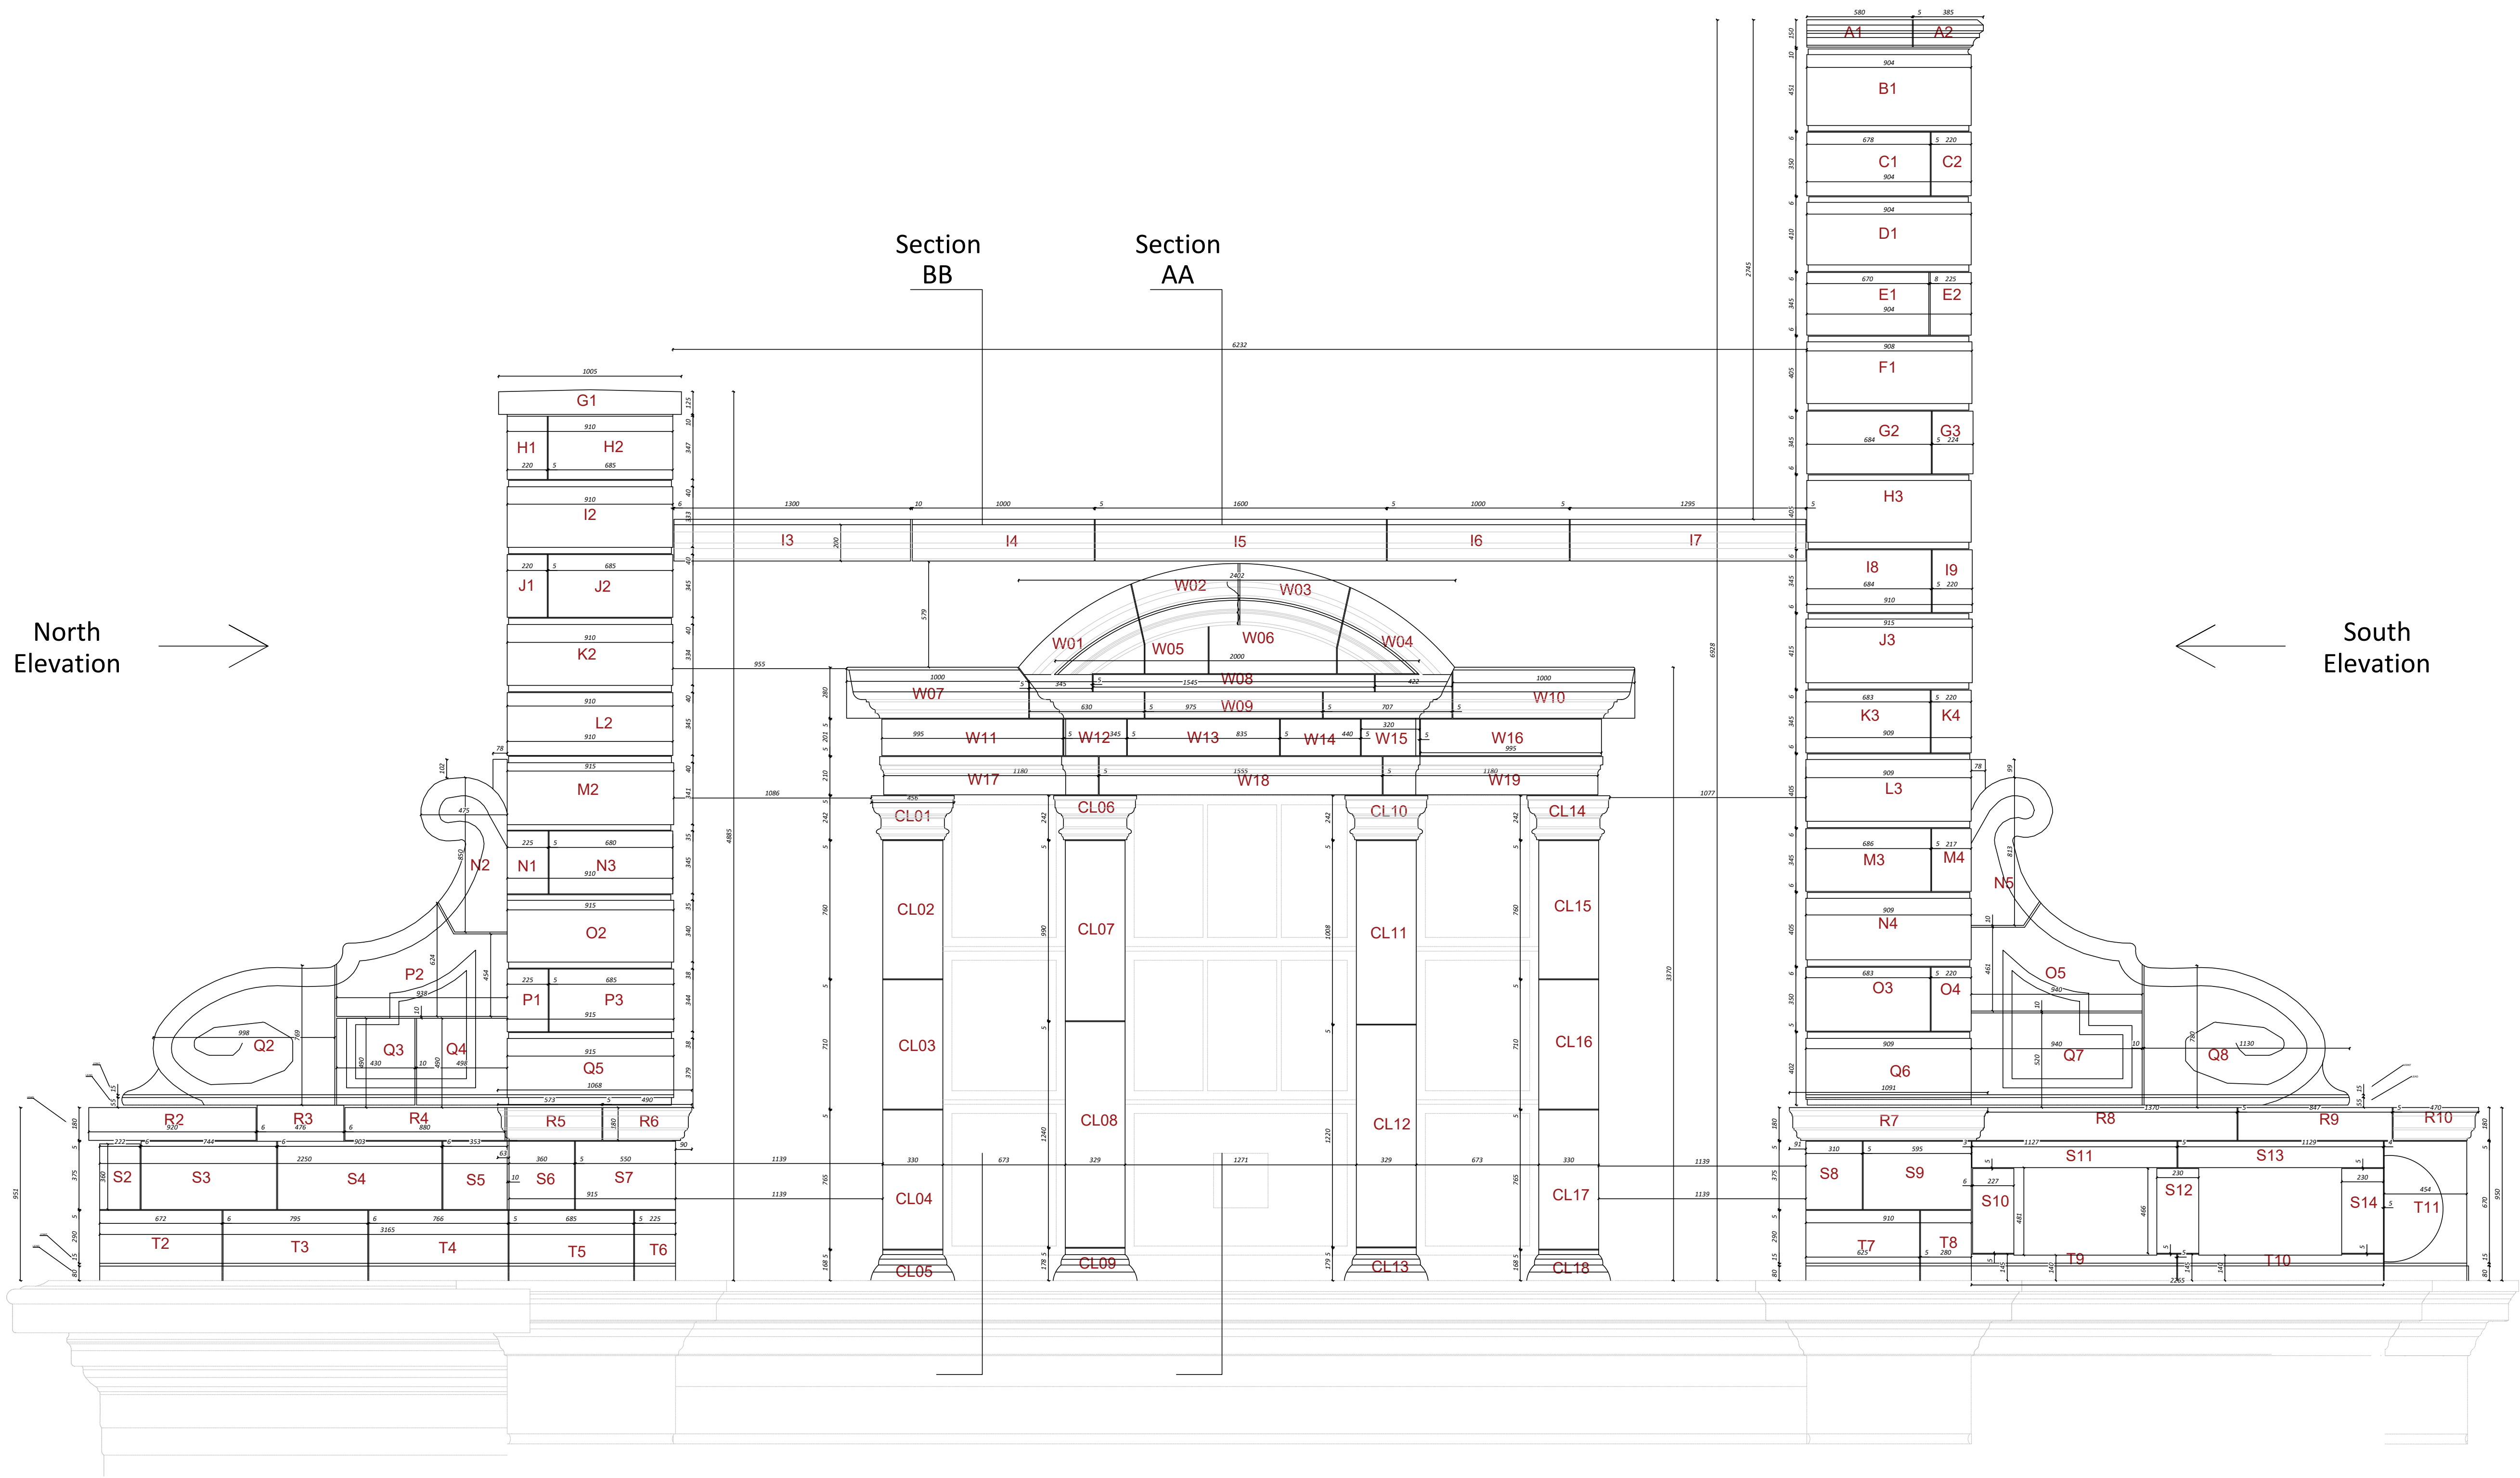

NOTES

1. No dimensions to be scaled from this drawing.
2. All dimensions to be checked on site.
3. The designer must be notified where any discrepancy occurs between specification and drawing.
4. COPYRIGHT: The contents of this drawing may not be reproduced in whole or part without the written permission of Paye Stonework & Restoration Ltd.

Sheet Size – A1

P02 11-03-21 Record Drawing

P01 25-01-21 For Reference

REVISIONS

Architect

Hawkins/Brown

Contractor

Keltbray

Contract

256 Gray's Inn Road

Drawing Title

West elevation

Date

Jan-2021

Scale

NA

Drawn by

IG


Chk'd By

Drawing No.

20106-01

Rev.

P02

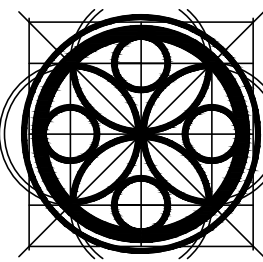

PAYE


Stonework & Restoration

Stationmasters House, Nottingham Station Approach,


London, SE9 4EL

Website: www.payestone.net Email: info@payestone.net


tel: 020 8857 9111

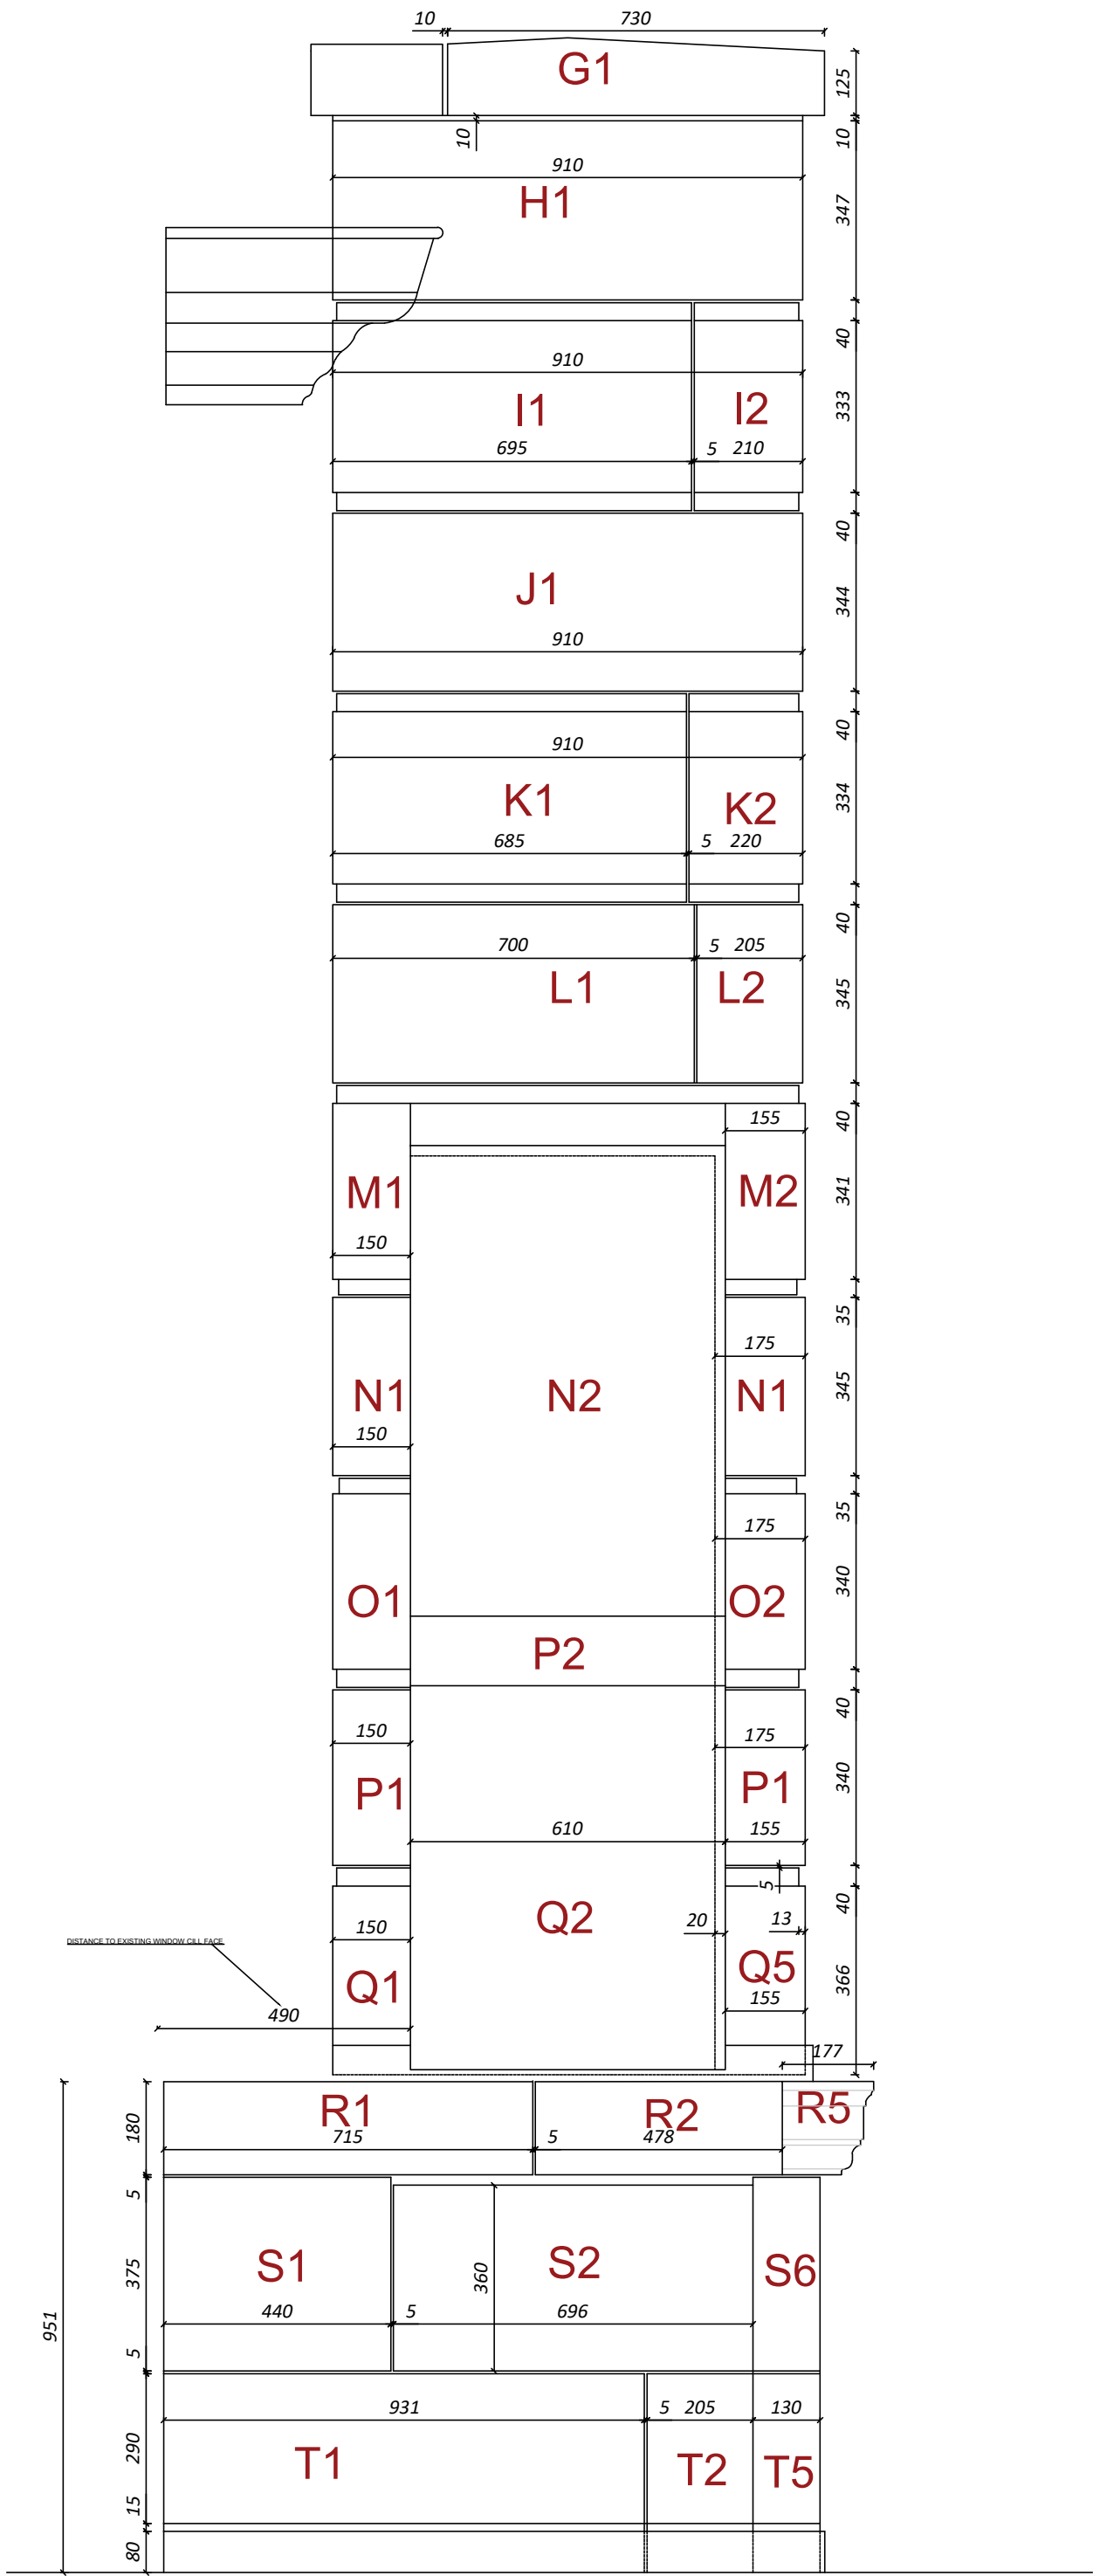


North Elevation

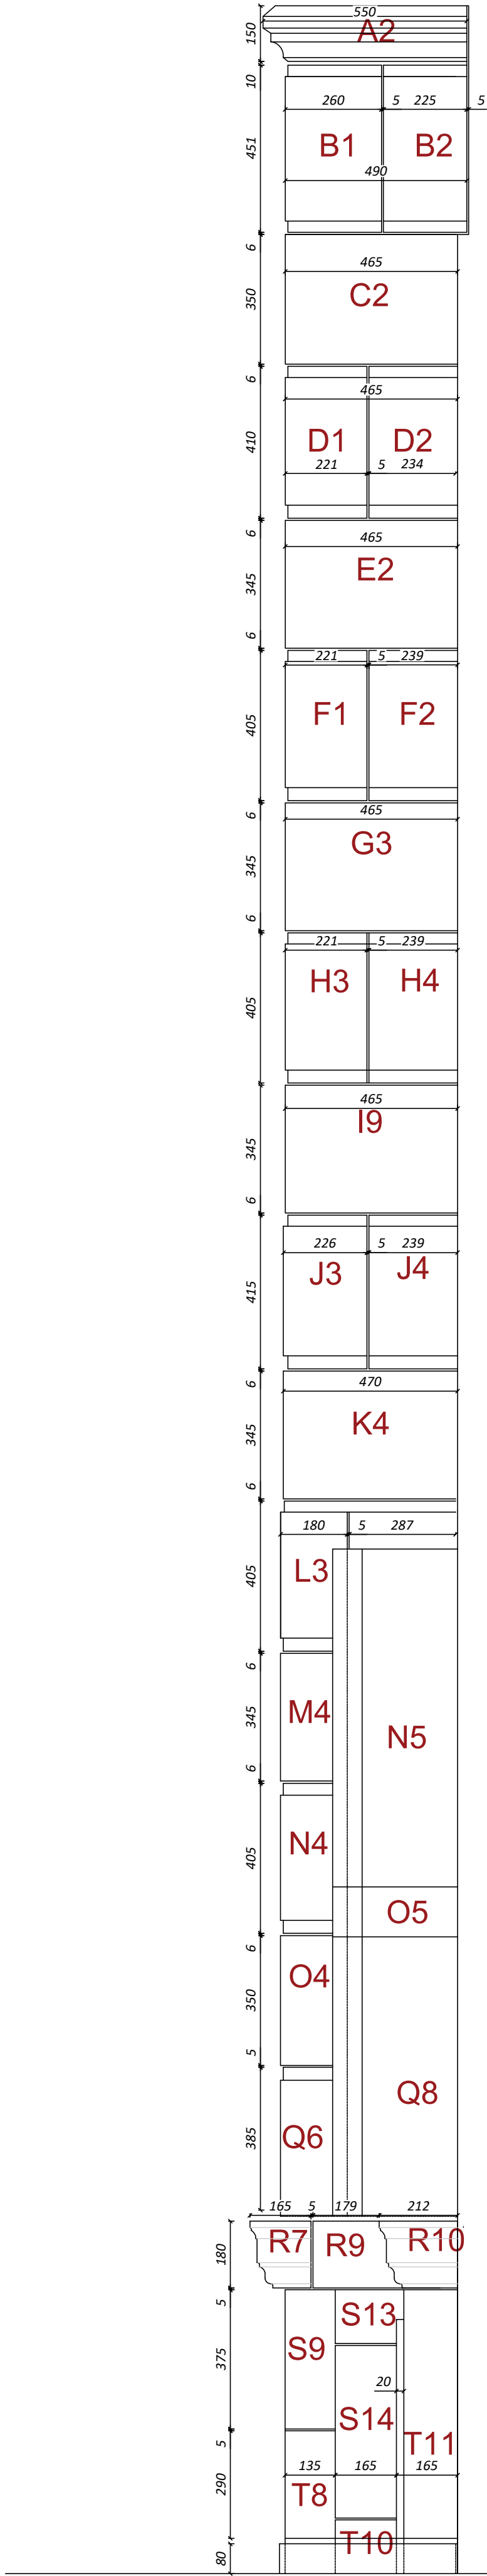

South Elevation

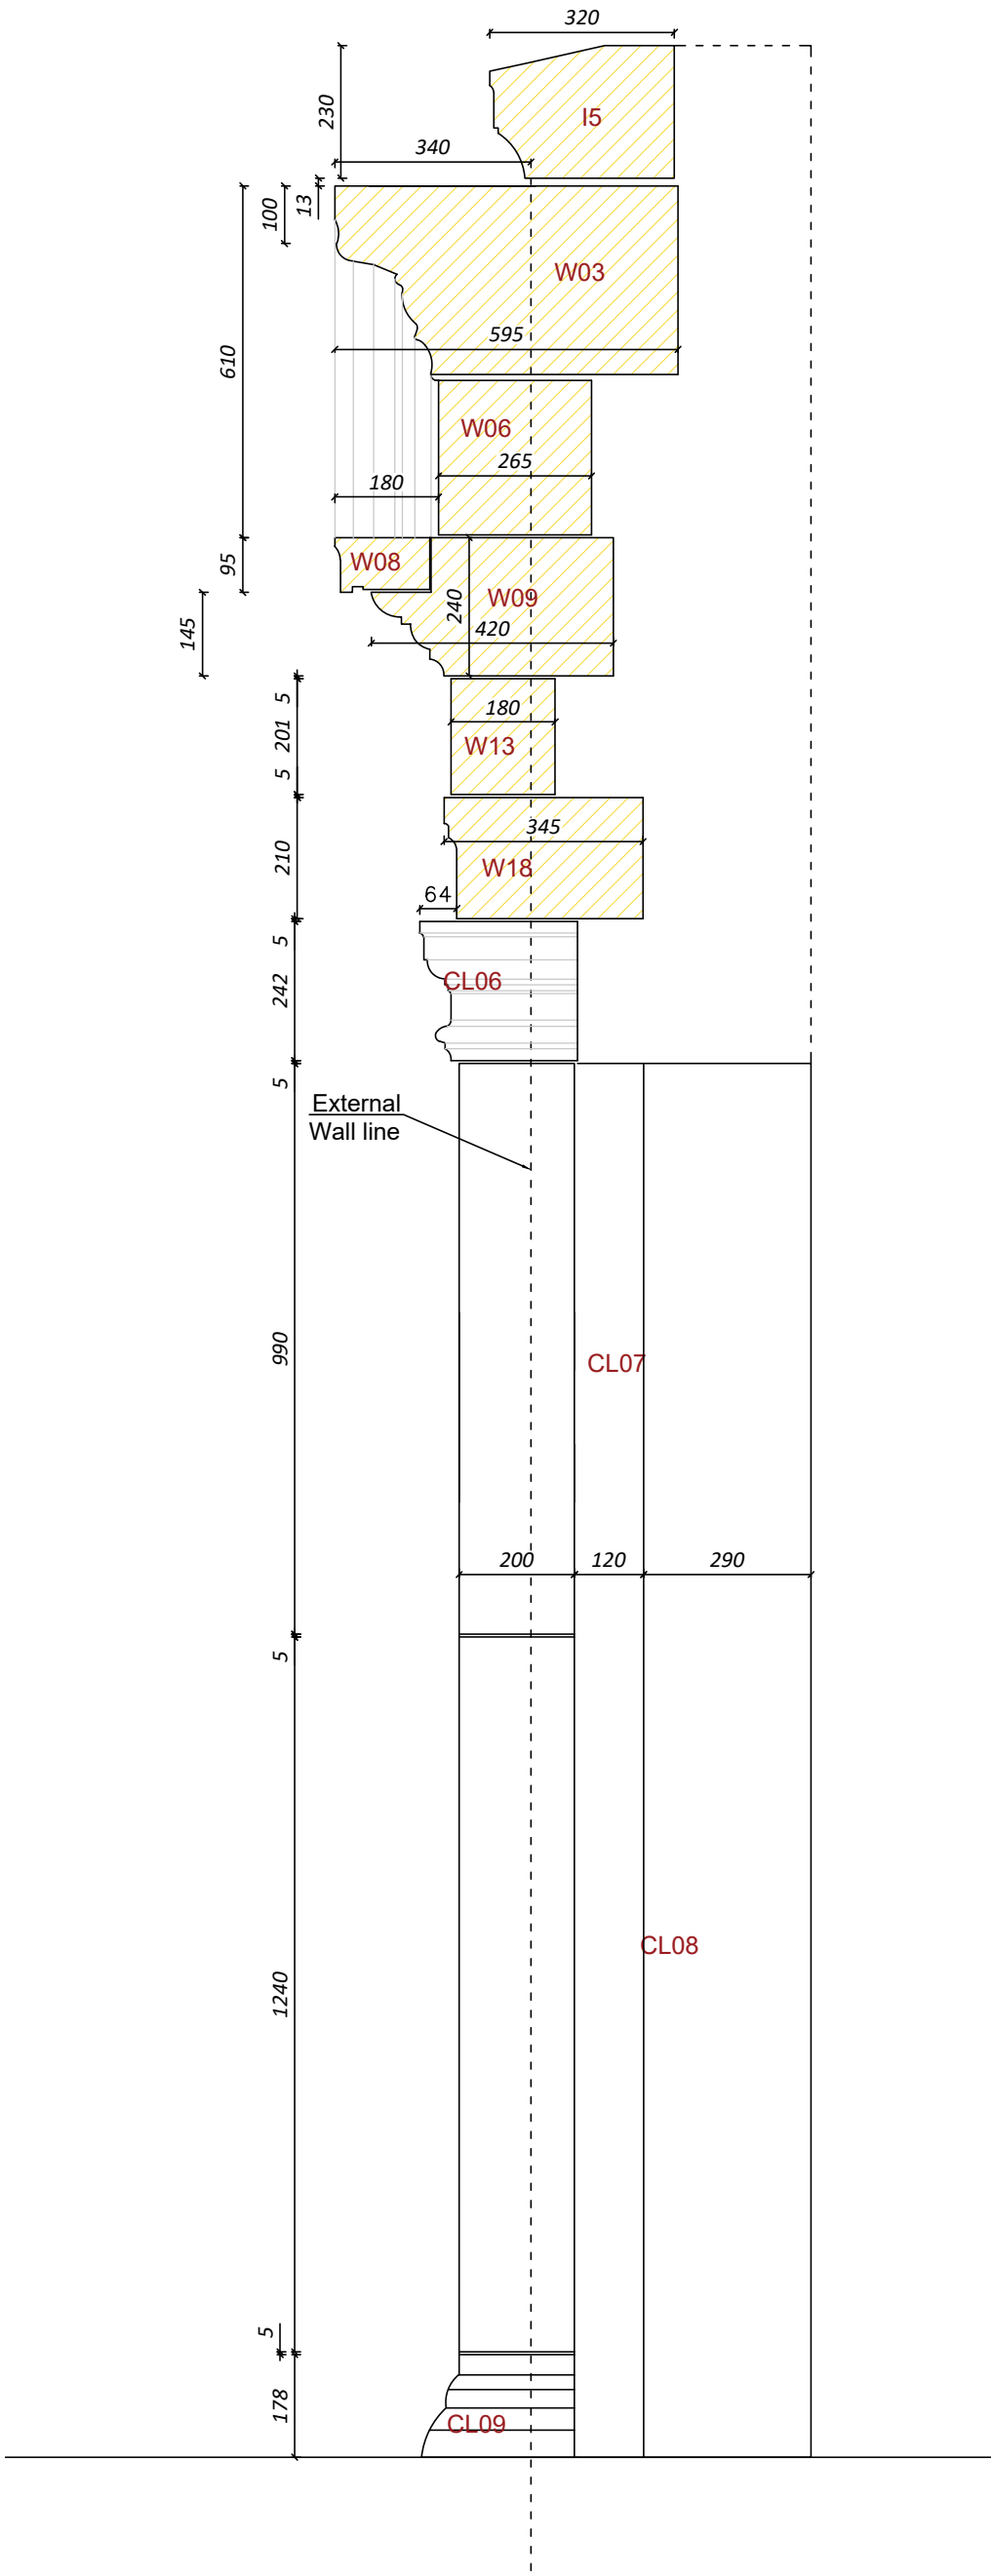

Section AA

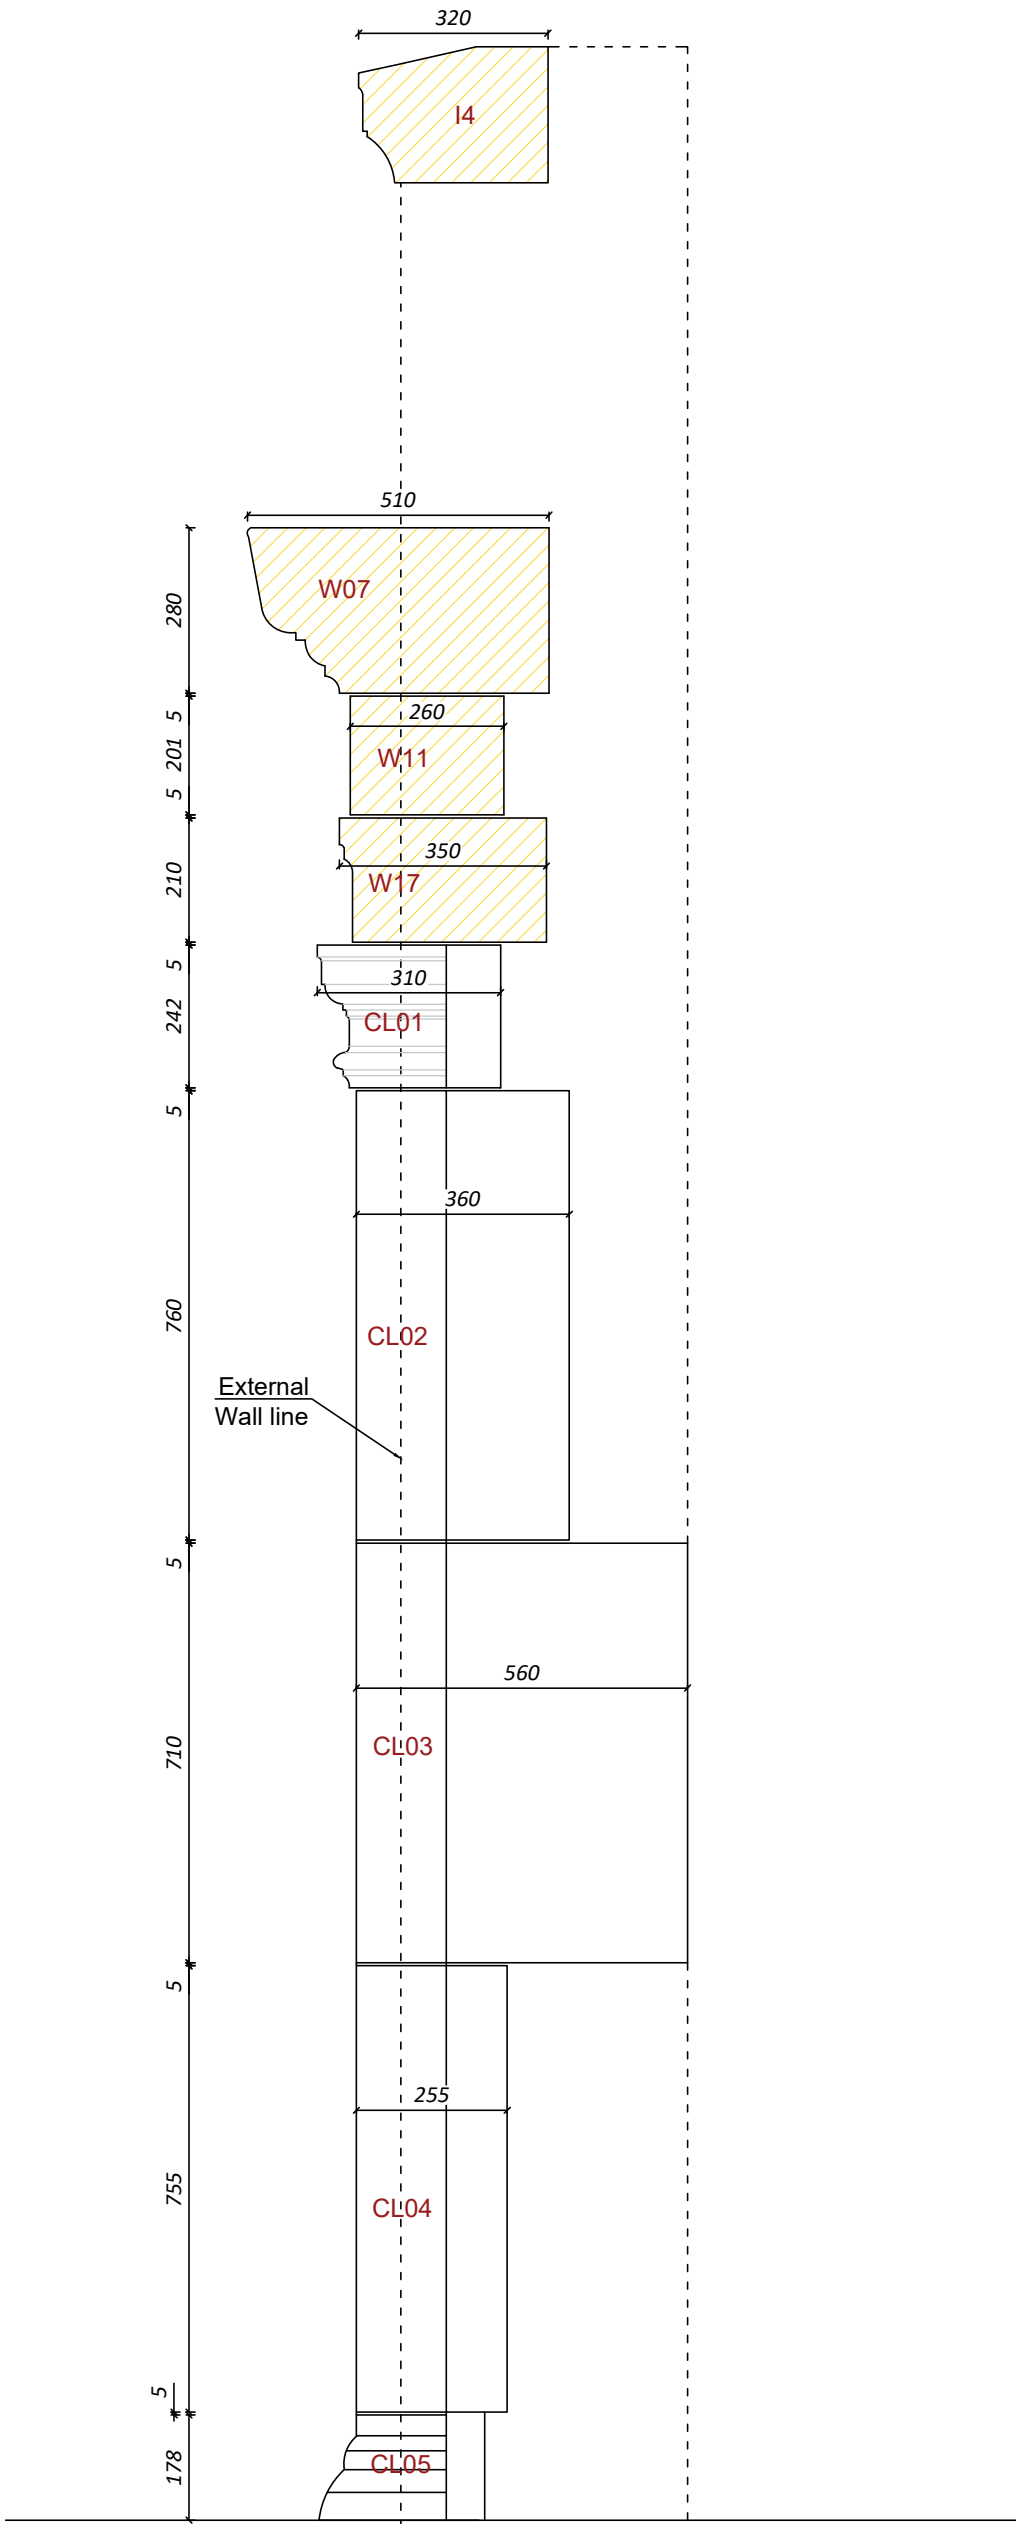

Section BB

NOTES

- 1. No dimensions to be scaled from this drawing.
- 2. All dimensions to be checked on site.
- 3. The designer must be notified where any discrepancy occurs between specification and drawing.
- 4. COPYRIGHT: The contents of this drawing may not be reproduced in whole or part without the written permission of Paye Stonework & Restoration Ltd.

Sheet Size – A1

P02 11-03-21	Record Drawing	
P01 25-01-21	For Reference	
REVISIONS		
Architect		
Hawkins/Brown		
Contractor		
Keltbray		
Contract		
256 Gray's Inn Road		
Drawing Title		
North & South elevation and sections		
Date	Scale	
Jan-2021	NA	
Drawn by	Chk'd By	
IG		
Drawing No.	Rev.	
20106-02	P02	

PAYE
Stonework & Restoration
Stationmasters House, Nottingham Station Approach,
London, SE9 4EL
Website: www.payestone.net Email: info@payestone.net
tel: 020 8857 9111

NOTES

1. No dimensions to be scaled from this drawing.

2. All dimensions to be checked on site.

3. The designer must be notified where any discrepancy occurs between specification and drawing.

4. COPYRIGHT: The contents of this drawing may not be reproduced in whole or part without the written permission of Paye Stonework & Restoration Ltd.

Sheet Size – A1

P02 11-03-21 Record Drawing

REVISIONS

Architect

Hawkins/Brown

Contractor

Keltbray

Contract


256 Gray's Inn Road

Drawing Title









Plan courses A to I


Date	Scale
MAR-2021	NA
Drawn by	Chk'd By
IG	

Drawing No.	Rev.
20106-03	P01

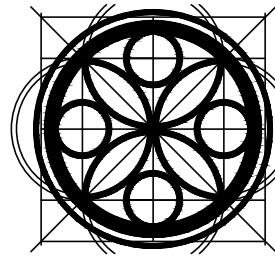

PAYE
Stonework & Restoration
Stationmasters House, Nottingham Station Approach,
London, SE9 4EL
Website: www.payestone.net Email: info@payestone.net
tel: 020 8857 9111

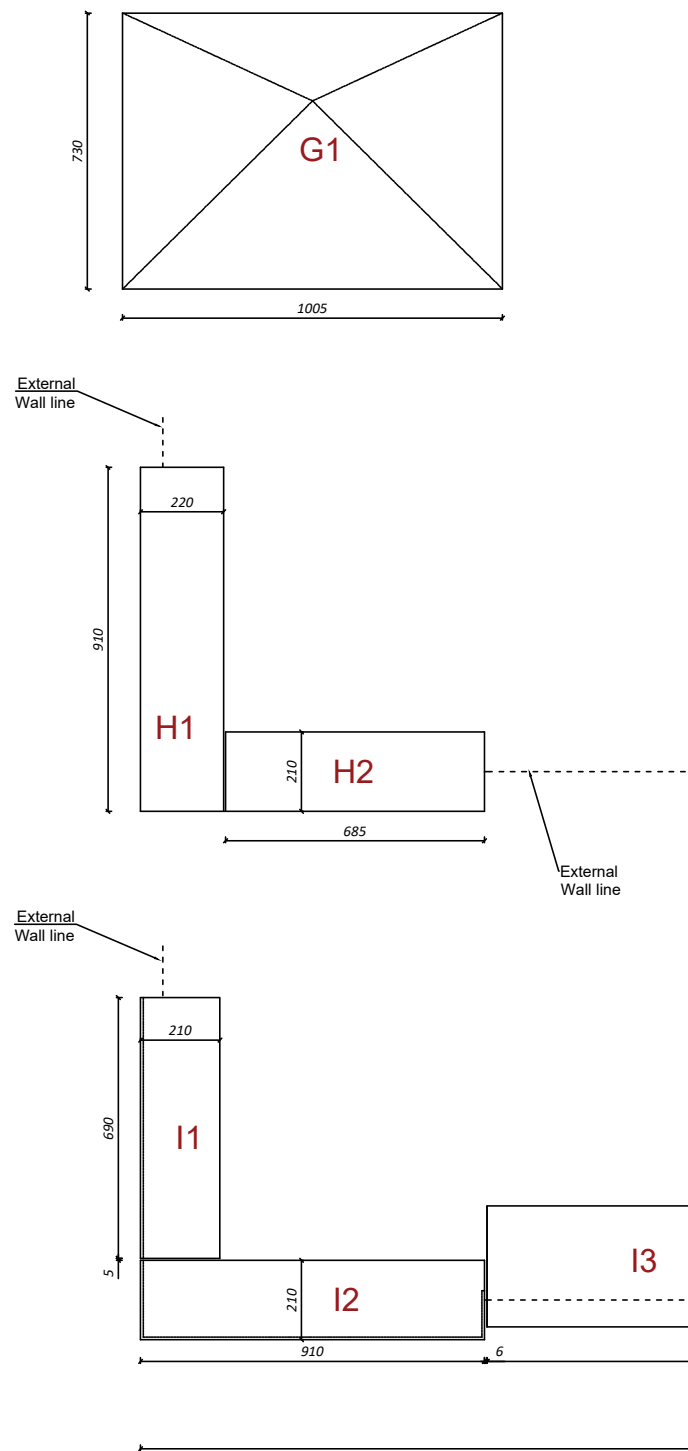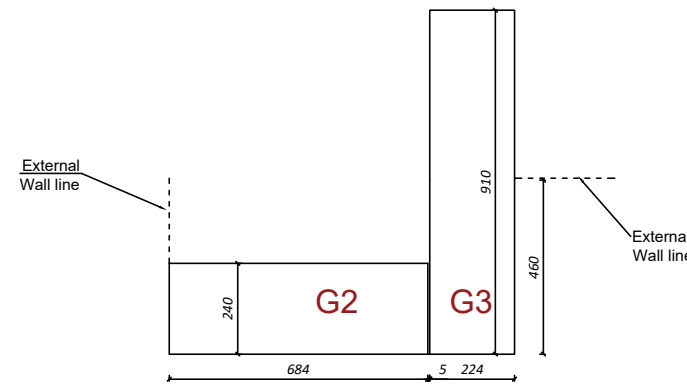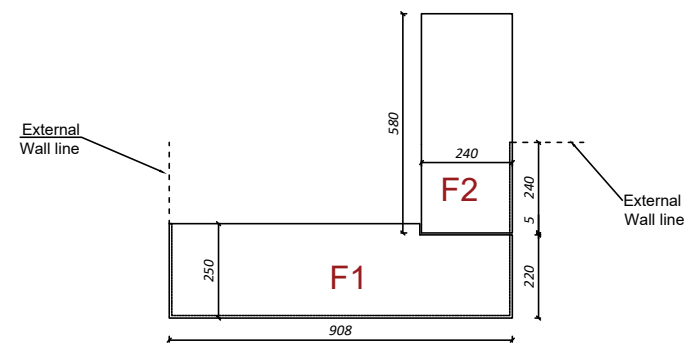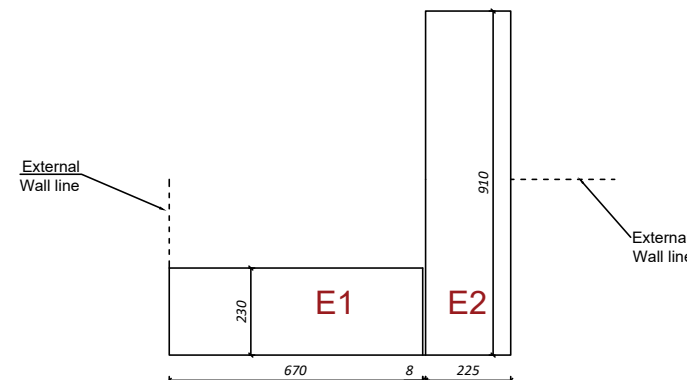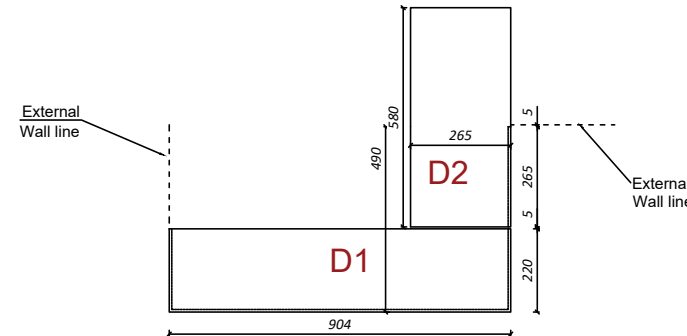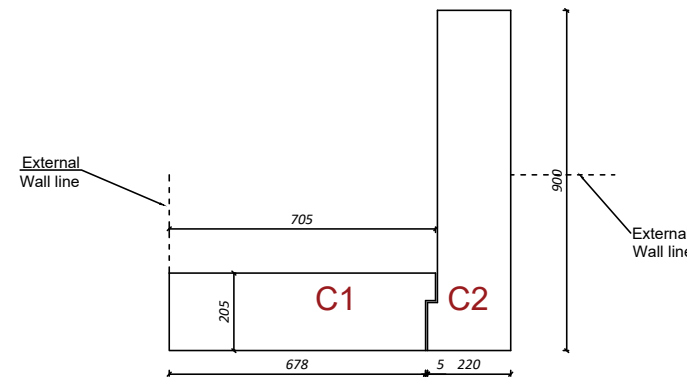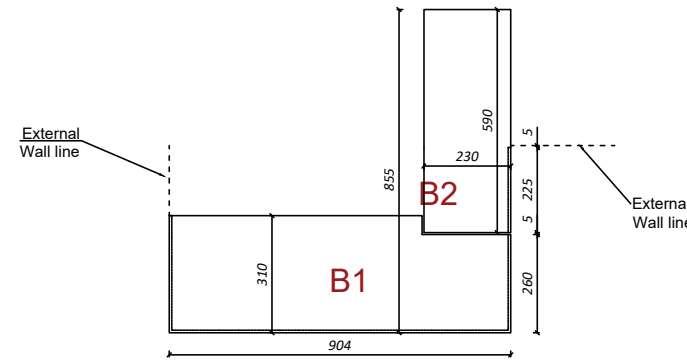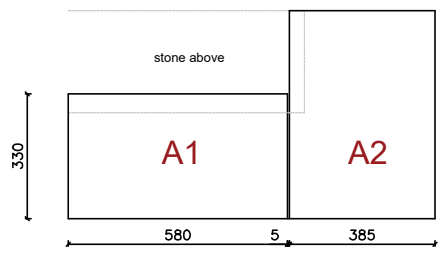

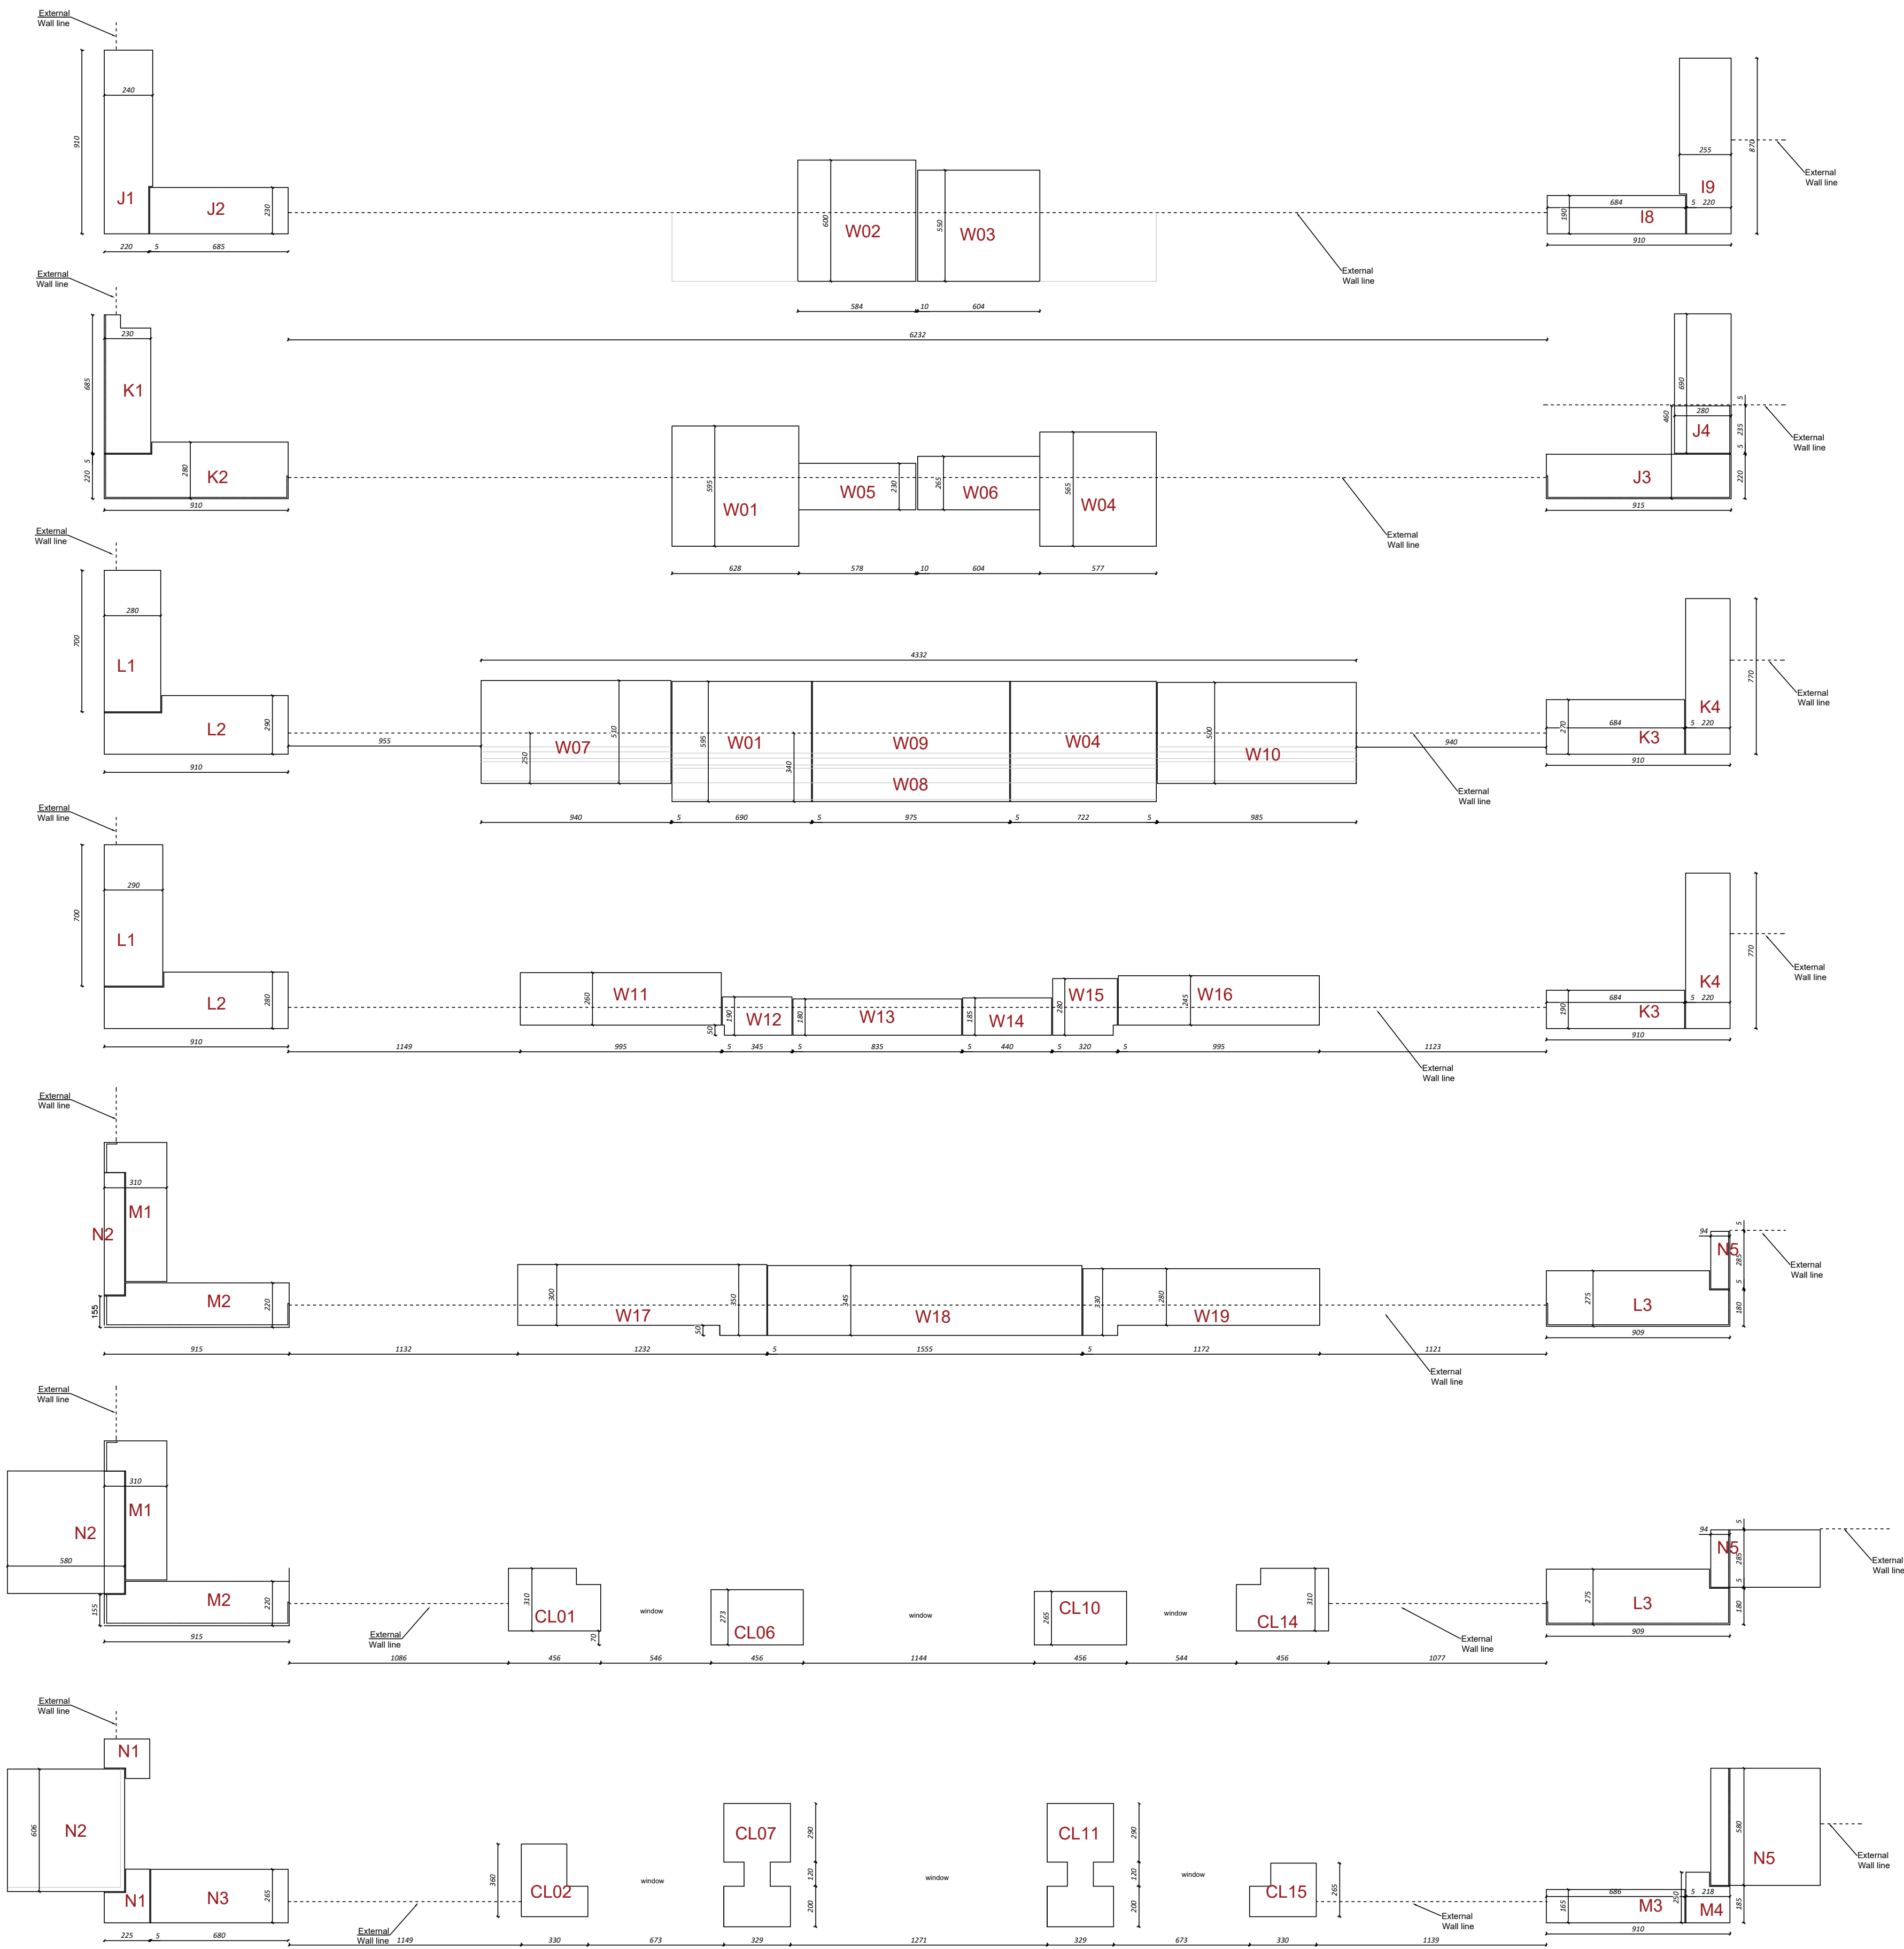

NOTES

1. No dimensions to be scaled from this drawing.
2. All dimensions to be checked on site.
3. The designer must be notified where any discrepancy occurs between specification and drawing.
4. COPYRIGHT: The contents of this drawing may not be reproduced in whole or part without the written permission of Paye Stonework & Restoration Ltd.

Sheet Size – A1

P01 11-03-21 Record Drawing

REVISIONS

Architect
Hawkins/Brown

Contractor
Keltbray

Contract
256 Gray's Inn Road

Drawing Title
Plan courses I to N

Date
MAR-2021

Scale
NA

Drawn by
IG

Chk'd By

Drawing No.
20106-04

Rev.
P01



