




Disclaimer
Do not scale from this drawing. Check all dimensions on site before fabrication or setting out. This document is copyright and may not be reproduced without permission of the owner.

Notes
Not all revision notes appear on all sheets. Refer to tagged clouds.

Revision RD01 - 26/10/22
A Roof plant and access updated to reflect latest design

| | | | |
|------|------------------|------------|-----|
| RD01 | Record Drawing | 26/10/2022 | Apt |
| 00 | Record Drawing | 31/05/2022 | Apt |
| Rev | Reason for Issue | Date | Iss |

Consultants
Structural Engineer: Davies Maguire
MEP Engineer: GDM Partnership
Project Manager: CBRE

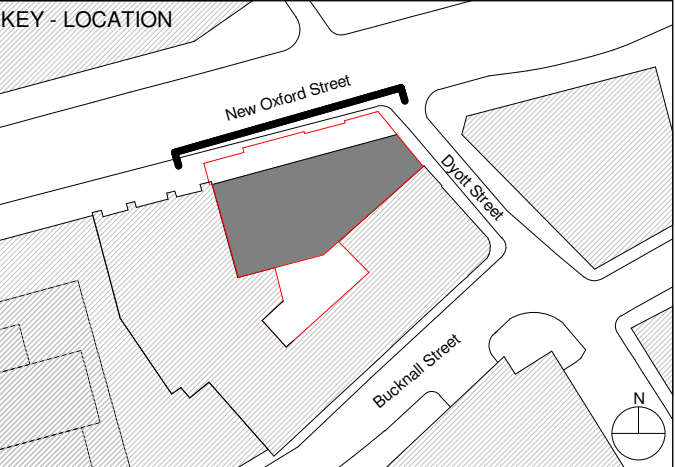

Apt

235 St John Street London EC1V 4NG www.aplondon.com

Client
Royal London Asset Management

Project
63-69 New Oxford Street

Drawing Title
**General Arrangement
North Elevation**

| | | |
|--------------|----------|-----------|
| Scale | Drawn By | Issued By |
| 1 : 100 @ A1 | Apt | Apt |

| Record Drawing | | |
|----------------|-------------|----------|
| Project No. | Drawing No. | Revision |
| 18013 | A_10_301 | RD01 |