


Disclaimer
Do not scale from this drawing. Check all dimensions on site before fabrication or setting out. This document is copyright and may not be reproduced without permission of the owner.

Notes
Not all revision notes appear on all sheets. Refer to tagged clouds.

Revision RD01 - 26/10/22


A Roof plant and access updated to reflect latest design

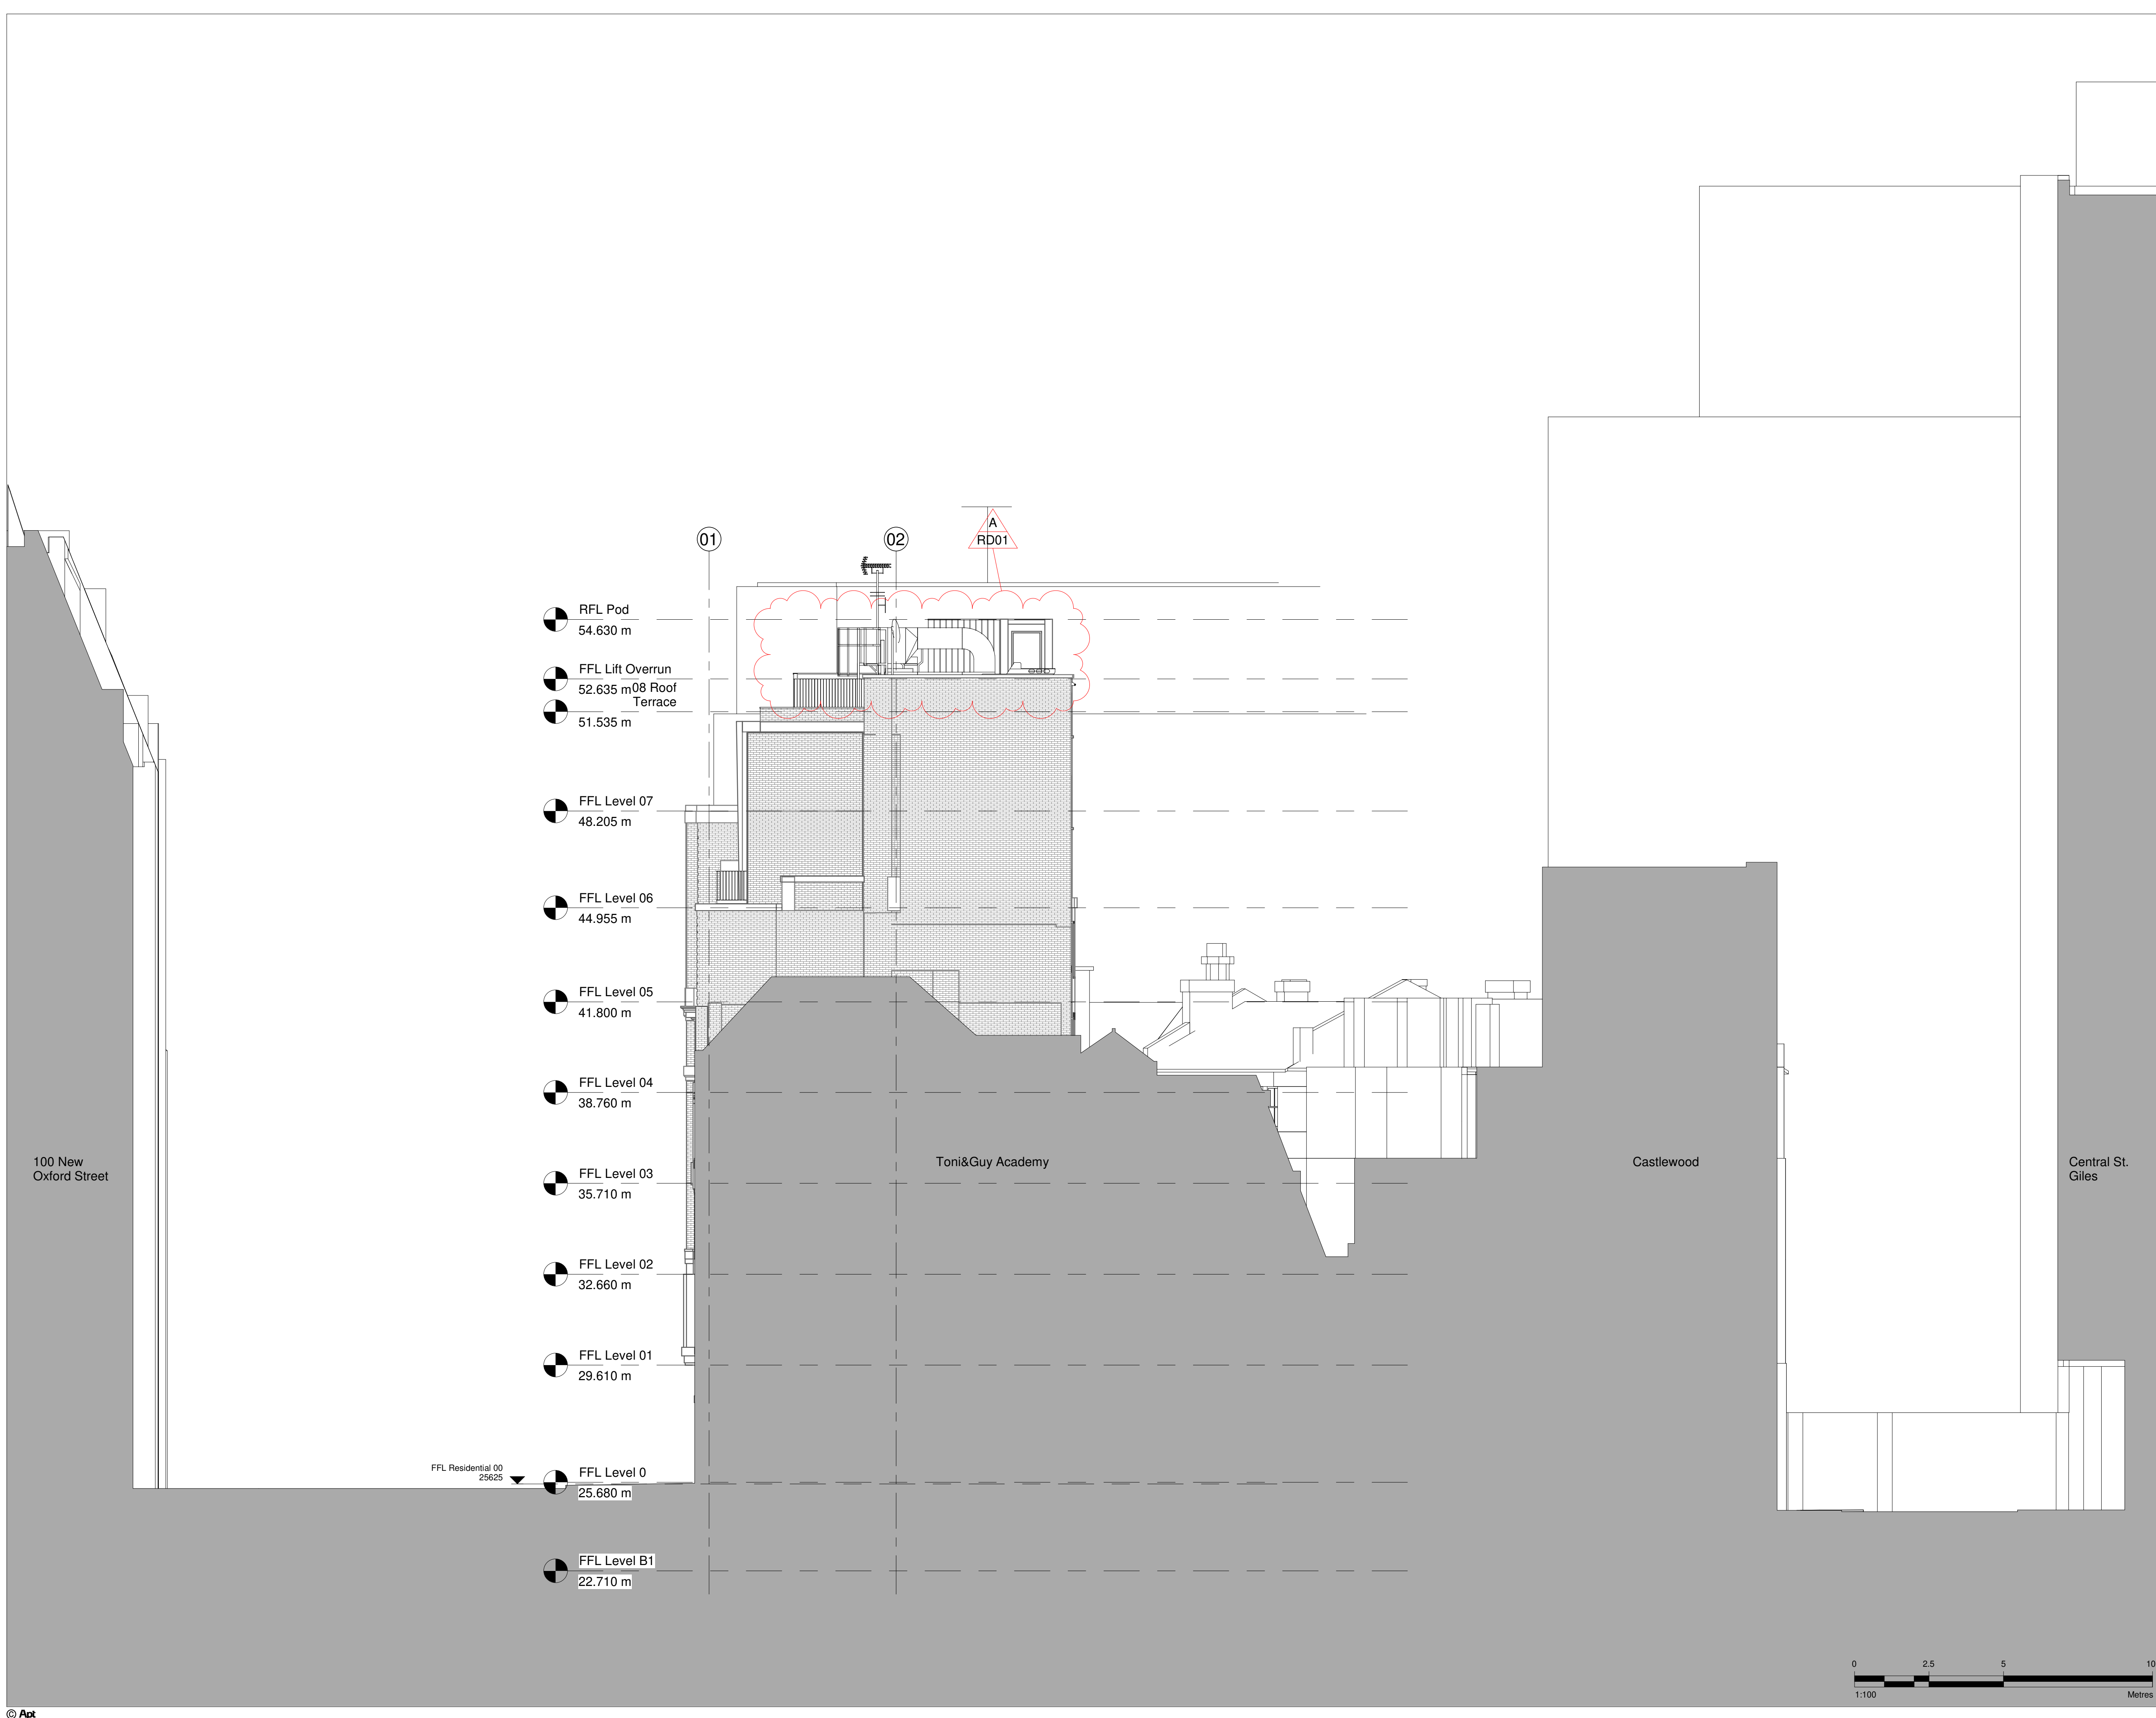

- RFL Pod
54.630 m
- FFL Lift Overrun
52.635 m
- 08 Roof Terrace
51.535 m
- FFL Level 07
48.205 m
- FFL Level 06
44.955 m
- FFL Level 05
41.800 m
- FFL Level 04
38.760 m
- FFL Level 03
35.710 m
- FFL Level 02
32.660 m
- FFL Level 01
29.610 m
- FFL Residential 00
25625
- FFL Level 0
25.680 m
- FFL Level B1
22.710 m

Rev	Reason for Issue	Date	Iss
RD01	Record Drawing	26/10/2022	Apt
00	Record Drawing	31/05/2022	Apt

Consultants
Structural Engineer: Davies Maguire
MEP Engineer: GDM Partnership
Project Manager: CBRE

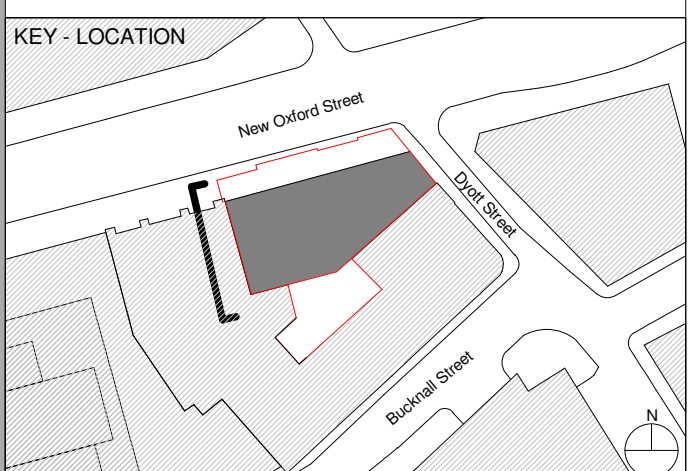

235 St John Street London EC1V 4NG www.aplondon.com

Client
Royal London Asset Management

Project
63-69 New Oxford Street

Drawing Title
General Arrangement
West Elevation

Scale	Drawn By	Issued By
1 : 100 @ A1	Apt	Apt

Record Drawing		
Project No.	Drawing No.	Revision
18013	A_10_304	RD01

