


Original Condition



As Built

revisions
P1

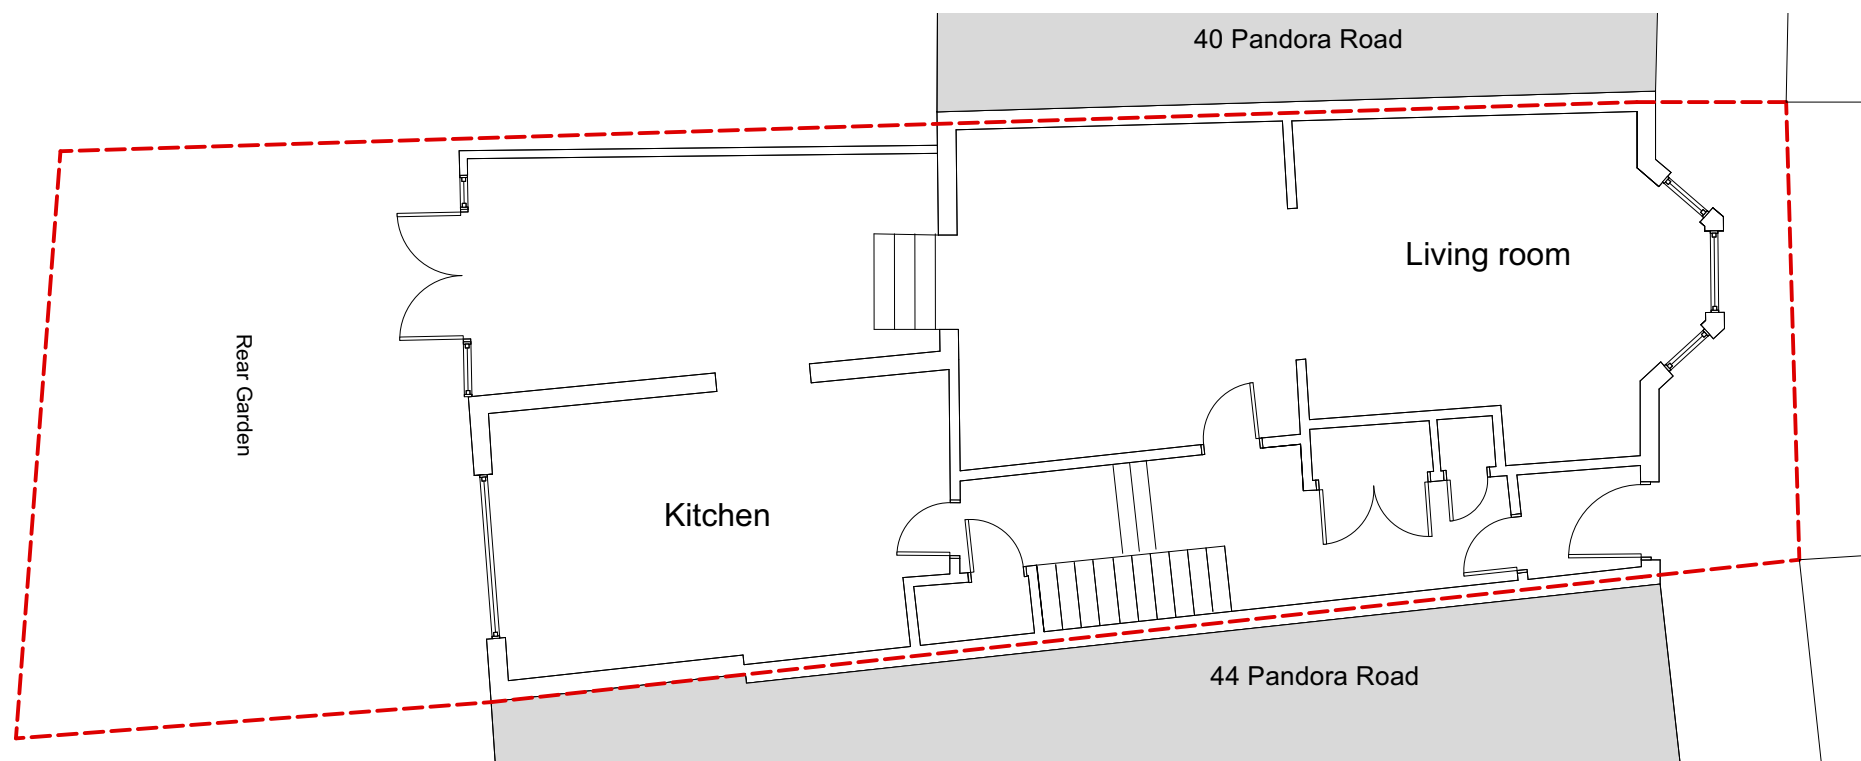

To be read in conjunction with all other information
Do not scale off this drawing.

Mulroy

020 4530 9400
www.mulroyarchitects.com

project 42 Pandora Road, London NW6 1TR			
for Jeannette & Oliver Boulind			
title Original Condition & As Built Ground Floor Plan			
status RIBA Stage 3			
scale 1:100	size A3	drawing number 21057-3-110	P1