




Original Condition Floor Plan level 1.5

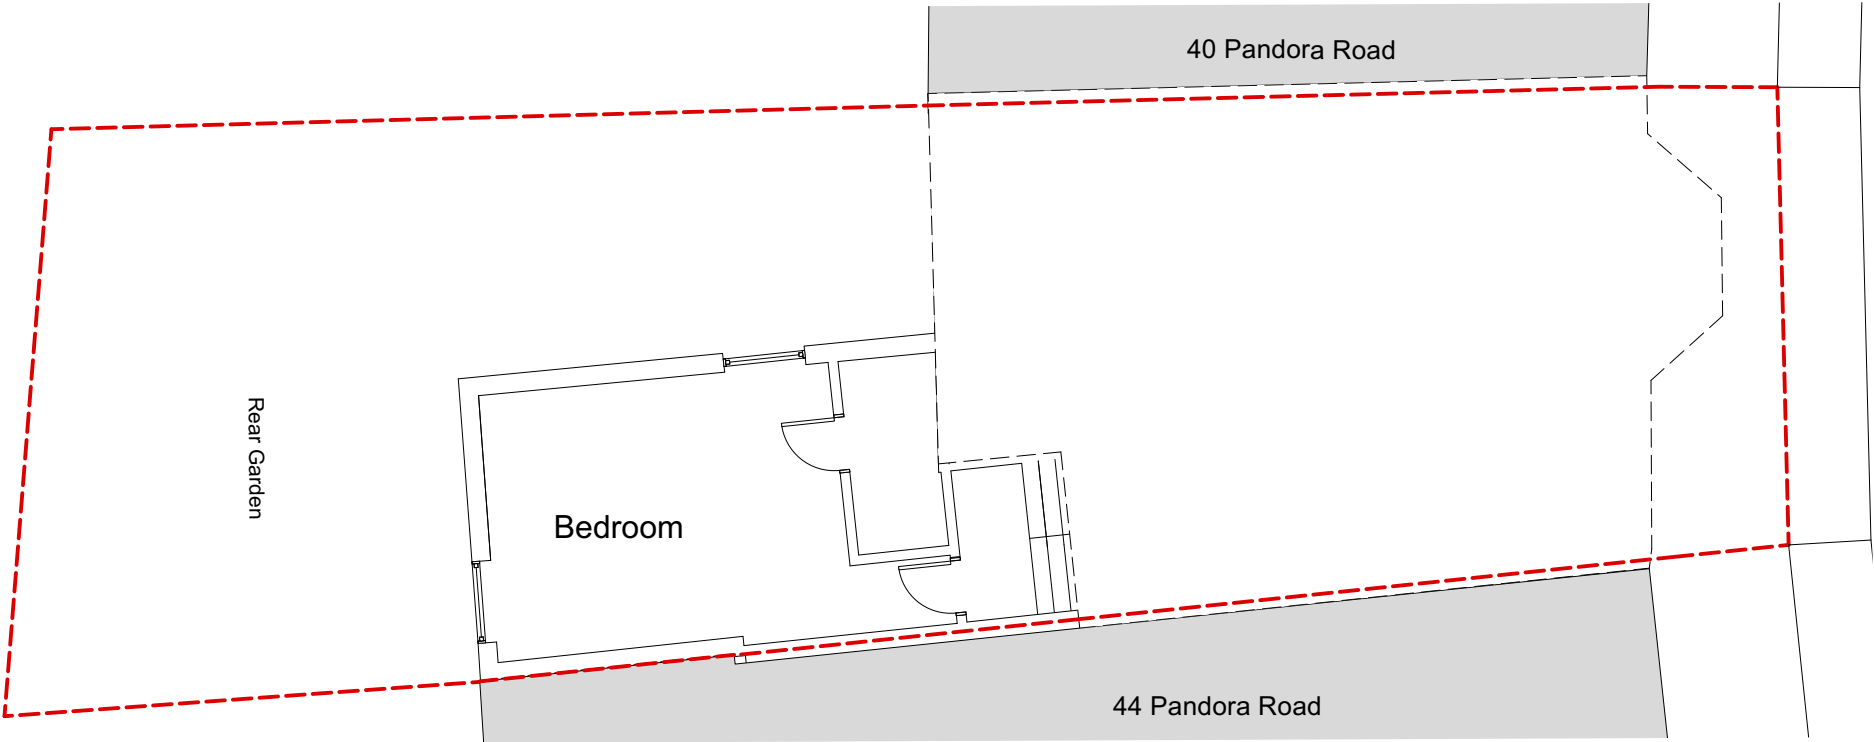

As built Floor Plan level 1.5

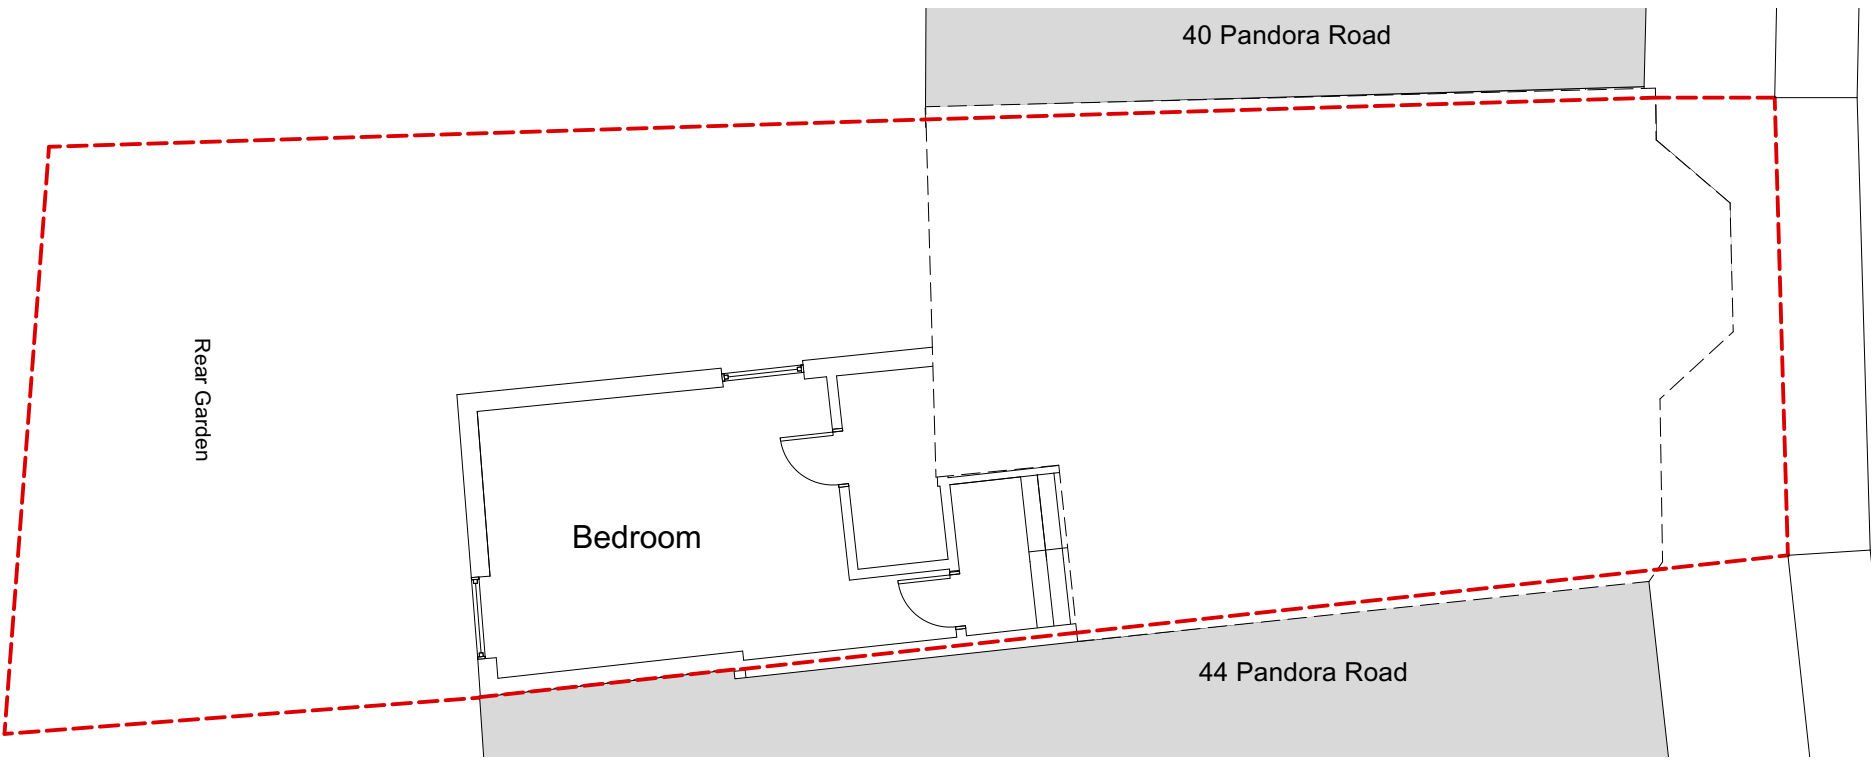

 revisions
P1



To be read in conjunction with all other information
Do not scale off this drawing.

Mulroy
020 4530 9400
www.mulroyarchitects.com

project 42 Pandora Road, London NW6 1TR			
for Jeannette & Oliver Boulind			
title Original Condition & As Built Floor Plan Level 1.5			
status RIBA Stage 3			
scale 1:100	size A3	drawing number 21057-3-112	P1