




Original Condition Floor Plan level 2

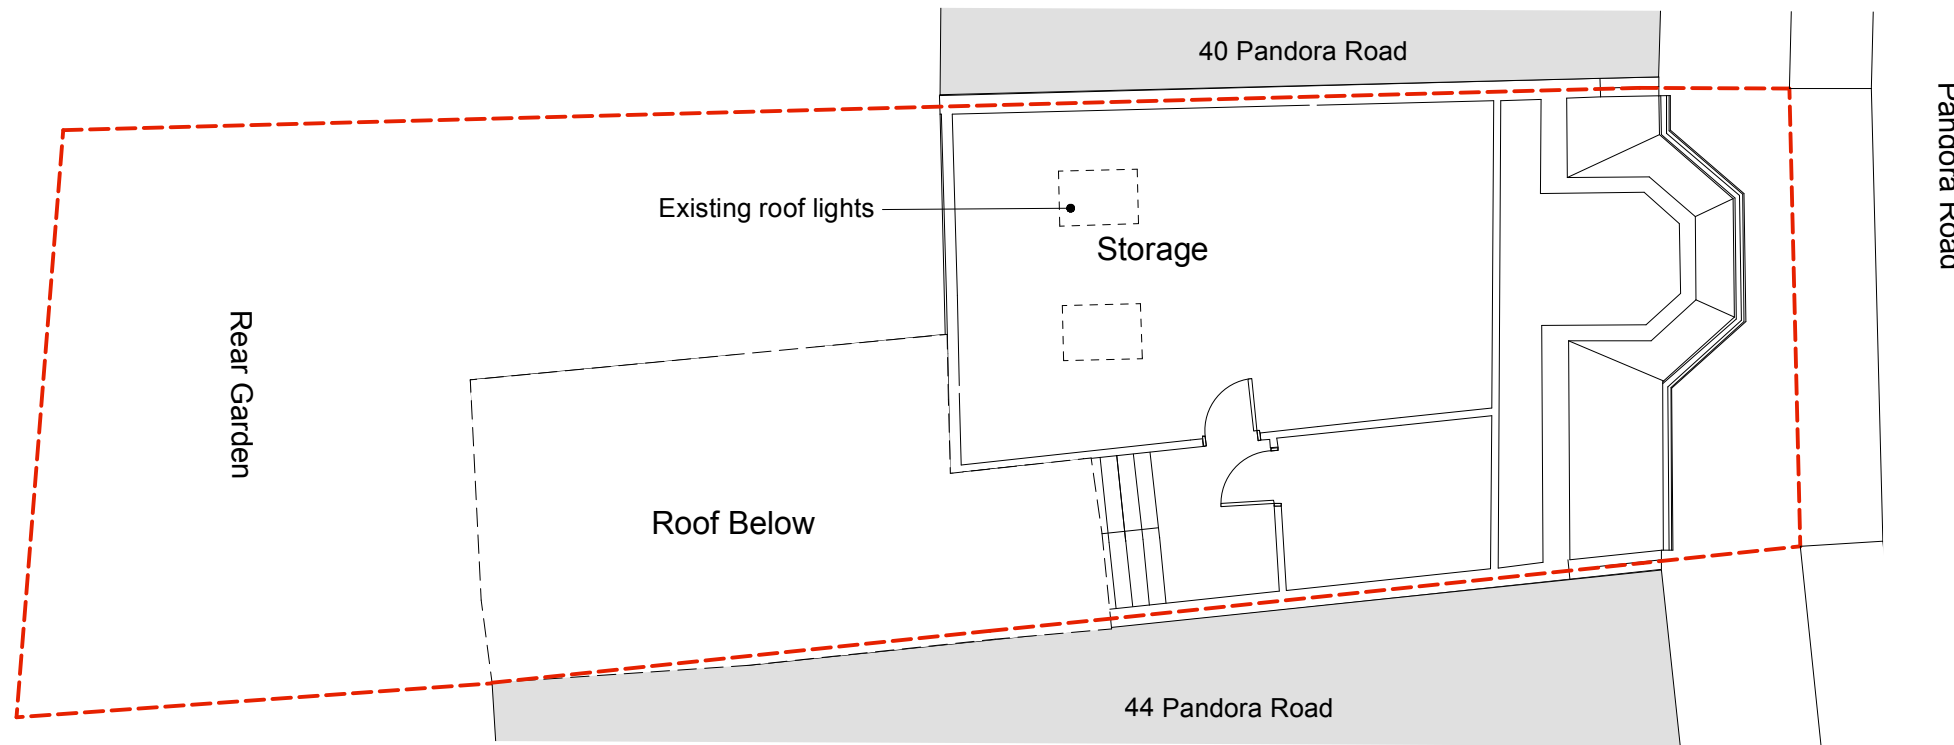

As built Floor Plan level 2

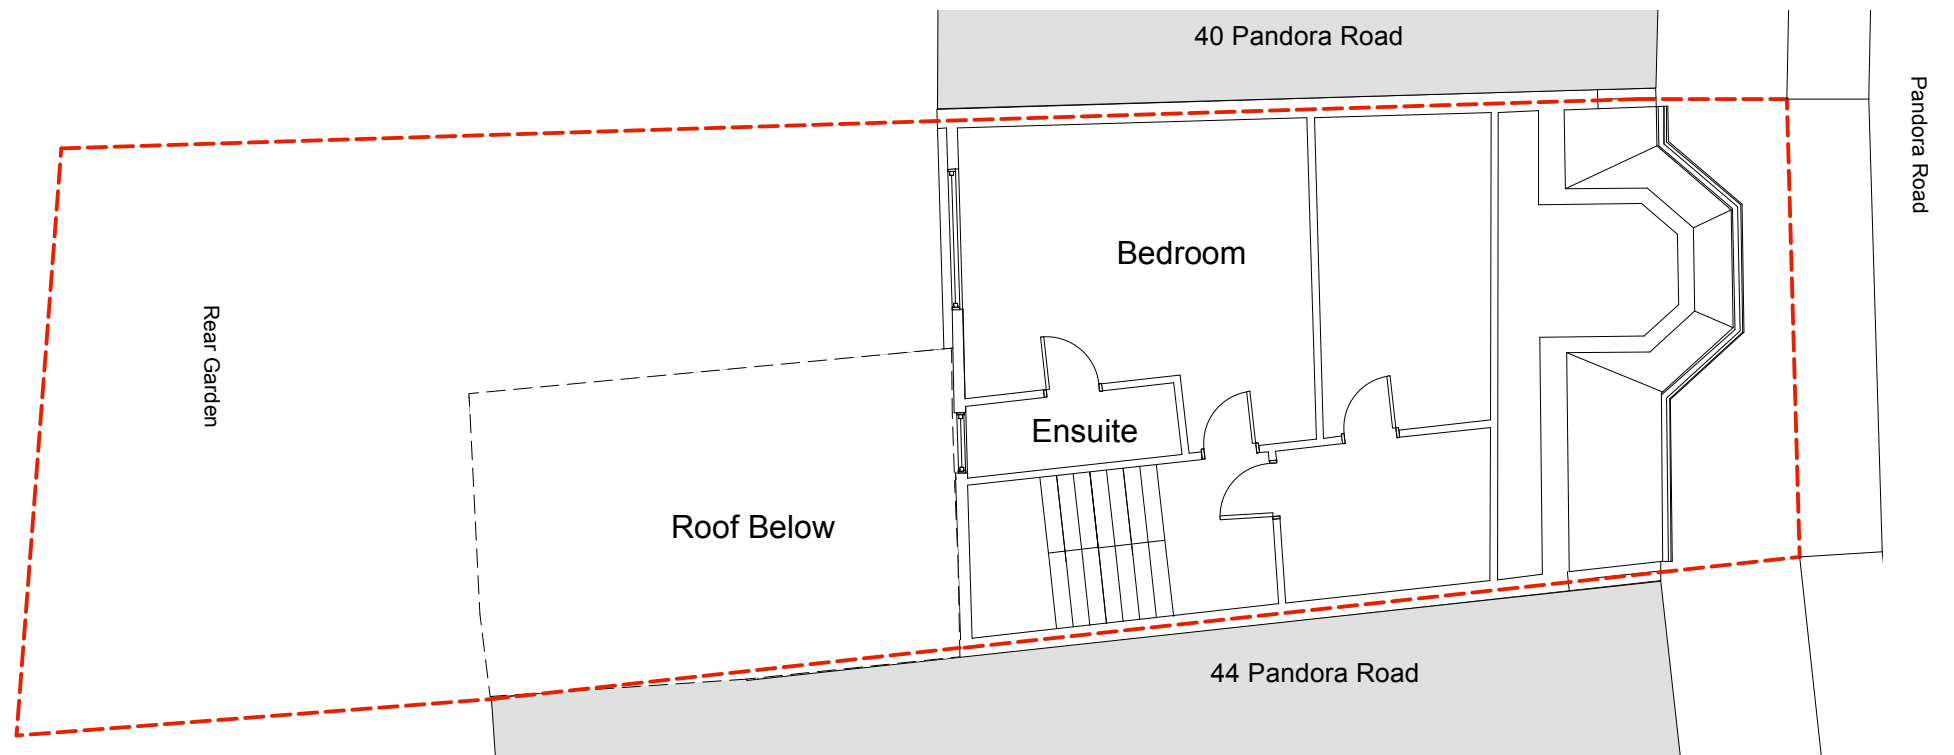

revisions  
P1

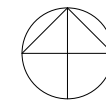

To be read in conjunction with all other information  
Do not scale off this drawing.

**Mulroy**

020 4530 9400  
www.mulroyarchitects.com

project 42 Pandora Road, London NW6 1TR  
for Jeannette & Oliver Boulind  
title Original Condition & As Built Floor Plan Level 2

status RIBA Stage 3

scale 1:100	size A3	drawing number 21057-3-113	P1
----------------	------------	-------------------------------	----