




Original Condition Roof Plan

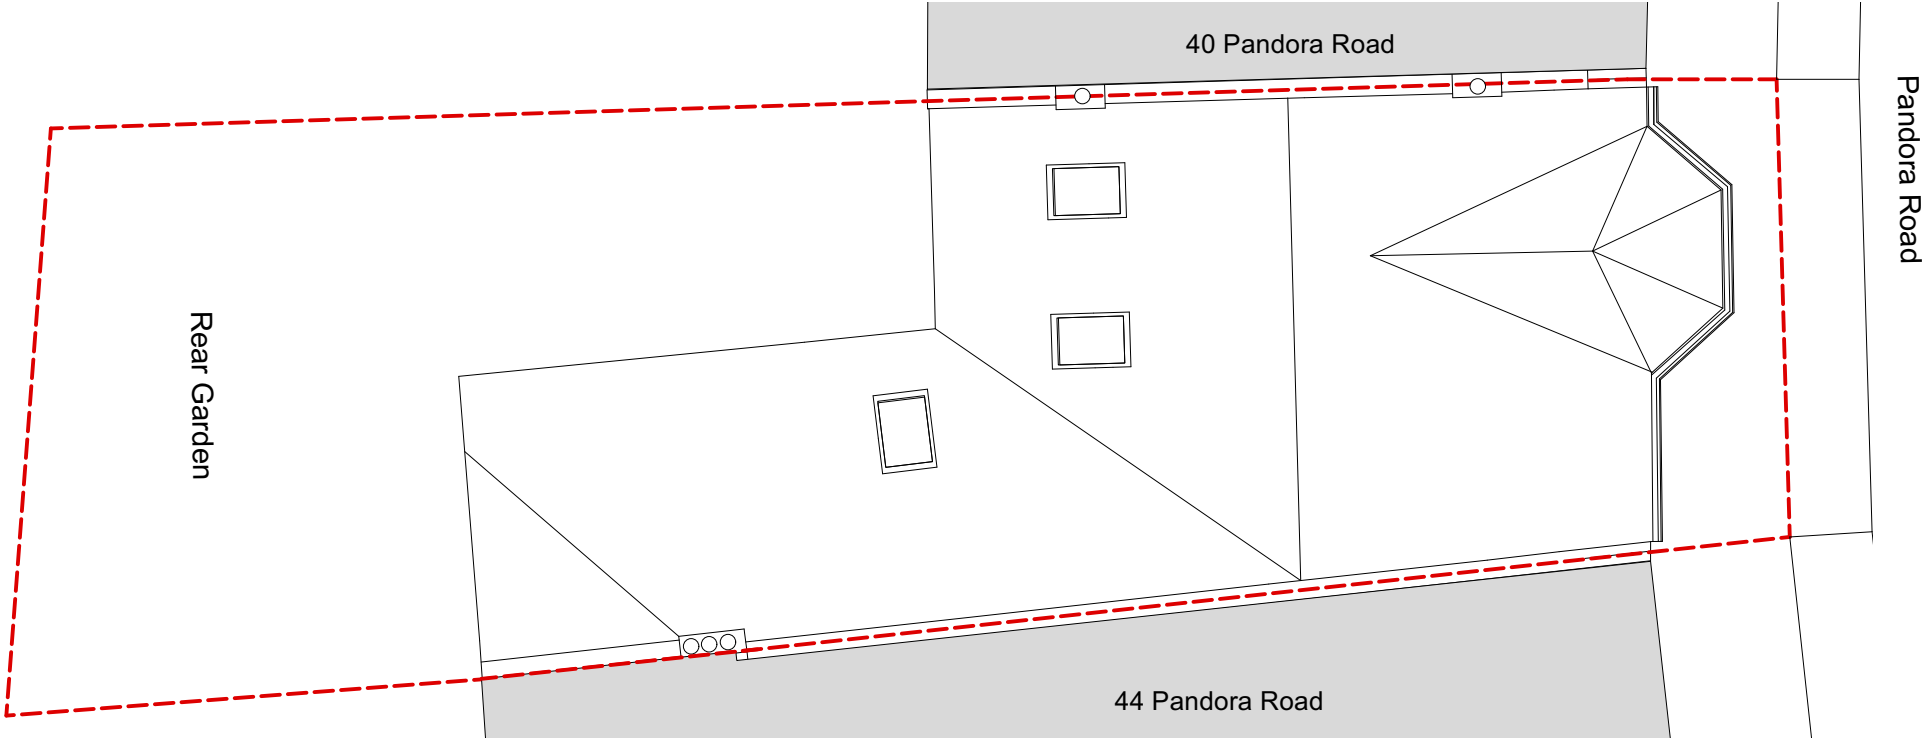

As built Roof Plan

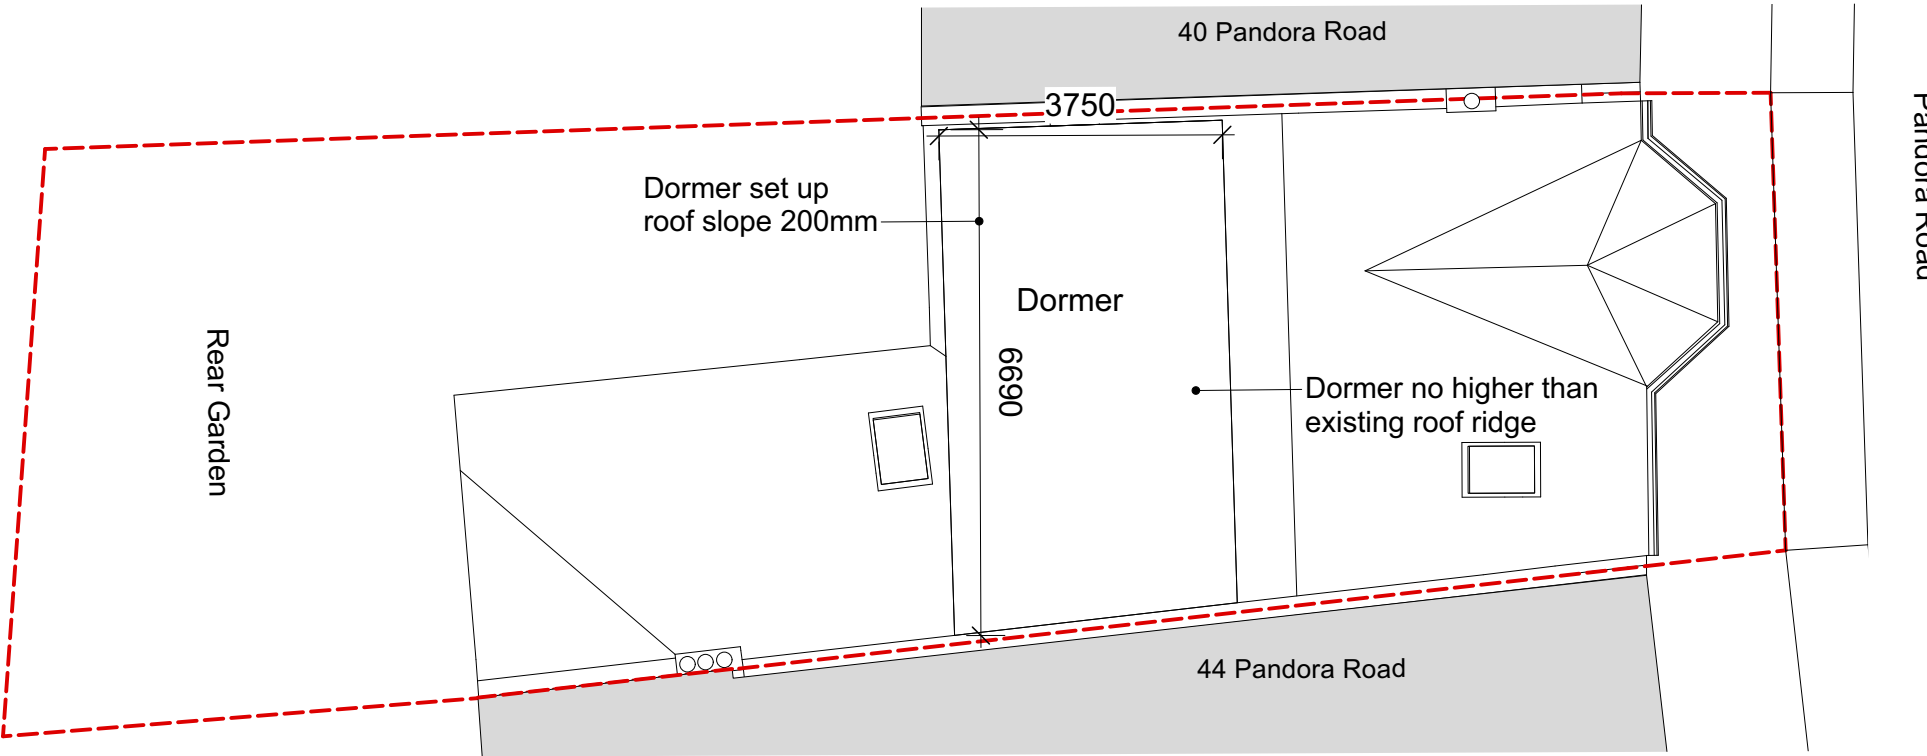

revisions
P1



To be read in conjunction with all other information
Do not scale off this drawing.

Mulroy

020 4530 9400
www.mulroyarchitects.com

project 42 Pandora Road, London NW6 1TR			
for Jeannette & Oliver Boulind			
title Original Condition & As Built Roof Plan			
status RIBA Stage 3			
scale	size	drawing number	
1:100	A3	21057-3-114	P1