



Front Elevation Original Condition

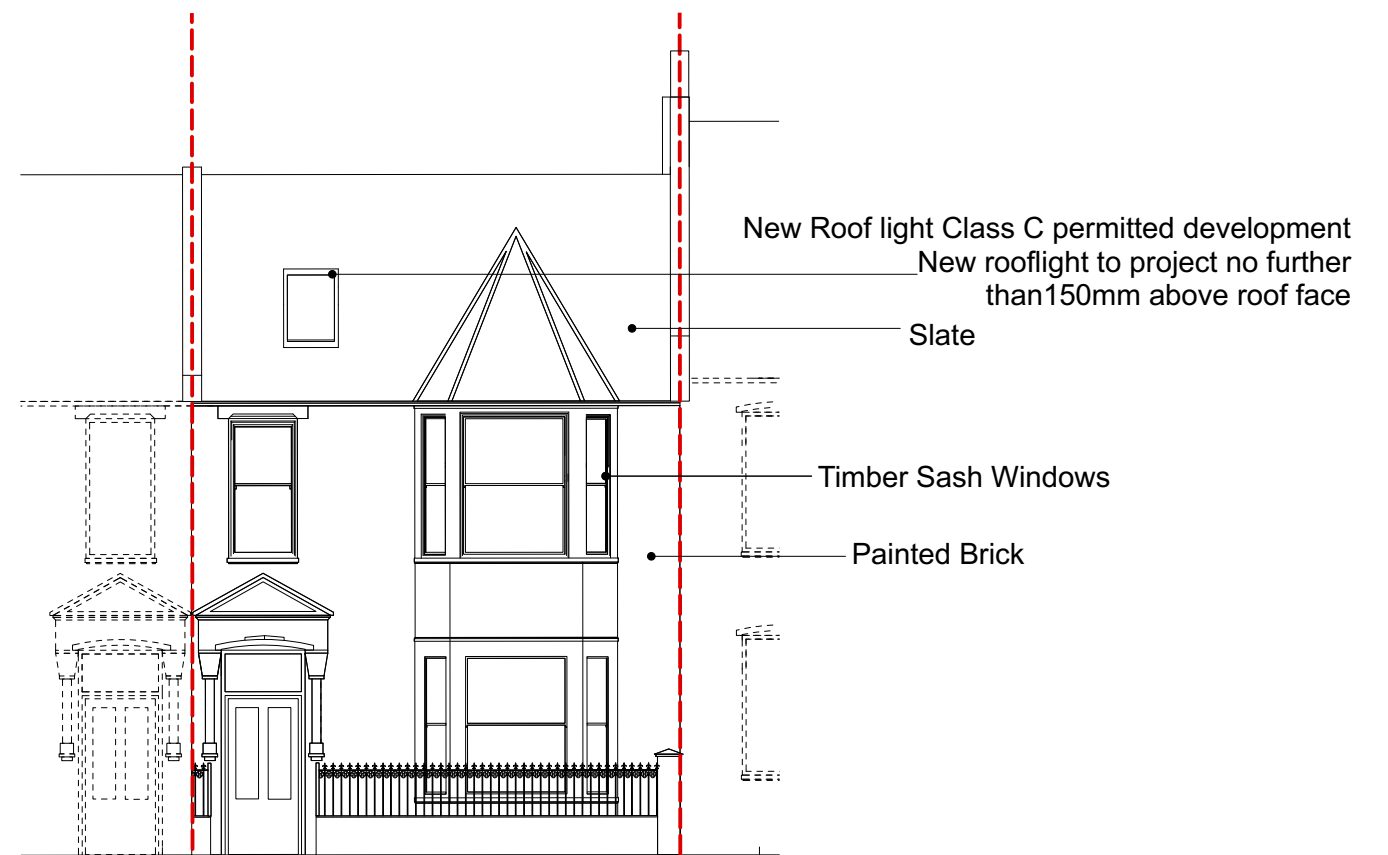

Front Elevation As built

revisions
P1

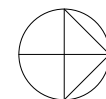

To be read in conjunction with all other information
Do not scale off this drawing.

Mulroy

020 4530 9400
www.mulroyarchitects.com

project 42 Pandora Road, London NW6 1TR
for Jeannette & Oliver Boulind
title Original Condition & As Built Front Elevation

status RIBA Stage 3

scale 1:100	size A3	drawing number 21057-3-130	P1
----------------	------------	-------------------------------	----