

Roof Level  
4305

L03  
4200

L02  
3900


L01  
3500

Main House L00  
3200

New House L00  
3100

New House 01  
3000

Main House 01  
2900

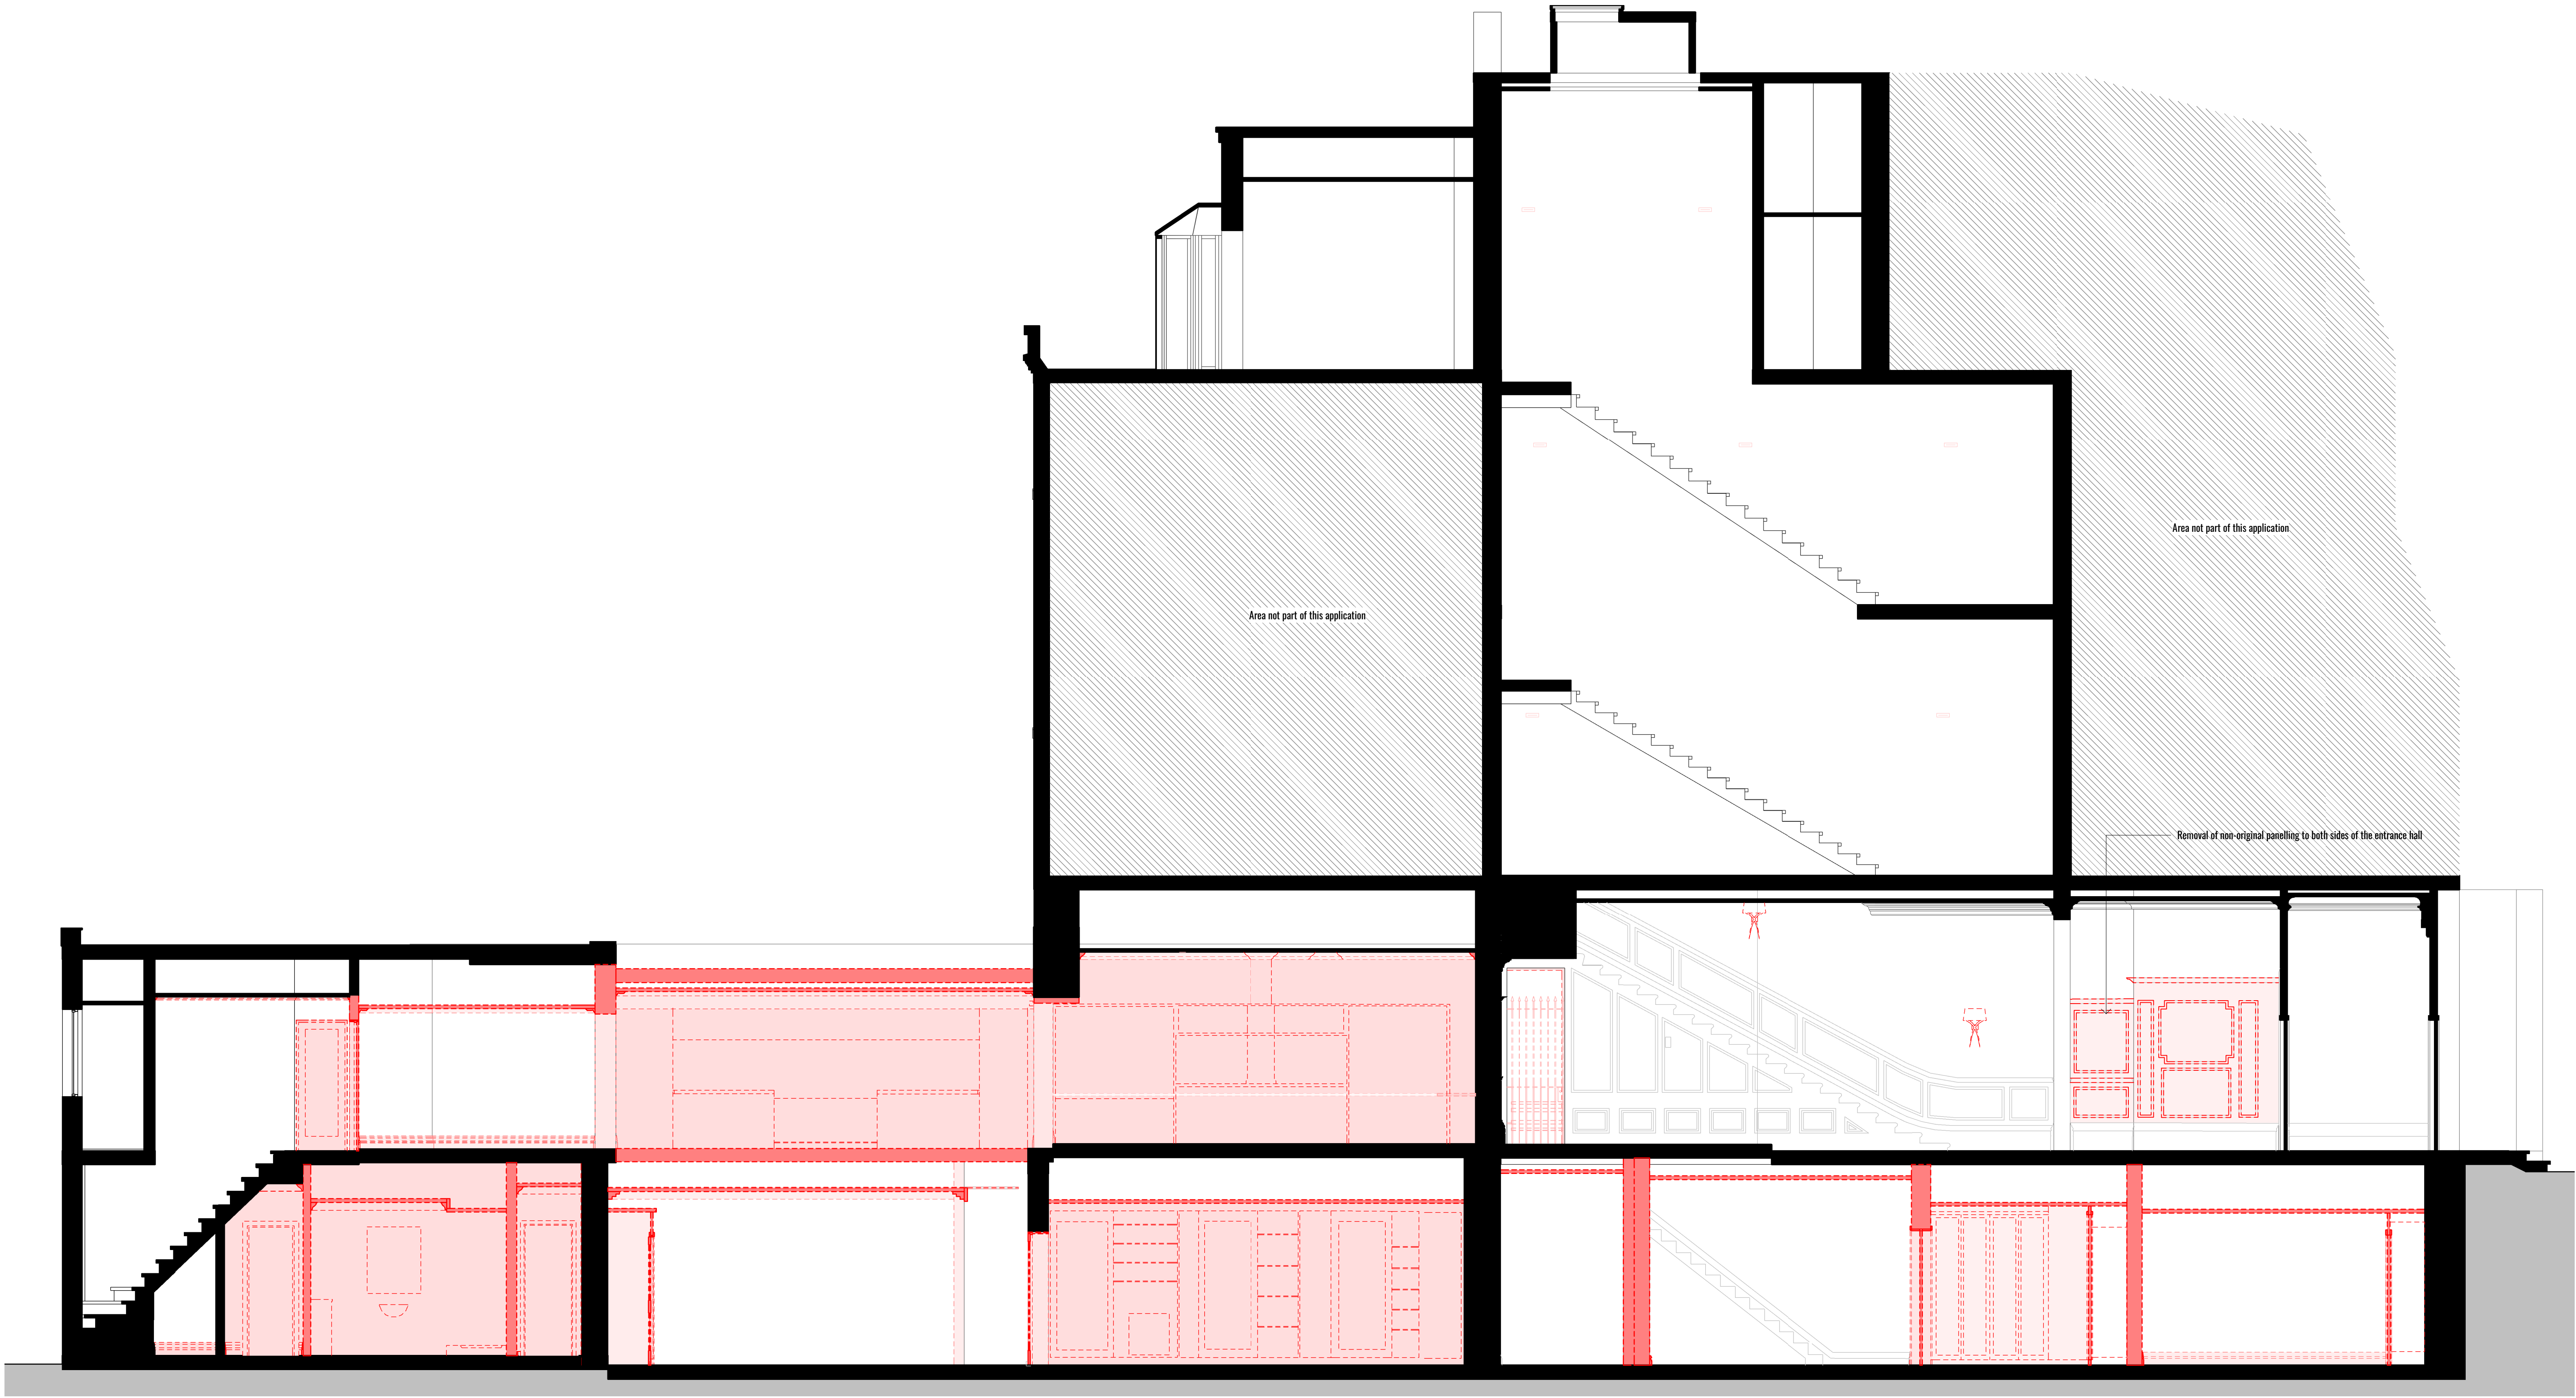

Demolition Section BB

1:50

# DOWEN FARMER ARCHITECTS

Unit 601, Level 6,  
Peckham Levels,  
95A Rye Ln,  
London  
SE15 4ST

T: 020 8058 7997  
W: [www.dowenfarmer.com](http://www.dowenfarmer.com)

Project  
4 CAMBRIDGE GATE

Project address  
4 Cambridge Gate, Regents Park, NW1 4JX

Client  
PRIVATE

Sheet number  
1089 -SC - 3004

Sheet name  
Demolition Section BB

Sheet scale  
1:50 @ A1


Date/time  
06/09/2022 18:03:45

Rev	Description	Date	Issued	Checked
1	Planning Issue	06/09/2022	PB	TF

## KEY

- To be removed
- Floor finishes to be removed
- Floor slab to be removed
- To be removed

Scale Bar: 1:50 @ A1 (Metres)

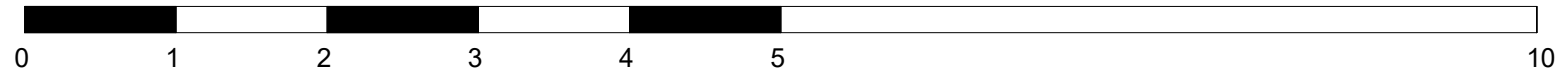

## Project status

## Planning

### GENERAL NOTES:

This drawing is not for construction and is for information purposes only. Contractor to provide detailed design and construction information. This drawing is to be read in conjunction with all relevant architects' and engineers' drawings and specifications. Drawings to be read in line with the approved inspectors plan check and all dimensions to be checked on site with any discrepancies reported to the architect.

OS information not accurate and not to be used for measurements.

Dowen Farmer Architects Ltd is incorporated in England & Wales. Company registration number 10861309.