
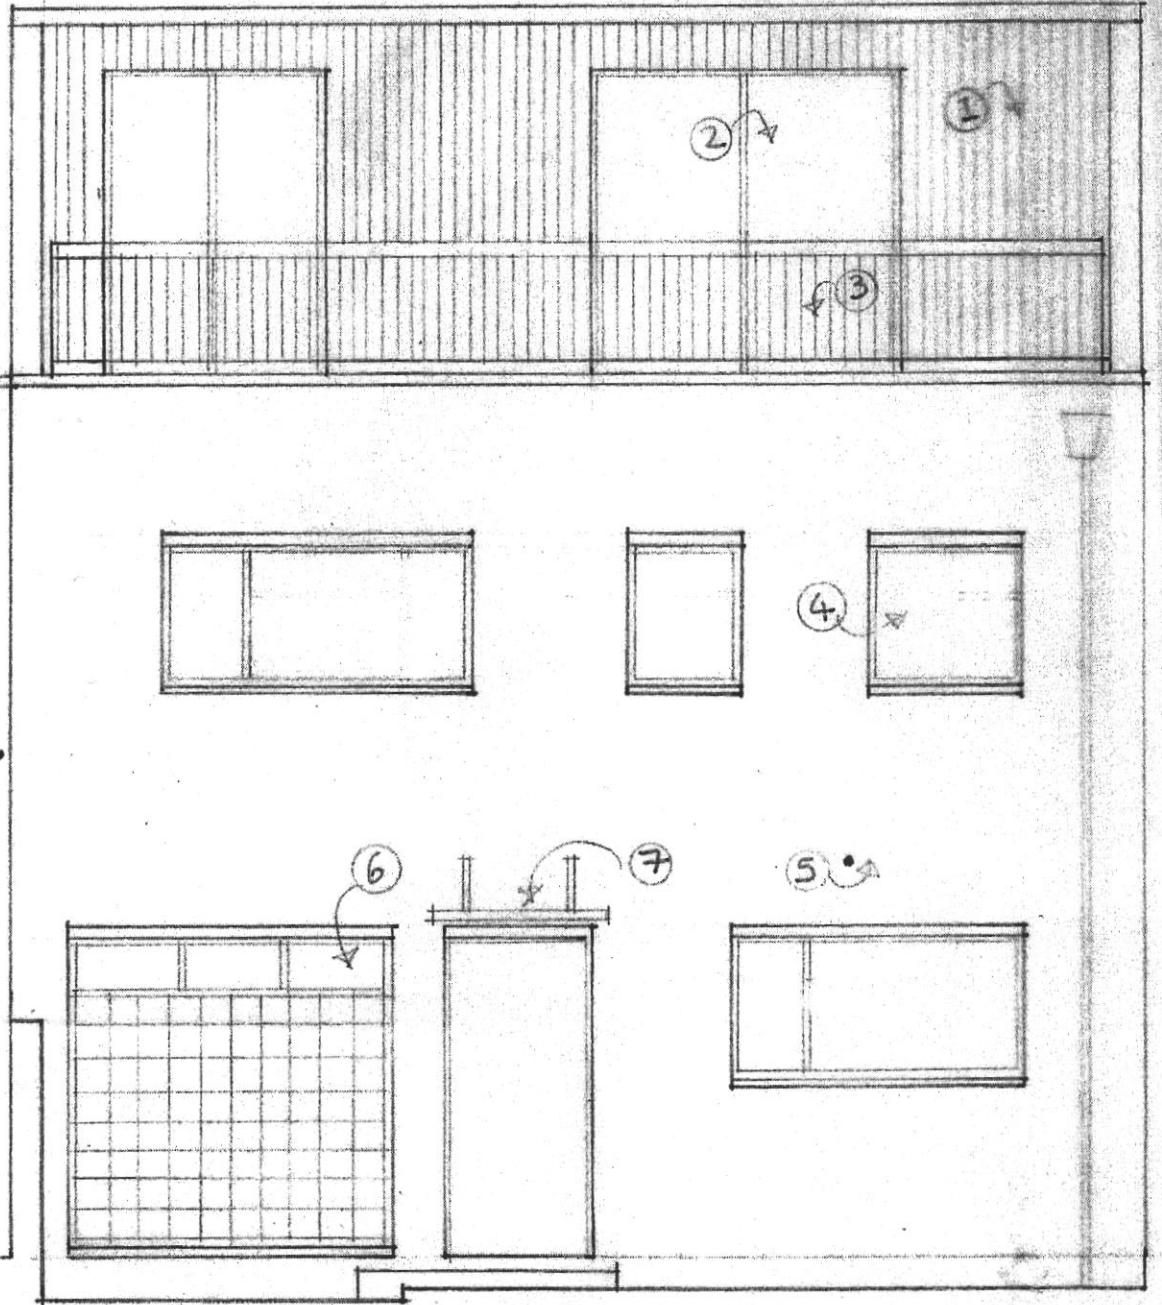


T6. PARAPET LEVEL  


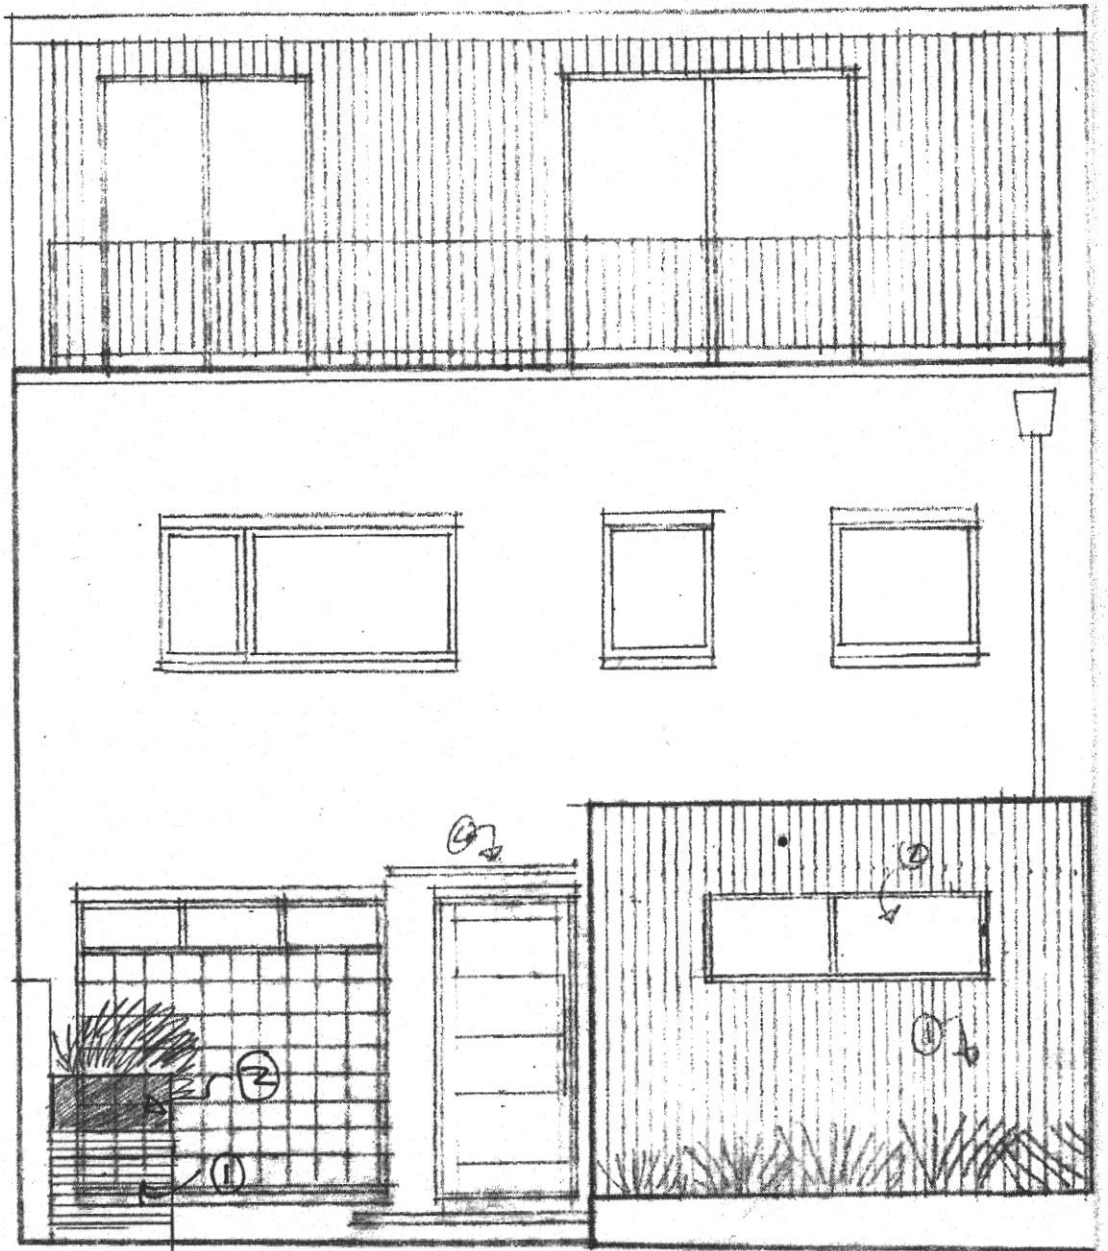


FRONT ELEVATION TO MURRAY MEWS

- 1 WESTERN RED CEDAR
- 2 NEW DOUBLE GLAZED WINDOWS/DOORS
- 3 METAL BALUSTRADE TO TERRACE
- 4. ~~DOUBLE GLAZED TIMBER WINDOWS~~
- ~~4. EXISTING BROWN CALCIUM SILICATE BRICKS~~
- 5 ~~EXISTING BROWN CALCIUM SILICATE BRICKS~~
- 7. CANOPY NOT YET INSTALLED.

40 MURRAY MEWS  
 LONDON NW1 7RQ  
 EXISTING FRONT  
 ELEVATION  
 DRG. NO. 05

SCALE 1:50




**FRONT ELEVATION**  
**40 MURRAY MEWS, LONDON NW1.**

① BIN ENCLOSURE CONSTRUCTED  
 OF 2ND HAND YELLOW LONDON  
 STOCK BRICKS TO MATCH WALL

③ METAL PLANTER



**FRONT ELEVATION SHOWING PROPOSED BIN  
 ENCLOSURE**

**DRG. NO. 07 SCALE 1:50**

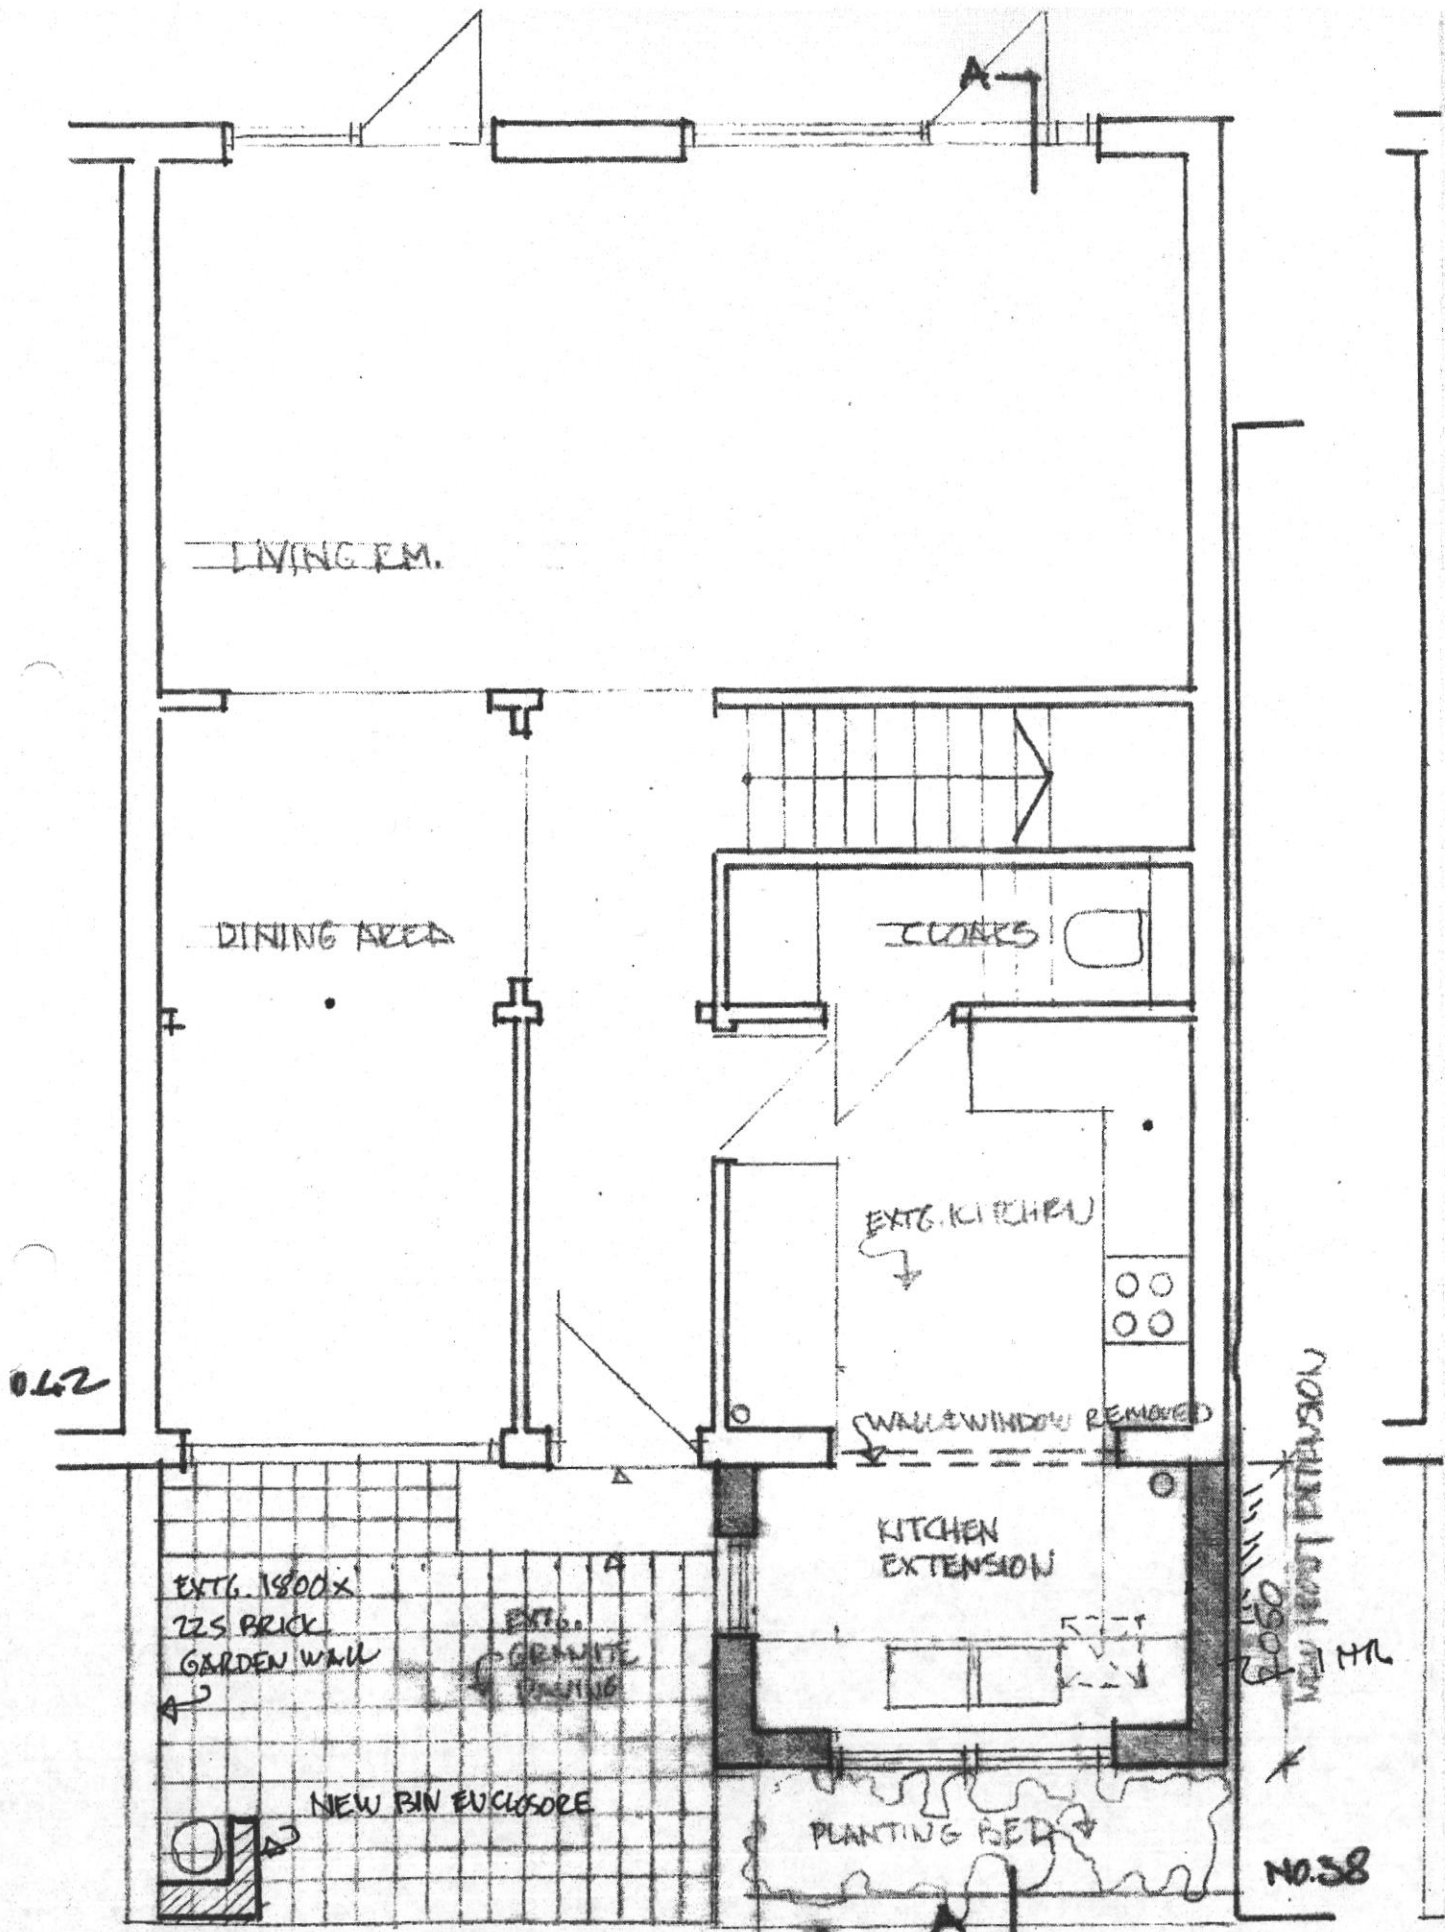

**GROUND FLOOR PLAN** FOOTPATH (EXTG. GARDEN) WALL  
 40 MURRELY MEWS, LONDON NW1 RETAINED  
 SITE PLAN SHOWING PROPOSED BIN ENCLOSURE  
 DRG NO. 06 SCALE 1:50

FILE COPY

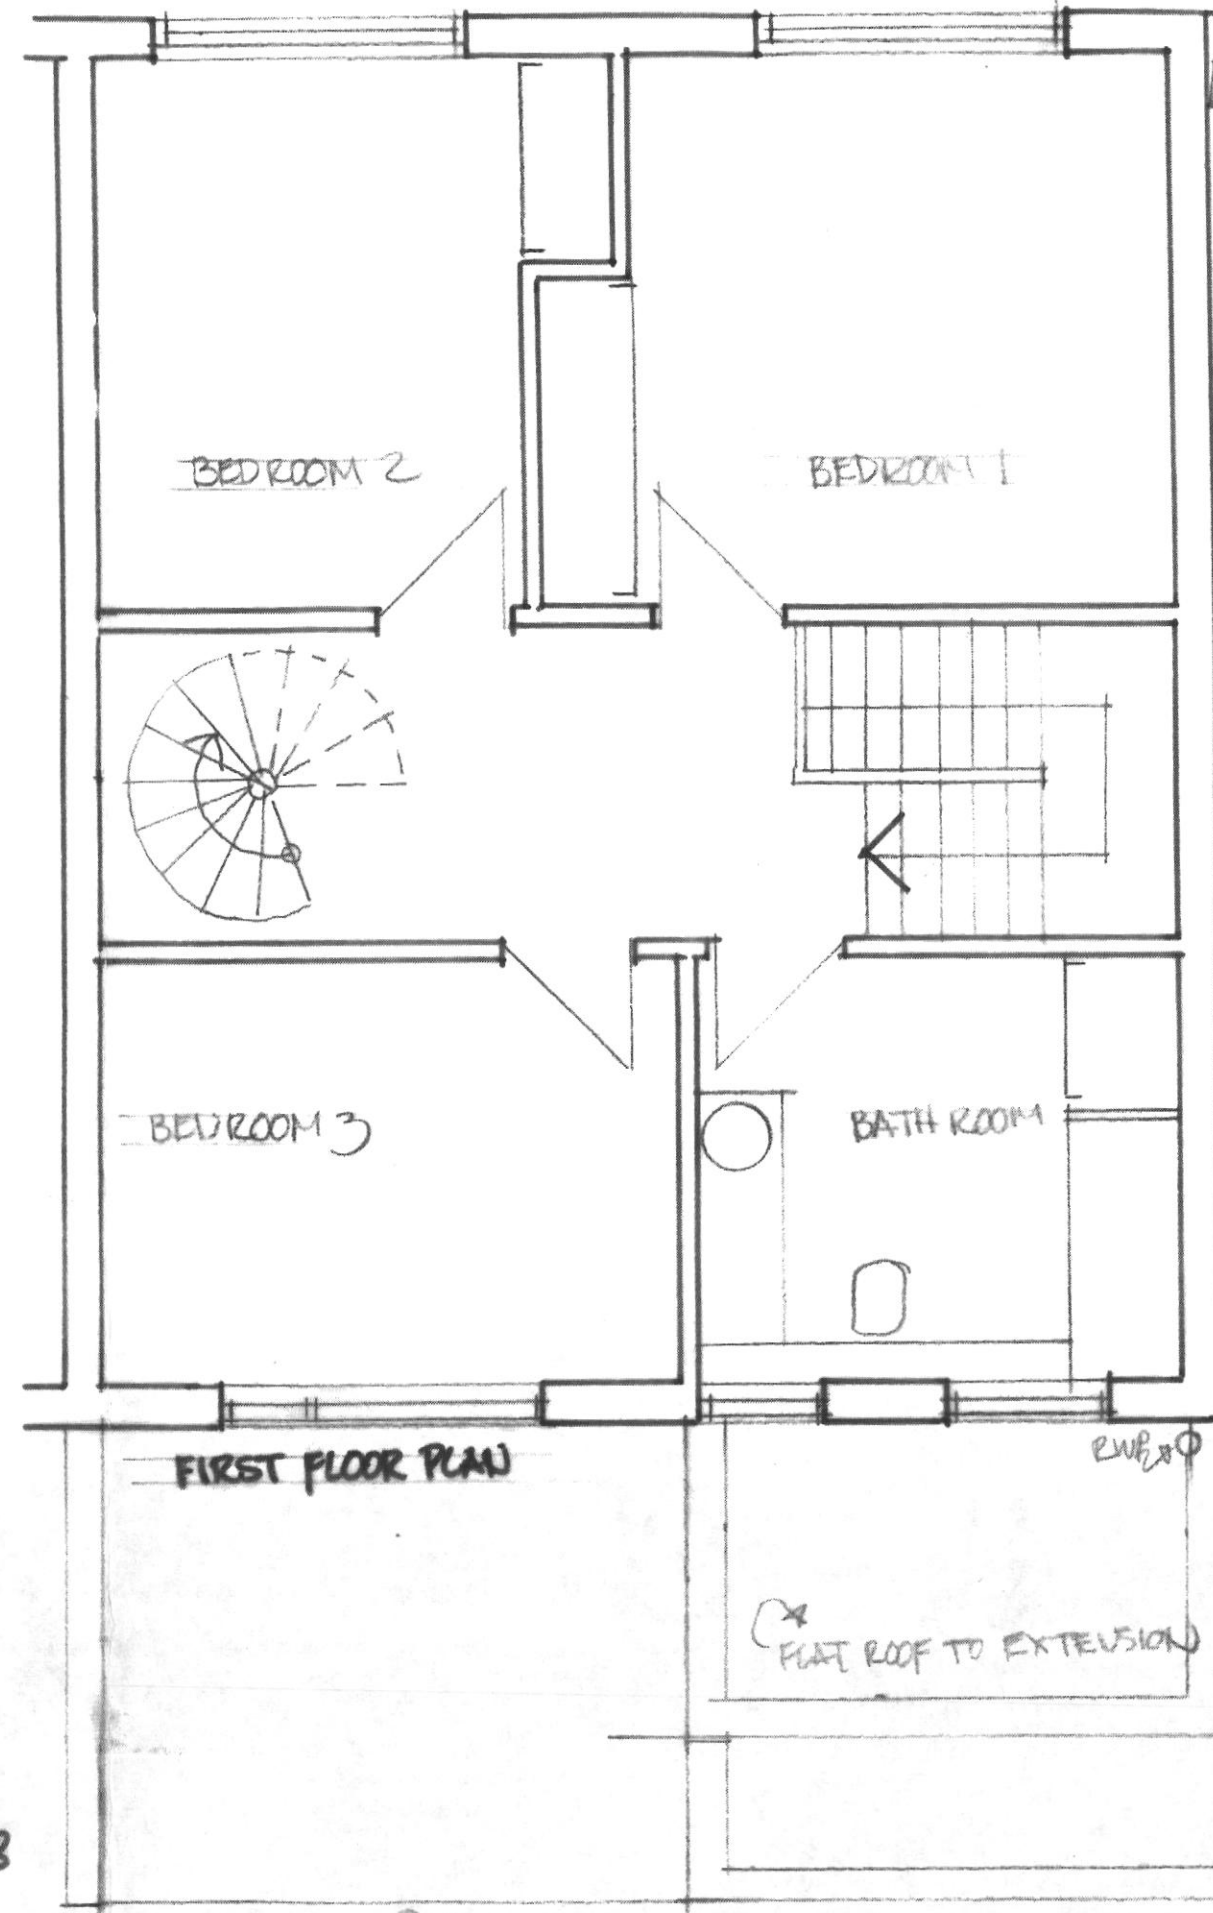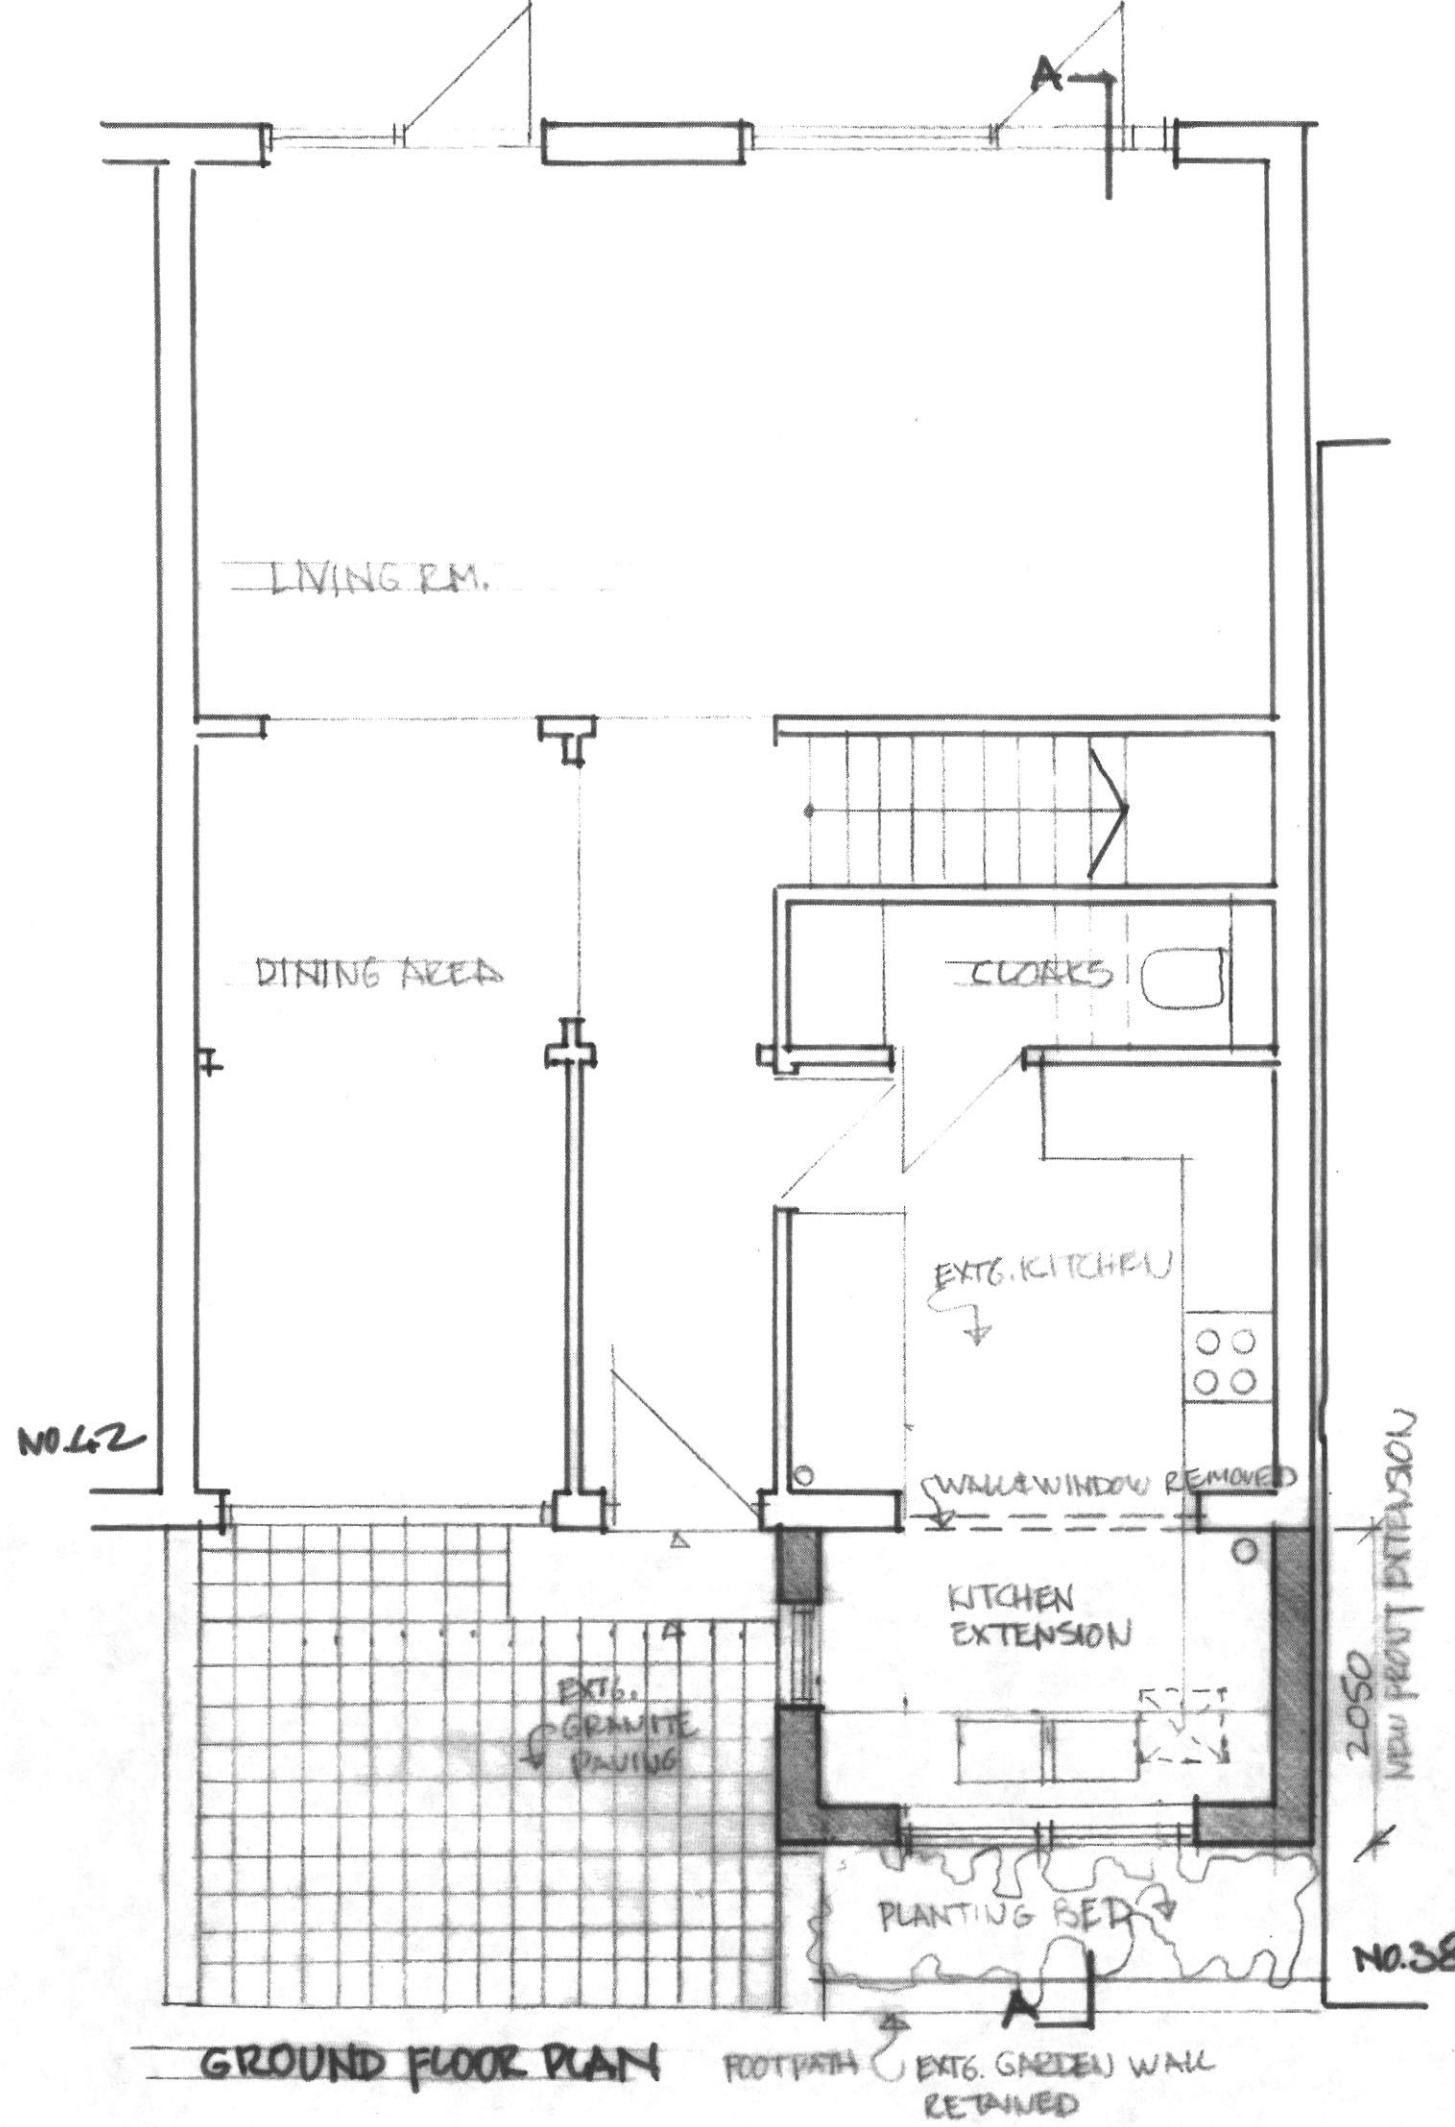


KITCHEN EXTENSION  
 40 MURRAY MEWS NW1  
 D.A. THOMPSON  
 0207-485-2606  
 SCALE 1:50 27.12.09  
 DRG. MM/01

2010/1437/7


FILE COPY

2010/143717

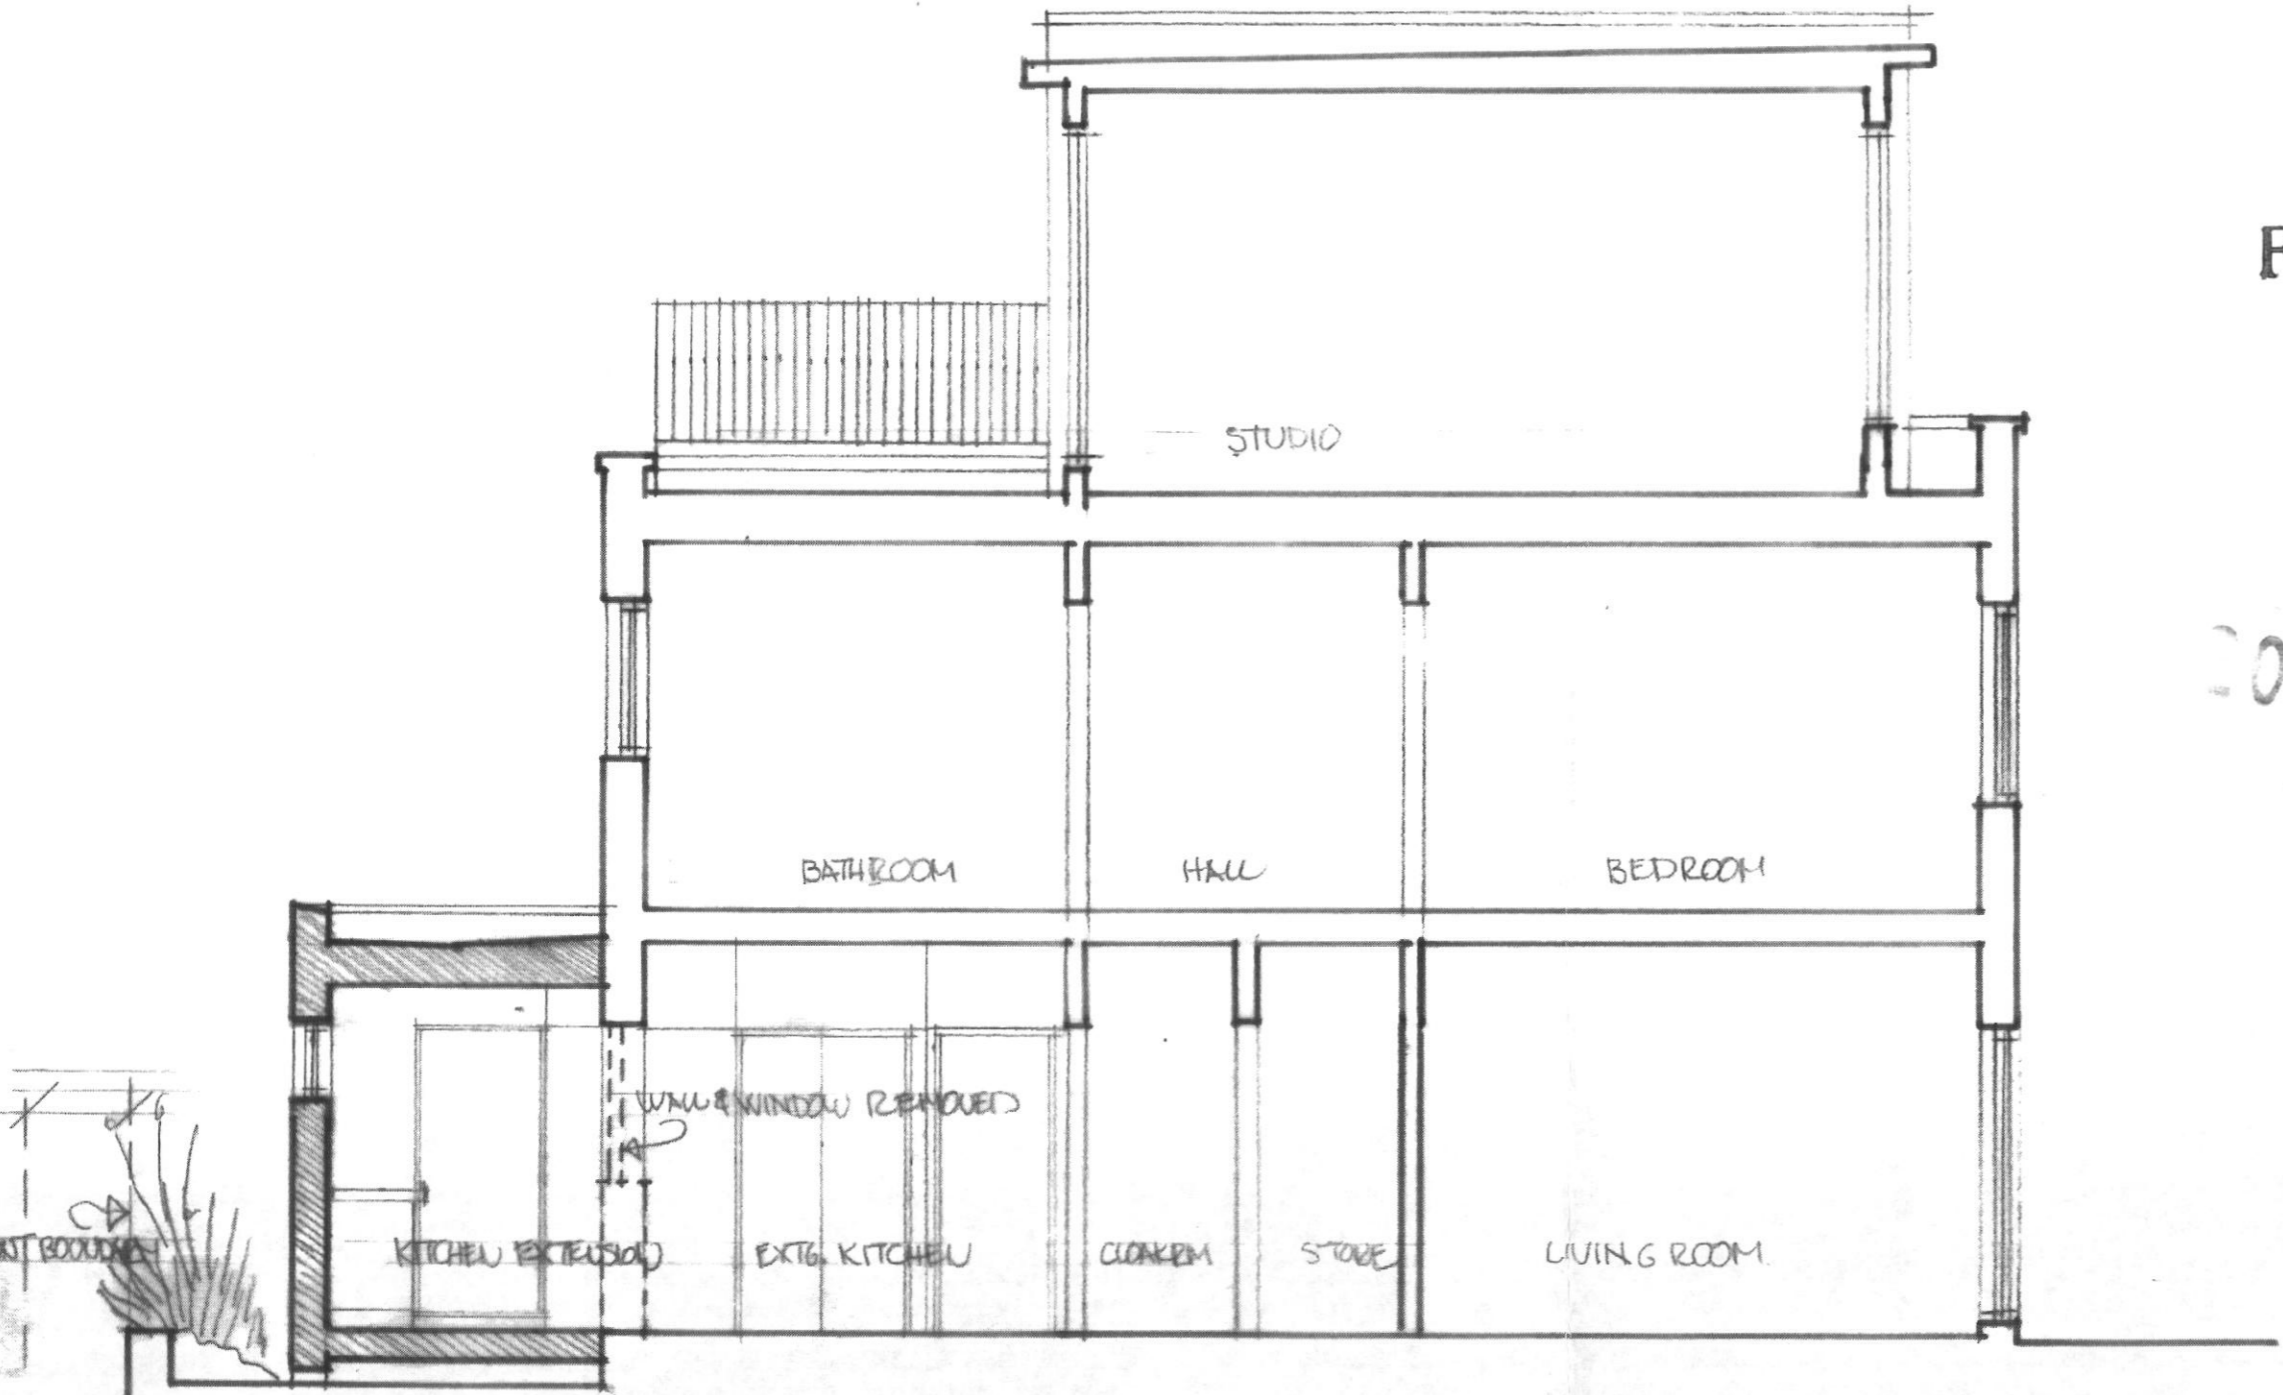


SECTION A-A

KITCHEN EXTENSION  
 40 MURRAY MEWS NW1  
 D.A. THOMPSON  
 0207-485-2406  
 SCALE 1:50 27.12.09  
 DRG MM/02

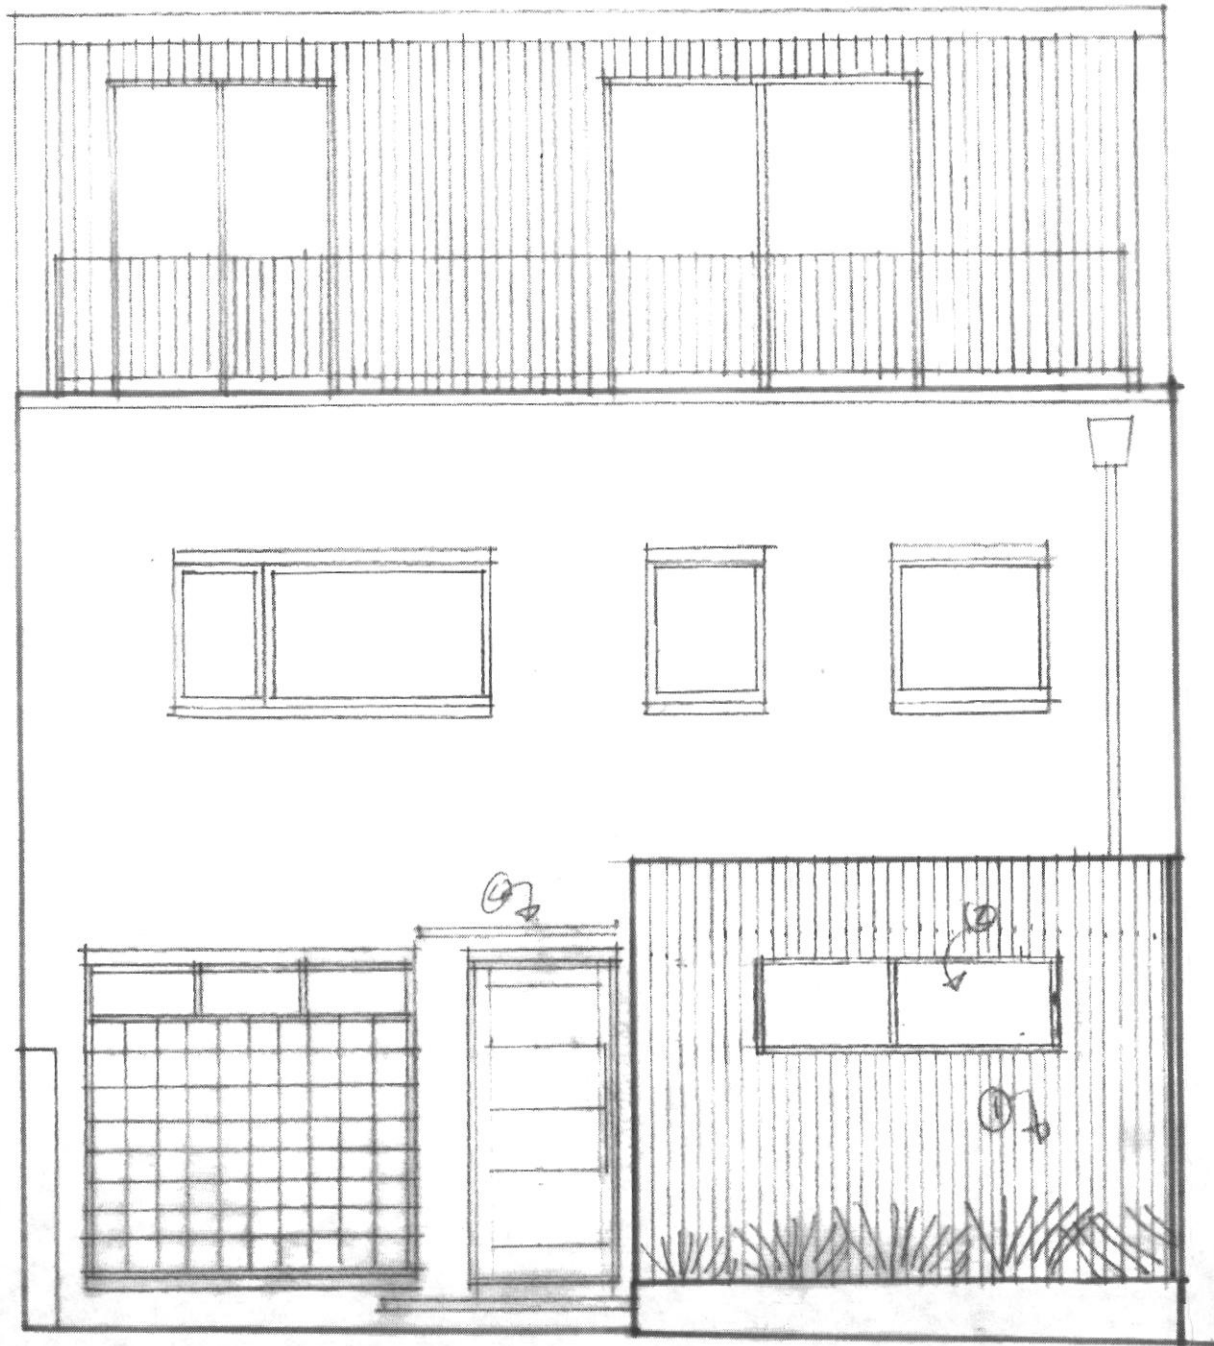

FRONT ELEVATION

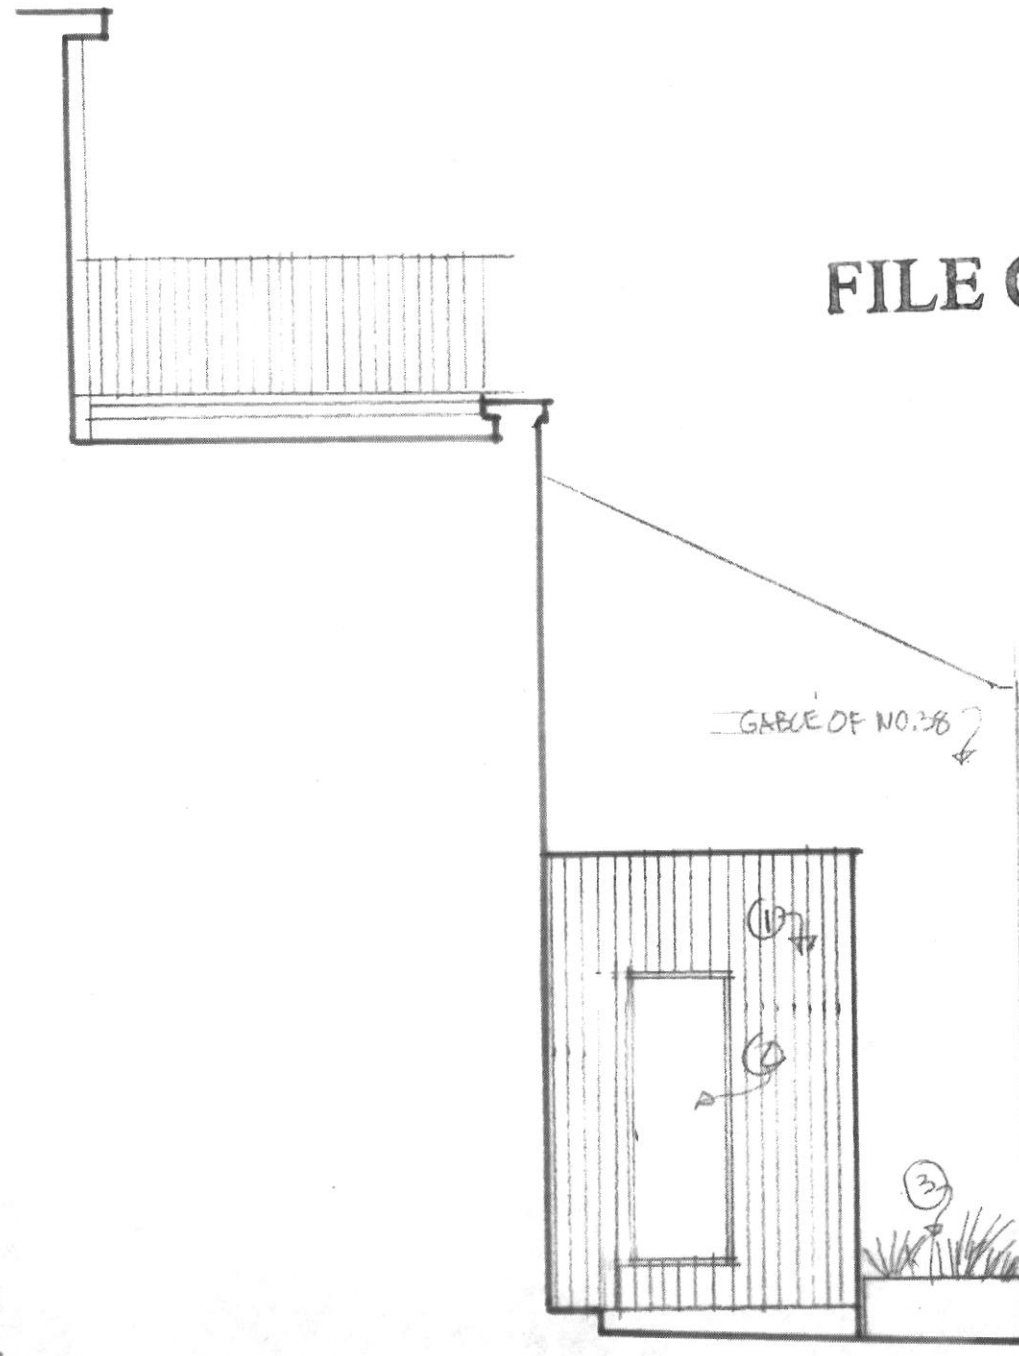

SIDE ELEVATION/SECTION

FILE COPY

GABLE OF NO. 36

NOTES.

- ① WESTERN RED CEDAR - VERTICAL CLADDING
- ② DOUBLE GLAZED TIMBER WINDOWS
- ③ PLANTER
- ④ GLASS/METAL CANOPY

FOOT BOUNDARY

KITCHEN EXTENSION

40 MURRAY MEWS NW1

D.A. THOMPSON

0207-485-2406

SCALE 1:50 27.12.09.

DRG NM/03

2010/1437/P