

LABTECH



NOTES:

Drawings to be read in conjunction with all other architectural & design consultant information.

Site dimensions are to be confirmed on site by contractor or joiner prior to construction.

Do not scale from this drawing.

REV	BY	DESCRIPTION	DATE	
PROJECT NAME:				
ATRIUM - AS BUILT				
DRAWING TITLE:				
Ground Floor Plan				
SCALE:	SIZE:	DATE:	BY:	STATUS:
As indicated	A1	18/11/22	JA	
PROJECT REF:	DRAWING NUMBER:	REVISION:		
0001	A002			

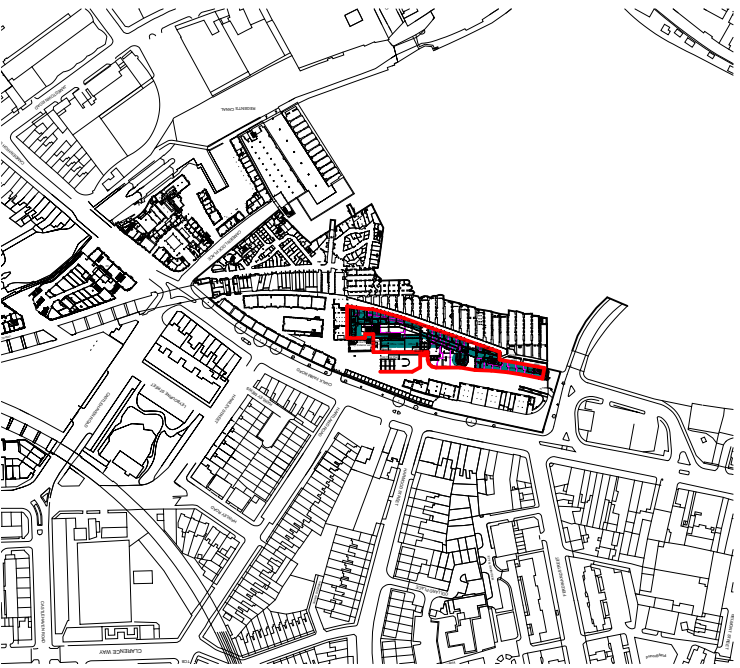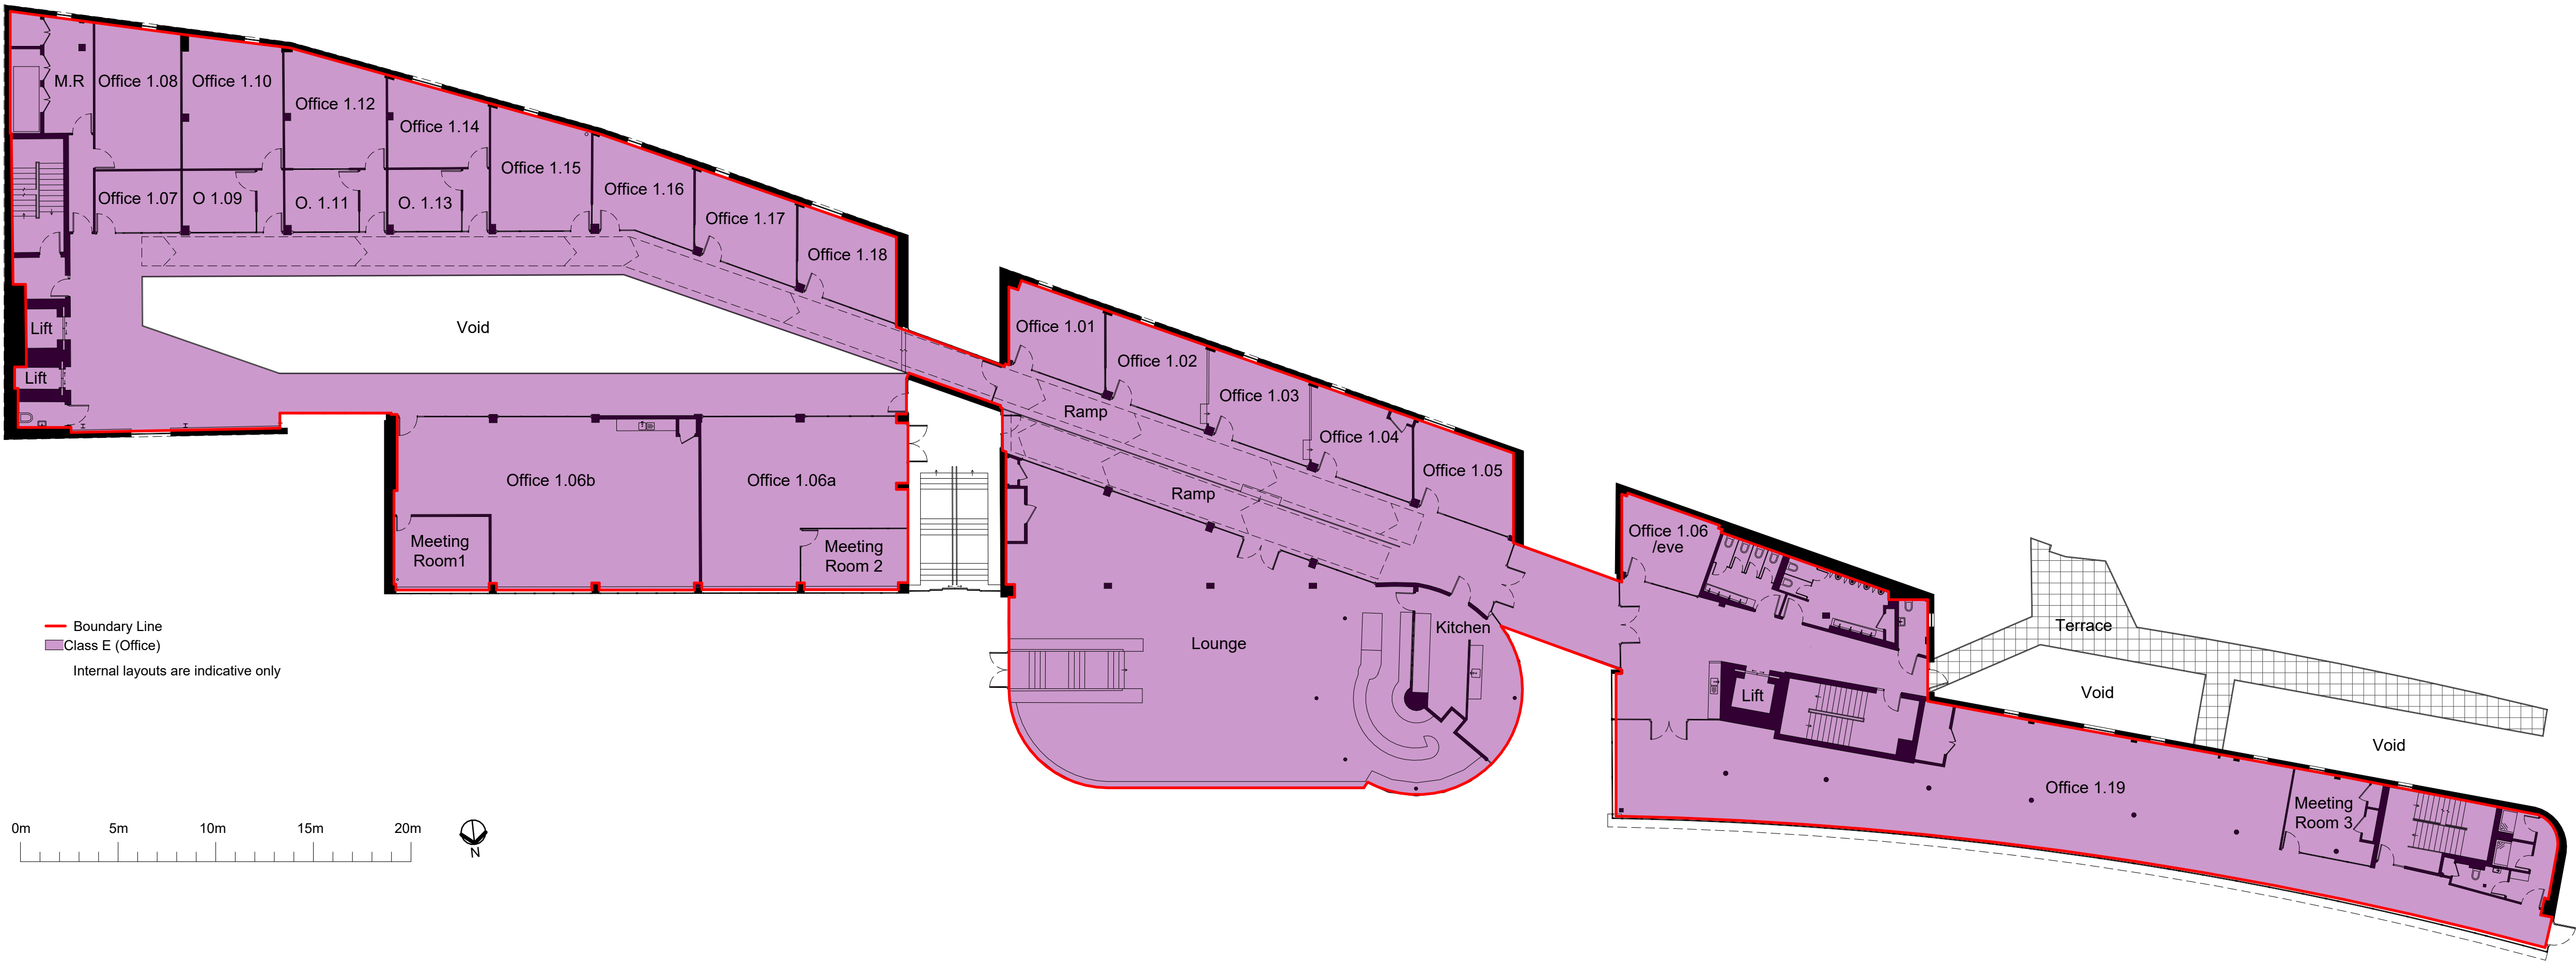

LABTECH



NOTES:

Drawings to be read in conjunction with all other architectural & design consultant information.

Site dimensions are to be confirmed on site by contractor or joiner prior to construction.

Do not scale from this drawing.

REV	BY	DESCRIPTION	DATE	
PROJECT NAME:				
ATRIUM - AS BUILT				
DRAWING TITLE:				
First Floor				
SCALE:	SIZE:	DATE:	BY:	STATUS:
As indicated	A1	18/11/22	JA	
PROJECT REF:	DRAWING NUMBER:	REVISION:		
0001	A003			

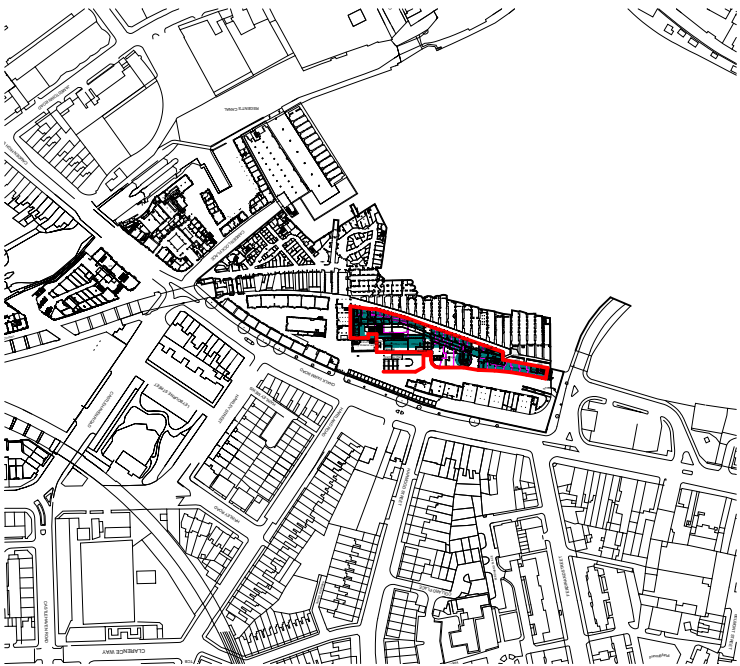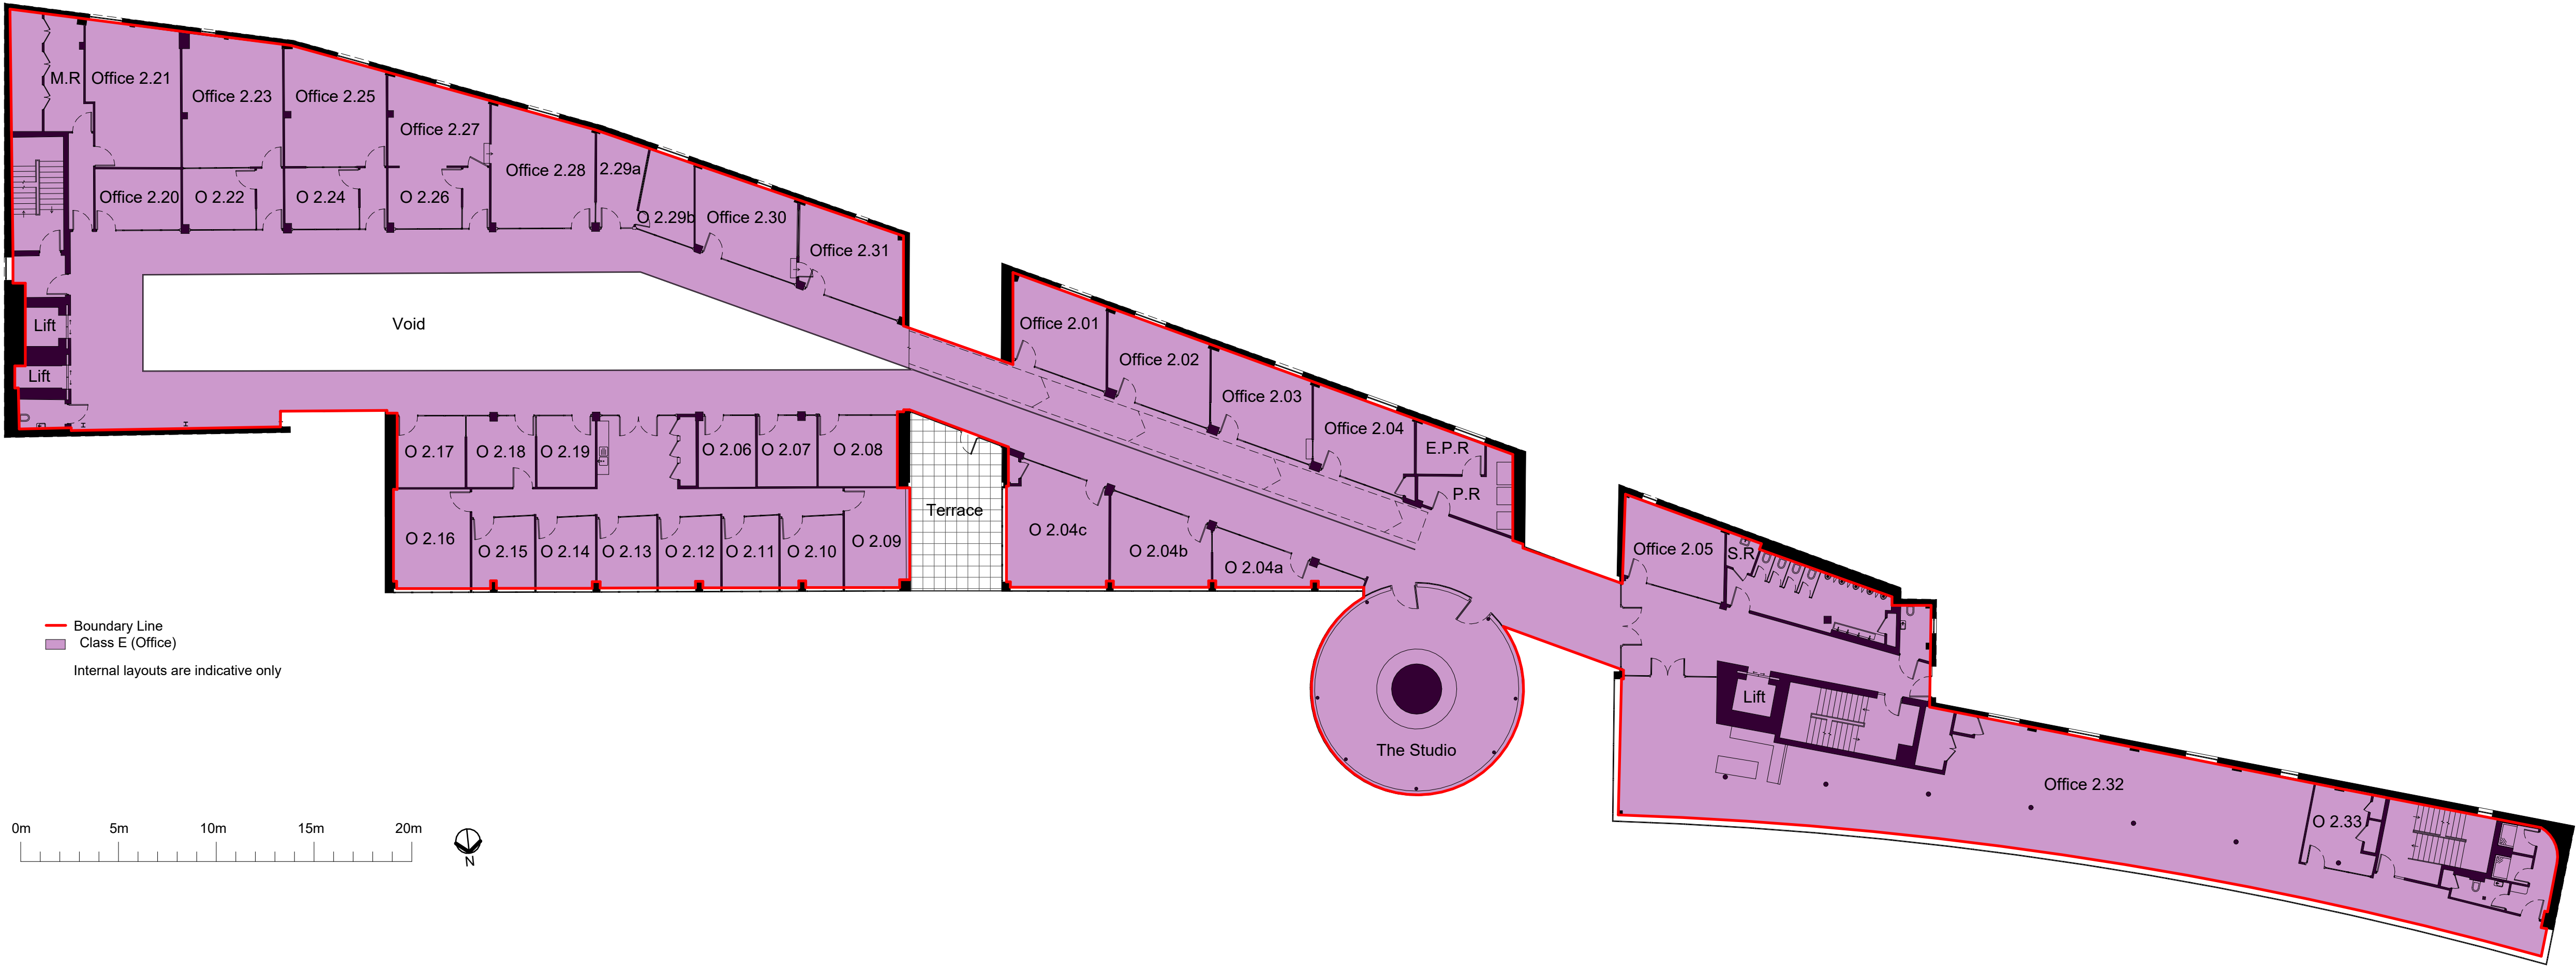

LABTECH



NOTES:

Drawings to be read in conjunction with all other architectural & design consultant information.

Site dimensions are to be confirmed on site by contractor or joiner prior to construction.

Do not scale from this drawing.

REV	BY	DESCRIPTION	DATE	
PROJECT NAME:				
ATRIUM - AS BUILT				
DRAWING TITLE:				
Second Floor				
SCALE:	SIZE:	DATE:	BY:	STATUS:
As indicated	A1	18/11/22	JA	
PROJECT REF:	DRAWING NUMBER:	REVISION:		
0001	A004			

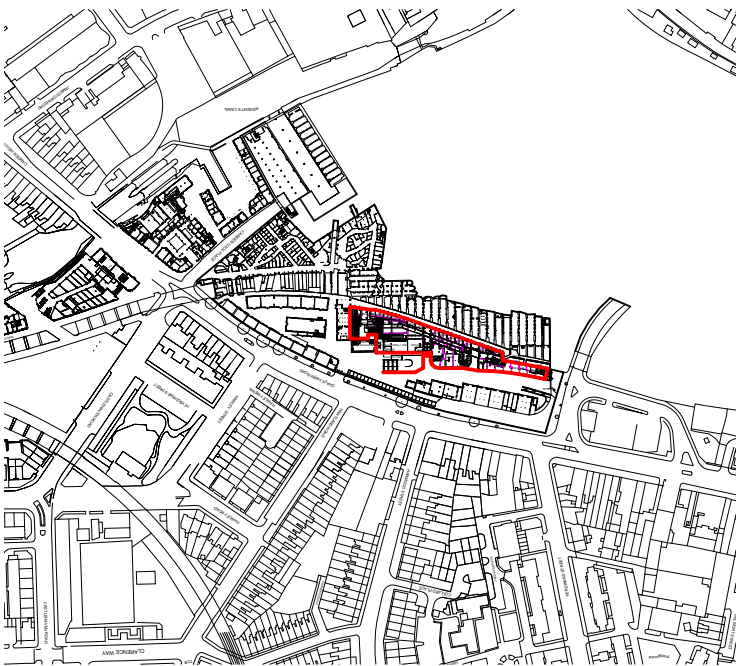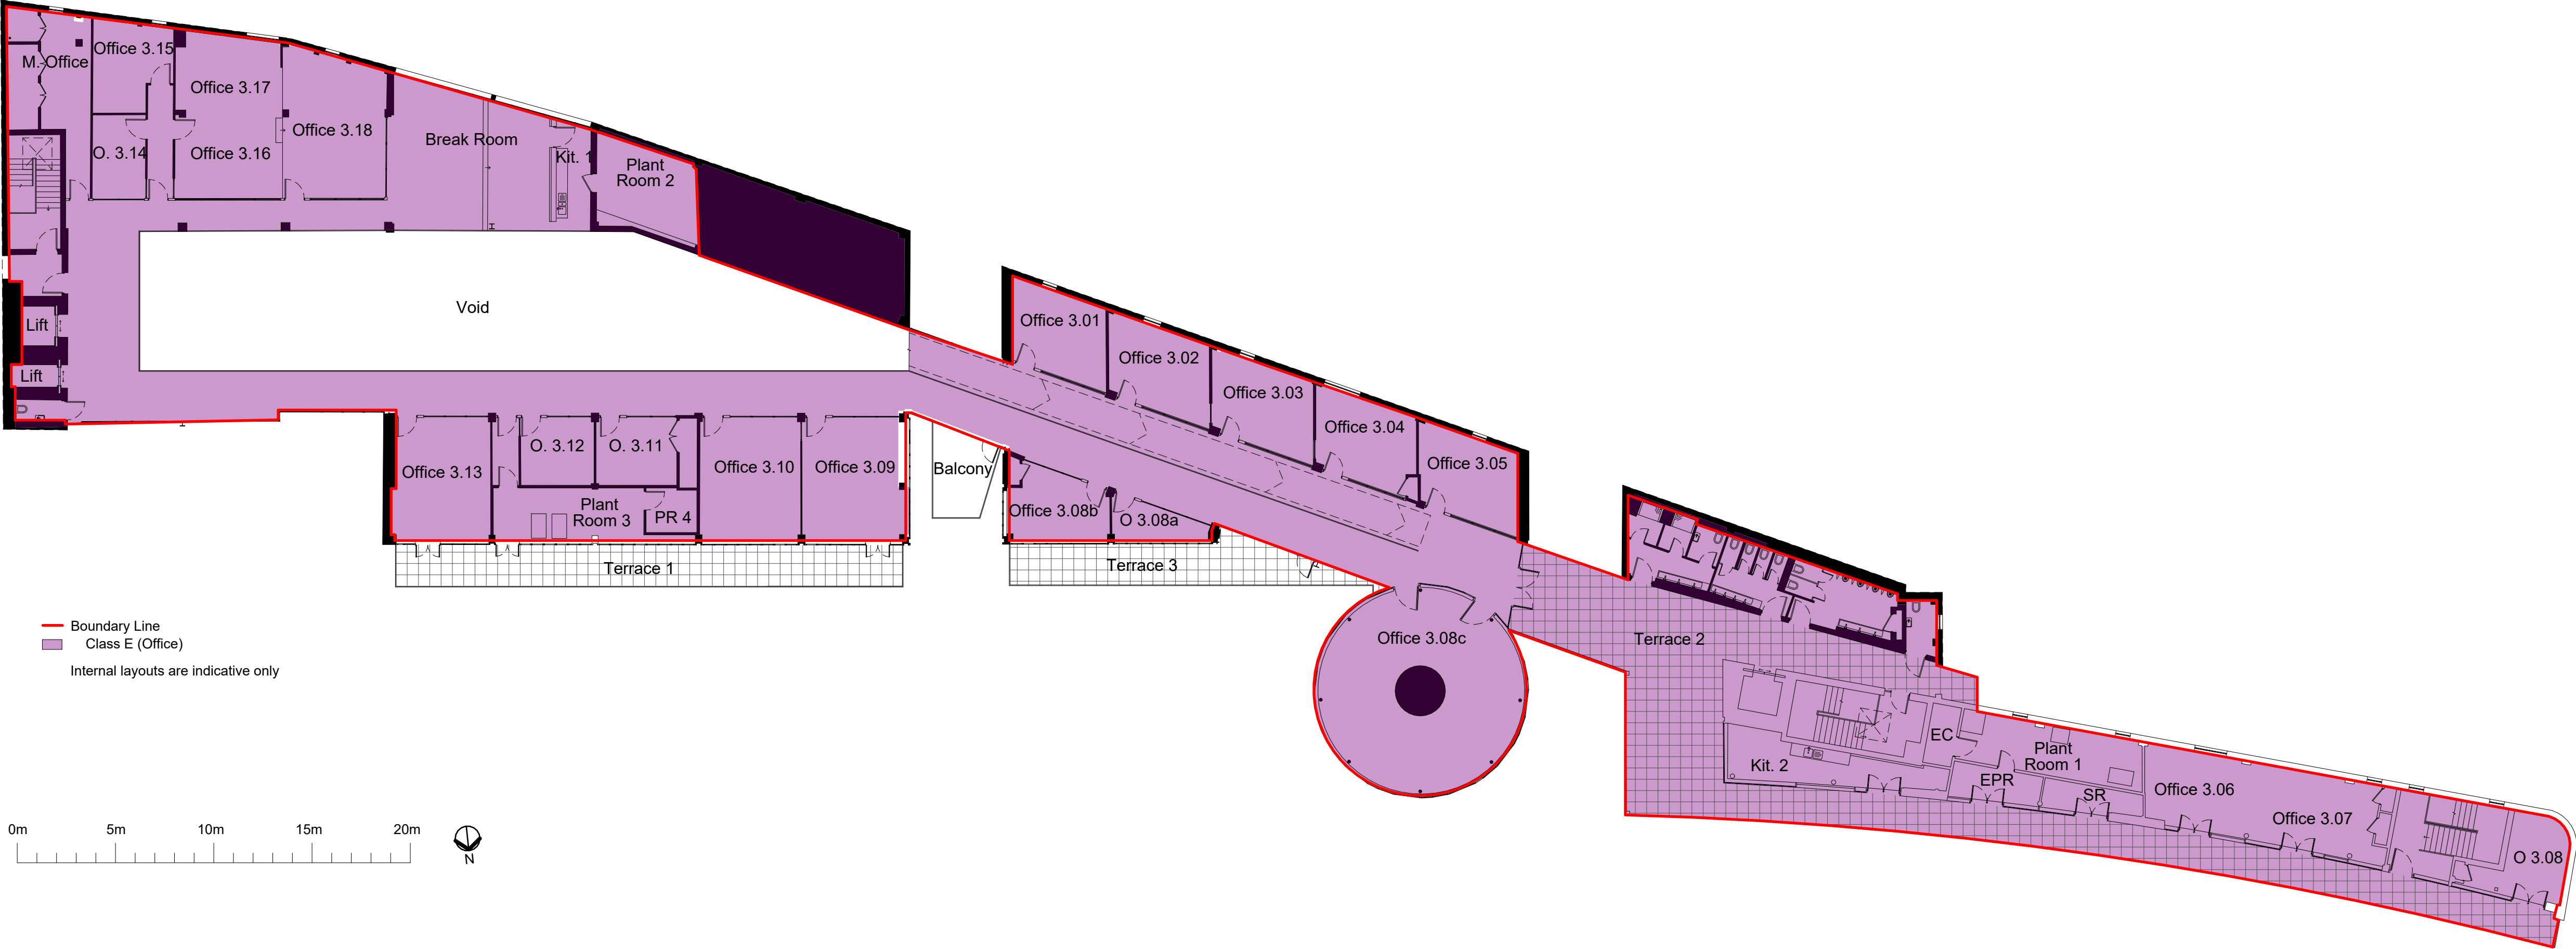

LABTECH

NOTES:

Drawings to be read in conjunction with all other architectural & design consultant information.

Site dimensions are to be confirmed on site by contractor or joiner prior to construction.

Do not scale from this drawing.

REV	BY	DESCRIPTION	DATE	
PROJECT NAME:				
ATRIUM - AS BUILT				
DRAWING TITLE:				
Third Floor				
SCALE:	SIZE:	DATE:	BY:	STATUS:
As indicated	A1	18/11/22	JA	
PROJECT REF:	DRAWING NUMBER:		REVISION:	
0001	A005			