


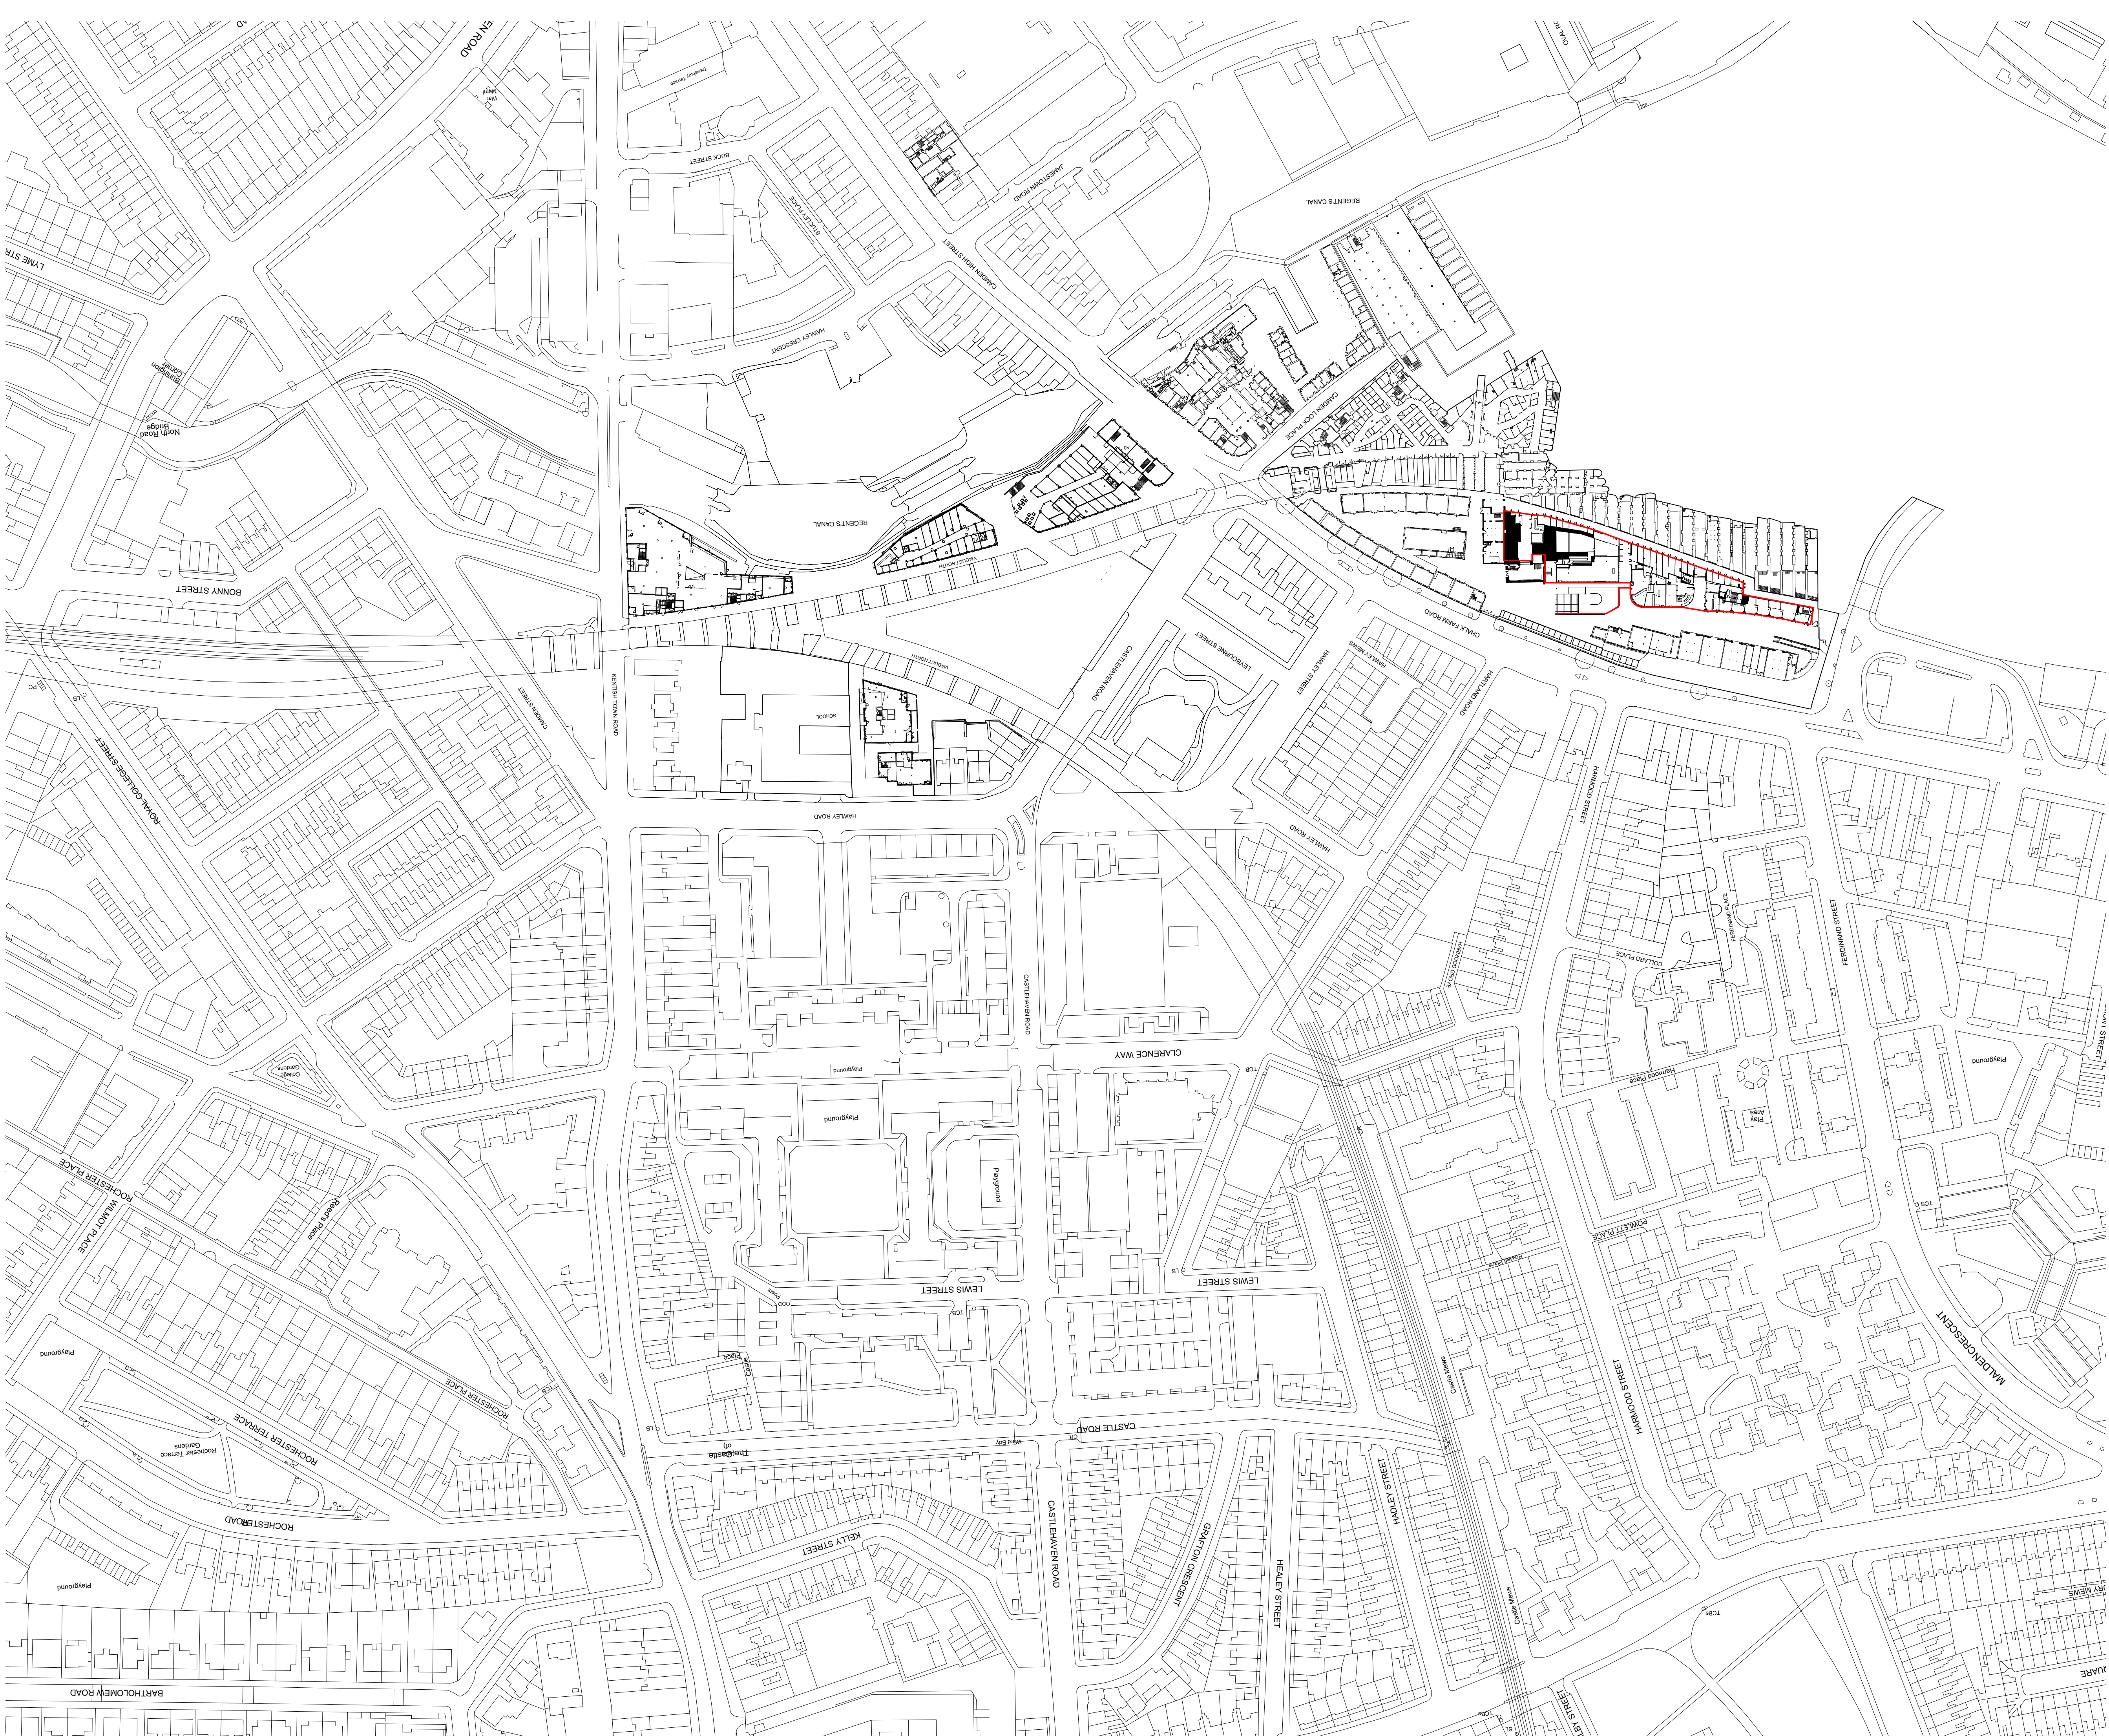

LABTECH

NOTES:

Drawings to be read in conjunction with all other architectural & design consultant information.

Site dimensions are to be confirmed on site by contractor or joiner prior to construction.

Do not scale from this drawing.

REV	BY	DESCRIPTION	DATE

PROJECT NAME:

ATRIUM - AS BUILT

DRAWING TITLE:
Location Plan



SCALE: 1 : 1250	SIZE: A1	DATE: 18/11/22	BY: JA	STATUS:
PROJECT REF: 0001	DRAWING NUMBER: A000			REVISION: