



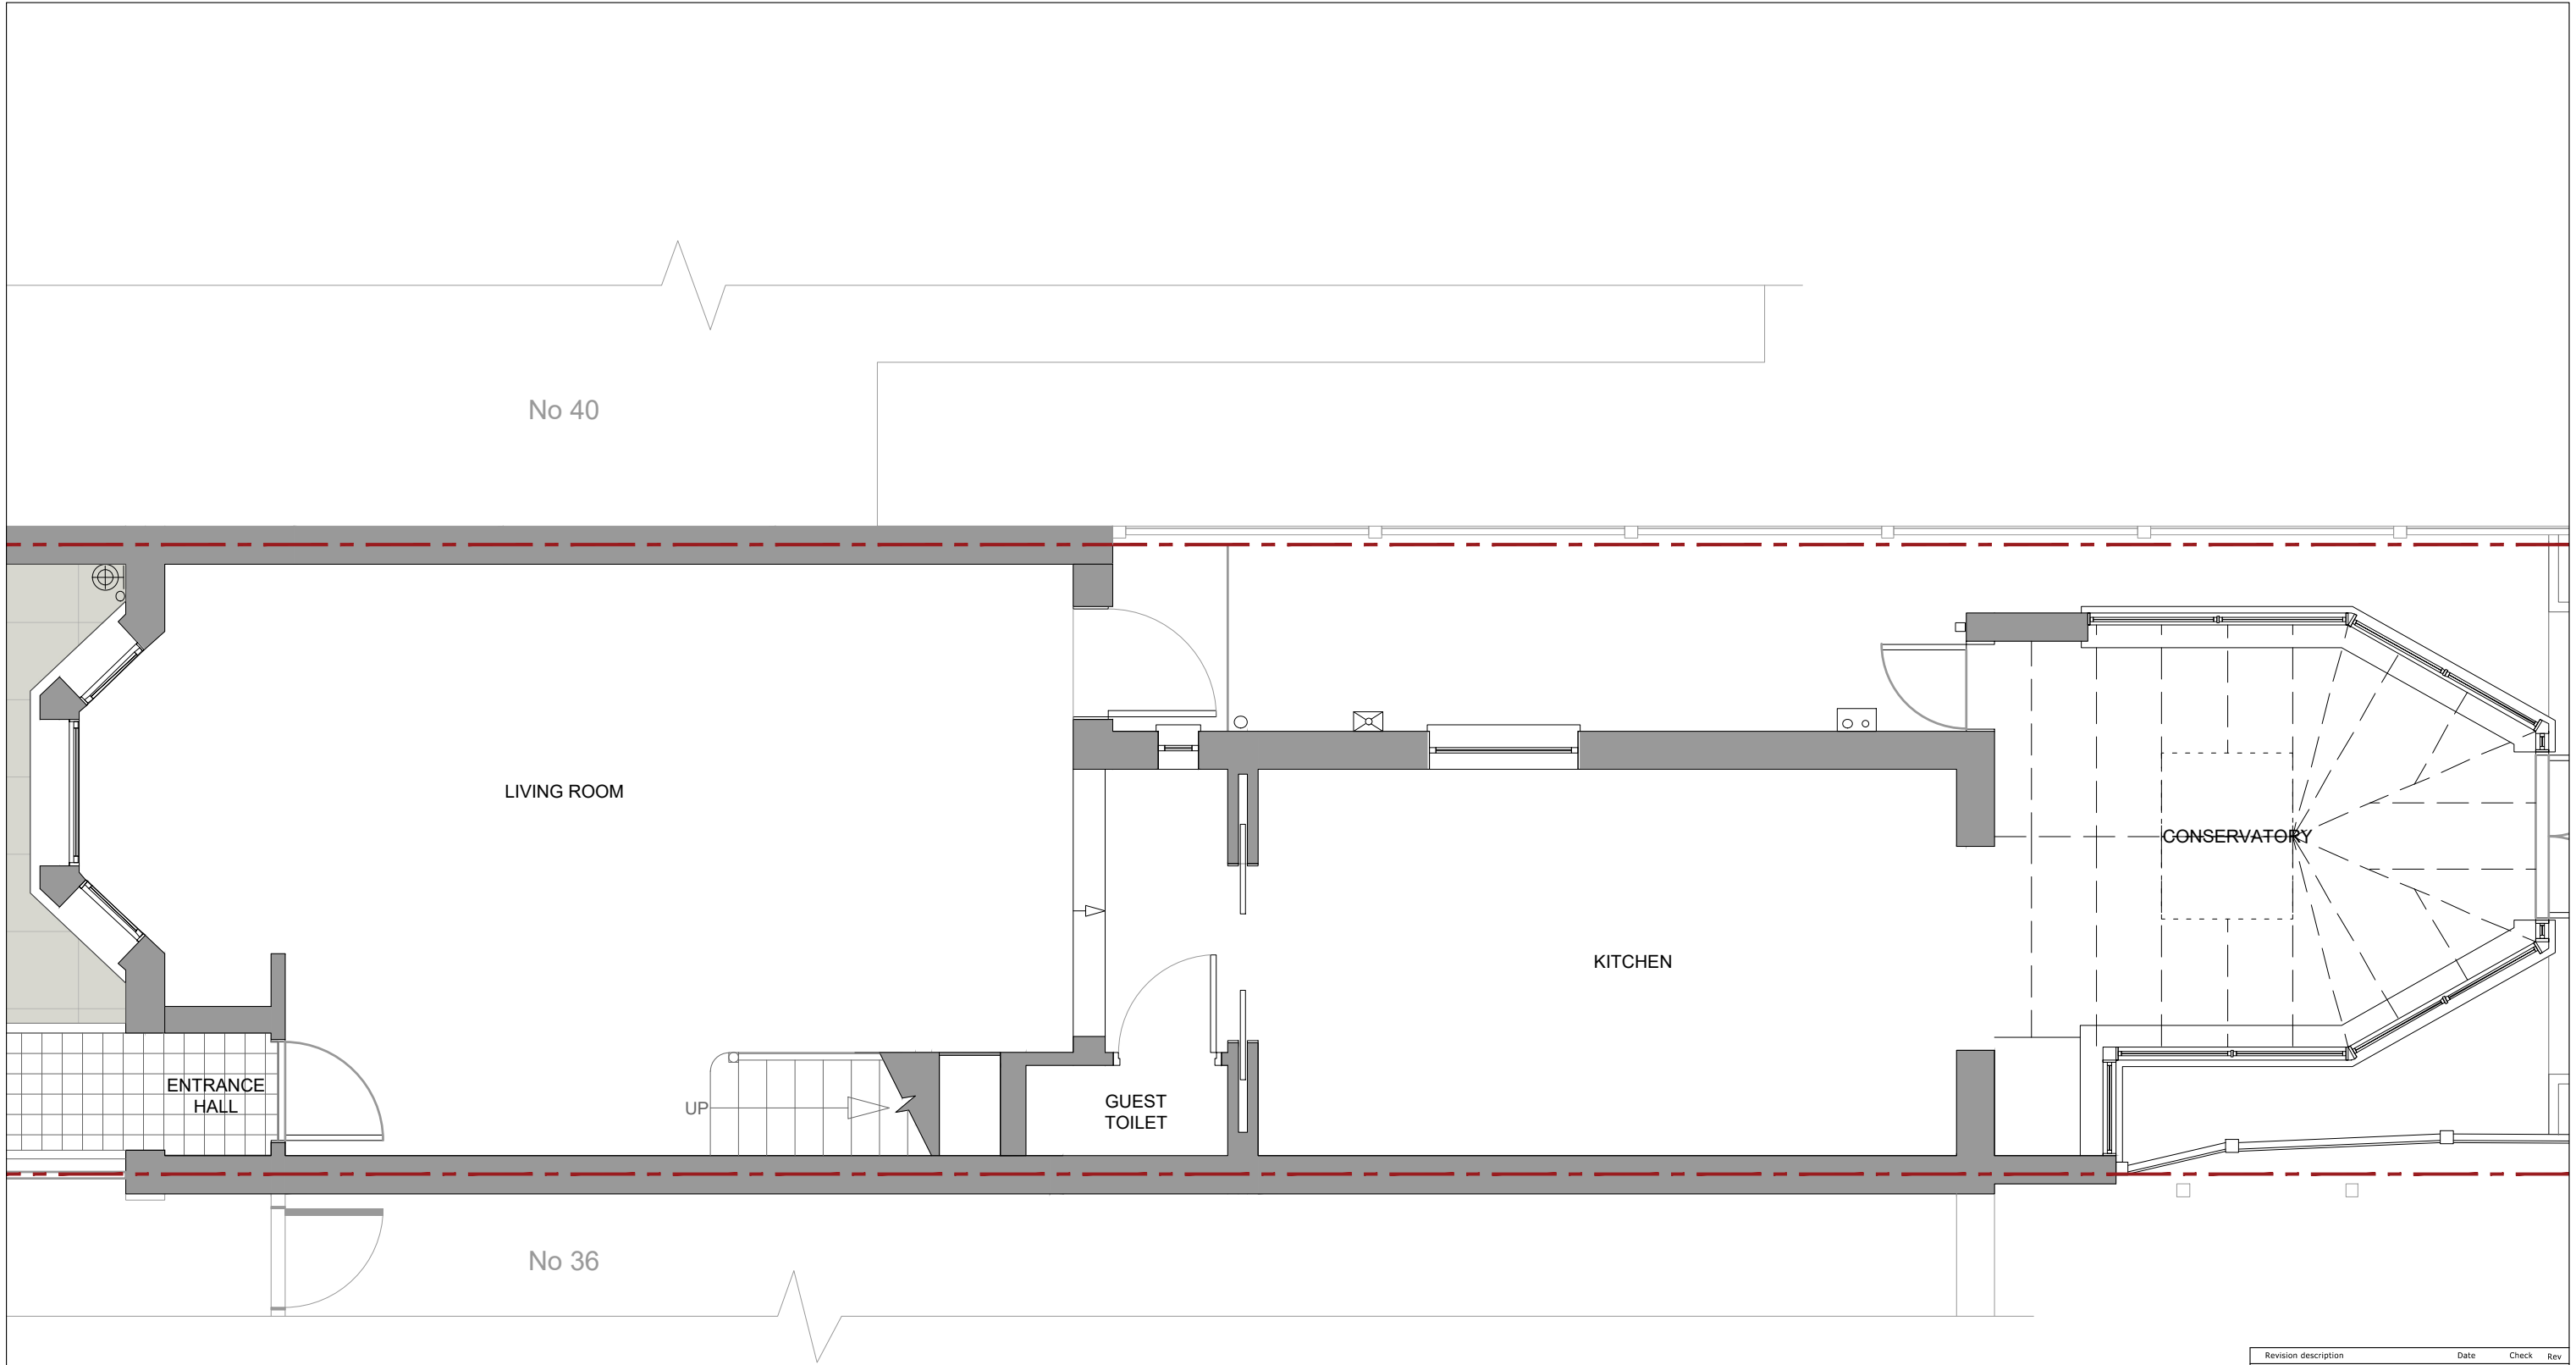

GROUND FLOOR PLAN
SCALE 1:50




Revision description		Date	Check	Rev
 STUDIO www.gf-studio.com Unit 1 Office 7 - Hawthorn Business Park 165 Granville Road, London, NW2 2AZ T: +44 (0) 208 123 53 20 E: info@gf-studio.com				
Project 38 INGHAM ROAD LONDON NW6 1DE				
Drawing GROUND FLOOR PLAN AS BUILT				
Drawn RL	Date 13/12/2022	Scale 1:50@A3		
Job number 2204	Drawing number GA 03 100	Revision A		
COPYRIGHT 2021 GF STUDIO LIMITED ALL RIGHTS RESERVED				

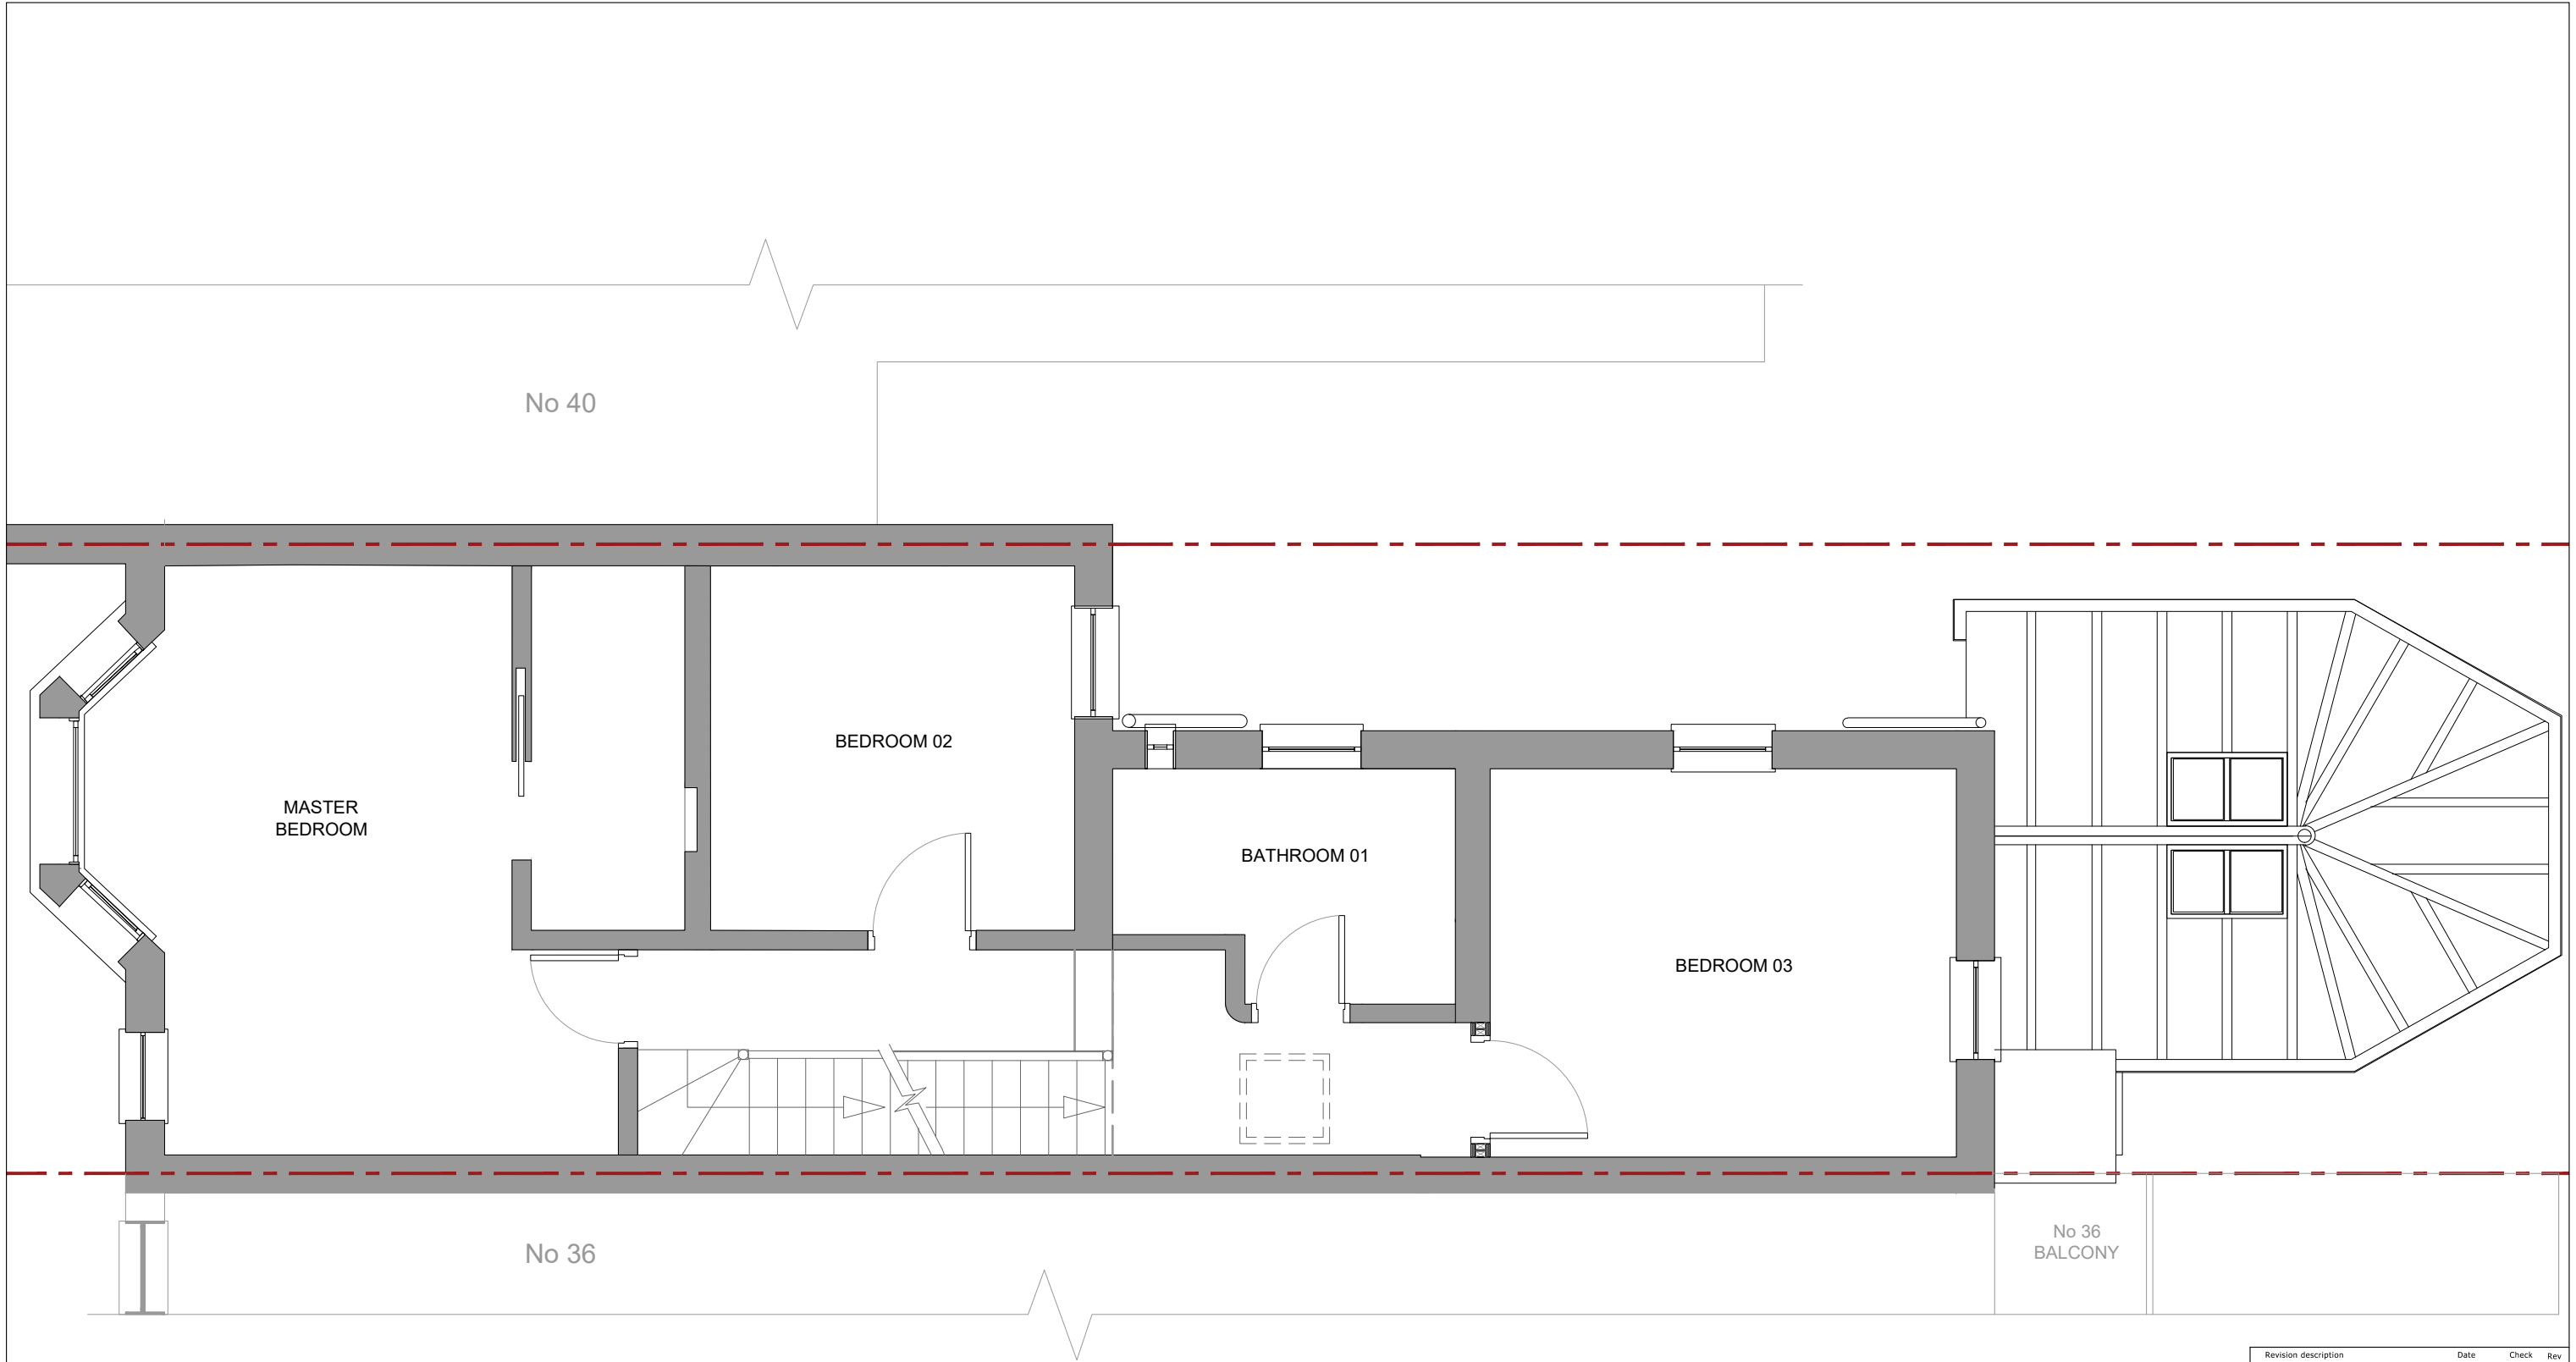

FIRST FLOOR PLAN
SCALE 1:50




Revision description		Date	Check	Rev
 STUDIO www.gf-studio.com Unit 1 Office 7 - Hawthorn Business Park 165 Granville Road, London, NW2 2AZ T: +44 (0) 208 123 53 20 E: info@gf-studio.com				
Project 38 INGHAM ROAD LONDON NW6 1DE				
Drawing FIRST FLOOR PLAN AS BUILT				
Drawn RL	Date 13/12/2022	Scale 1:50@A3		
Job number 2204	Drawing number GA 03 101	Revision A		
COPYRIGHT 2021 GF STUDIO LIMITED ALL RIGHTS RESERVED				

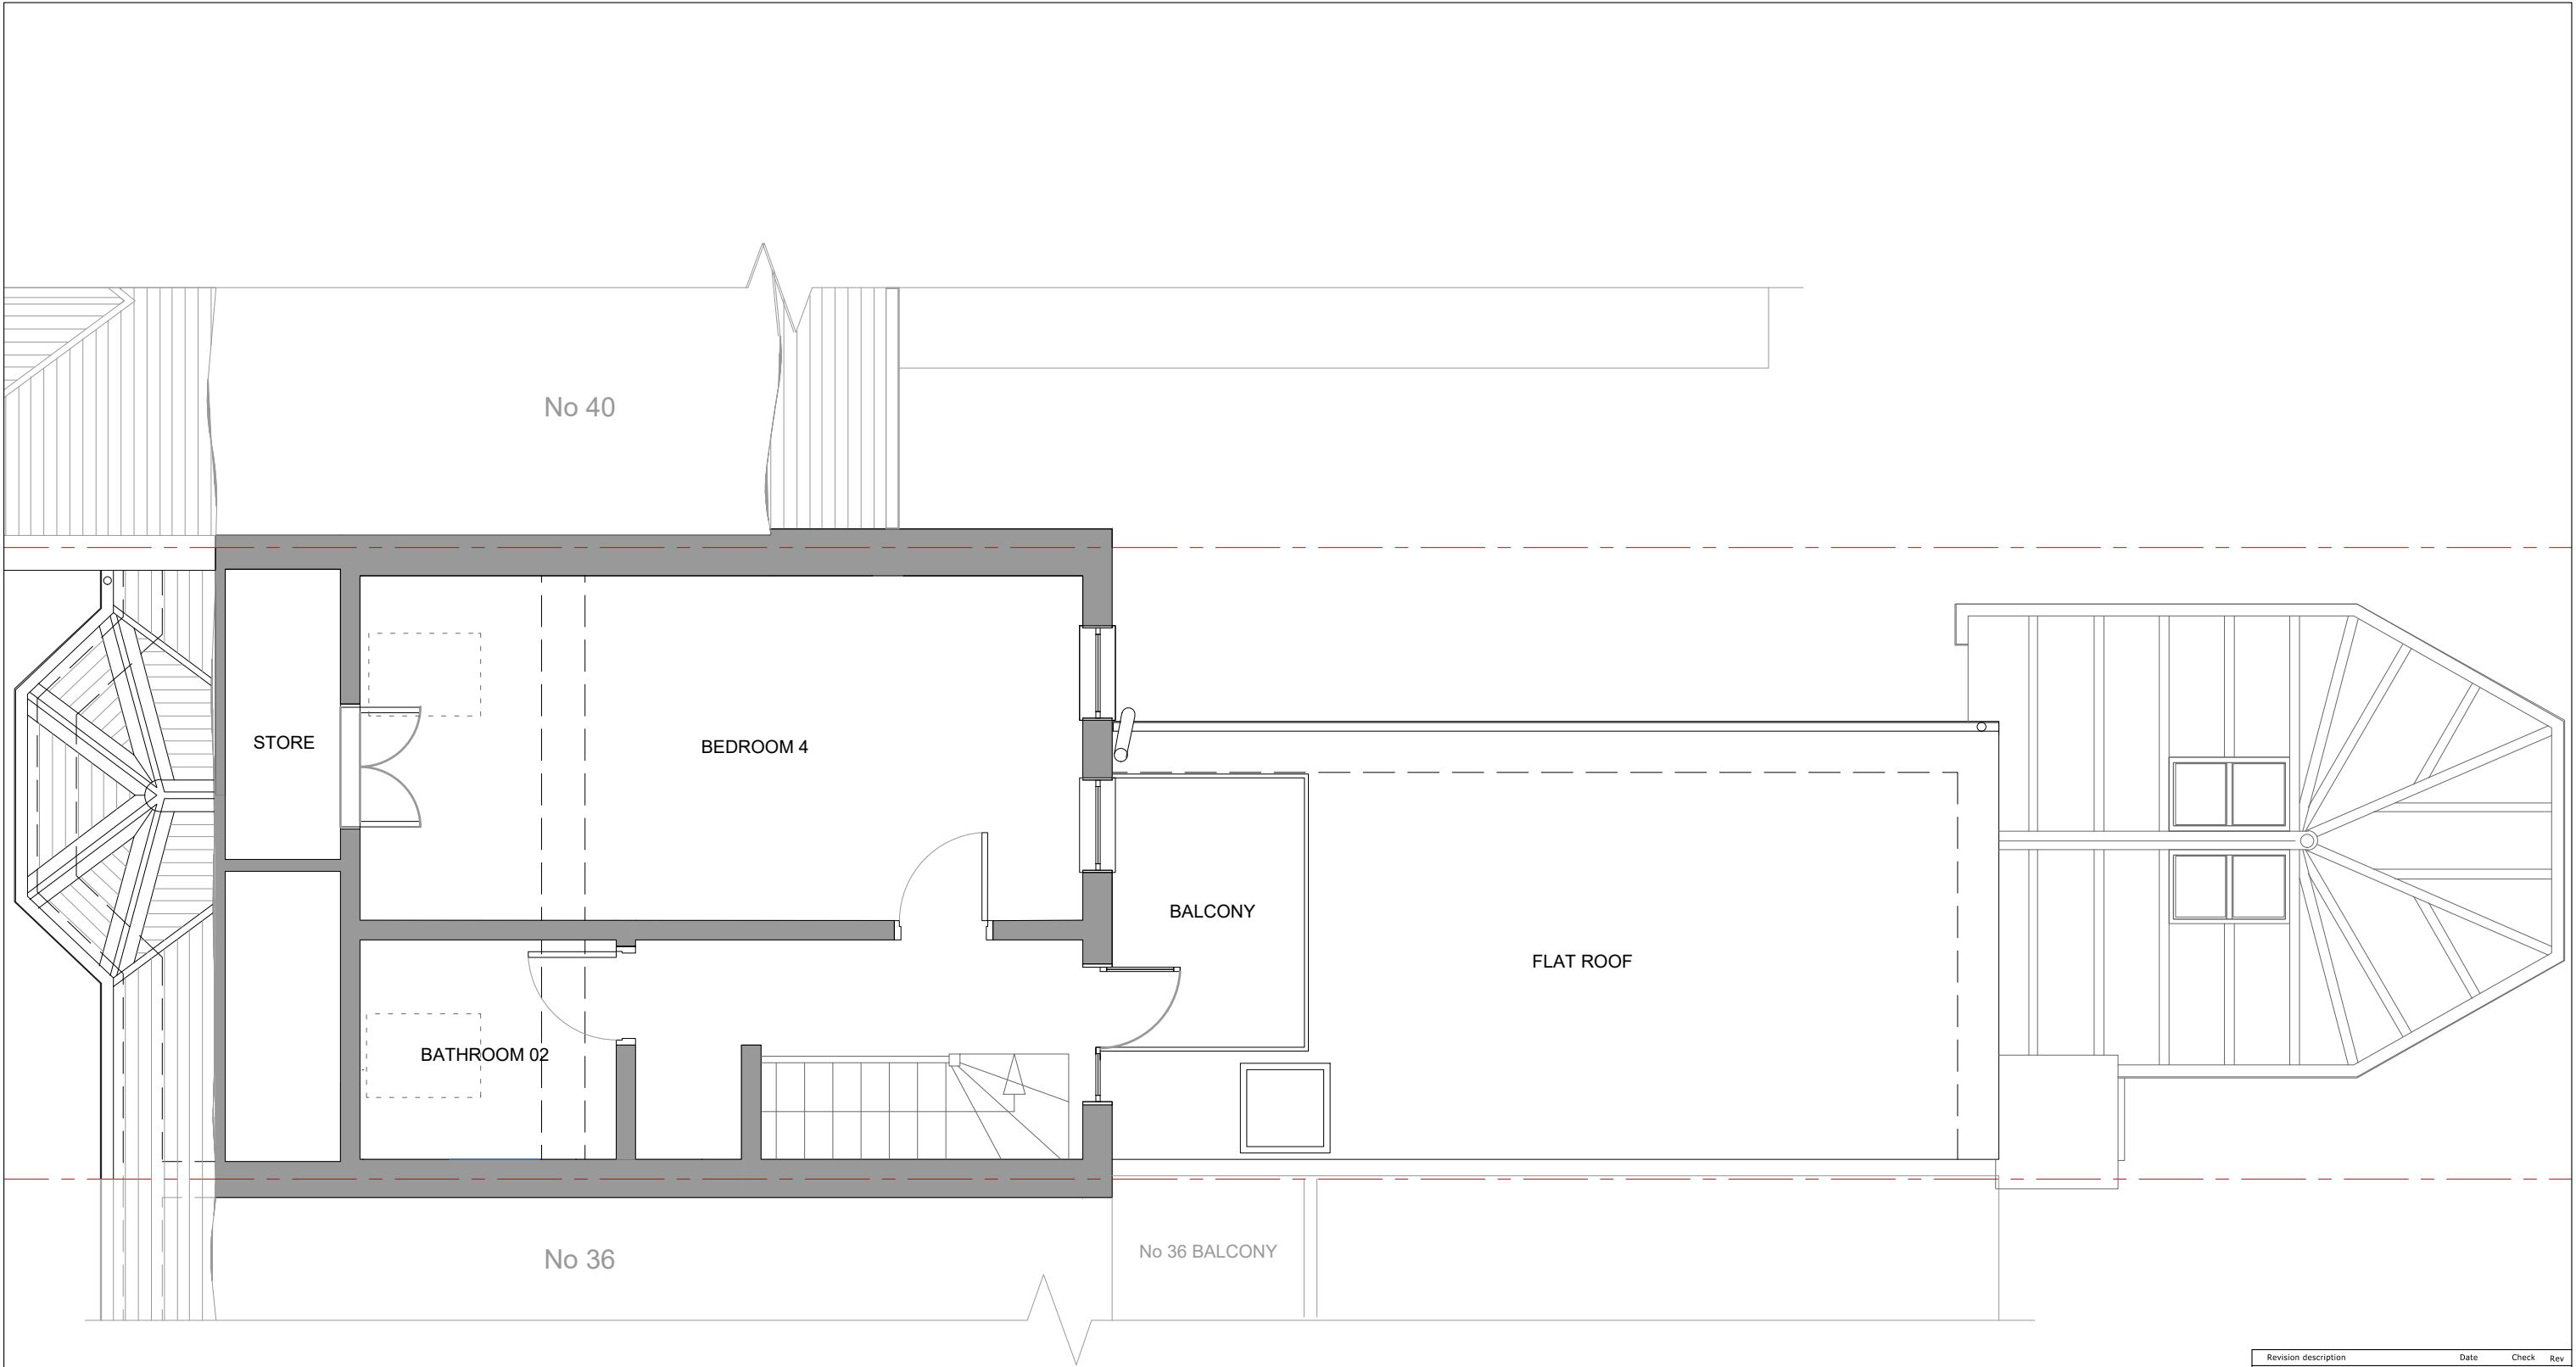

LOFT FLOOR PLAN
SCALE 1:50



Revision description		Date	Check	Rev
STUDIO www.gf-studio.com Unit 1 Office 7 - Hawthorn Business Park 165 Granville Road, London, NW2 2AZ T: +44 (0) 208 123 53 20 E: info@gf-studio.com				
Project 38 INGHAM ROAD LONDON NW6 1DE				
Drawing LOFT FLOOR PLAN AS BUILT				
Drawn RL	Date 13/12/2022	Scale 1:50@A3		
Job number 2204	Drawing number GA 03 102	Revision A		
COPYRIGHT 2021 GF STUDIO LIMITED ALL RIGHTS RESERVED				

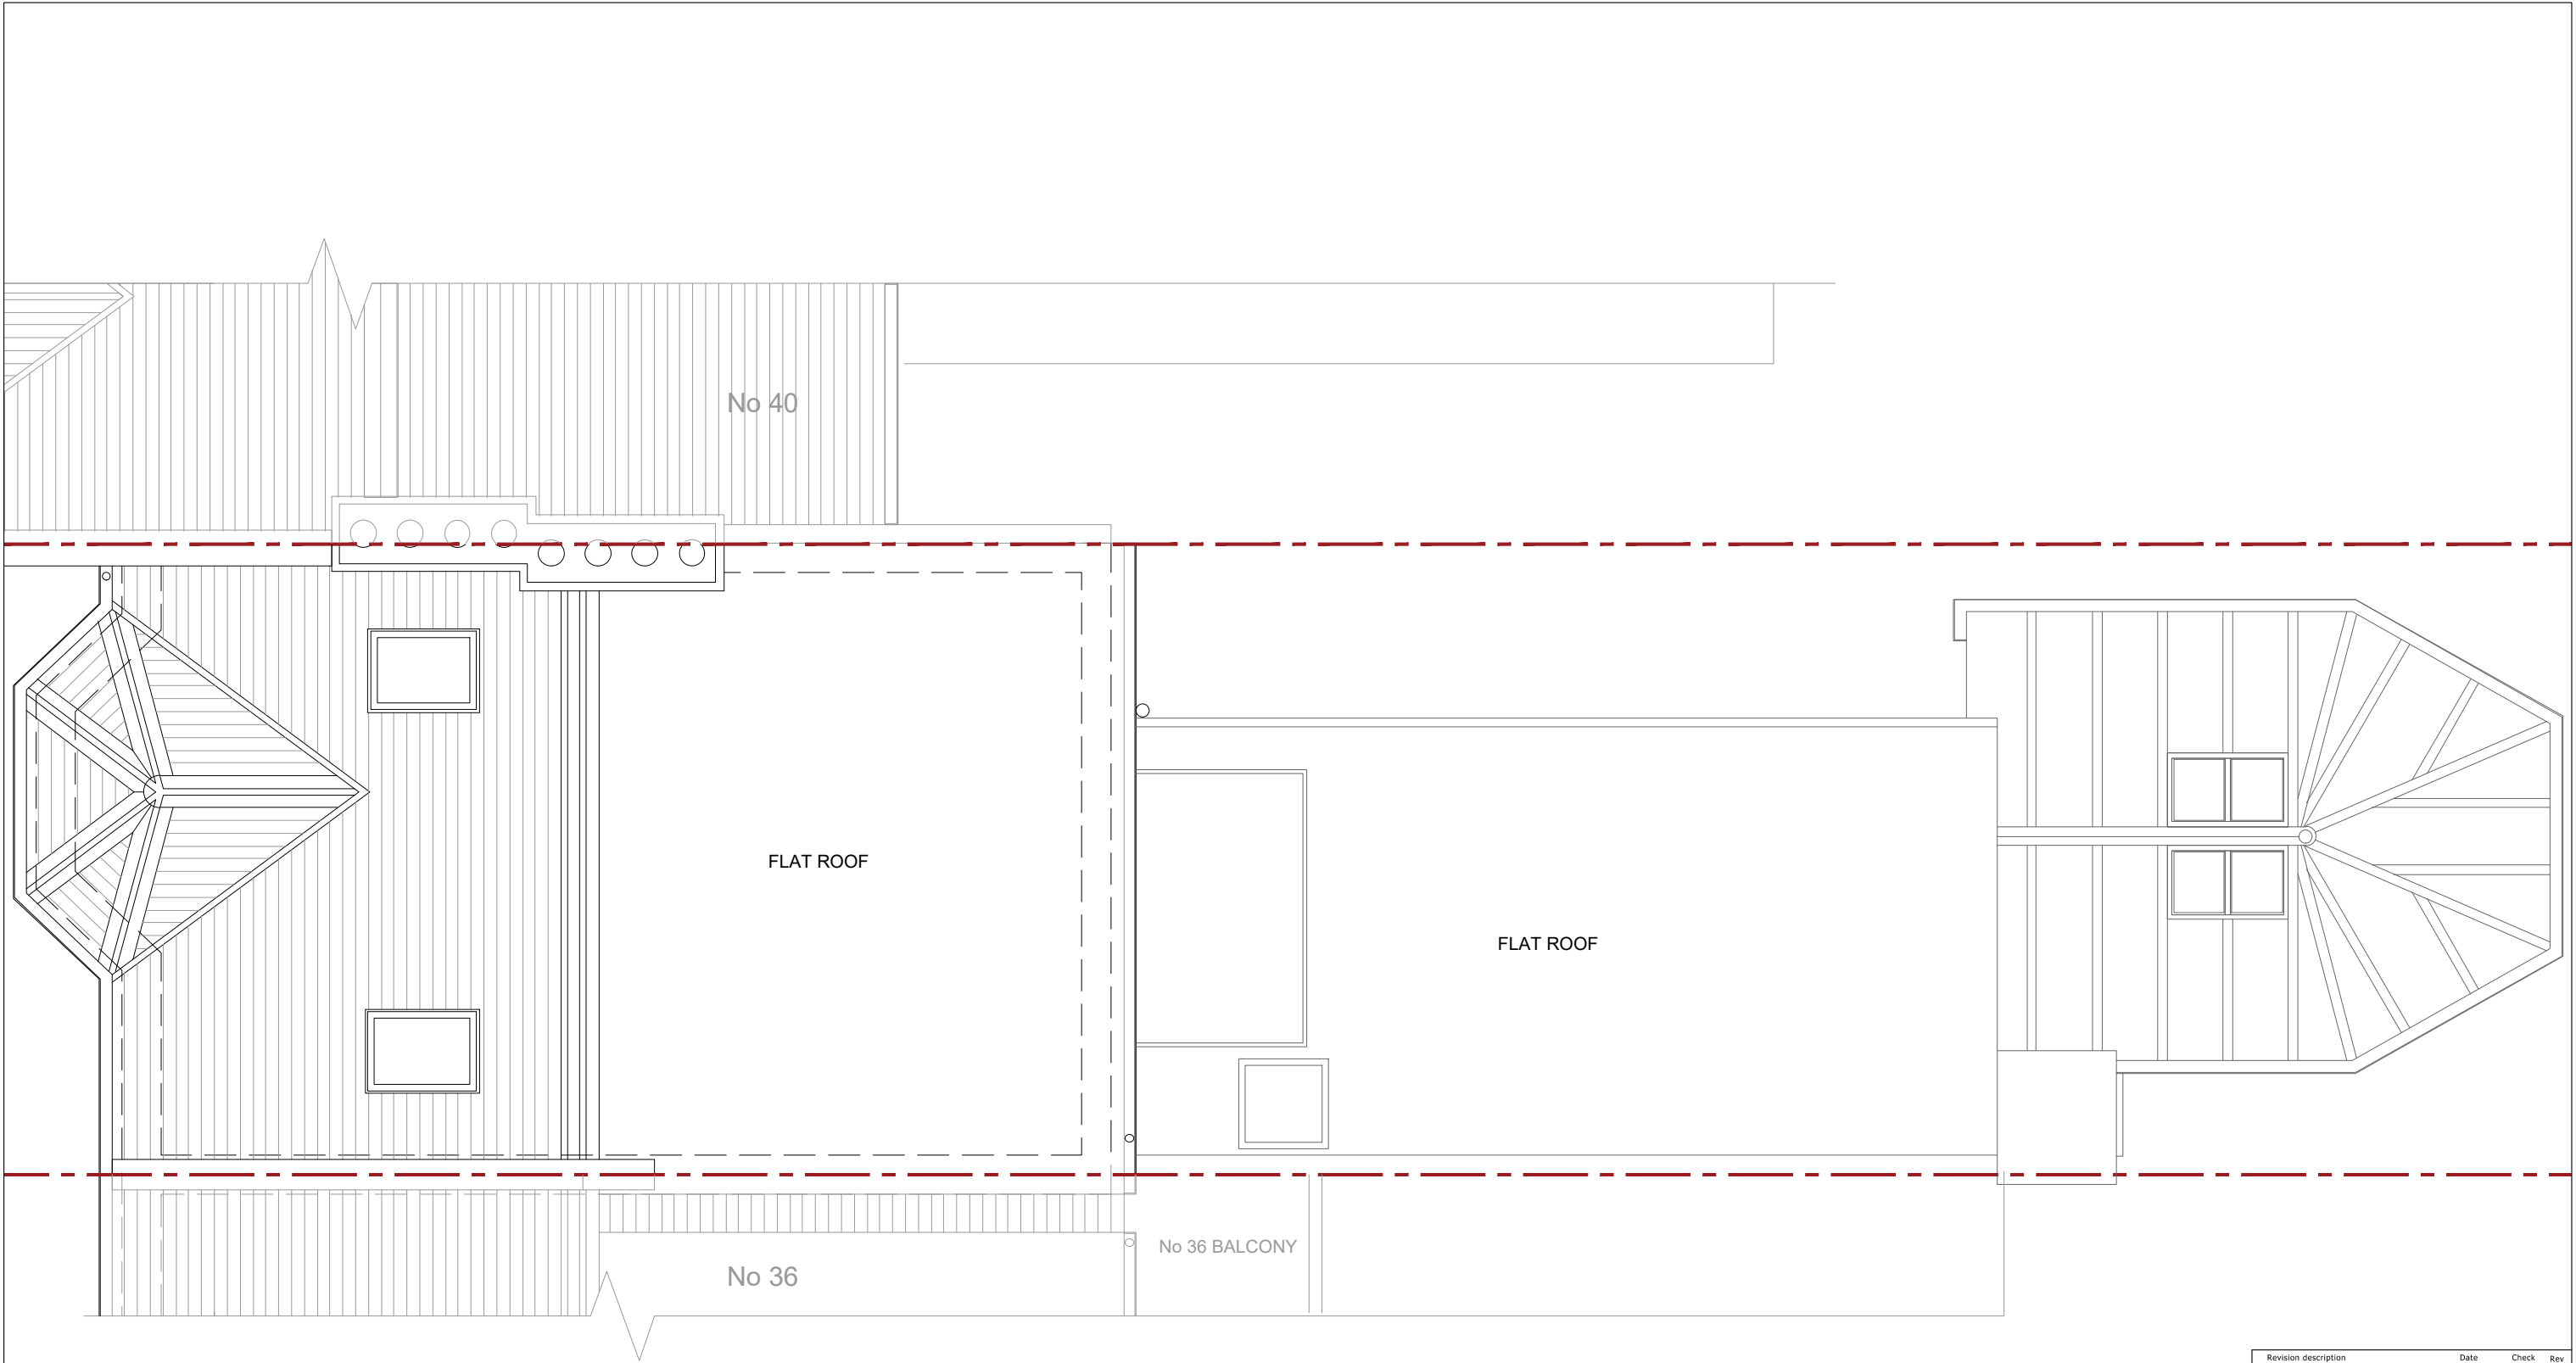

ROOF PLAN
SCALE 1:50



Revision description		Date	Check	Rev
STUDIO www.gf-studio.com Unit 1 Office 7 - Hawthorn Business Park 165 Granville Road, London, NW2 2AZ T: +44 (0) 208 123 53 20 E: info@gf-studio.com				
Project 38 INGHAM ROAD LONDON NW6 1DE				
Drawing ROOF PLAN AS BUILT				
Drawn RL	Date 13/12/2022	Scale 1:50@A3		
Job number 2204	Drawing number GA 03 103	Revision A		
COPYRIGHT 2021 GF STUDIO LIMITED ALL RIGHTS RESERVED				



Revision description		Date	Check	Rev
STUDIO www.gf-studio.com Unit 1 Office 7 - Hawthorn Business Park 165 Granville Road, London, NW2 2AZ T: +44 (0) 208 123 53 20 E: info@gf-studio.com				
Project 38 INGHAM ROAD LONDON NW6 1DE				
Drawing FRONT ELEVATION AS BUILT				
Drawn RL	Date 13/12/2022	Scale 1:50 @A3		
Job number 2204	Drawing number GA 05 03	Revision A		
COPYRIGHT 2021 GF STUDIO LIMITED ALL RIGHTS RESERVED				



REAR ELEVATION
SCALE 1:50



Revision description	Date	Check	Rev
----------------------	------	-------	-----

 **STUDIO**
www.gf-studio.com
Unit 1 Office 7 - Hawthorn Business Park
165 Granville Road, London, NW2 2AZ
T: +44 (0) 208 123 53 20
E: info@gf-studio.com


Project
**38 INGHAM ROAD
LONDON
NW6 1DE**

Drawing
REAR ELEVATION AS BUILT

Drawn	Date	Scale
RL	13/12/2022	1:50 @A3

Job number	Drawing number	Revision
2204	GA 05 04	A

COPYRIGHT 2021 GF STUDIO LIMITED ALL RIGHTS RESERVED

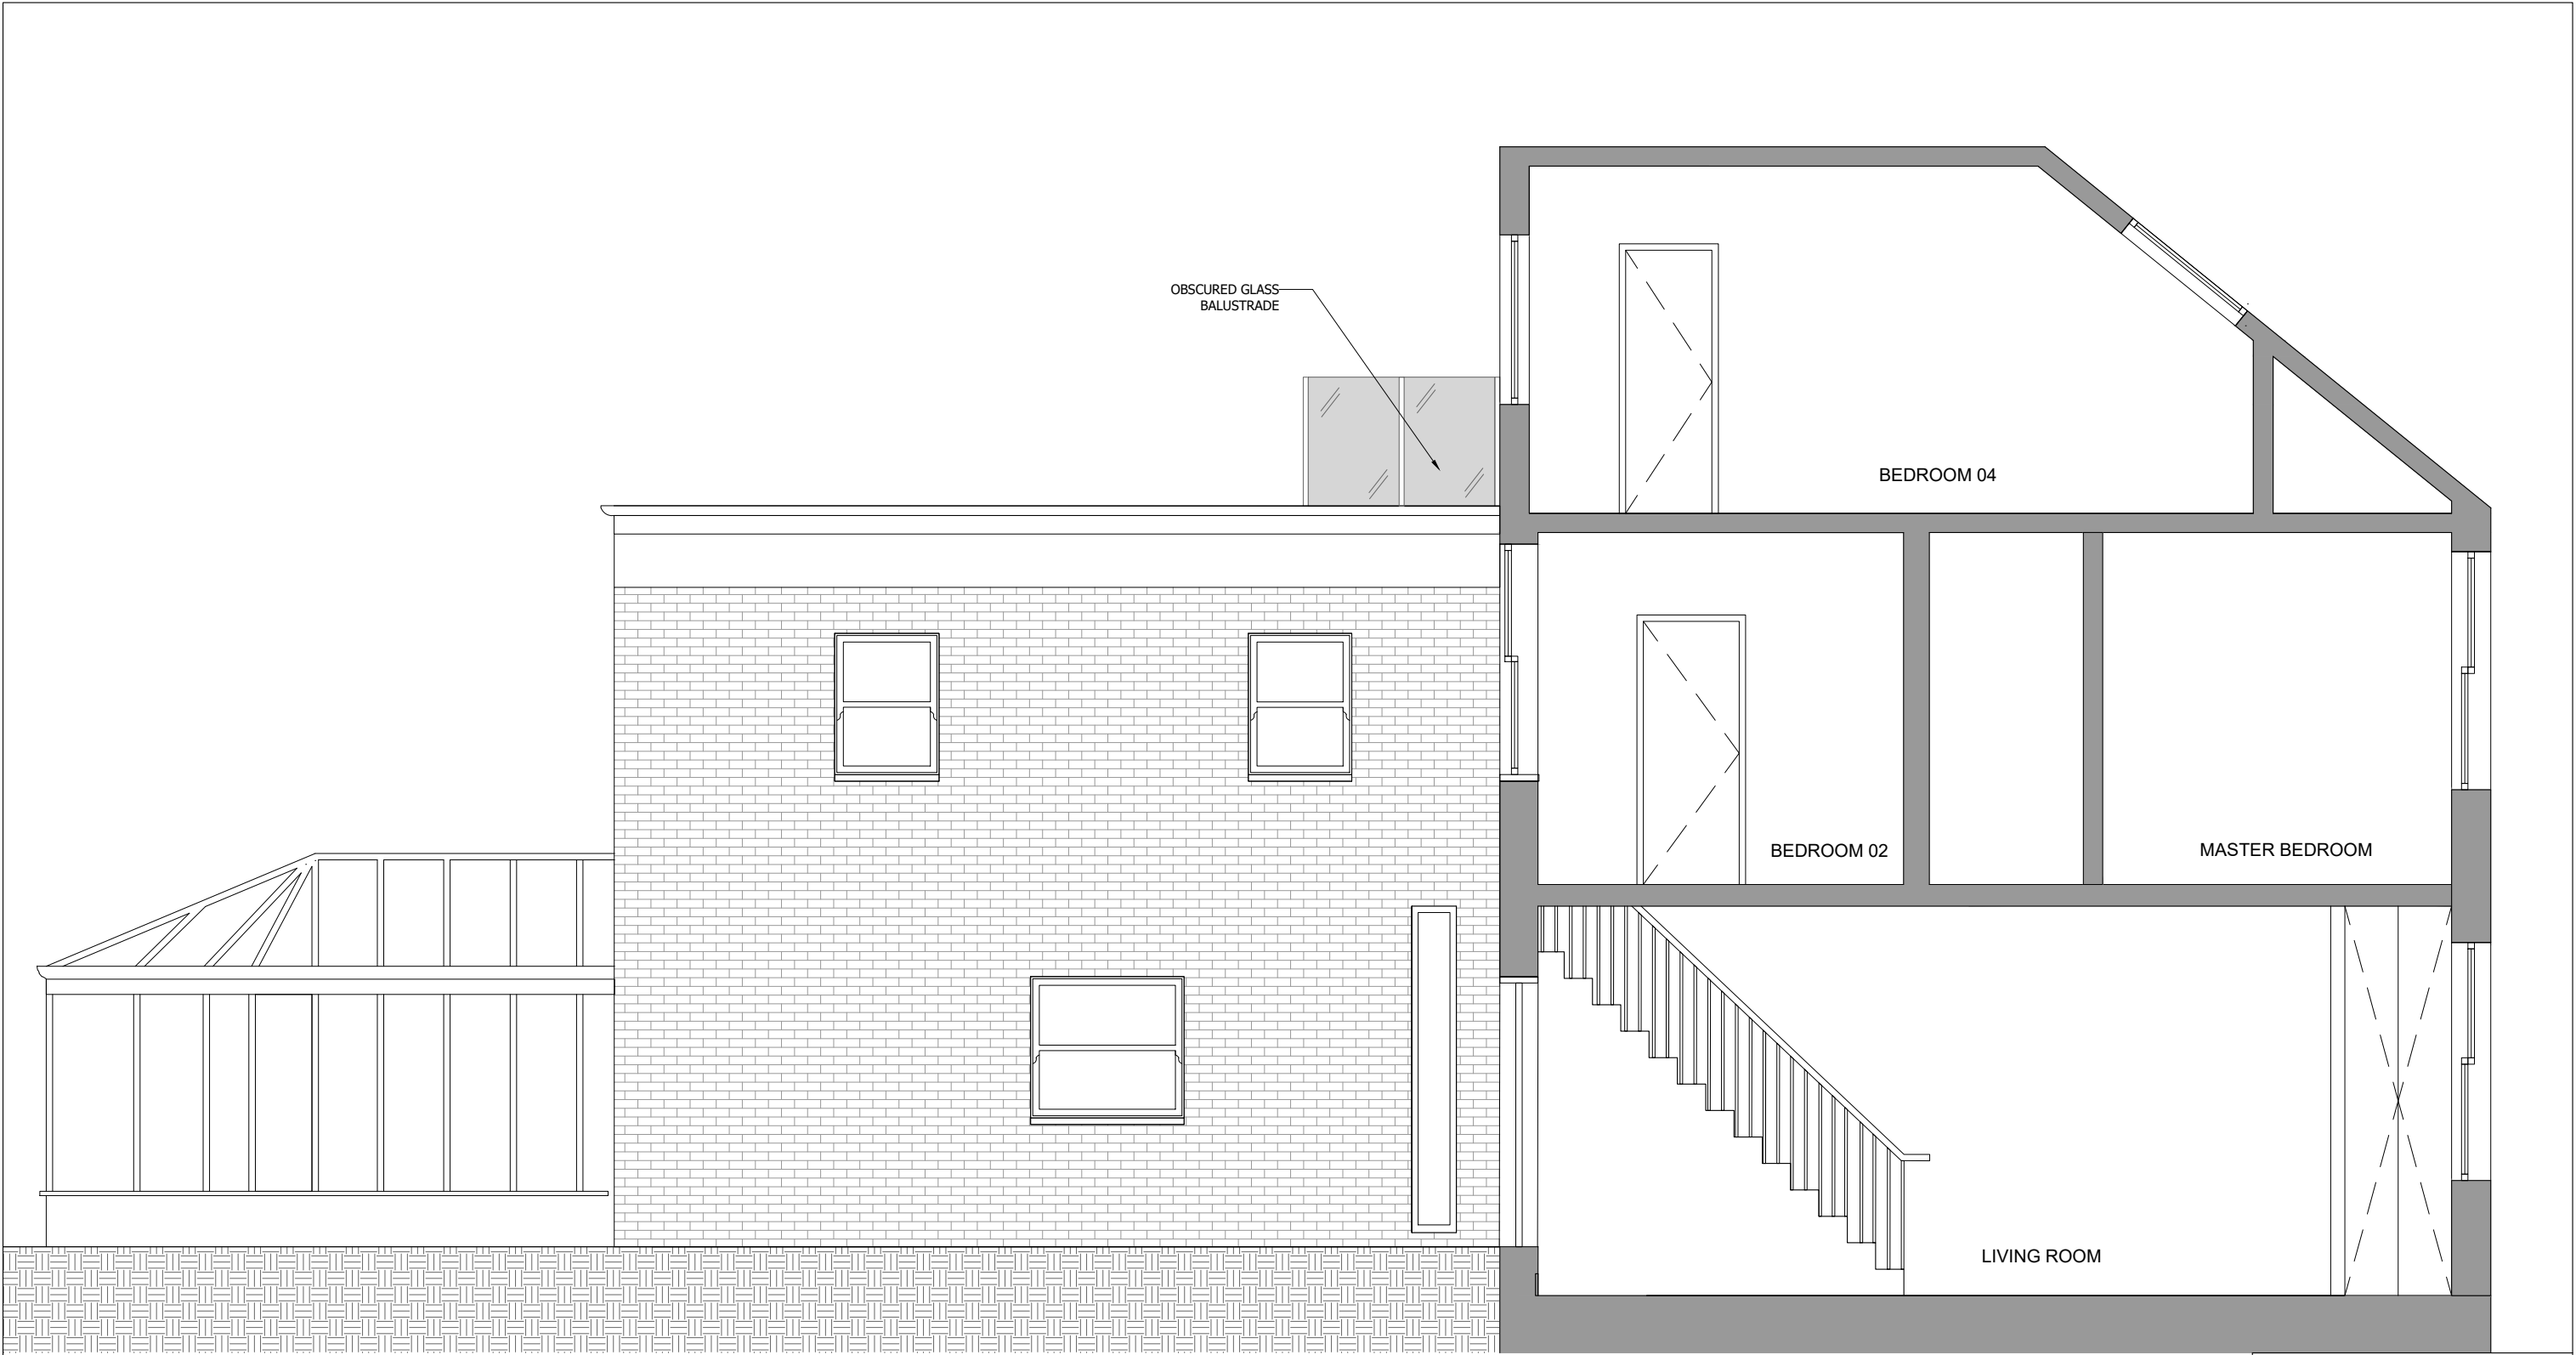

SIDE ELEVATION
SCALE 1:50



Revision description		Date	Check	Rev
STUDIO www.gf-studio.com Unit 1 Office 7 - Hawthorn Business Park 165 Granville Road, London, NW2 2AZ T: +44 (0) 208 123 53 20 E: info@gf-studio.com				
Project 38 INGHAM ROAD LONDON NW6 1DE				
Drawing SIDE ELEVATION AS BUILT				
Drawn RL	Date 13/12/2022	Scale 1:50 @A3		
Job number 2204	Drawing number GA 05 04	Revision A		
COPYRIGHT 2021 GF STUDIO LIMITED ALL RIGHTS RESERVED				