



existing shopfront elevation
scale - 1:25 @ A1 / 1:50 @ A3

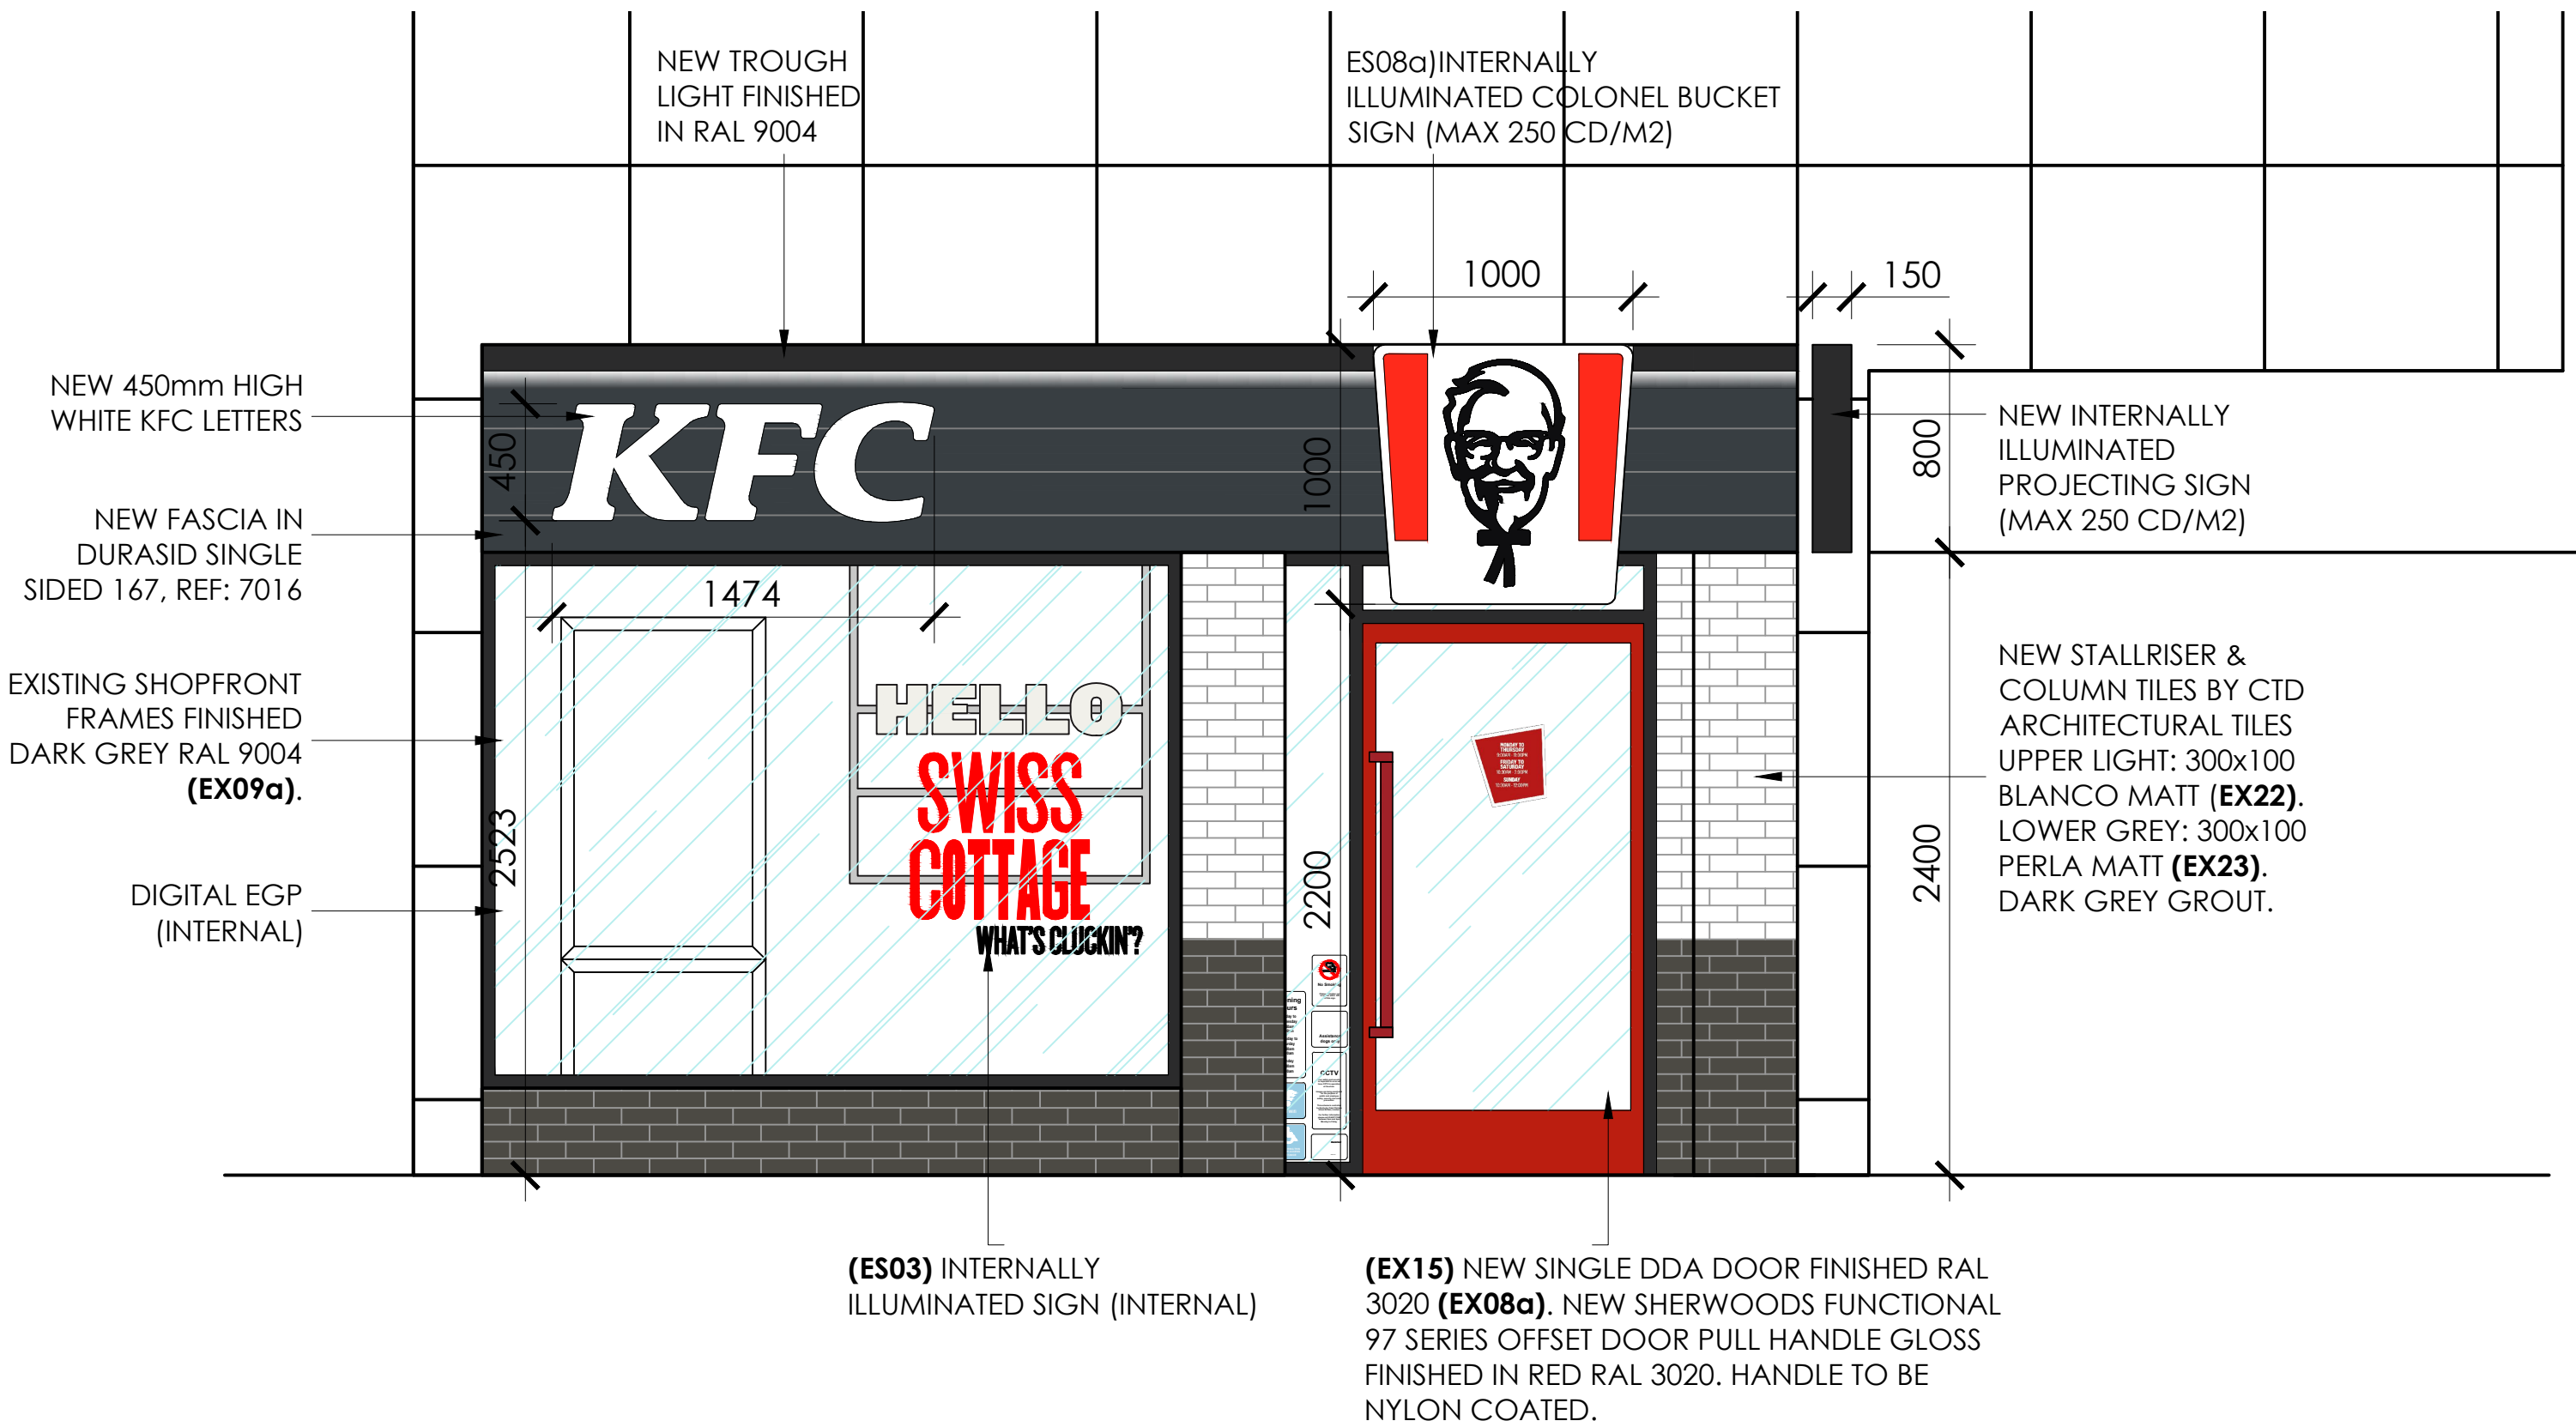

proposed shopfront elevation
scale - 1:25 @ A1 / 1:50 @ A3

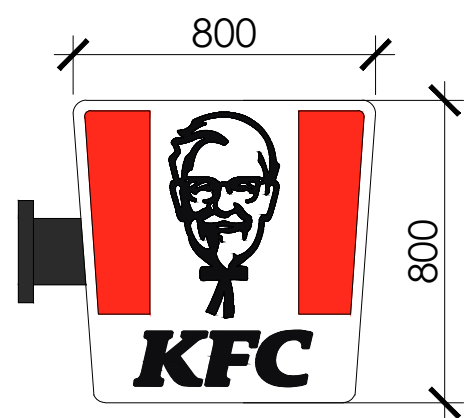

proposed
projection sign
scale - 1:20 @ A1

ALL DIMENSIONS TO BE CHECKED ON SITE. DO NOT SCALE FROM THIS DRAWING EXCEPT FOR THE PURPOSES OF LOCAL AUTHORITY PLANNING		
rev	date	description
A	14.03.22	Col's sign increased in size to match ex. height
B	24.03.22	Tiles to shopfront revised
C	26.04.22	Tiles to shopfront & entrance door revised
D	26.07.22	New door shown
E	22.08.22	AS BUILT
F	22-12-22	Amendments for building purposes

HONE
EDWARDS
ASSOCIATES

Design Studio
Millars Three
Southmill Road
Bishop's Stortford
Herts. CM23 3DH
email: firstname.lastname@honeedwards.co.uk

Tel: 01279 758545
Fax: 01279 757730

HILLCREST

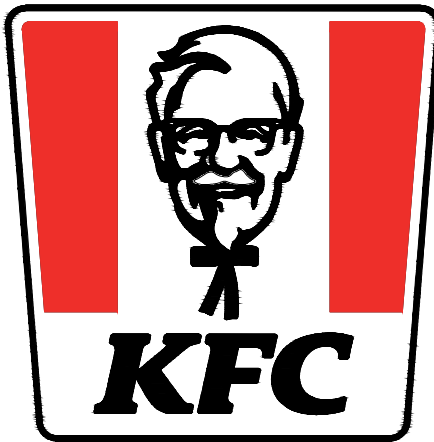


IMAGE ENHANCEMENT

store address
SWISS COTTAGE
149 FINCHLEY ROAD
LONDON
NW3 6JH

drawing title
EXISTING & PROPOSED
EXTERNAL ELEVATIONS

drawn by	checked	date
RJS	JE	MARCH 2022
store no.	scale	
0000	1:25 @ A1 / 1:50 @ A3	
drawing no.	revision	
0000/2022/G210		
HEA drawing no.	revision	
3393/G210	F	

SCALE
1:25 only 0 1 2 3 4 5