



Consented

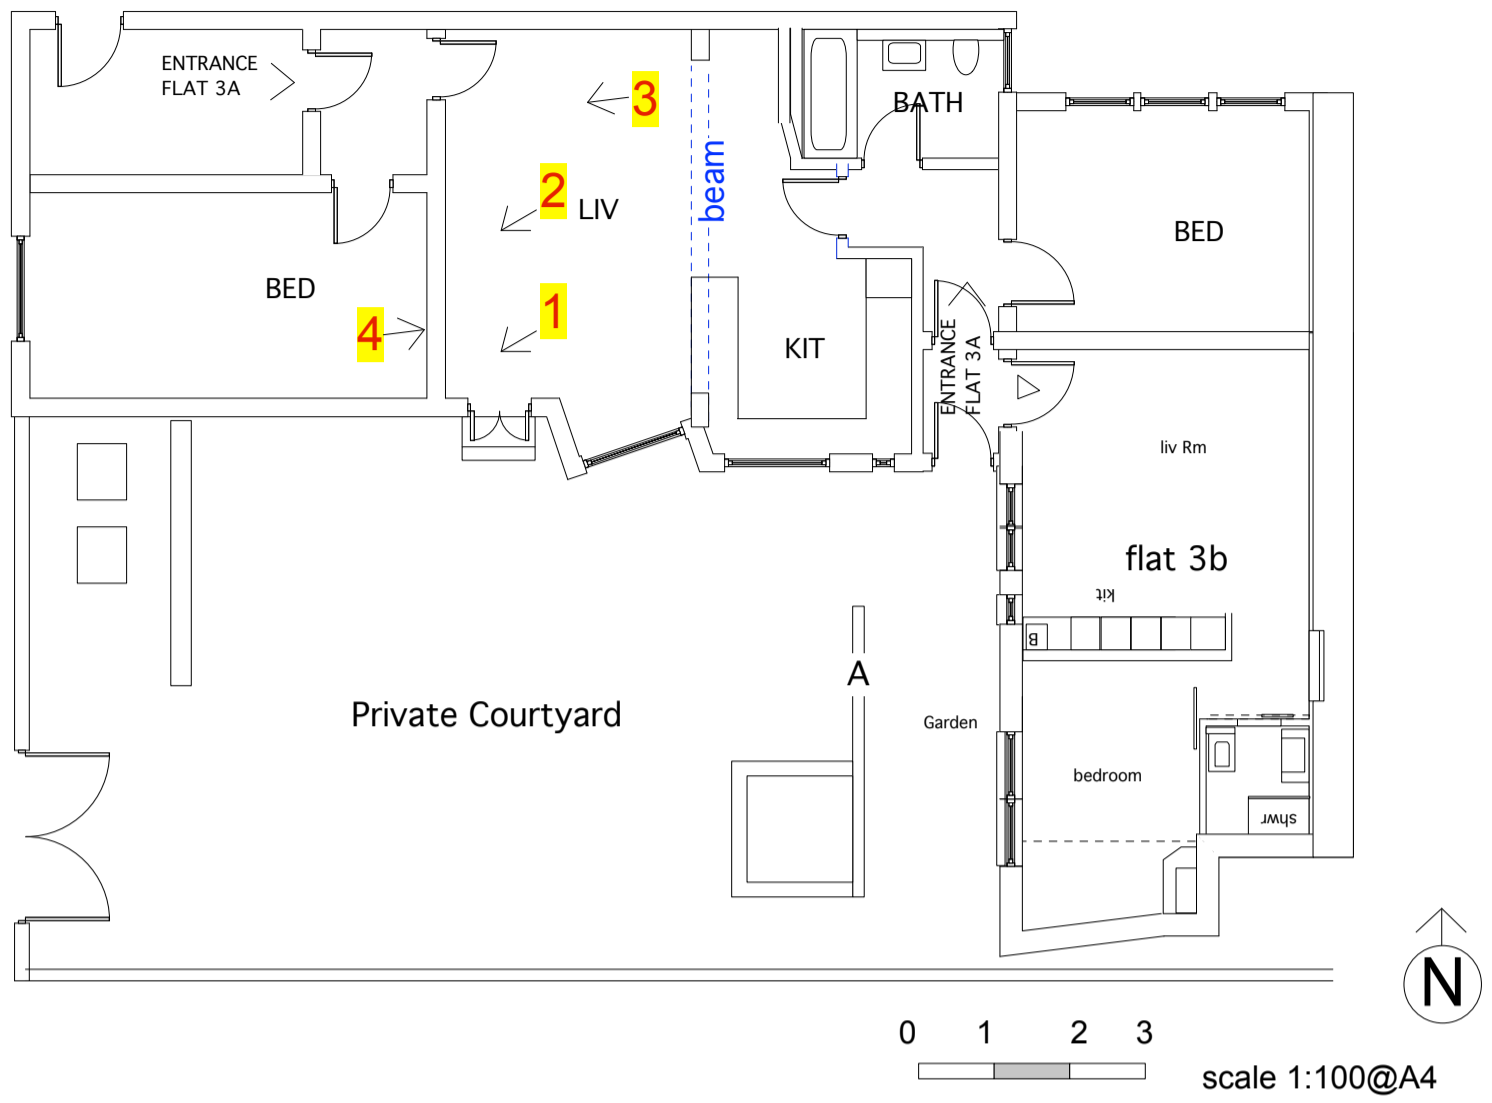

Existing with demolitions approved under 2020/4357/P

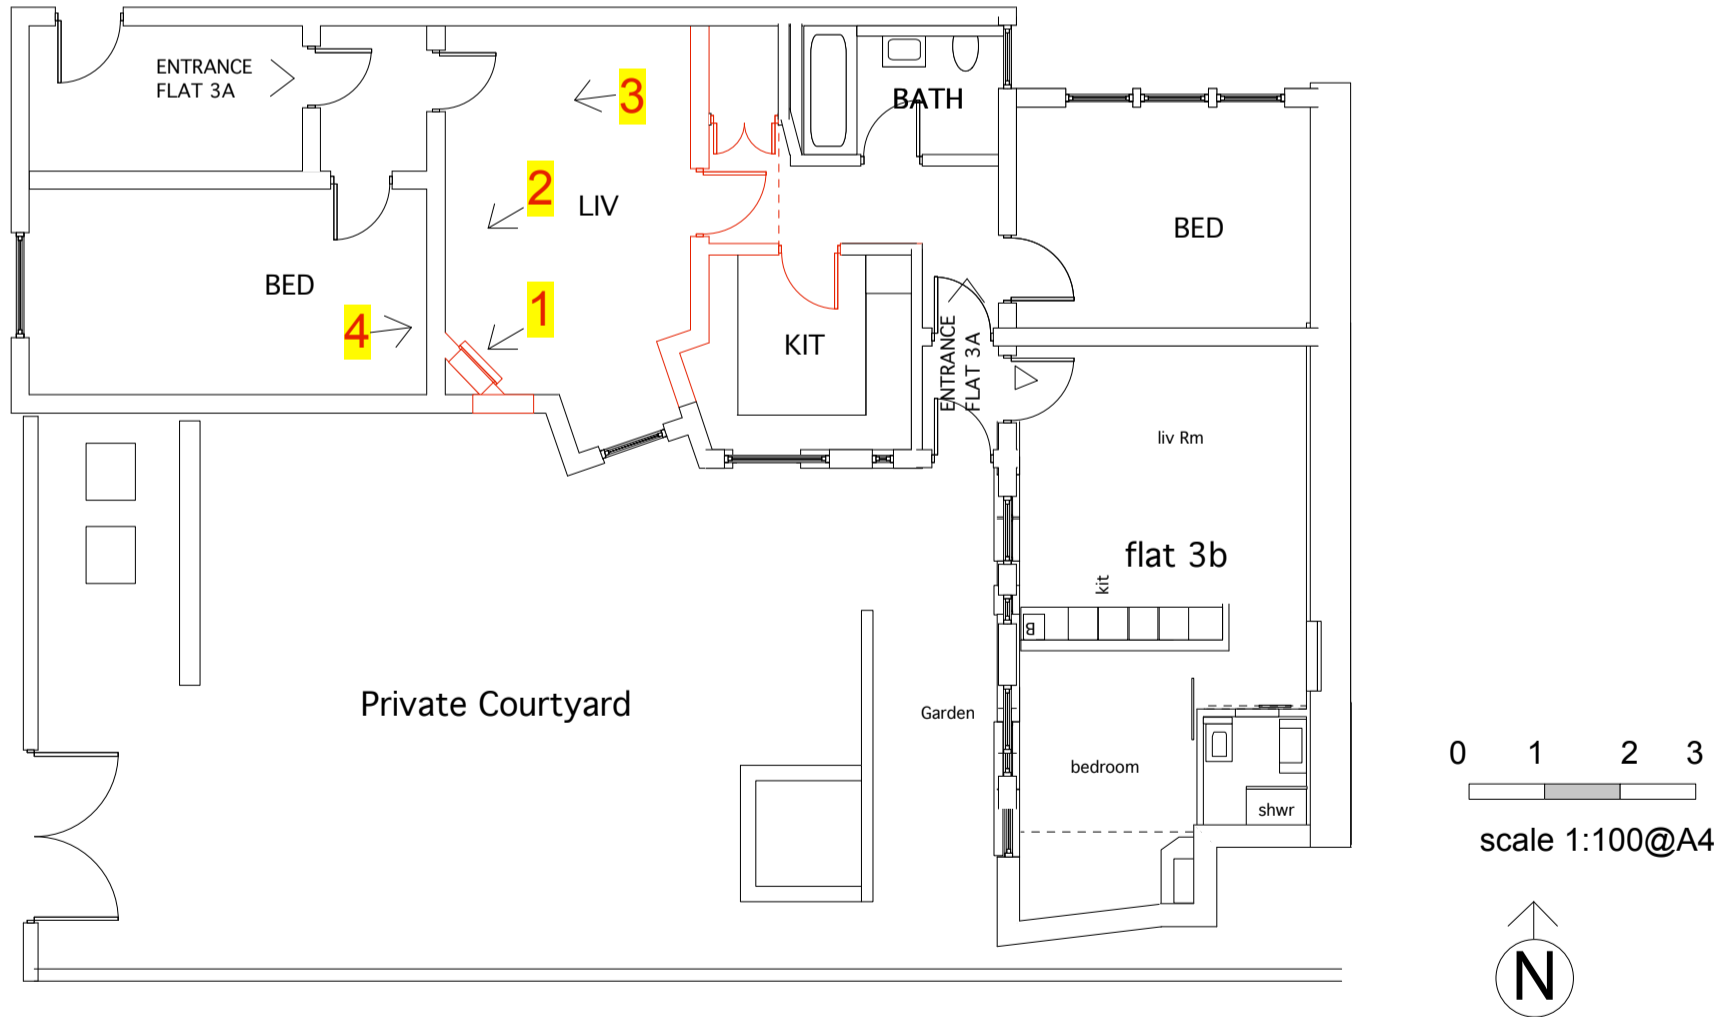

Existing plan

Red lines denote consented demolition